
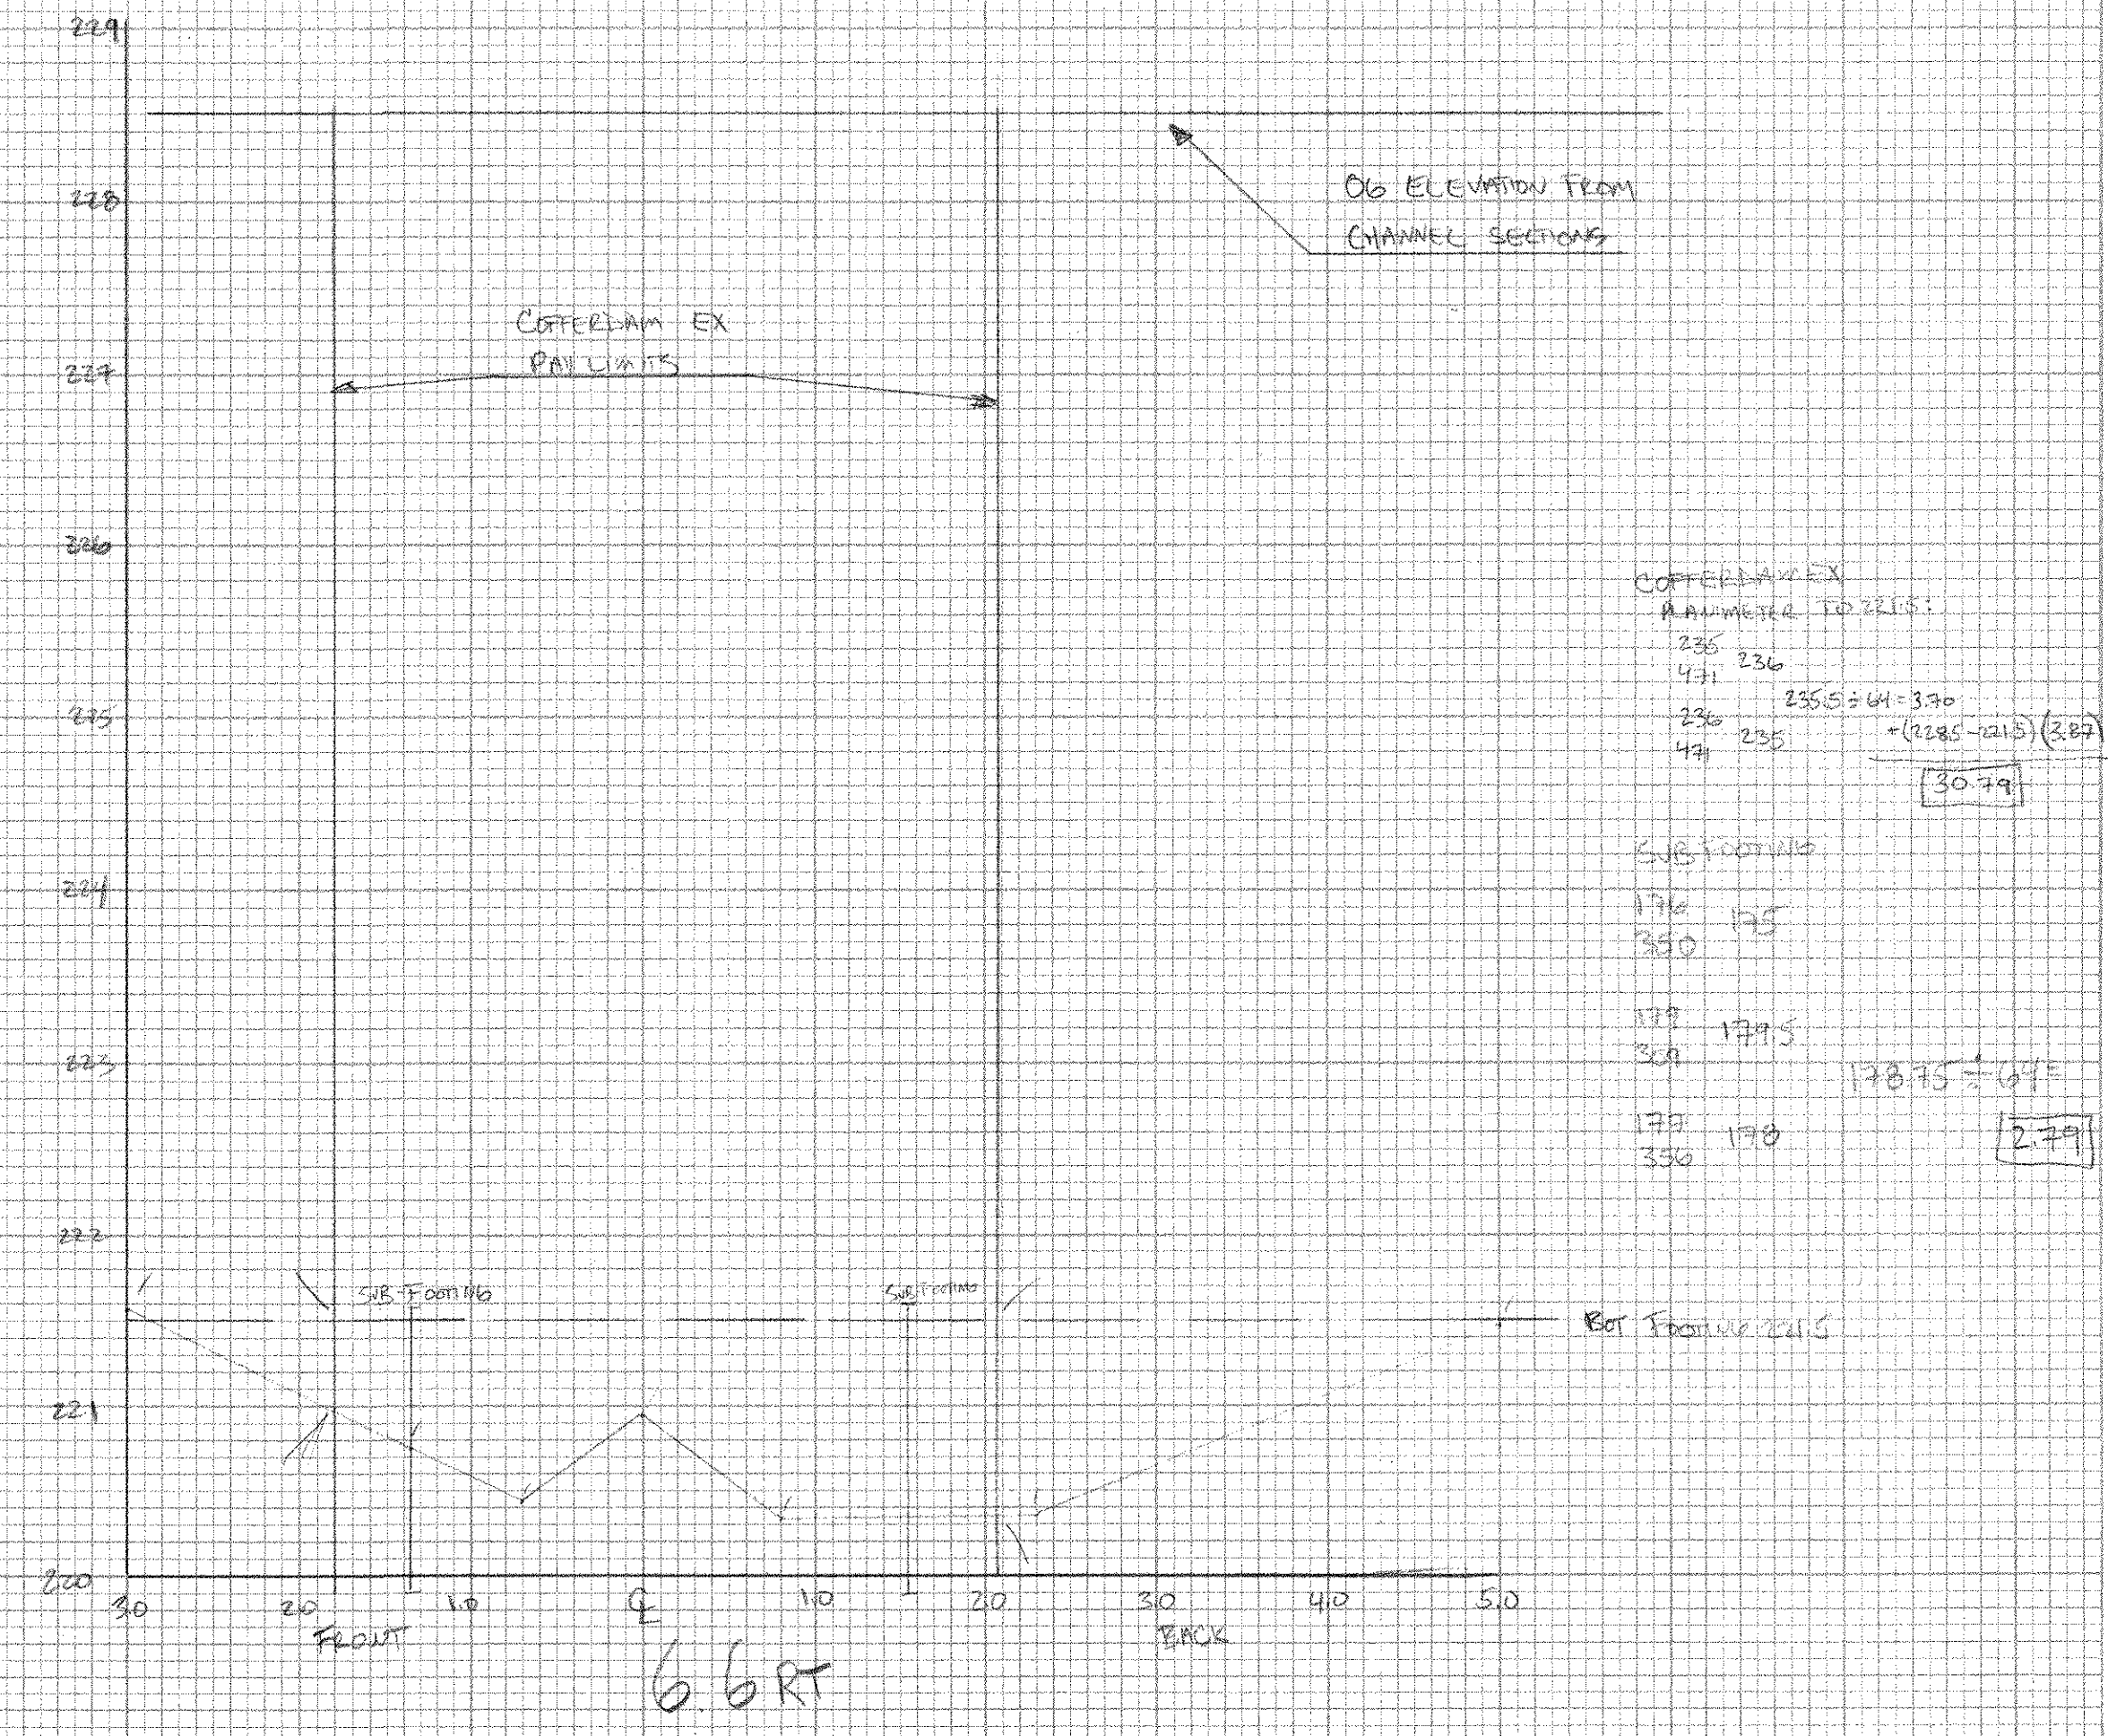
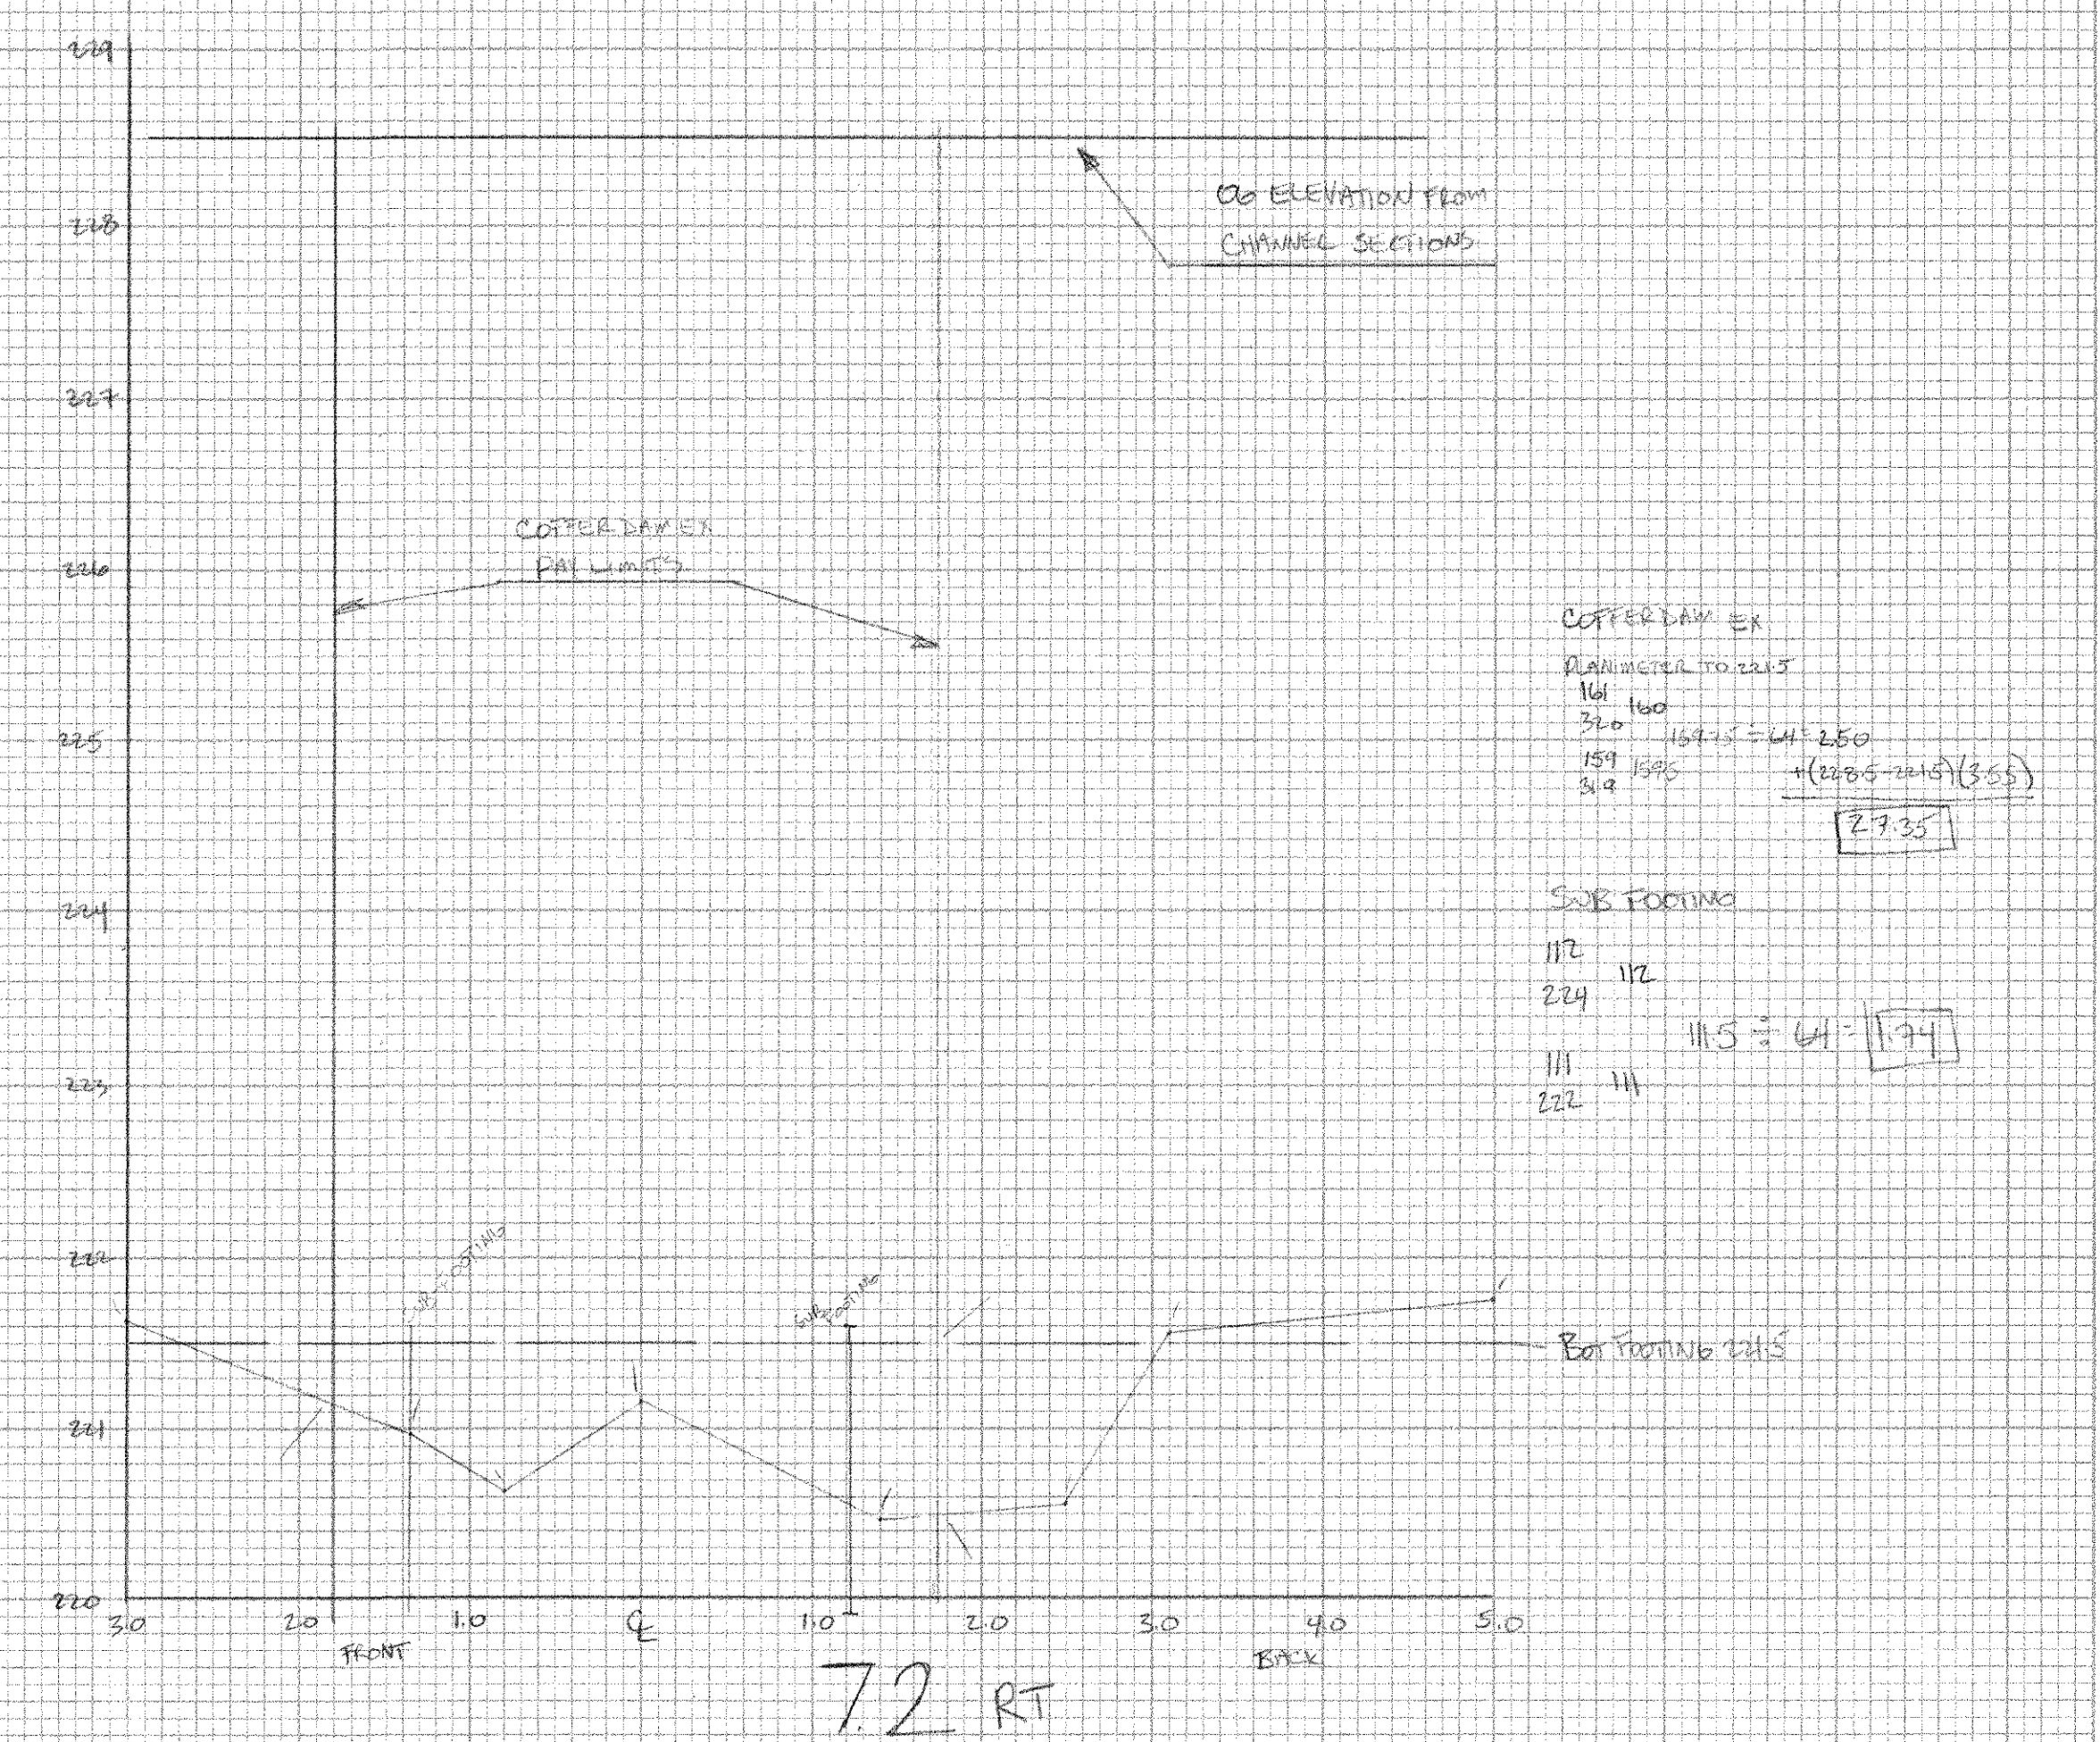
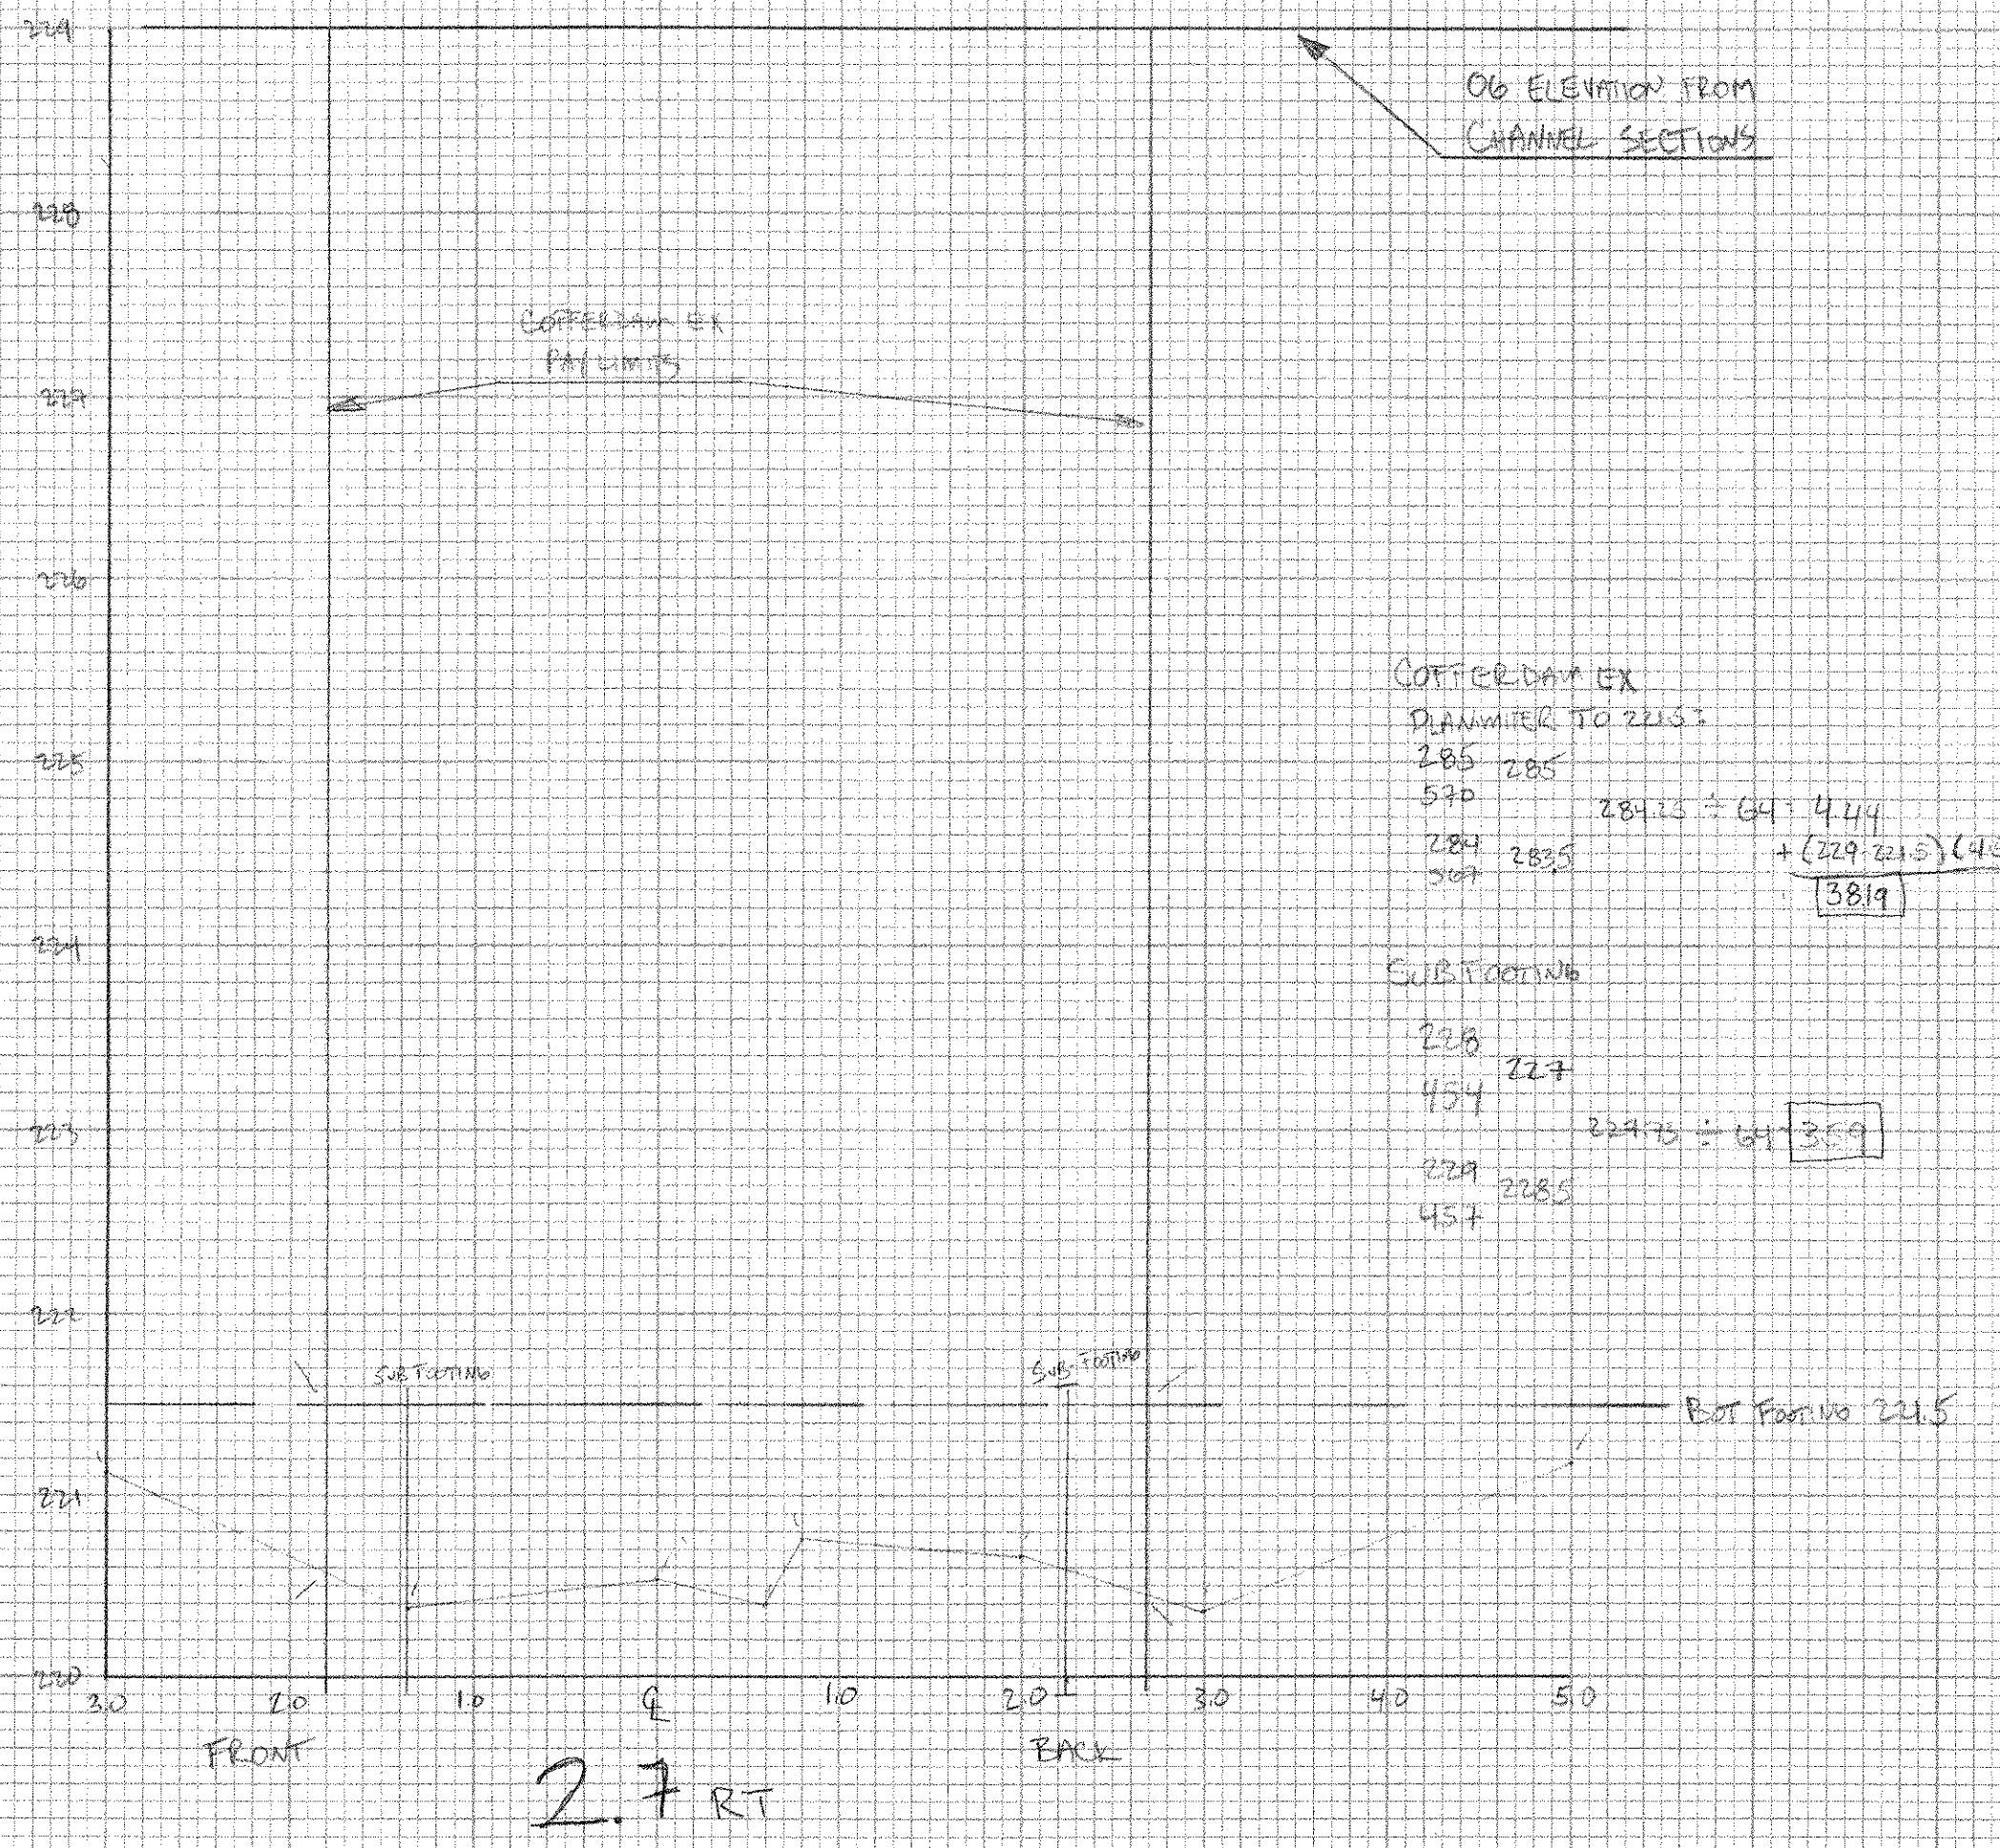


LYNDON BR 0269 (8)S  
SECTIONS ALONG C-ERB ABST #2

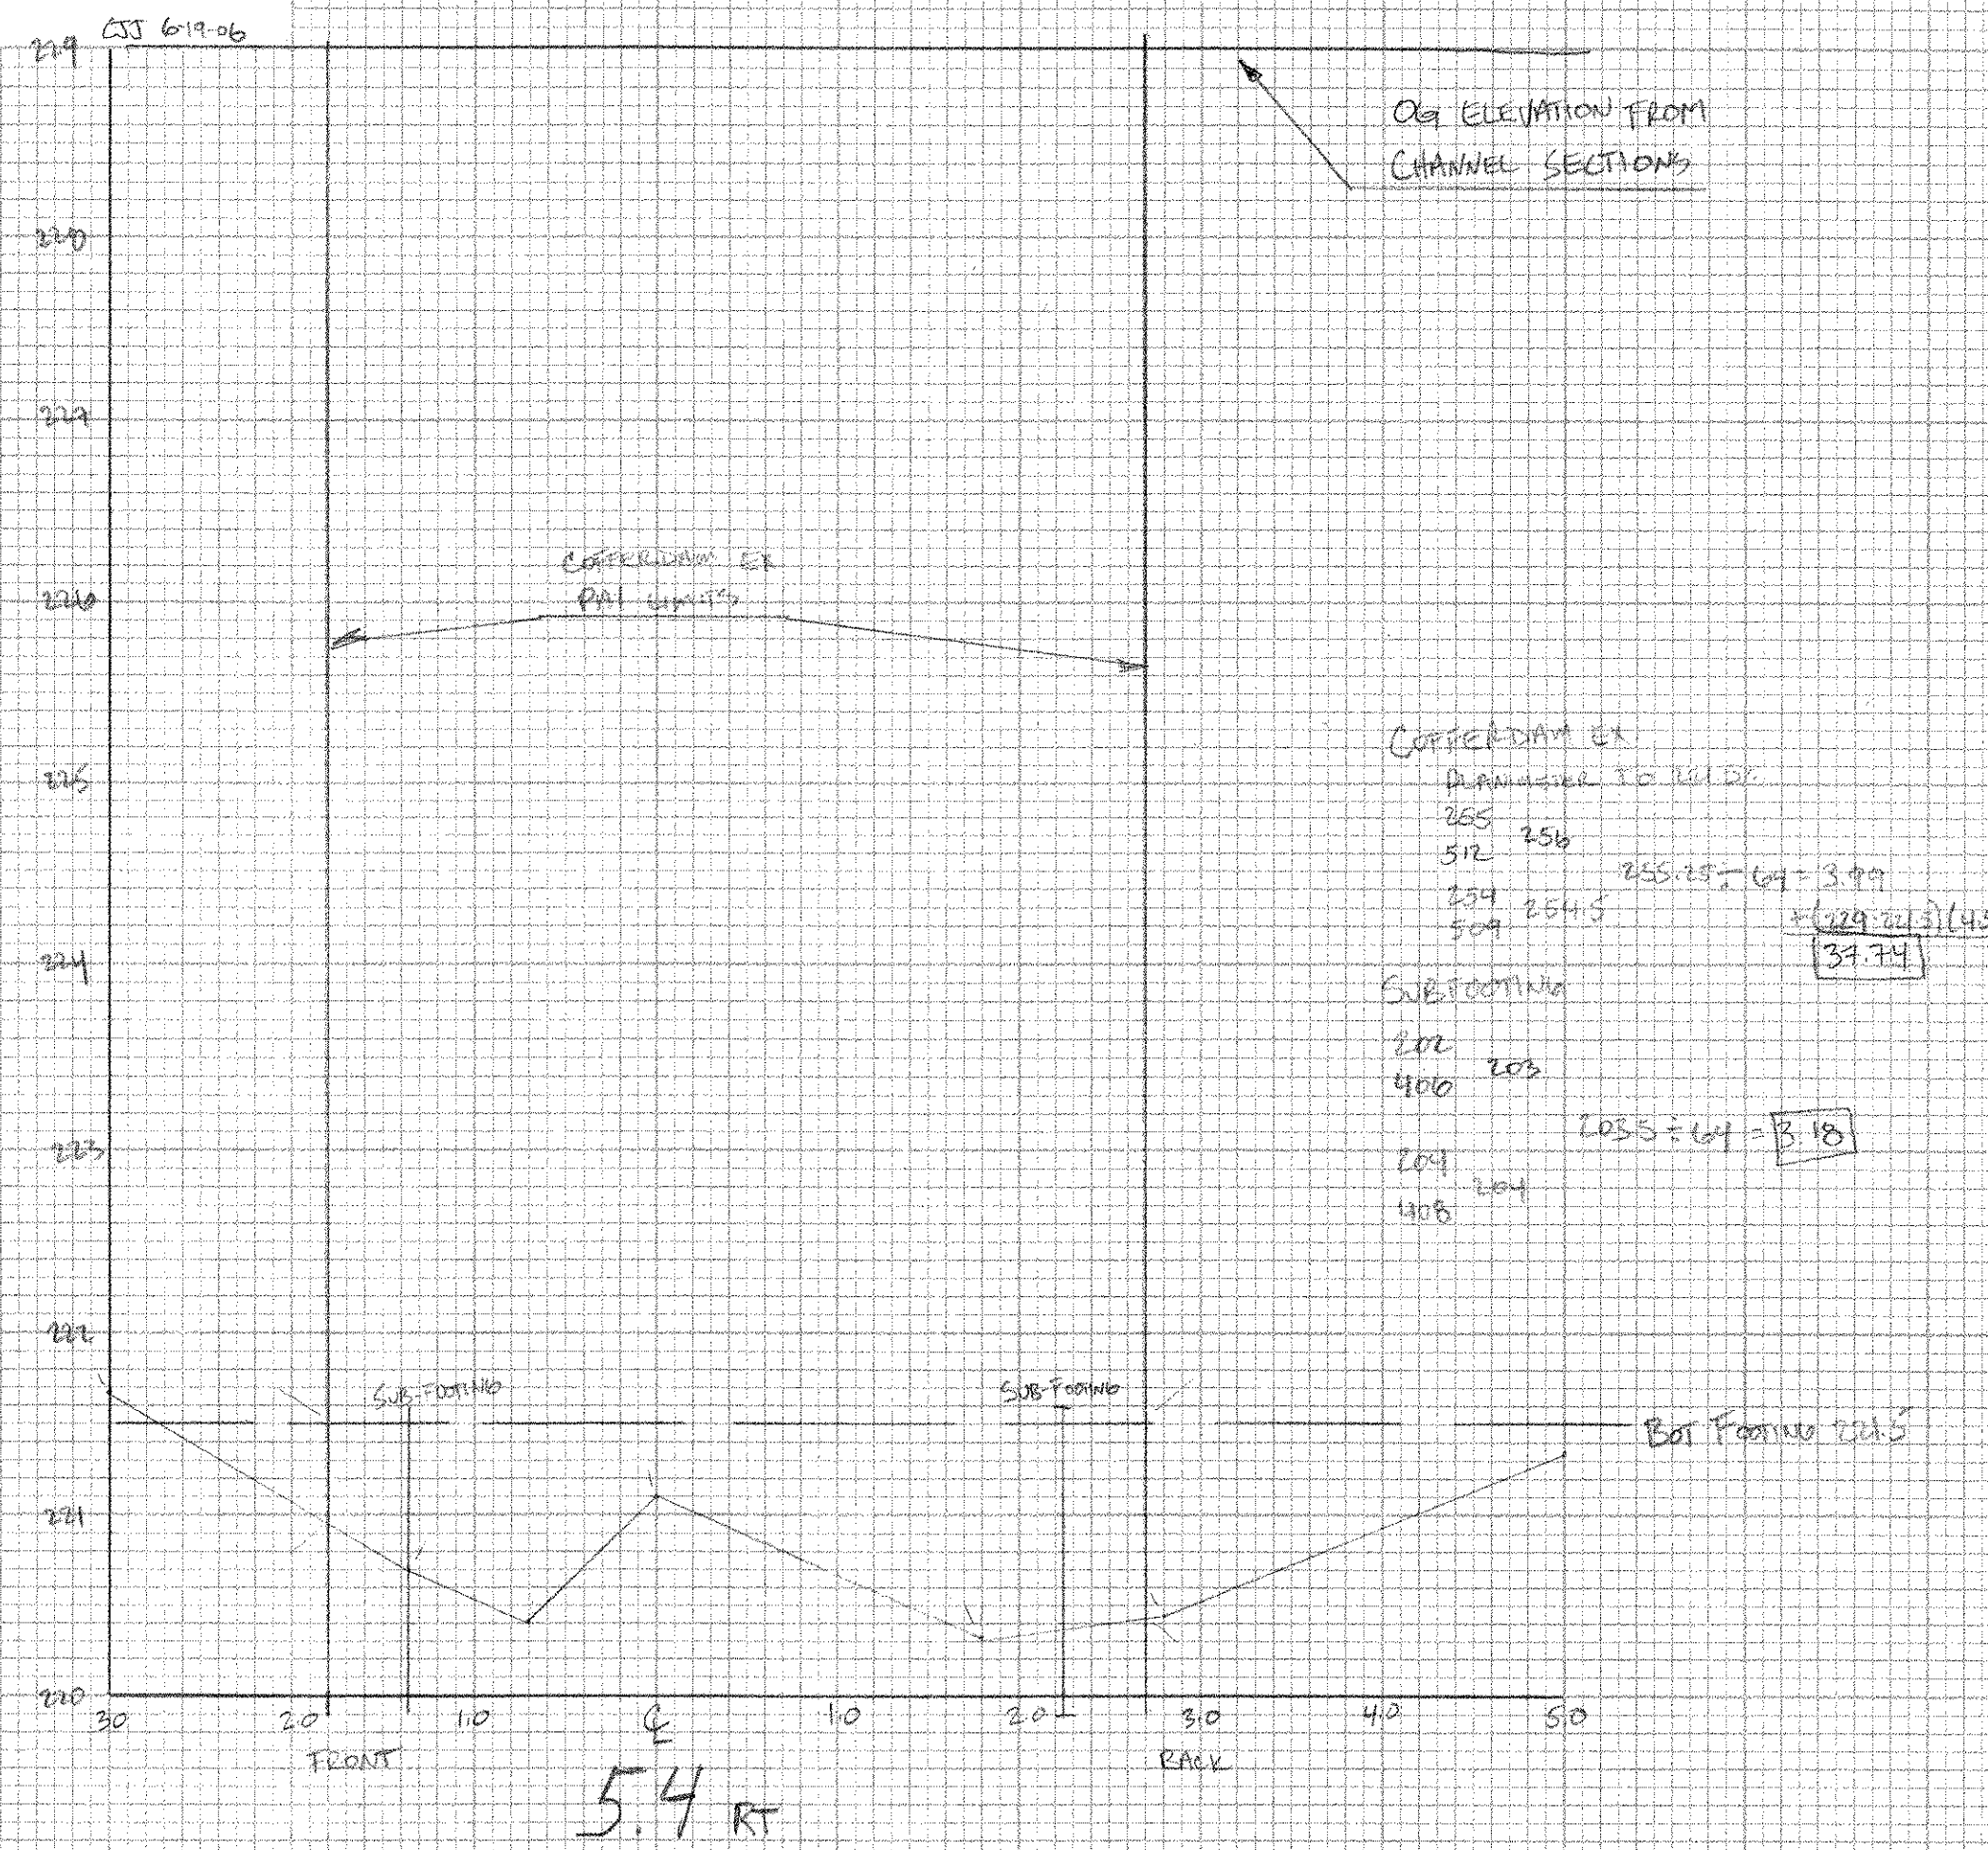

NO. CHECKED	DATE
NO. REVISIONS	
NO. EROSION	
NO. COLLAPSE	
NO. BRIDGE	
NO. OTHER	

NO. CHECKED	DATE
NO. REVISIONS	
NO. EROSION	
NO. COLLAPSE	
NO. BRIDGE	
NO. OTHER	