

APPROACH AREA DETAIL


NOT TO SCALE

LOCATION

VT RTE 103
 STA 68+08, LUDLOW - BEGIN COLD PLANING
 STA 151+12, LUDLOW - END COLD PLANING

TOWN HIGHWAYS:

TH #320 RT	TH #324 LT
TH #316 RT	SA #4 RT
TH #326 LT	TH #314 RT
TH #328 LT	TH #330 LT
TH #330 RT	VT #100 LT
TH #354 LT	TH #360 LT
TH #356 LT	TH #362 LT
TH #364 LT	SA #3 LT
TH #363 LT	

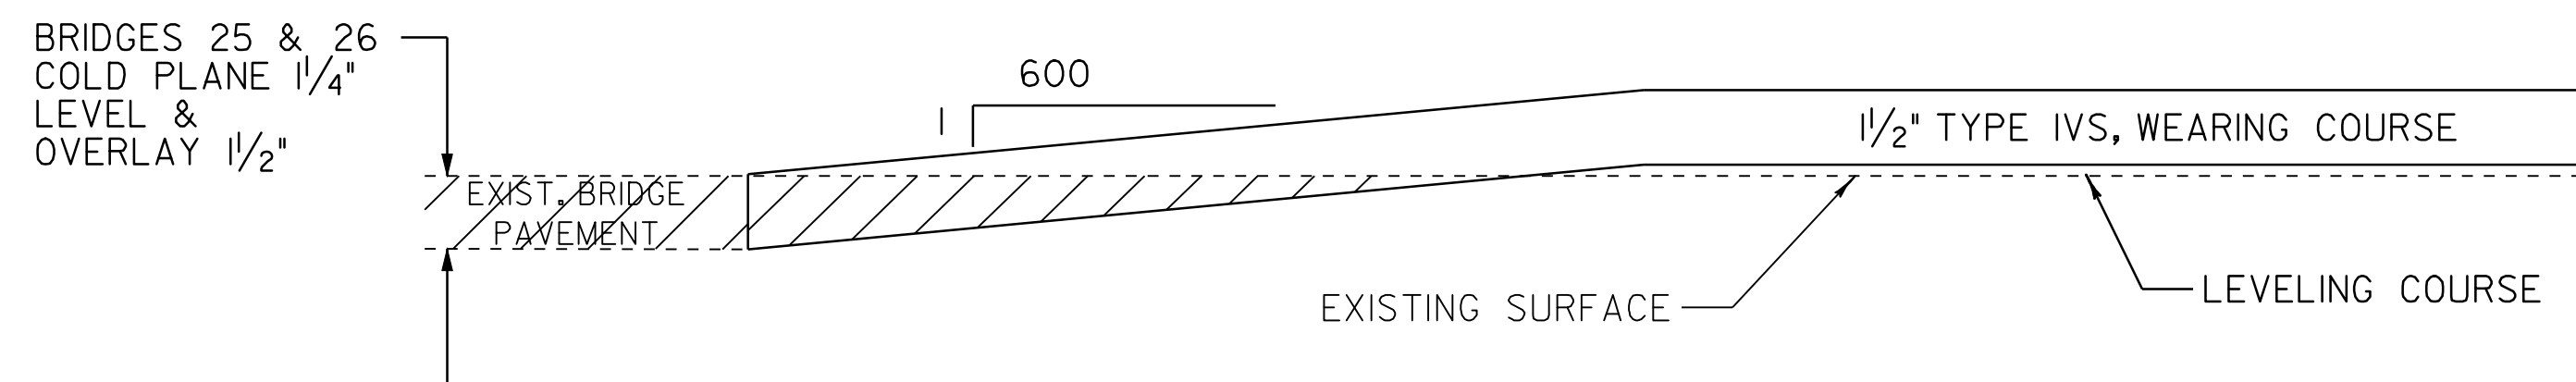

BRIDGE COLD PLANE DETAIL

NOT TO SCALE

LUDLOW
 BRIDGE #25 - STA 101+63 TO 102+49
 BRIDGE #26 - STA 118+06 TO 118+55

NOTES:
 THE CONTRACTOR SHALL TAKE PRECAUTIONS TO AVOID THE ACCUMULATION OF DEBRIS IN THE DRAINAGE STRUCTURES LOCATED AT CURB LINE AND IN THE EXPANSION JOINTS. THE CONTRACTOR SHALL EXAMINE THESE BRIDGE FEATURES ON A REGULAR BASIS TO ENSURE THAT DEBRIS HAS NOT ACCUMULATED. ANY DEBRIS WHICH IS PRESENT SHALL BE REMOVED BY THE CONTRACTOR AT NO COST TO THE STATE.

DATUM	
VERTICAL	N/A
HORIZONTAL	N/A

PROJECT TYPICAL SHEET 2	SURVEYED BY <u>CLD</u> DATE <u>11/05</u>
	DRAWN BY <u>MRS</u> DATE <u>5/06</u>
	SQUAD LEADER <u>PTS</u>
	DESIGN FILE NO. <u>/pave/05B008/pb008.dgn</u>
	IPARM FILE <u>pb008ty02.i</u> DATE PLOTTED <u>2010-05-14</u>
PROJ. NAME <u>LUDLOW</u>	
PROJ. NO. <u>NH 2409(1)S</u>	
SHEET <u>4</u> OF <u>51</u> SHEETS	