

TEMPORARY 4" WHITE LINE, PAINT  
 DURABLE 4" WHITE LINE, THERMOPLASTIC  
 STA 70+50 TO 75+50 SOLID LT & RT

TEMPORARY LETTER OR SYMBOL, PAINT  
 DURABLE LETTER OR SYMBOL, TYPE I TAPE  
 STA 74+59 RT - "SCHOOL"


CHANGING ELEVATION OF SEWER MANHOLES  
 STA 71+71 RT  
 STA 74+71 RT

REMOVING SIGNS  
 AS SHOWN - 5

TEMPORARY 4" YELLOW LINE, PAINT  
 DURABLE 4" YELLOW LINE, THERMOPLASTIC  
 STA 70+50 TO 75+50 SOLID LT & RT

FLASHING BEACON, GROUND MOUNTED  
 STA 74+56 RT

CHANGE ELEVATION OF CATCH BASIN, D.I.  
 75+50 LT

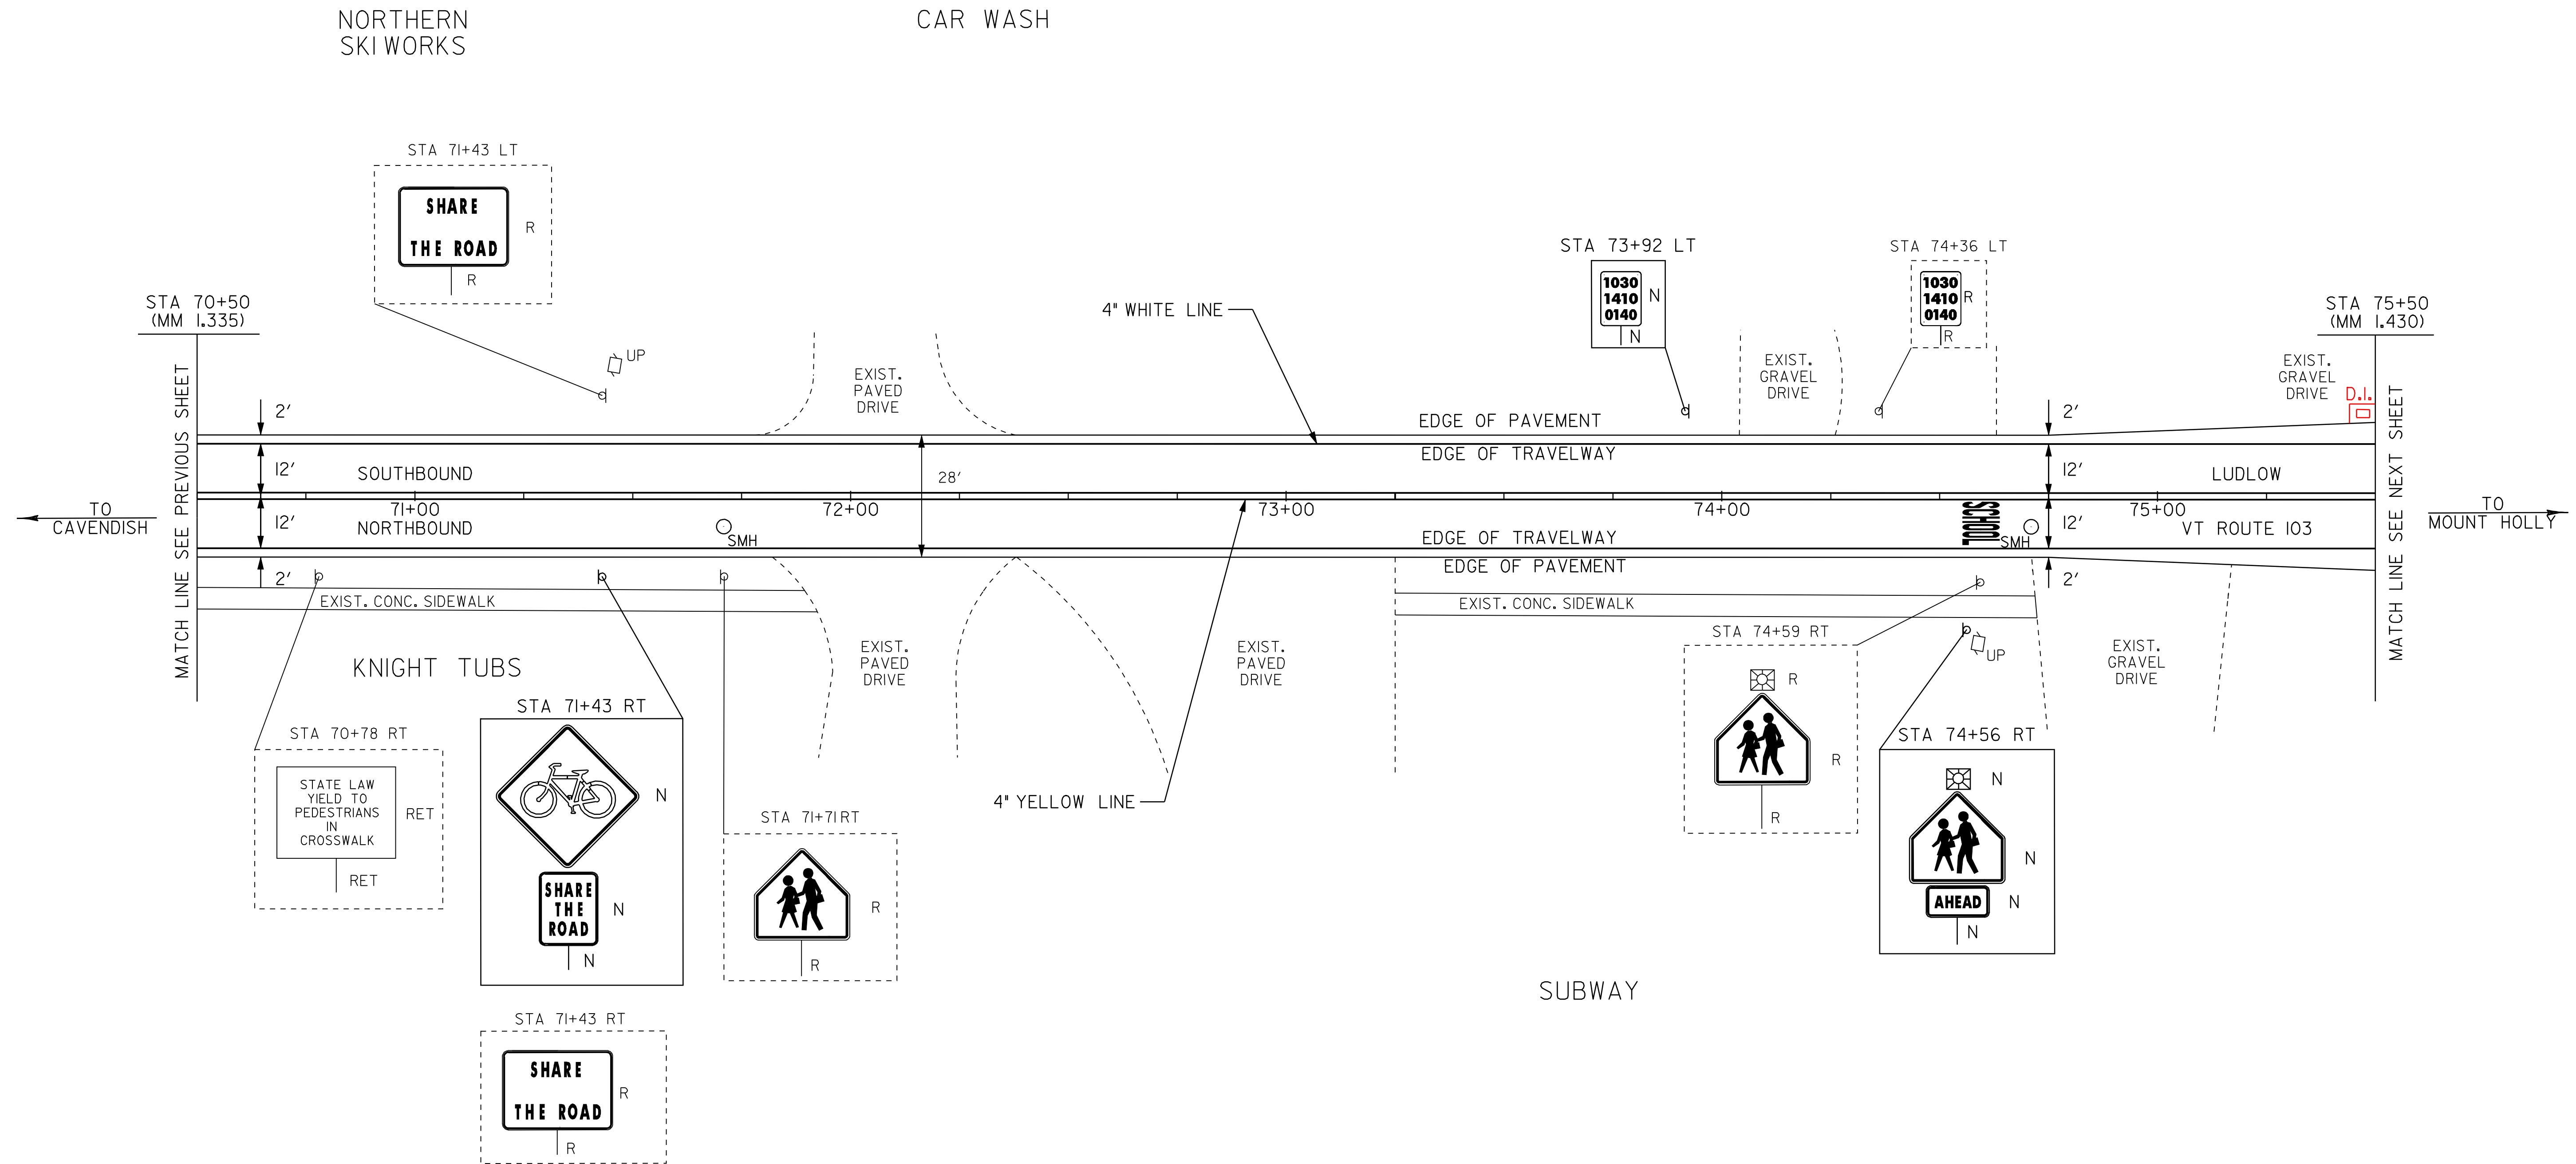

NOT TO SCALE

LEGEND

- R = REMOVE EXISTING
- S = SALVAGE
- R&S = REMOVE AND SALVAGE
- N = NEW
- RET = RETAIN
- B-B = BACK TO BACK
- = NEW RAIL
- = EXISTING RAIL

**PAVING  
 PROJECT  
 LAYOUT #2**

PROJECT:	<u>LUDLOW</u>	PROJECT NO.:	<u>NH_2409(I)S</u>
DESIGN FILE NAME:	/pave/05B008/pb008.dgn	PLOT DATE:	20-MAY-2010 14:3
IPARM FILE NAME:	pb008la02.i	SURVEY DATE:	11/20/05
SURVEYED BY:	CLD_ENGINEERS, INC	DRAWN BY:	MRS
SQUAD LEADER:	PIS		
CLD_REF_NO.:	05-0389	SHEET:	13 OF 51