

TEMPORARY 4" WHITE LINE, PAINT  
 STA 95+50 TO 97+47 SOLID LT  
 STA 95+50 TO 97+02 SOLID RT  
 STA 97+12 TO 98+58 SOLID RT  
 STA 97+27 TO 97+47 SOLID LT NO PARKING  
 STA 97+65 TO 97+85 SOLID LT NO PARKING  
 STA 97+65 TO 98+58 SOLID LT  
 STA 98+66 TO 101+50 SOLID LT  
 STA 98+66 TO 99+78 SOLID RT  
 STA 100+04 TO 100+44 SOLID RT ( TH 314)  
 STA 100+61 TO 101+50 SOLID RT

DURABLE 4" WHITE LINE, THERMOPLASTIC  
 STA 95+50 TO 97+47 SOLID LT  
 STA 95+50 TO 97+02 SOLID RT  
 STA 97+12 TO 98+58 SOLID RT  
 STA 97+27 TO 97+47 SOLID LT NO PARKING  
 STA 97+65 TO 98+58 SOLID LT  
 STA 97+65 TO 97+85 SOLID LT NO PARKING  
 STA 98+66 TO 101+50 SOLID LT  
 STA 98+66 TO 99+78 SOLID RT  
 STA 100+04 TO 100+44 SOLID RT ( TH 314)  
 STA 100+61 TO 101+50 SOLID RT

TEMPORARY 4" YELLOW LINE, PAINT  
 DURABLE 4" YELLOW LINE, THERMOPLASTIC  
 STA 95+50 TO 96+24 SOLID LT & RT  
 STA 96+57 TO 97+06 DOUBLE SOLID RT ( SA 4)  
 STA 96+64 TO 97+36 SOLID LT & RT  
 STA 97+76 TO 98+58 SOLID LT & RT  
 STA 98+66 TO 99+95 SOLID LT & RT  
 STA 99+88 TO 100+08 DOUBLE SOLID RT ( TH 314)  
 STA 100+35 TO 101+50 SOLID LT & RT

TEMPORARY 24" STOP BAR, PAINT  
 DURABLE 24" STOP BAR, TYPE ITAPE  
 STA 96+62 RT ( SA 4)  
 STA 100+08 RT ( TH 314)

TEMPORARY LETTER OR SYMBOL, PAINT  
 DURABLE LETTER OR SYMBOL, TYPE ITAPE  
 STA 96+70 RT - "STOP"  
 STA 97+94 LT - DISABLED MARKING  
 STA 100+17 RT - "STOP"

TEMPORARY CROSSWALK MARKING, PAINT  
 STA 97+47 TO 97+65 LT  
 STA 98+62 LT TO RT  
 STA 99+81 TO 100+68 RT

SPECIAL PROVISION  
 (DURABLE CROSSWALK MARKING, IMPRINTED/COLORIZED)  
 STA 97+47 TO 97+65 LT  
 STA 98+62 LT TO RT  
 STA 99+81 TO 100+68 RT

CONSTRUCT SIDEWALK RAMP W/DETECTABLE  
 WARNING SURFACE (CAST IRON)  
 STA 97+47 LT ( TYPE 1)  
 STA 97+65 LT ( TYPE 1)  
 STA 98+62 LT ( TYPE 6)  
 STA 98+62 RT ( TYPE 2)  
 STA 99+81 RT ( TYPE 1)  
 STA 100+68 RT ( TYPE 6)

CHANGING ELEVATION OF DROP INLETS,  
 CATCH BASINS OR MANHOLES  
 STA 99+75 RT ( CB)  
 STA 100+13 LT ( CB)













CHANGING ELEVATION OF SEWER MANHOLES  
 STA 95+64 RT  
 STA 100+13 LT

ADJUST ELEVATION OF VALVE BOX  
 STA 96+36 LT ( WSO)  
 STA 96+58 RT ( WSO)  
 STA 100+53 RT ( WSO)  
 95+54 LT

PORTLAND CEMENT CONCRETE SIDEWALK, 5 INCH  
 STA 101+20 TO 101+50 LT  
 STA 101+41 TO 101+50 RT

REMOVING SIGNS  
 AS SHOWN - 17

ERECTING SALVAGED SIGNS  
 AS SHOWN - 1

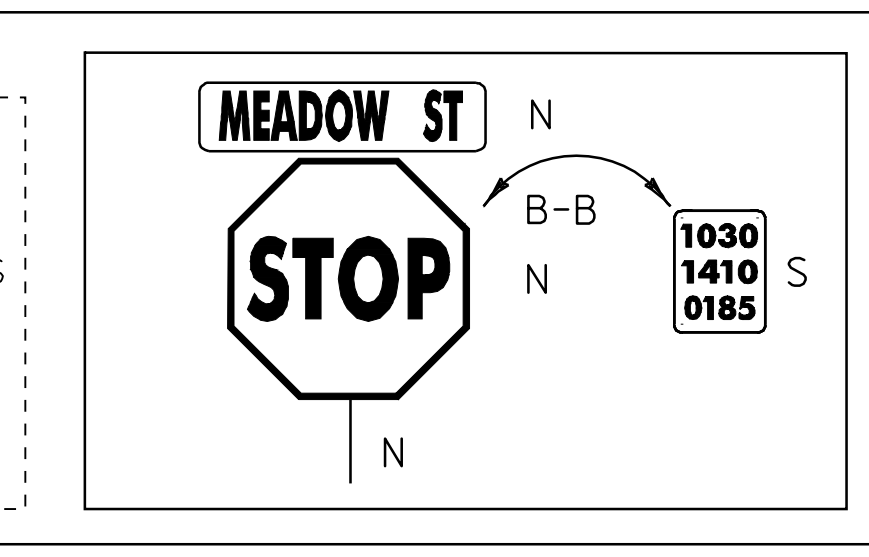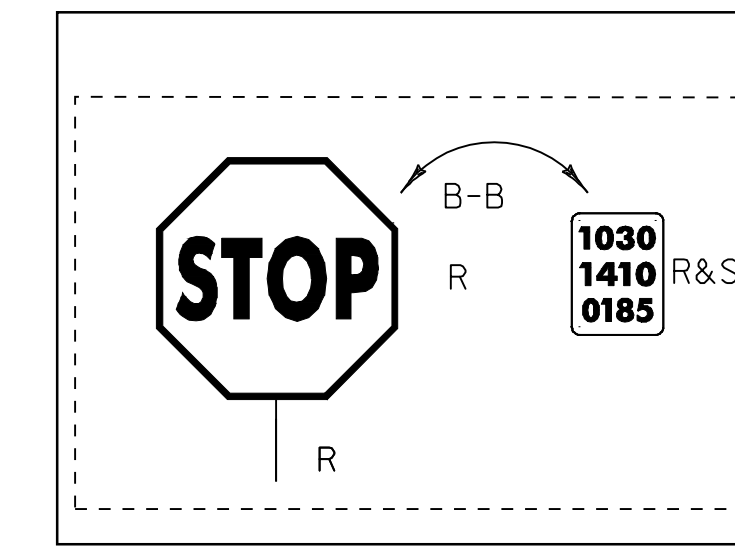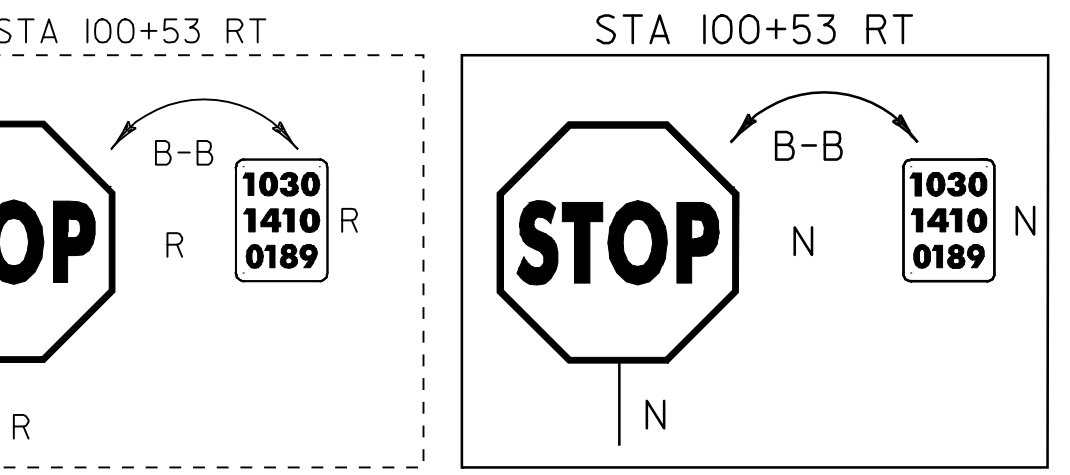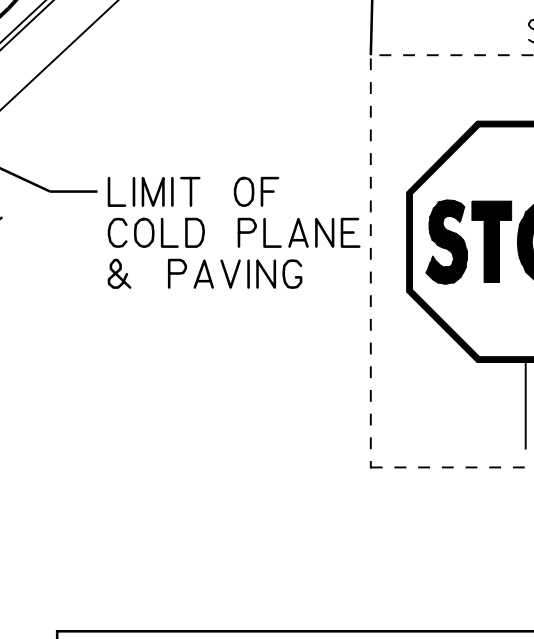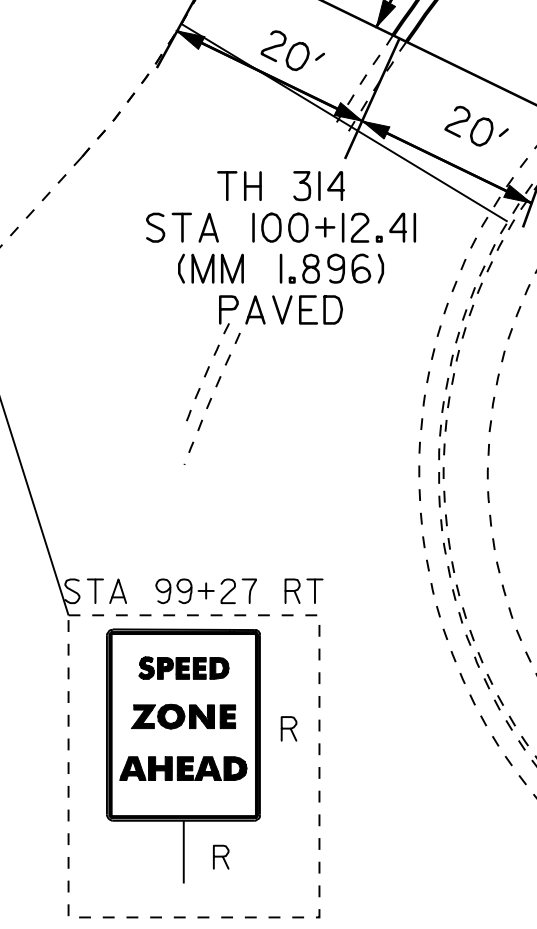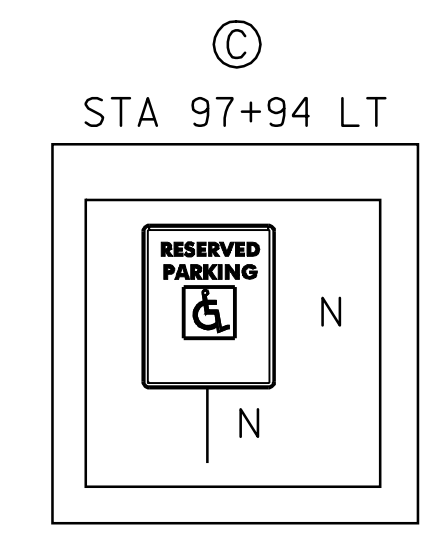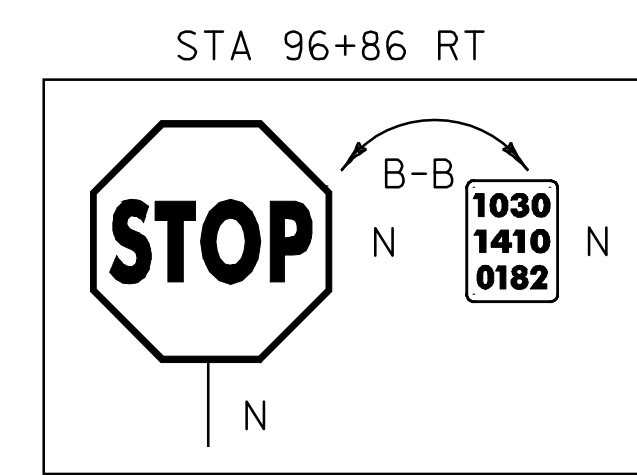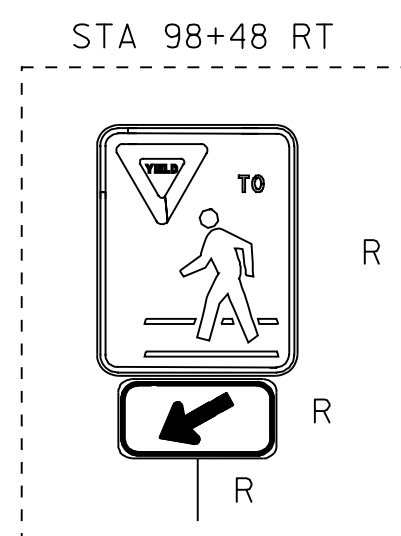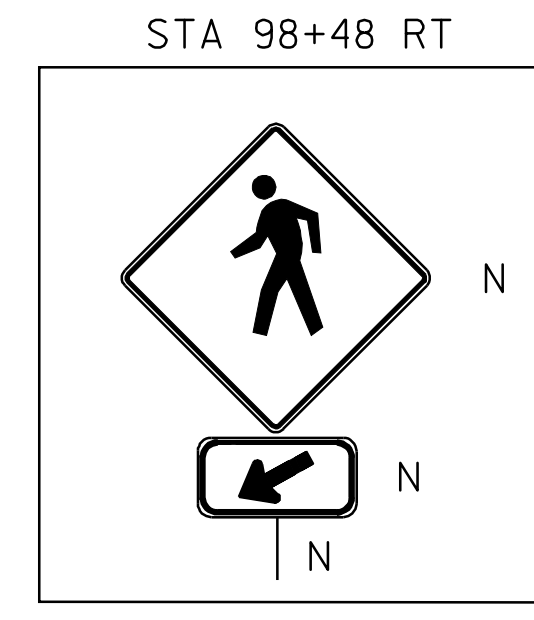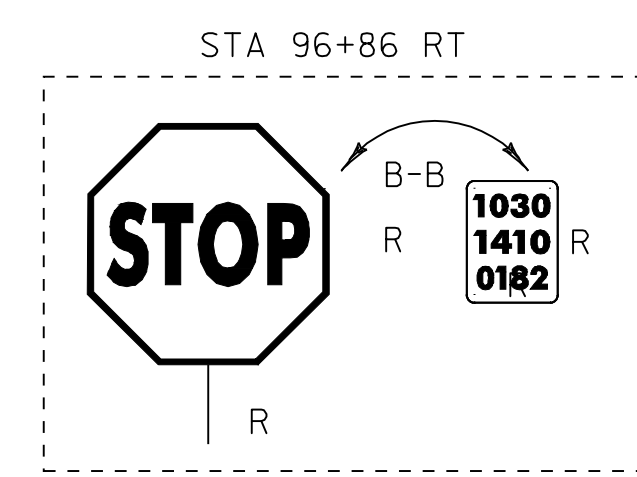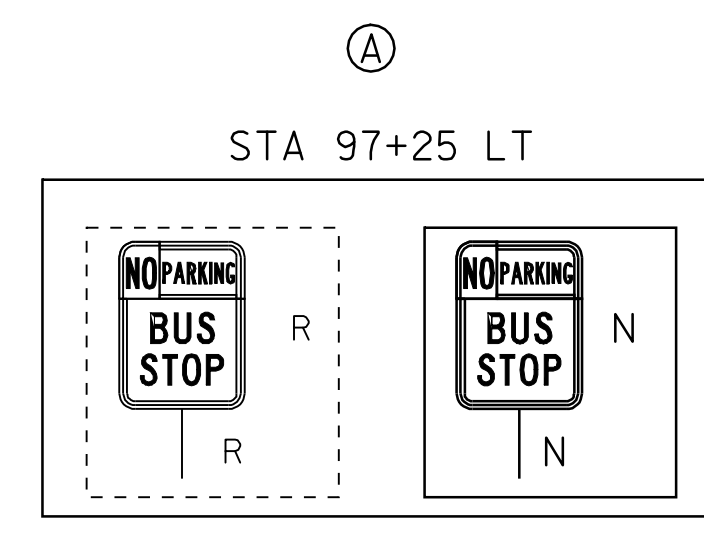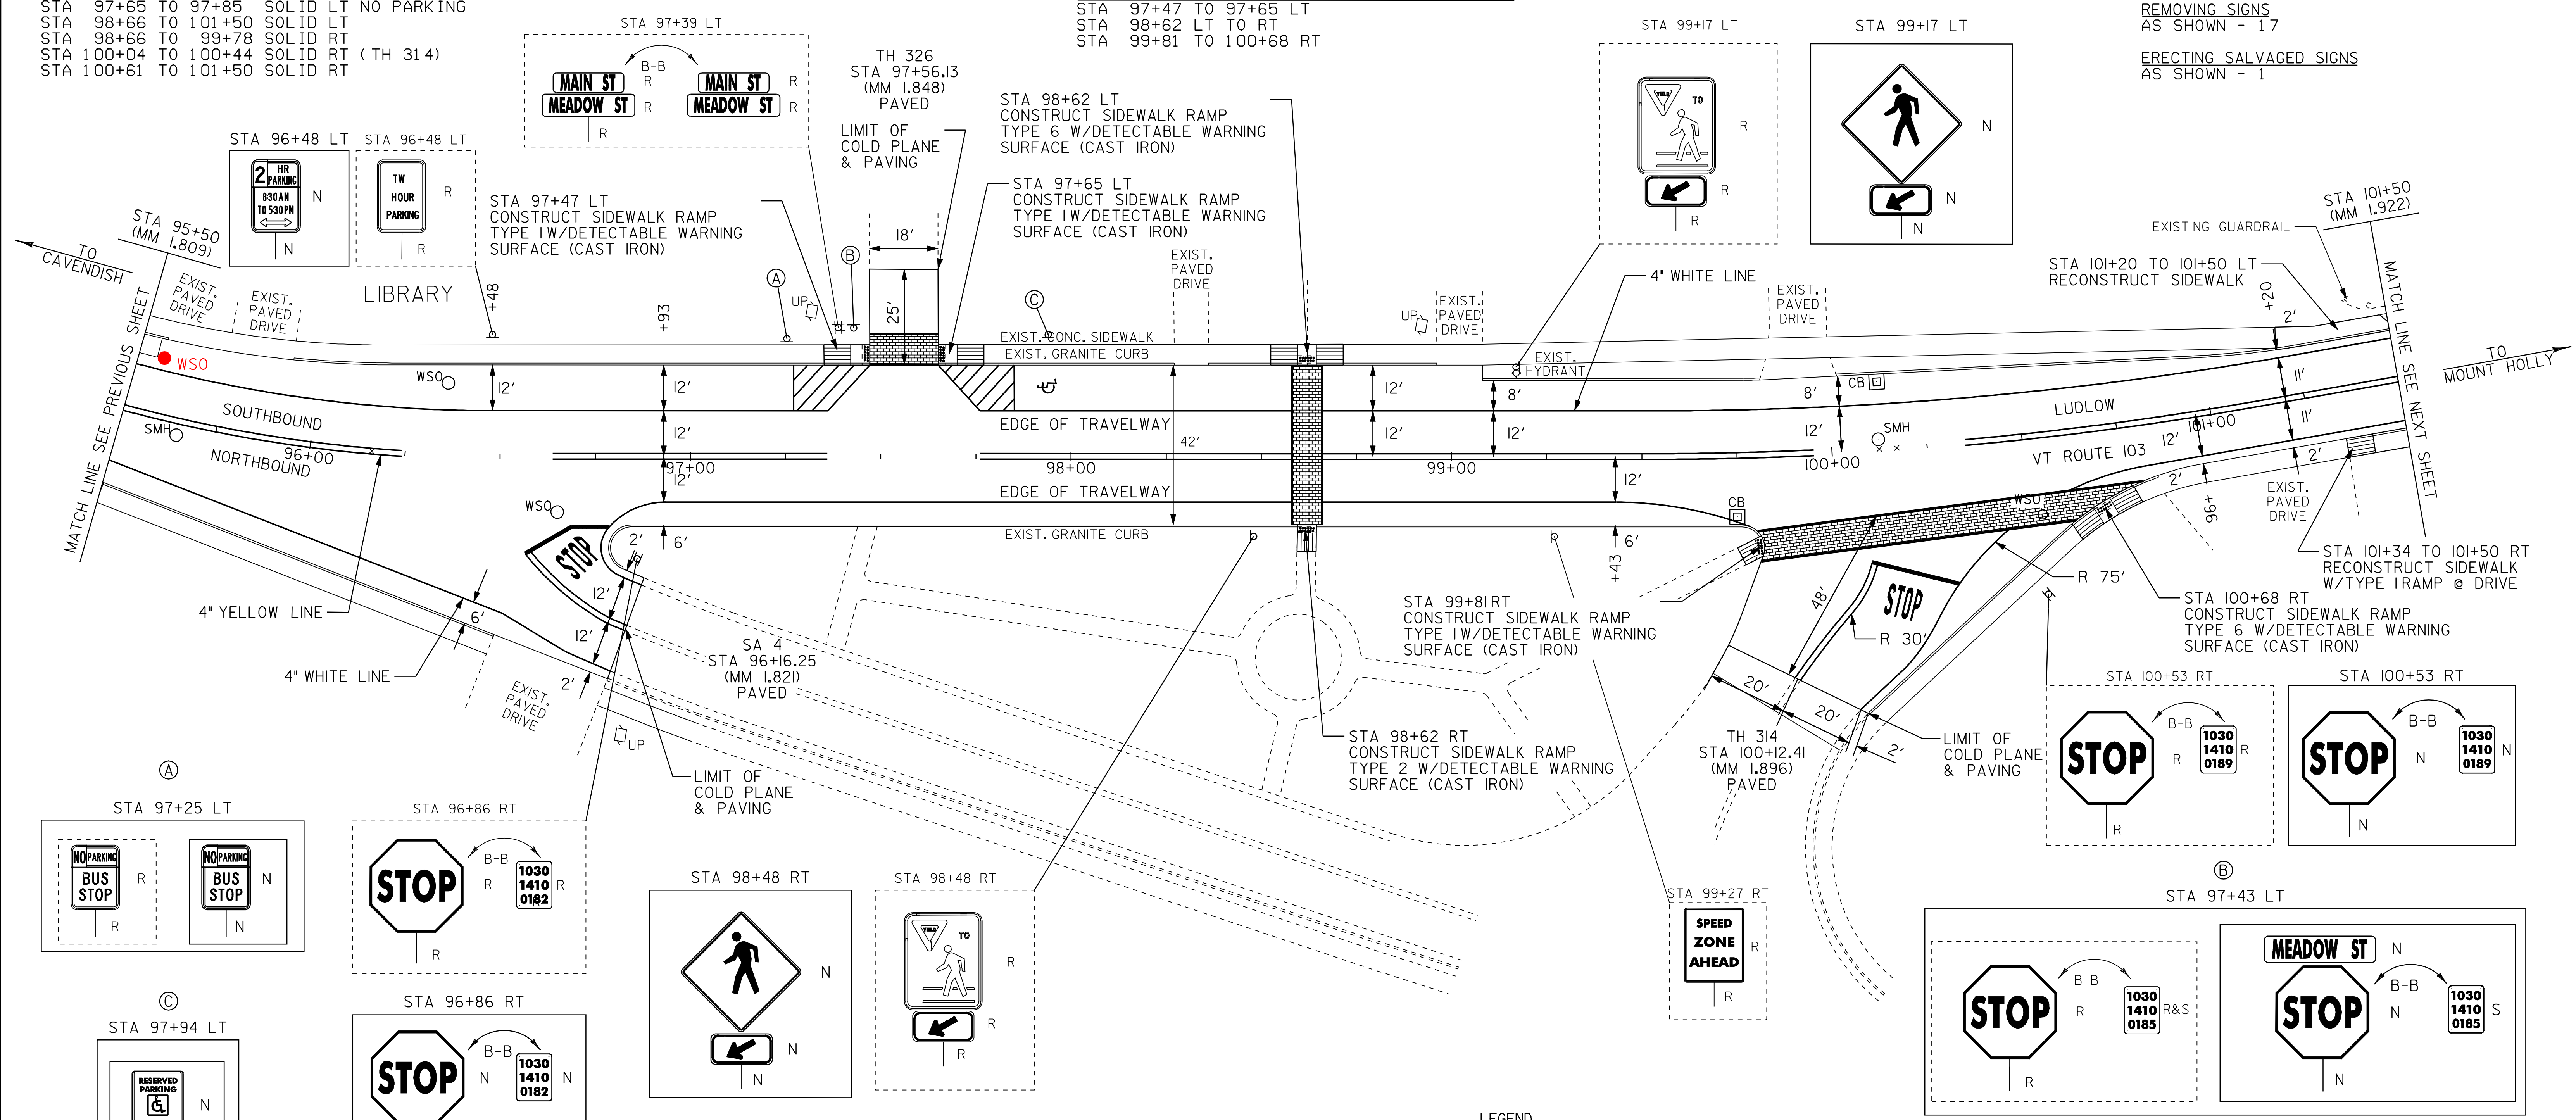

- LEGEND
- R = REMOVE EXISTING
  - S = SALVAGE
  - R&S = REMOVE AND SALVAGE
  - N = NEW
  - RET = RETAIN
  - B-B = BACK TO BACK
  - = NEW RAIL
  - - - = EXISTING RAIL

<h3>PAVING PROJECT LAYOUT #7</h3>	PROJECT: LUDLOW	PROJECT NO.: NH 2409(I)S
	DESIGN FILE NAME: /pave/05B008/pb008.dgn	PLOT DATE: 20-MAY-2010 14:3
	IPARM FILE NAME: pb008la07.1	SURVEY DATE: 11/05
	SQUAD LEADER: PIS	DRAWN BY: MRS
CLD REF. NO.: 05-0389	SHEET: 18 OF 51	

NOT TO SCALE