

TEMPORARY 4" WHITE LINE, PAINT  
 STA 101+50 TO 102+00 SOLID LT  
 STA 101+50 TO 102+00 SOLID RT  
 STA 104+25 TO 104+57 SOLID LT PARKING  
 STA 104+57 TO 104+72 SOLID LT NO PARKING  
 STA 104+85 TO 104+95 SOLID LT NO PARKING  
 STA 104+86 TO 104+98 SOLID RT NO PARKING  
 STA 104+95 TO 105+58 SOLID LT PARKING  
 STA 104+98 TO 105+61 SOLID RT PARKING  
 STA 105+58 TO 105+70 SOLID LT NO PARKING  
 STA 105+61 TO 105+72 SOLID RT NO PARKING  
 STA 105+76 TO 105+89 SOLID LT NO PARKING  
 STA 105+89 TO 106+31 SOLID LT PARKING  
 STA 105+93 TO 106+02 SOLID RT NO PARKING  
 STA 106+02 TO 106+44 SOLID RT PARKING  
 STA 106+31 TO 106+44 SOLID LT NO PARKING  
 STA 106+44 TO 106+52 SOLID RT NO PARKING  
 STA 106+64 TO 106+81 SOLID LT NO PARKING  
 STA 106+67 TO 106+82 SOLID RT NO PARKING  
 STA 106+81 TO 107+00 SOLID LT PARKING  
 STA 106+82 TO 107+00 SOLID RT PARKING


DURABLE 4" WHITE LINE, THERMOPLASTIC  
 STA 104+25 TO 104+57 SOLID LT PARKING  
 STA 104+57 TO 104+72 SOLID LT NO PARKING  
 STA 104+85 TO 104+95 SOLID LT NO PARKING  
 STA 104+86 TO 104+98 SOLID RT NO PARKING  
 STA 104+95 TO 105+58 SOLID LT PARKING  
 STA 104+98 TO 105+61 SOLID RT PARKING  
 STA 105+58 TO 105+70 SOLID LT NO PARKING  
 STA 105+61 TO 105+72 SOLID RT NO PARKING  
 STA 105+76 TO 105+89 SOLID LT NO PARKING  
 STA 105+89 TO 106+31 SOLID LT PARKING  
 STA 105+93 TO 106+02 SOLID RT NO PARKING  
 STA 106+02 TO 106+44 SOLID RT PARKING  
 STA 106+31 TO 106+44 SOLID LT NO PARKING  
 STA 106+44 TO 106+52 SOLID RT NO PARKING  
 STA 106+64 TO 106+81 SOLID LT PARKING  
 STA 106+67 TO 106+82 SOLID RT NO PARKING  
 STA 106+81 TO 107+00 SOLID LT PARKING  
 STA 106+82 TO 107+00 SOLID RT PARKING

TEMPORARY 4" YELLOW LINE, PAINT  
 DURABLE 4" YELLOW LINE, THERMOPLASTIC  
 STA 101+50 TO 102+00 SOLID LT & RT  
 STA 104+25 TO 107+00 SOLID LT & RT  
  
 CHANGE ELEVATION OF SEWER MANHOLES  
 STA 106+20 LT  
  
 PORTLAND CEMENT CONCRETE SIDEWALK, 5 INCH  
 STA 101+50 TO 101+52 LT  
 STA 101+50 TO 101+78 RT  
  
 REMOVING SIGNS  
 AS SHOWN - 3  
  
 ADJUST ELEVATION OF VALVE BOX  
 I04+70 LT

DURABLE 4" WHITE LINE, THERMOPLASTIC  
 STA 101+50 TO 102+00 SOLID LT  
 STA 101+50 TO 102+00 SOLID RT

TH 328  
 STA 102+60.56  
 (MM 1,943)  
 PAVED

SEE INTERSECTION DETAIL SHEET 30

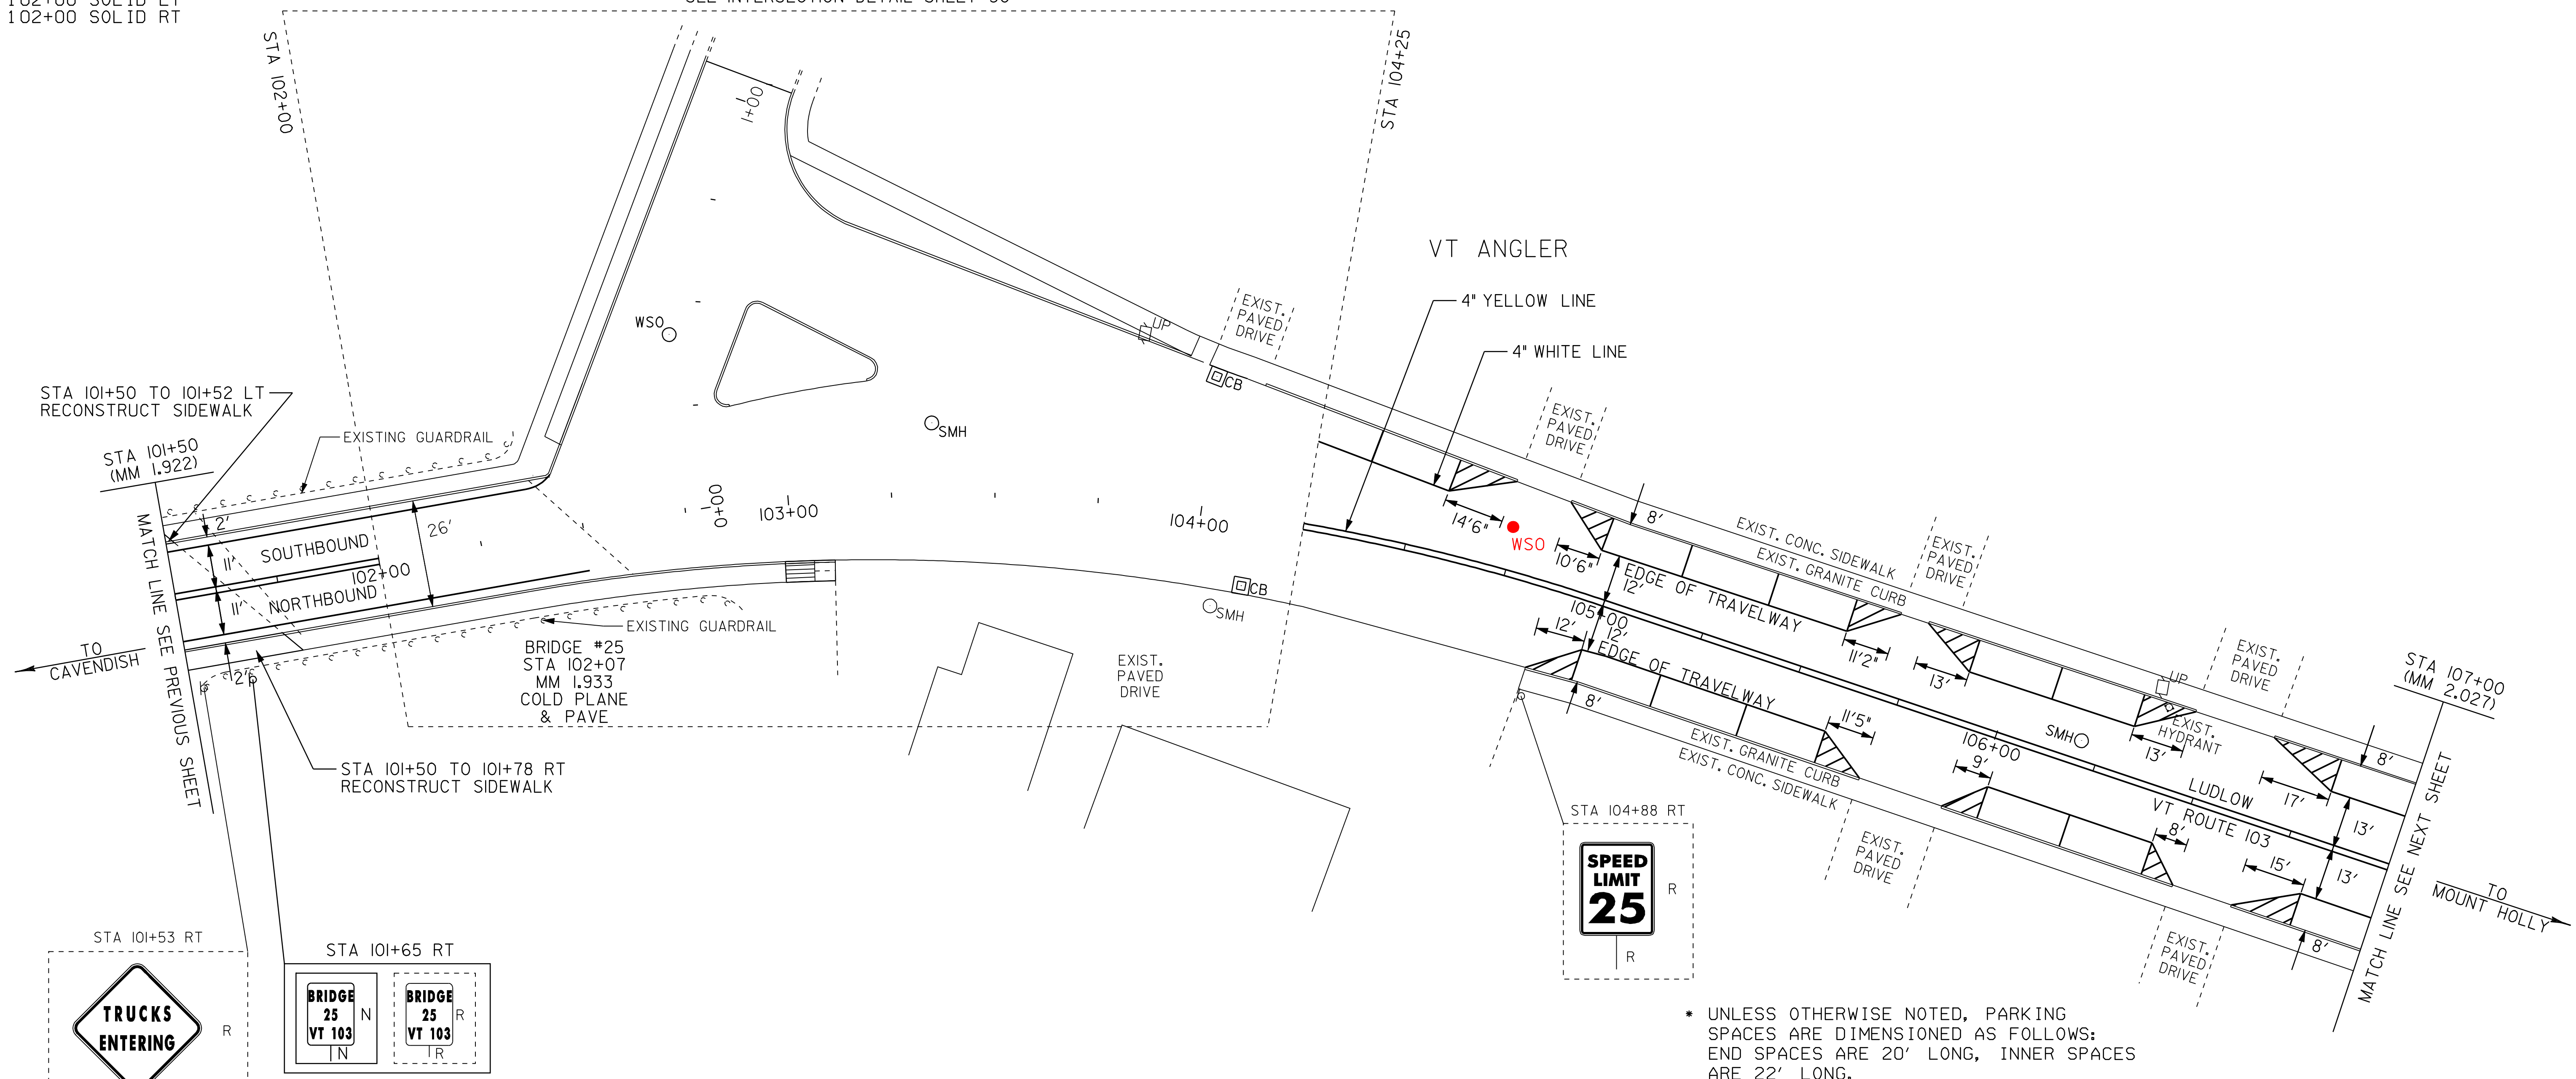

\* UNLESS OTHERWISE NOTED, PARKING SPACES ARE DIMENSIONED AS FOLLOWS: END SPACES ARE 20' LONG, INNER SPACES ARE 22' LONG.

- LEGEND**
- R = REMOVE EXISTING
  - S = SALVAGE
  - R&S = REMOVE AND SALVAGE
  - N = NEW
  - RET = RETAIN
  - B-B = BACK TO BACK
  - = NEW RAIL
  - — — = EXISTING RAIL

<b>PAVING PROJECT LAYOUT #8</b>	PROJECT: LUDLOW	PROJECT NO.: NH 2409(I)S
	DESIGN FILE NAME: /pave/05B008/pb008.dgn	PLOT DATE: 20-MAY-2010 14:3
	IPARM FILE NAME: pb008la08.l	SURVEY DATE: 11/2005
	SURVEYED BY: CLD_ENGINEERS, INC	DRAWN BY: MRS
SQUAD LEADER: PIS	CLD REF. NO.: 05-0389	SHEET: 19 OF 51

NOT TO SCALE