

TEMPORARY 4" WHITE LINE, PAINT
 DURABLE 4" WHITE LINE, THERMOPLASTIC

STA 107+00 TO 107+44 SOLID RT PARKING
 STA 107+00 TO 107+65 SOLID LT PARKING
 STA 107+44 TO 107+58 SOLID RT NO PARKING
 STA 107+65 TO 107+82 SOLID LT NO PARKING
 STA 108+08 TO 108+13 SOLID LT NO PARKING
 STA 108+13 TO 108+94 SOLID LT PARKING
 STA 108+45 TO 108+85 SOLID RT PARKING
 STA 108+94 TO 108+97 SOLID LT NO PARKING
 STA 109+12 TO 109+18 SOLID LT NO PARKING
 STA 109+18 TO 109+58 SOLID LT PARKING
 STA 109+46 TO 109+86 SOLID RT PARKING
 STA 109+58 TO 109+70 SOLID LT NO PARKING
 STA 109+70 TO 109+90 SOLID LT PARKING
 STA 109+90 TO 110+02 SOLID LT NO PARKING
 STA 110+13 TO 110+27 SOLID LT NO PARKING
 STA 110+17 TO 110+57 SOLID RT PARKING
 STA 110+27 TO 111+33 SOLID LT PARKING
 STA 111+01 TO 111+06 SOLID RT NO PARKING
 STA 111+06 TO 112+00 SOLID RT PARKING
 STA 111+33 TO 111+45 SOLID LT NO PARKING
 STA 111+70 TO 111+76 SOLID LT NO PARKING
 STA 111+76 TO 112+00 SOLID LT PARKING

TEMPORARY 4" YELLOW LINE, PAINT
 DURABLE 4" YELLOW LINE, THERMOPLASTIC

STA 107+00 TO 107+82 SOLID LT & RT
 STA 107+90 TO 112+00 SOLID LT & RT

TEMPORARY LETTER OR SYMBOL, PAINT
 DURABLE LETTER OR SYMBOL, TYPE ITAPE
 STA 107+34 RT - DISABLED MARKING
 (PAID AS 2 SYMBOLS)

DURABLE 8" WHITE LINE, THERMOPLASTIC
 STA 107+58 TO 109+70 SOLID LT - SHOULDER HATCHING

TEMPORARY 8" WHITE LINE, PAINT
 STA 107+58 TO 109+70 SOLID LT - SHOULDER HATCHING

TEMPORARY CROSSWALK MARKING, PAINT
 STA 107+86 LT TO RT

SPECIAL PROVISION
 (DURABLE CROSSWALK MARKING, IMPRINTED/COLORIZED)
 STA 107+86 LT TO RT


CONSTRUCT SIDEWALK RAMP W/DETECTABLE WARNING SURFACE (CAST IRON)
 STA 107+86 LT (TYPE 6)
 STA 107+86 RT (TYPE 6)

CHANGING ELEVATION OF DROP INLETS,
 CATCH BASINS OR MANHOLES
 STA 109+40 RT (CB)
 STA 111+80 RT (CB)
~~STA 111+80 RT (DMH)~~

CHANGE ELEVATION OF SEWER MANHOLES
 STA 110+45 CL
 STA 111+75 RT

ADJUST ELEVATION OF VALVE BOX
 107+65 LT
 110+05 LT

REMOVING SIGNS
 AS SHOWN -2

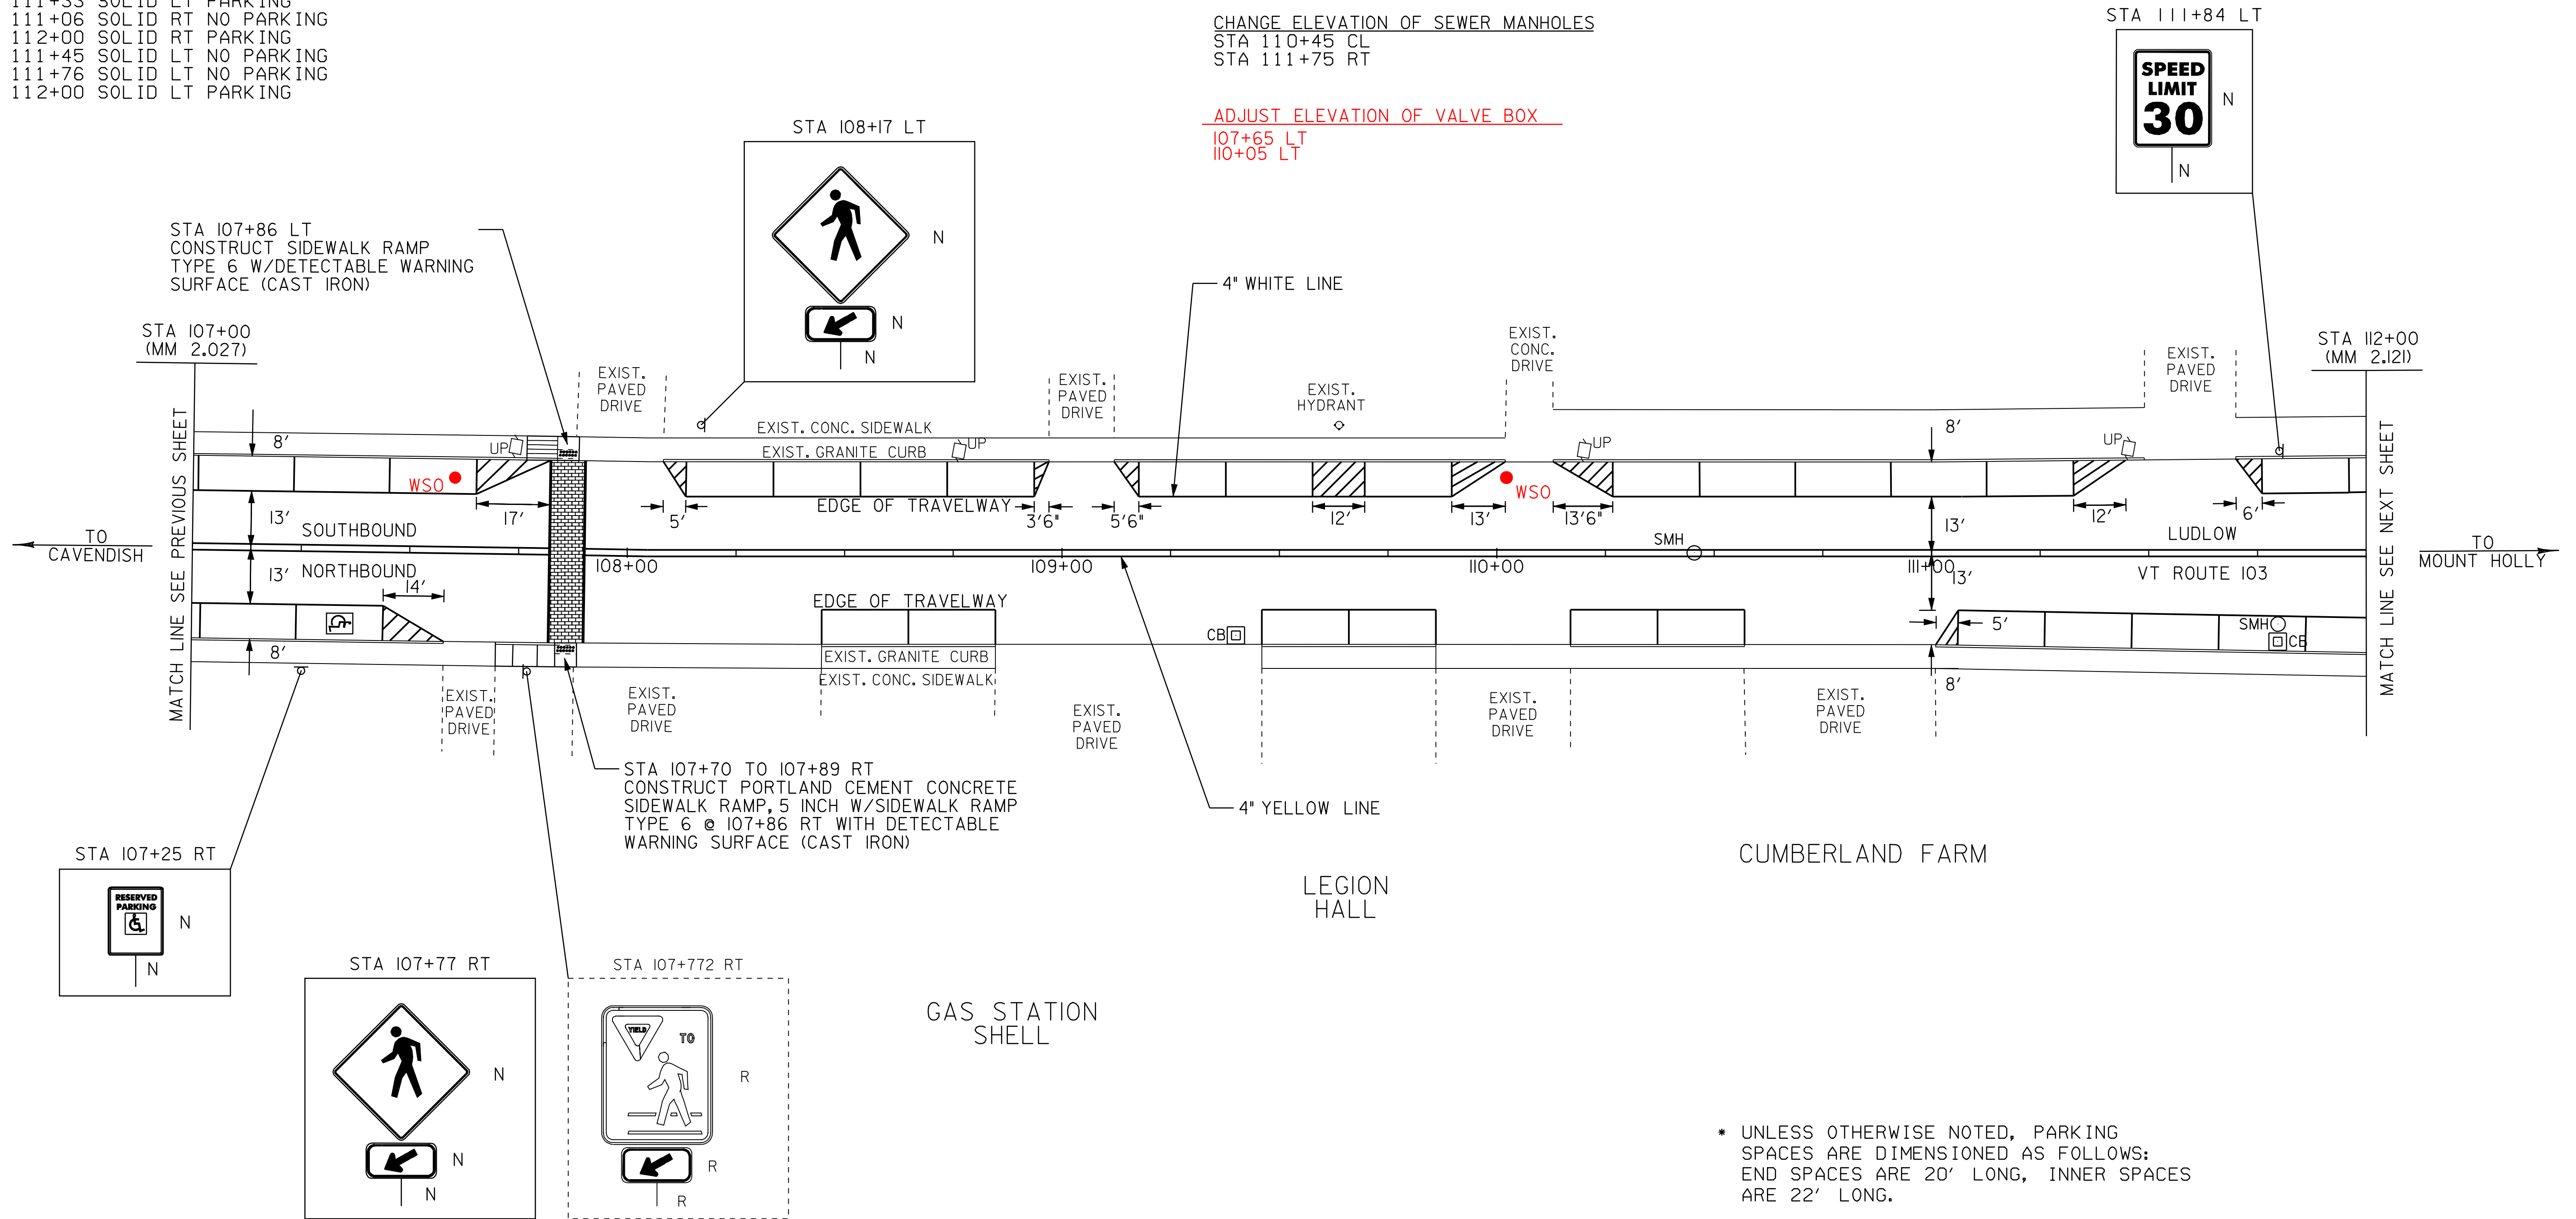

* UNLESS OTHERWISE NOTED, PARKING SPACES ARE DIMENSIONED AS FOLLOWS: END SPACES ARE 20' LONG, INNER SPACES ARE 22' LONG.

LEGEND

R	=	REMOVE EXISTING
S	=	SALVAGE
R&S	=	REMOVE AND SALVAGE
N	=	NEW
RET	=	RETAIN
B-B	=	BACK TO BACK
—○—	=	NEW RAIL
—●—	=	EXISTING RAIL

NOT TO SCALE

PAVING PROJECT LAYOUT #9

PROJECT: LUDLOW

DESIGN FILE NAME: /pave/05B008/pb008.dgn

IPARM FILE NAME: pb008la09.1

SURVEYED BY: CLD_ENGINEERS, INC

SQUAD LEADER: PIS

CLD REF. NO.: 05-0389

PROJECT NO.: NH_2409(I)S

PLOT DATE: 20-MAY-2010 14:3

SURVEY DATE: 11/205

DRAWN BY: MRS

SHEET: 20 OF 51