

TEMPORARY 4" WHITE LINE, PAINT
 DURABLE 4" WHITE LINE, THERMOPLASTIC
 STA 112+00 TO 112+26 SOLID RT PARKING
 STA 112+00 TO 112+36 SOLID LT PARKING
 STA 112+26 TO 112+32 SOLID RT NO PARKING
 STA 112+36 TO 112+41 SOLID LT NO PARKING
 STA 112+61 TO 112+85 SOLID LT NO PARKING
 STA 112+64 TO 112+77 SOLID RT NO PARKING
 STA 112+77 TO 113+40 SOLID RT PARKING
 STA 112+85 TO 113+47 SOLID LT PARKING
 STA 113+40 TO 113+60 SOLID RT NO PARKING
 STA 113+47 TO 113+68 SOLID LT NO PARKING
 STA 113+87 TO 113+97 SOLID LT NO PARKING (TH 330)
 STA 114+49 TO 114+91 SOLID LT NO PARKING
 STA 115+05 TO 115+10 SOLID LT NO PARKING
 STA 115+10 TO 115+51 SOLID LT PARKING
 STA 115+20 TO 115+25 SOLID RT NO PARKING
 STA 115+25 TO 115+64 SOLID RT PARKING
 STA 115+51 TO 115+63 SOLID LT NO PARKING
 STA 115+63 TO 116+48 SOLID LT PARKING
 STA 115+64 TO 115+69 SOLID RT NO PARKING
 STA 116+03 TO 116+08 SOLID RT NO PARKING
 STA 116+08 TO 116+48 SOLID RT PARKING
 STA 116+48 TO 116+50 SOLID LT NO PARKING
 STA 116+48 TO 116+50 SOLID RT NO PARKING


TEMPORARY 4" YELLOW LINE, PAINT
 DURABLE 4" YELLOW LINE, THERMOPLASTIC
 STA 112+00 TO 113+64 SOLID LT & RT
 STA 114+49 TO 116+50 SOLID LT & RT
 TEMPORARY 24" STOP BAR, PAINT
 DURABLE 24" STOP BAR, TYPE I TAPE
 STA 113+64 RT
 STA 114+05 LT (TH 330)
 STA 114+07 RT (TH 330)
 STA 114+49 LT

TEMPORARY CROSSWALK MARKING, PAINT
 STA 113+72 LT TO RT
 STA 113+87 TO 114+22 LT
 STA 113+89 TO 114+21 RT
 STA 114+40 LT TO RT
 SPECIAL PROVISION
 (DURABLE CROSSWALK MARKING, IMPRINTED/COLORIZED)
 STA 113+72 LT TO RT
 STA 113+87 TO 114+22 LT
 STA 113+89 TO 114+21 RT
 STA 114+40 LT TO RT
 CONSTRUCT SIDEWALK RAMP W/DETECTABLE
 WARNING SURFACE (CAST IRON)
 STA 113+85 RT (TYPE 6)
 STA 113+81 LT (TYPE 6)
 STA 114+25 RT (TYPE 6)
 STA 114+28 LT (TYPE 6)

CHANGING ELEVATION OF DROP INLETS,
 CATCH BASINS OR MANHOLES
~~STA 112+18 LT (CB)~~
~~STA 113+76 LT (CB)~~
 STA 113+89 LT (CB) (TH 330)
 STA 114+18 LT (CB) (TH 330)
~~STA 114+32 LT (CB)~~
 STA 116+08 RT (CB)
 CHANGE ELEVATION OF SEWER MANHOLES
 STA 113+65 RT (SMH)
 ADJUST ELEVATION OF VALVE BOX
 STA 112+68 LT (WSO)
 STA 113+68 LT (WSO)
 STA 113+80 LT (WSO)
 STA 113+97 LT (WSO) (TH 330)
 STA 114+12 RT (WSO) (TH 330)
 STA 114+77 RT (WSO)
 STA 115+53 LT (WSO)

REMOVING SIGNS
 AS SHOWN - 11
 REHAB CB,DI
 112+18 LT
 113+76 LT
 114+32 LT

TEMPORARY 8" WHITE LINE, PAINT
 STA 115+51 TO 115+63 SOLID LT SHOULDER HATCHING
 DURABLE 8" WHITE LINE, THERMOPLASTIC
 STA 115+51 TO 115+63 SOLID LT SHOULDER HATCHING

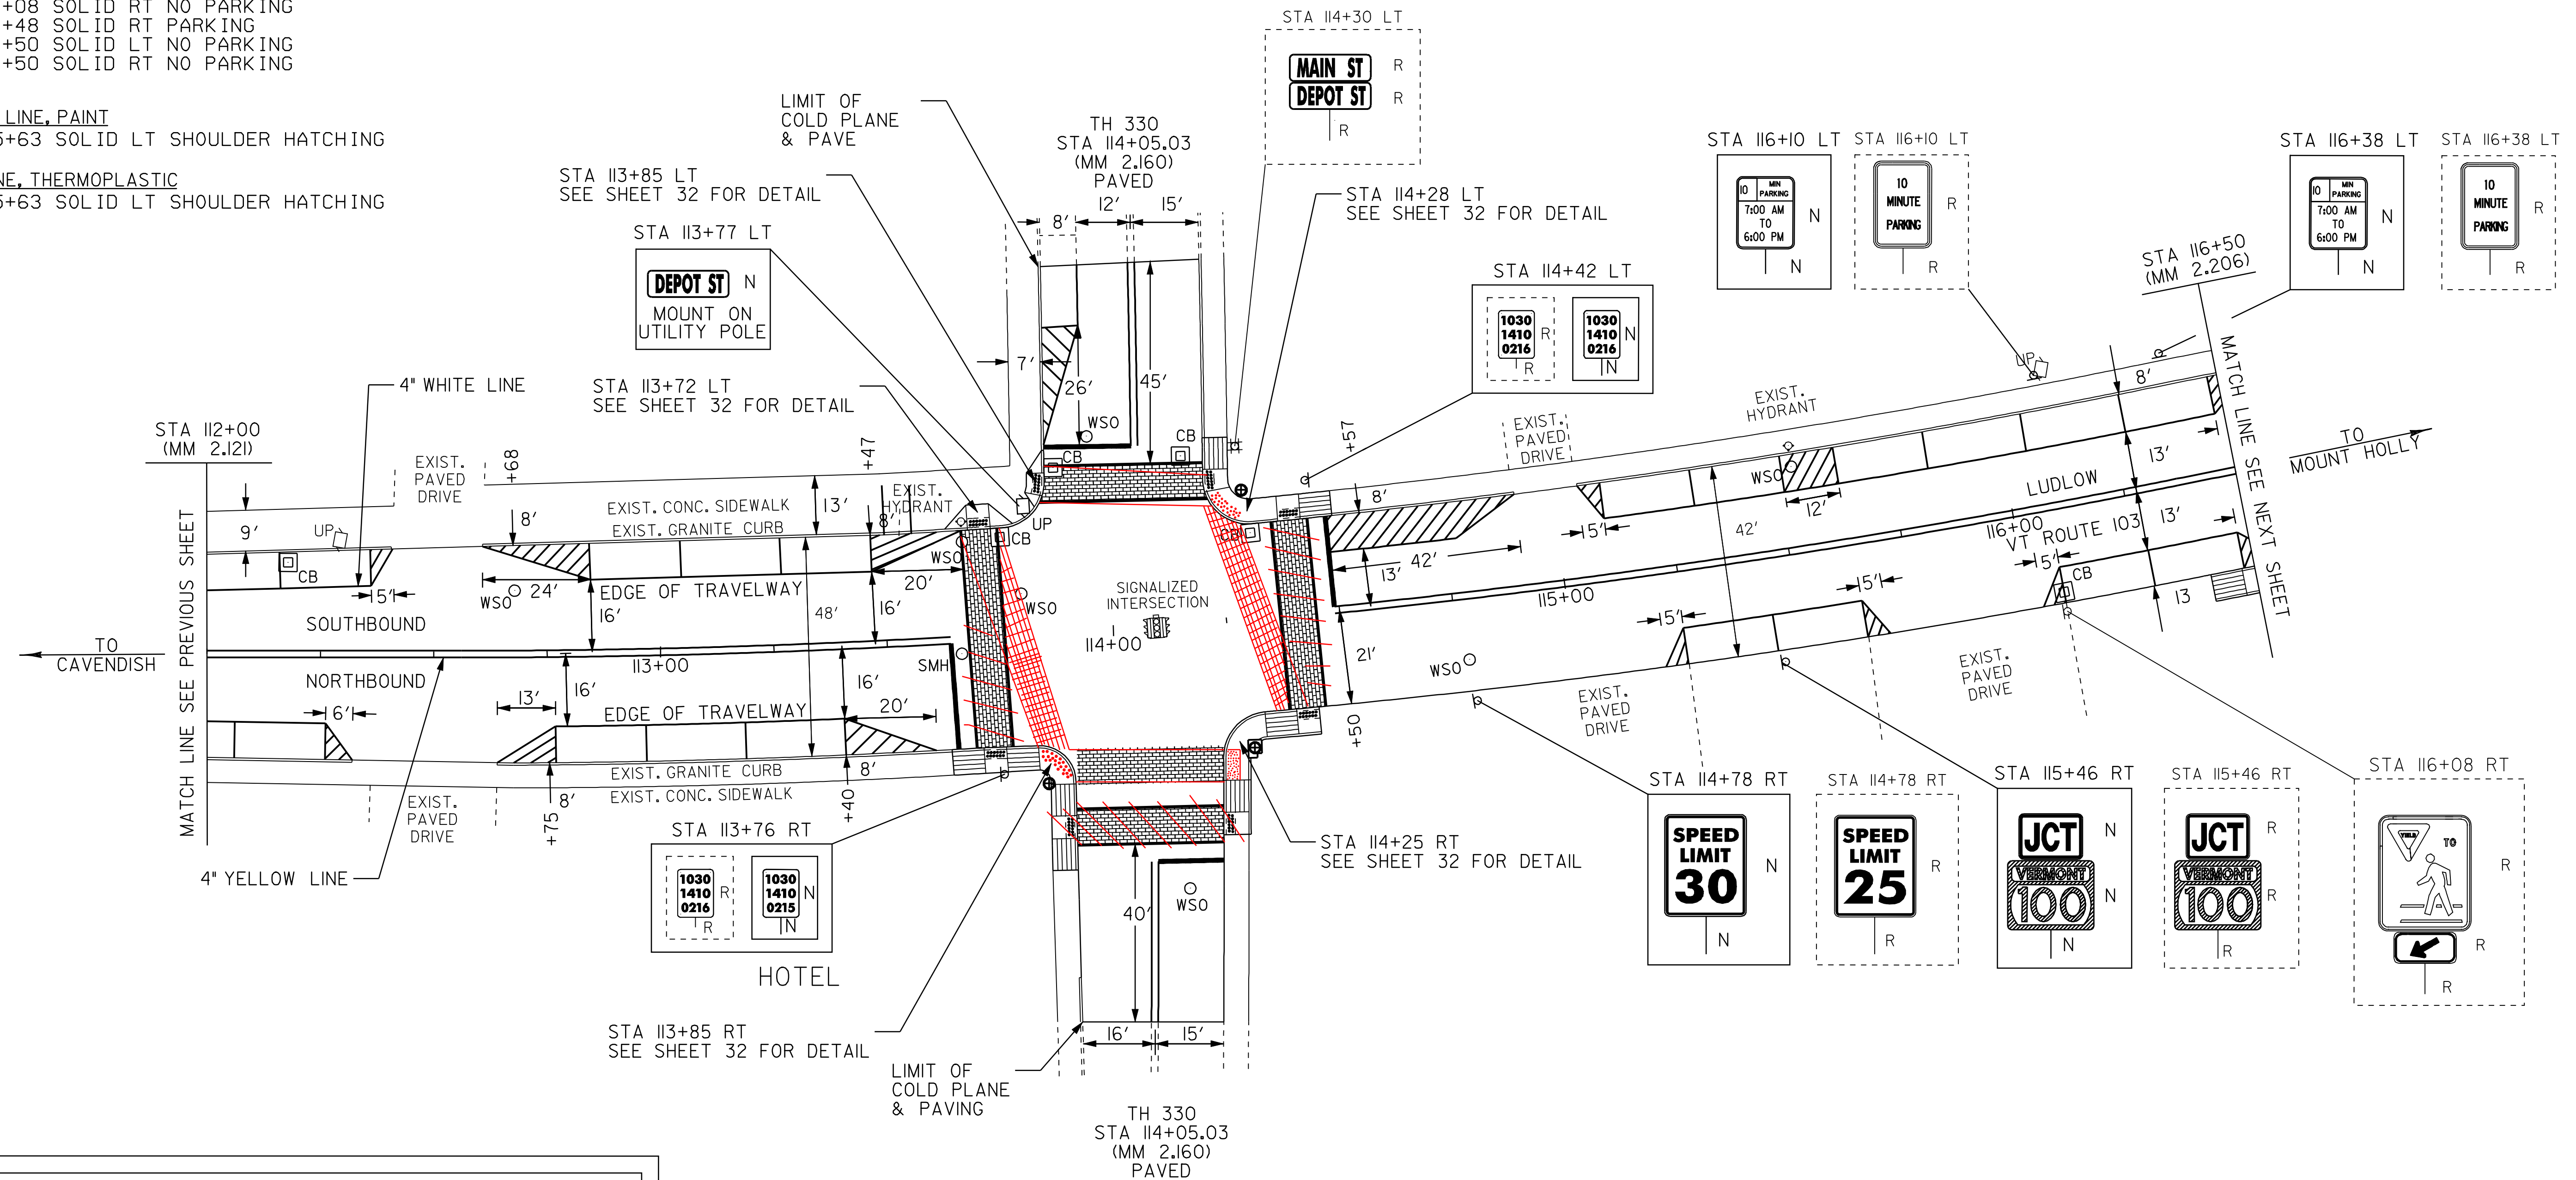

THE LOCATION OF THE SIGNAL/PEDESTRIAN PEDESTALS IS APPROXIMATE, THE LOCATION AND DEPTH OF THE ELECTRICAL CONDUITS ARE UNKNOWN, THE CONTRACTOR MUST TAKE CARE NOT TO DAMAGE THE ELECTRICAL CONDUITS IN THE PROCESS OF COLD PLANING OR CONSTRUCTING SIDEWALK OR PEDESTRIAN RAMPS. ANY DAMAGE INCURRED WILL BE THE RESPONSIBILITY OF THE CONTRACTOR AT NO COST TO THE STATE OF VERMONT.

NOT TO SCALE

- LEGEND**
- R = REMOVE EXISTING
 - S = SALVAGE
 - R&S = REMOVE AND SALVAGE
 - N = NEW
 - RET = RETAIN
 - B-B = BACK TO BACK
 - = NEW RAIL
 - - - = EXISTING RAIL
 - ⊕ = PEDESTRIAN SIGNAL POLE

PAVING PROJECT LAYOUT #10	PROJECT: LUDLOW	PROJECT NO.: NH_2409(I)S
	DESIGN FILE NAME: /pave/05B008/pb008.dgn	PLOT DATE: 20-MAY-2010 14:3
	IPARM FILE NAME: pb008d10.i	SURVEY DATE: 11/20/05
	SQUAD LEADER: PIS	DRAWN BY: MRS
CLD_REF_NO.: 05-0389	SHEET: 21 OF 51	