

TEMPORARY 4" WHITE LINE, PAINT
 STA 121+50 TO 122+10 DOTTED LT LANE LINE
 STA 121+50 TO 122+32 SOLID LT
 STA 121+50 TO 125+29 SOLID RT
 STA 122+82 TO 123+28 SOLID LT
 STA 123+84 TO 124+40 SOLID LT
 STA 124+90 TO 125+29 SOLID LT
 STA 124+44 TO 124+67 SOLID LT (TH 362)
 STA 124+85 TO 124+86 SOLID LT (TH 362)
 STA 125+37 TO 126+50 SOLID LT
 STA 125+37 TO 126+50 SOLID RT

DURABLE 4" WHITE LINE, TYPE I TAPE
 STA 121+50 TO 122+10 DOTTED LT LANE LINE
 STA 122+82 TO 123+28 SOLID LT
 STA 123+84 TO 124+40 SOLID LT
 STA 124+90 TO 125+29 SOLID LT

TEMPORARY 4" YELLOW LINE, PAINT
DURABLE 4" YELLOW LINE, THERMOPLASTIC
 STA 121+50 TO 122+30 SOLID LT & RT
 STA 121+81 TO 122+30 DOUBLE SOLID LT (ISLAND)
 STA 122+65 DOUBLE SOLID LT (TH 360)
 STA 122+69 TO 123+04 DOUBLE SOLID LT (ISLAND)
 STA 122+69 TO 123+41 SOLID LT & RT
 STA 123+34 DOUBLE SOLID LT (TH 356)
 STA 123+82 TO 124+36 SOLID LT & RT
 STA 124+59 DOUBLE SOLID LT (TH 362)
 STA 124+76 TO 125+29 SOLID LT & RT
 STA 125+37 TO 126+50 SOLID LT & RT

TEMPORARY 24" STOP BAR, PAINT
DURABLE 24" STOP BAR, TYPE I TAPE
 STA 122+65 LT (TH 360)
 STA 122+99 LT (TH 360)
 STA 123+34 LT (TH 356)
 STA 124+59 LT (TH 362)

TEMPORARY LETTER OR SYMBOL, PAINT
DURABLE LETTER OR SYMBOL, TYPE I TAPE
 STA 122+68 LT - "STOP" (TH 360)
 STA 122+97 LT - "STOP" (TH 360)
 STA 123+24 LT - "STOP" (TH 356)
 STA 124+57 LT - "STOP" (TH 362)

CONSTRUCT SIDEWALK RAMP W/DETECTABLE WARNING SURFACE (CAST IRON)
 STA 122+36 LT (TYPE 6)
 STA 122+82 LT (TYPE 1)
 STA 123+28 LT (TYPE 1)
 STA 124+91 LT (TYPE 6)
 STA 125+33 LT (TYPE 6)
 STA 125+33 RT (TYPE 6)

DURABLE 4" WHITE LINE, THERMOPLASTIC
 STA 121+50 TO 122+32 SOLID LT
 STA 121+50 TO 125+29 SOLID RT
 STA 124+44 TO 124+67 SOLID LT (TH 362)
 STA 124+85 TO 124+86 SOLID LT (TH 362)
 STA 125+37 TO 126+50 SOLID LT
 STA 125+37 TO 126+50 SOLID RT

STA 122+82 LT
 CONSTRUCT SIDEWALK RAMP
 TYPE 1W/DETECTABLE WARNING SURFACE (CAST IRON)

TEMPORARY 8" YELLOW LINE, PAINT
DURABLE 8" YELLOW LINE, THERMOPLASTIC
 STA 121+94 TO 122+30 LT
 STA 122+69 TO 122+89 LT

TEMPORARY CROSSWALK MARKING, PAINT
 STA 122+36 TO 122+82 LT
 STA 123+28 TO 124+91 LT
 STA 125+33 LT TO RT

CHANGING ELEVATION OF DROP INLETS, CATCH BASINS OR MANHOLES
 STA 121+81 RT (CB)
 STA 121+86 RT (CB)
~~STA 122+29 LT (CB)~~
~~STA 122+58 LT (CB) (TH 360)~~
 STA 122+84 LT (CB) (TH 360) } **DOUBLE**
 STA 122+87 LT (CB) (TH 360) } **DOUBLE-NO WORK DONE**
 STA 123+00 LT (CB)
 STA 123+04 RT (CB)
 STA 124+34 LT (CB) } **DOUBLE**
 STA 124+38 LT (CB) } **DOUBLE**
 STA 124+91 LT (CB) } **DOUBLE**
 STA 124+94 LT (CB)
~~STA 125+41 LT (CB)~~

SPECIAL PROVISION (DURABLE CROSSWALK MARKING, IMPRINTED/COLORIZED)
 STA 122+36 TO 122+82 LT
 STA 123+28 TO 124+91 LT
 STA 125+33 LT TO RT

REHAB OF CB, DI
 122+39 LT
 122+58 LT
 125+41 LT

CHANGING ELEVATION OF SEWER MANHOLES
 STA 122+73 LT (SMH) (TH 360)
 STA 122+88 LT (SMH) (TH 360)
 STA 124+28 RT (SMH)












ADJUST ELEVATION OF VALVE BOX
 STA 124+26 LT (WSO)

STEEL BEAM GUARDRAIL, GALVANIZED W/8 FEET POSTS
 STA 126+33 TO 126+50 RT
 125+45

REMOVAL AND DISPOSAL OF GUARDRAIL
 STA 126+33 TO 126+50 RT

REMOVING SIGNS AS SHOWN - 20

MANUFACTURED TERMINAL SECTION, FLARED 125+45 RT

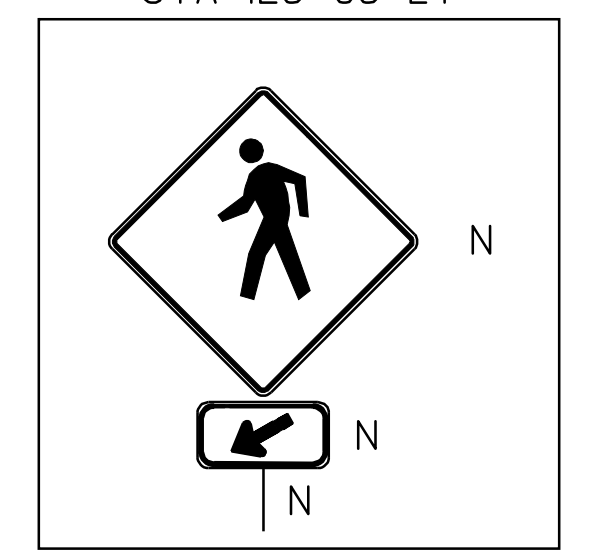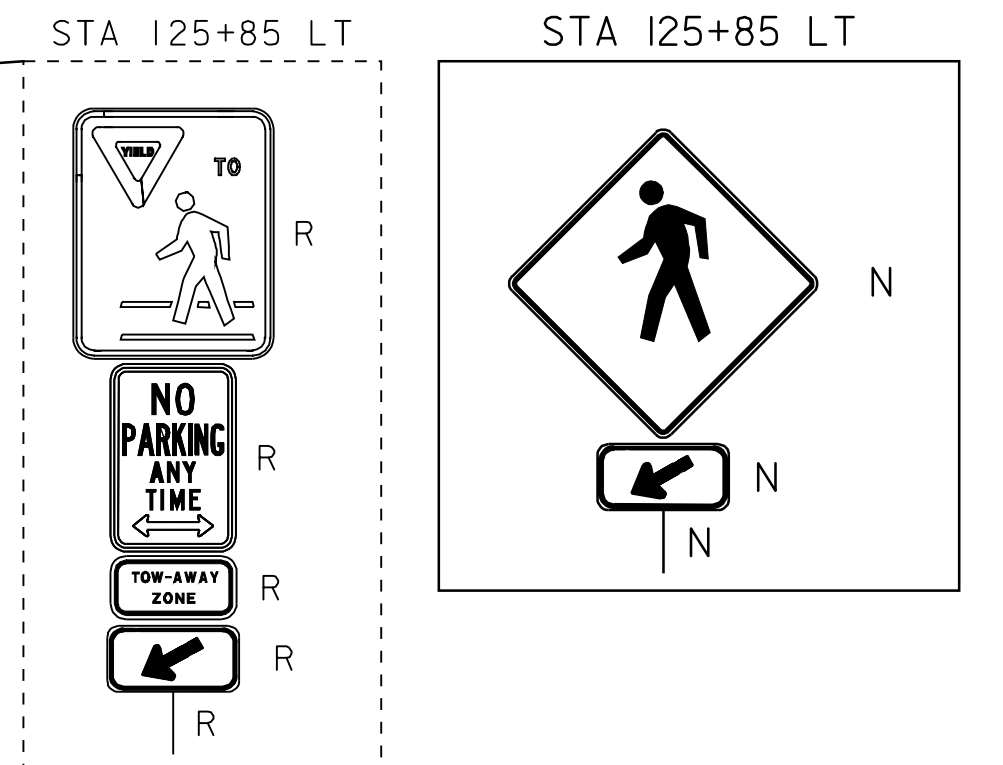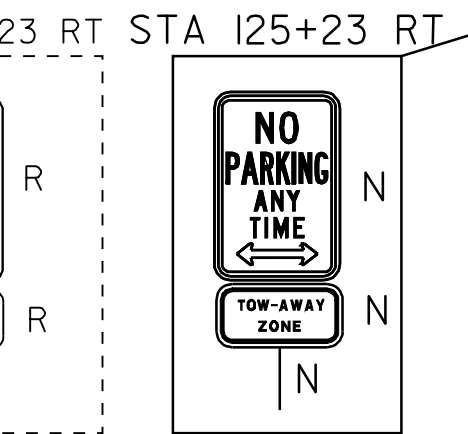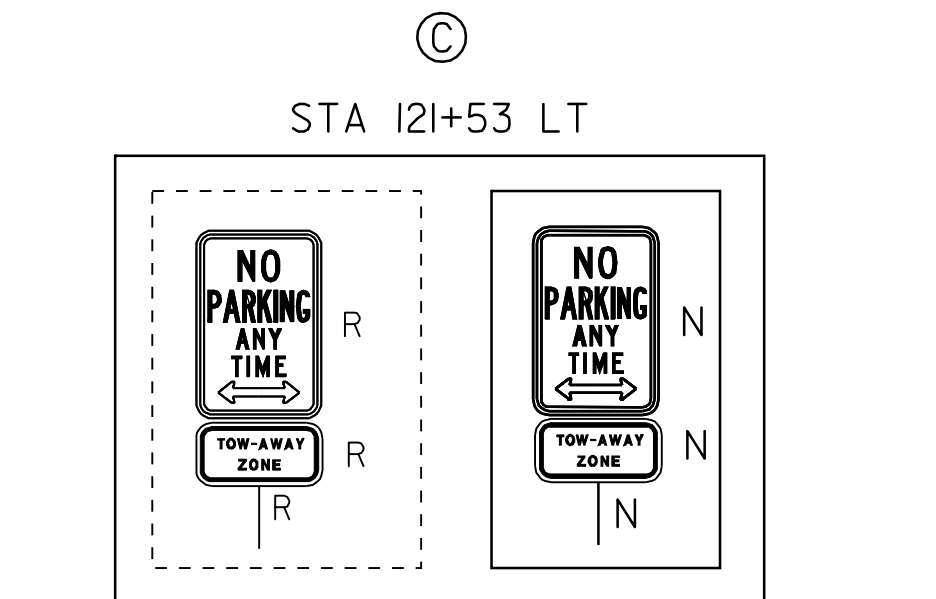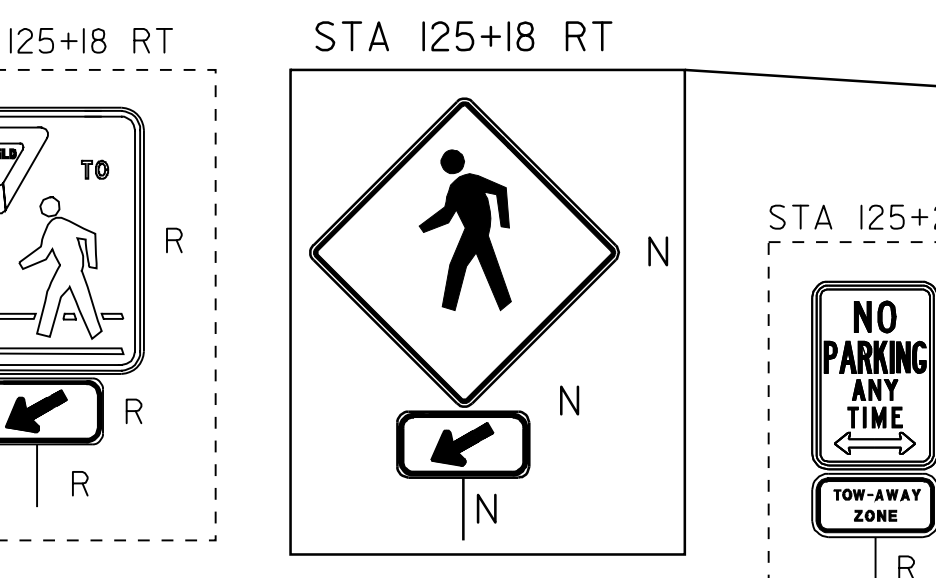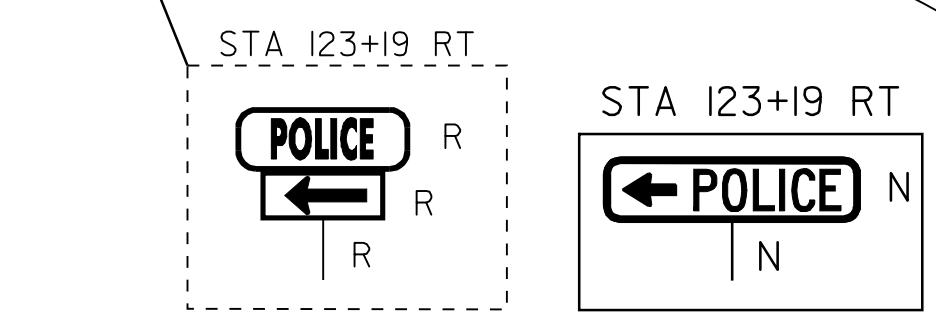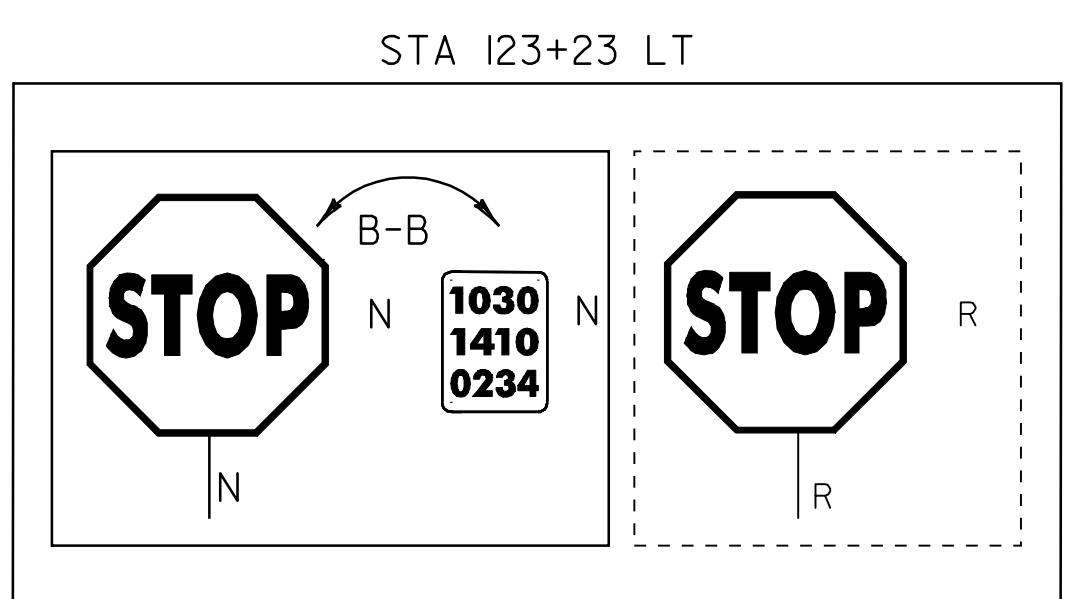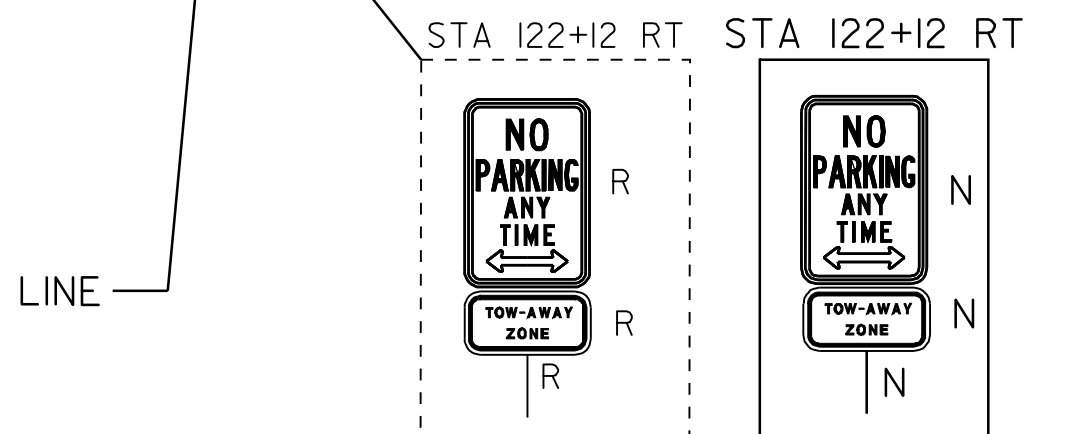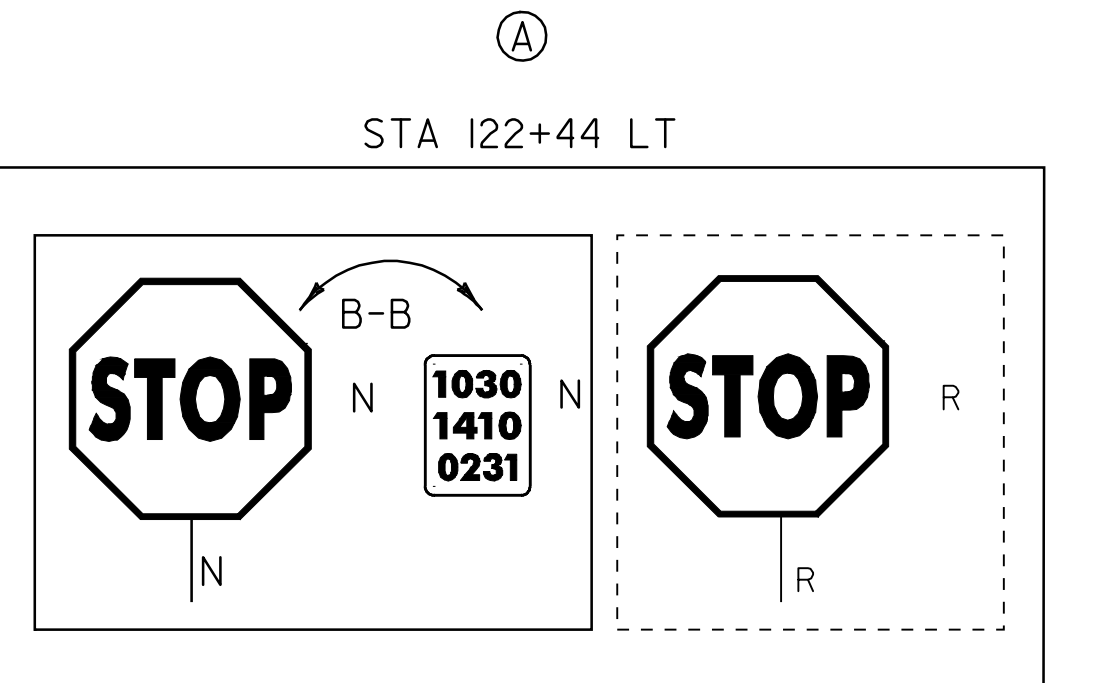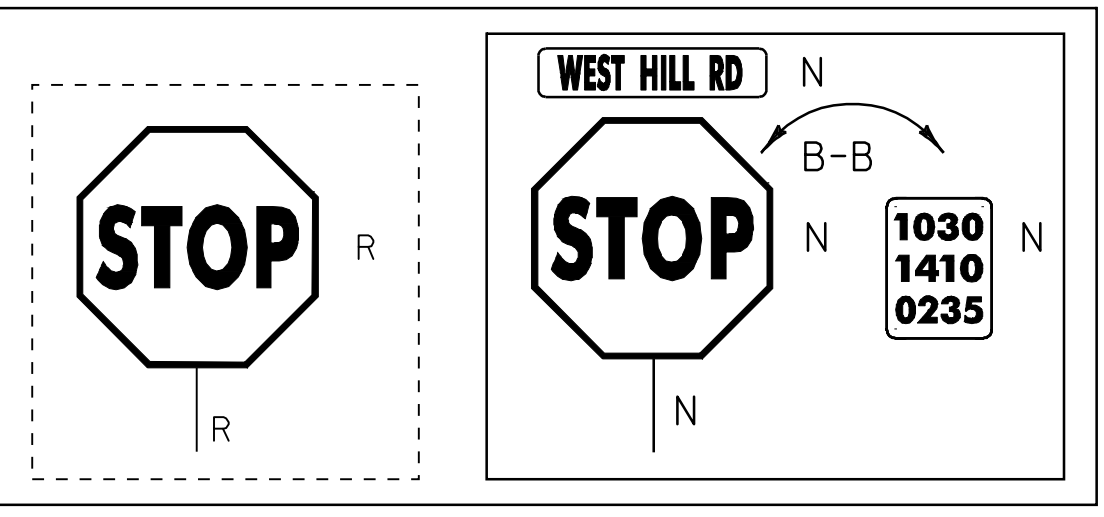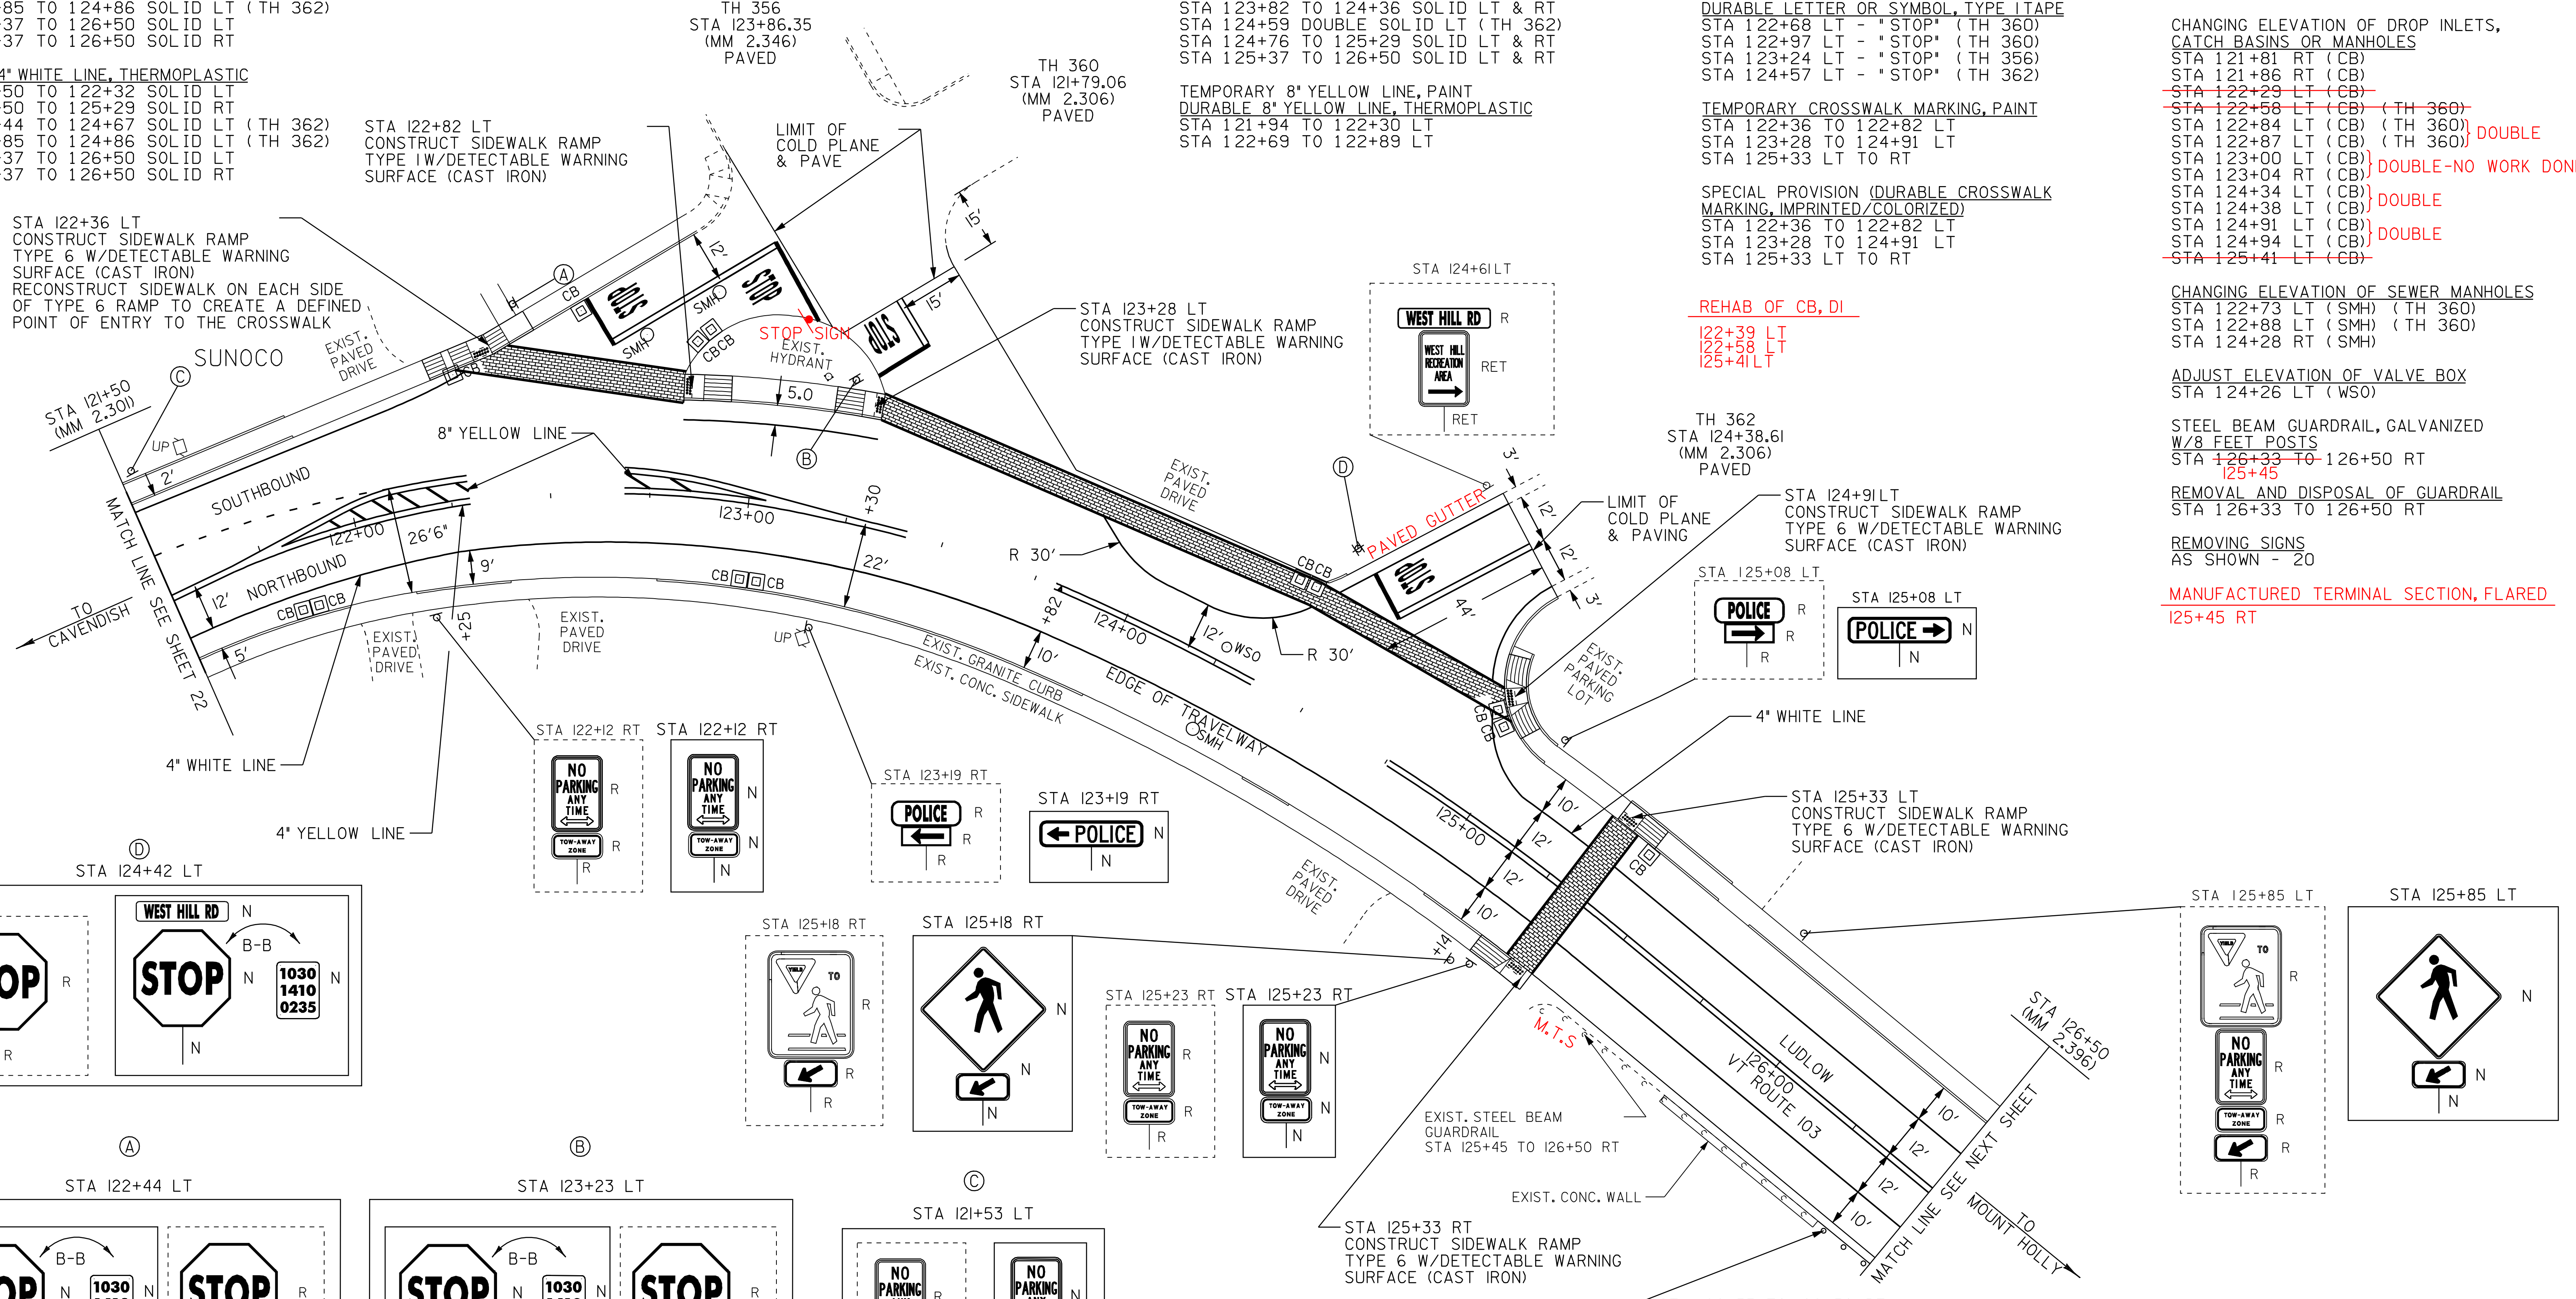

- LEGEND**
- R = REMOVE EXISTING
 - S = SALVAGE
 - R&S = REMOVE AND SALVAGE
 - N = NEW
 - RET = RETAIN
 - B-B = BACK TO BACK
 - = NEW RAIL
 - - - = EXISTING RAIL

PAVING PROJECT LAYOUT #12

PROJECT:	LUDLOW	PROJECT NO.:	NH_2409(I)S
DESIGN FILE NAME:	7pave/05B008/pb008.dgn	PLOT DATE:	20-MAY-2010 14:
IPARM FILE NAME:	pb008ld2.l	SURVEY DATE:	11/05
SURVEYED BY:	CLD_ENGINEERS, INC	DRAWN BY:	MRS
SQUAD LEADER:	PIS	SHEET:	24 OF 51
CLD REF. NO.:	05-0389		

NOT TO SCALE