

TEMPORARY 4" WHITE LINE, PAINT
 STA 102+00 TO 102+62 SOLID LT
 STA 102+00 TO 103+04 SOLID RT
 STA 104+11 TO 104+19 SOLID LT NO PARKING
 STA 104+19 TO 104+25 SOLID LT PARKING

DURABLE 4" WHITE LINE, THERMOPLASTIC
 STA 102+00 TO 102+62 SOLID LT
 STA 102+00 TO 103+04 SOLID RT
 STA 104+11 TO 104+19 SOLID LT NO PARKING
 STA 104+19 TO 104+25 SOLID LT PARKING

TEMPORARY 4" YELLOW LINE, PAINT
 DURABLE 4" YELLOW LINE, THERMOPLASTIC
 STA 102+00 TO 102+60 SOLID LT & RT
 STA 103+13 TO 104+25 SOLID LT & RT
 STA 0+34 TO 1+06 SOLID LT & RT (TH 328)

TEMPORARY 24" STOP BAR, PAINT
 DURABLE 24" STOP BAR, TYPE 1 TAPE
 STA 0+30 LT (TH 328)

TEMPORARY LETTER OR SYMBOL, PAINT
 DURABLE LETTER OR SYMBOL, TYPE 1 TAPE
 STA 0+34 LT - "STOP" (TH 328)

TEMPORARY CROSSWALK MARKING, PAINT
 STA 102+65 TO 103+08 LT
 STA 103+08 LT TO RT

SPECIAL PROVISION (DURABLE CROSSWALK MARKING, IMPRINTED/COLORIZED)
 STA 102+65 LT (TYPE 5)
 STA 103+08 LT (TYPE 1)
 STA 103+08 RT (TYPE 6)

CONSTRUCT SIDEWALK RAMP W/DETECTABLE WARNING SURFACE (CAST IRON)
 STA 102+65 LT (TYPE 5)
 STA 103+08 LT (TYPE 1)
 STA 103+08 RT (TYPE 6)

NEW CB BY TOWN →
 NEW DI →

CHANGING ELEVATION OF DROP INLETS, CATCH BASINS OR MANHOLES
 STA 104+00 LT (CB)
 STA 104+12 RT (CB)

CHANGING ELEVATION OF SEWER MANHOLE
 STA 103+34 LT (SMH)
 +0.75 CL




ADJUST ELEVATION OF VALVE BOX
 STA 102+76 LT (WSO) (TH 328)
 +0.50 LT

EXCAVATION OF SURFACES AND PAVEMENTS
 STA 102+43 TO 0+79 LT
 STA 1+06 RT TO 103+98 LT





PORTLAND CEMENT CONCRETE SIDEWALK, 5 INCH
 STA 102+60 TO 102+99 RT
 STA 103+22 TO 103+97 LT

VERTICAL GRANITE CURB
 STA 102+43 TO 1+06 LT
 STA 1+06 TO 103+98 LT

REMOVING SIGNS
 AS SHOWN - 8

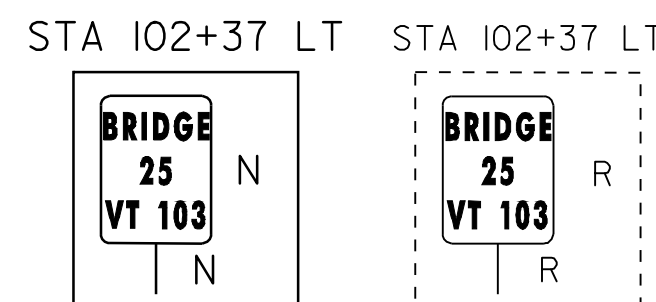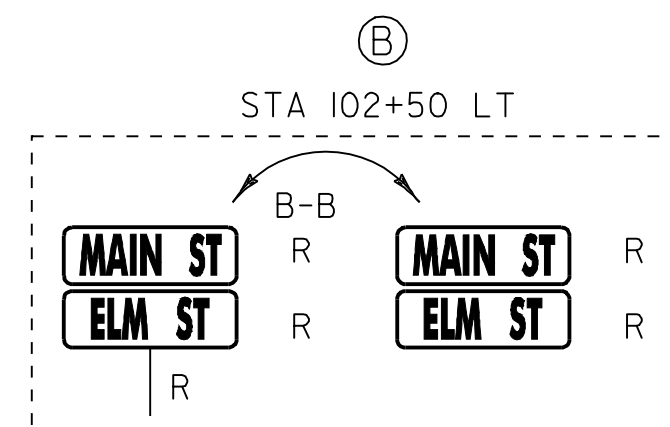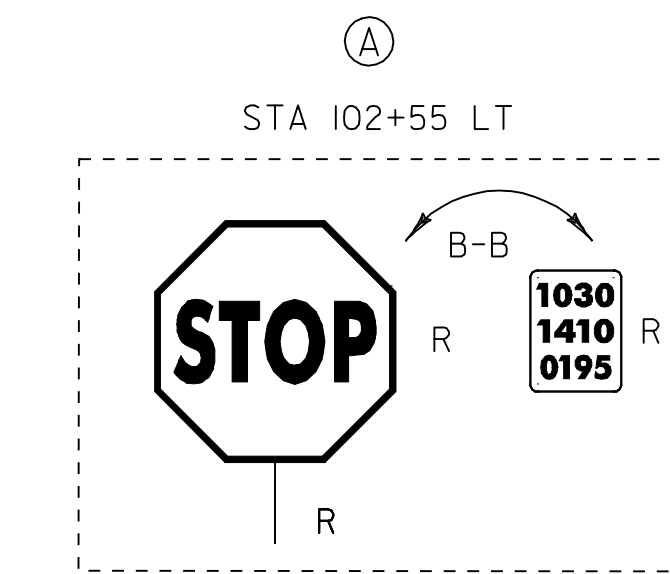

STA 102+65 LT
 CONSTRUCT SIDEWALK RAMP
 TYPE 5 W/DETECTABLE WARNING SURFACE (CAST IRON)

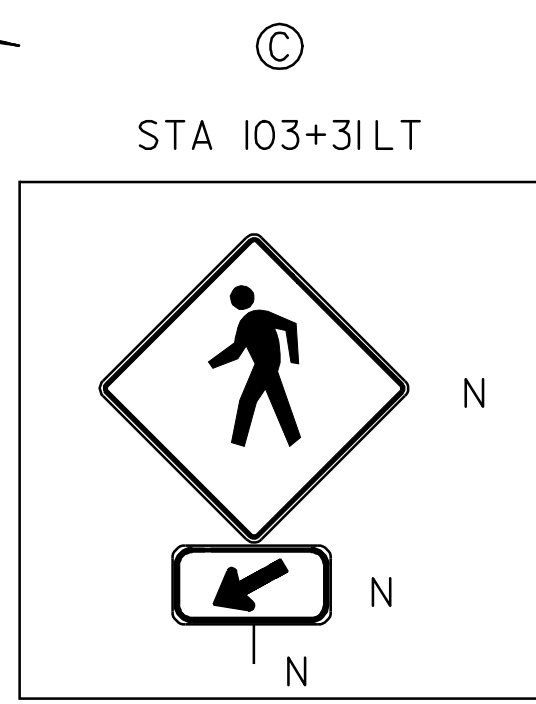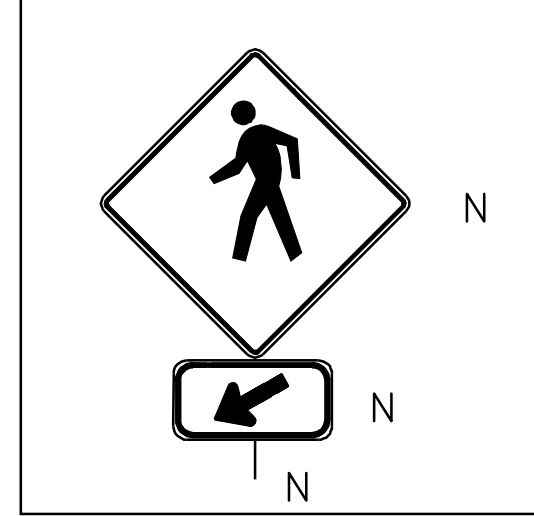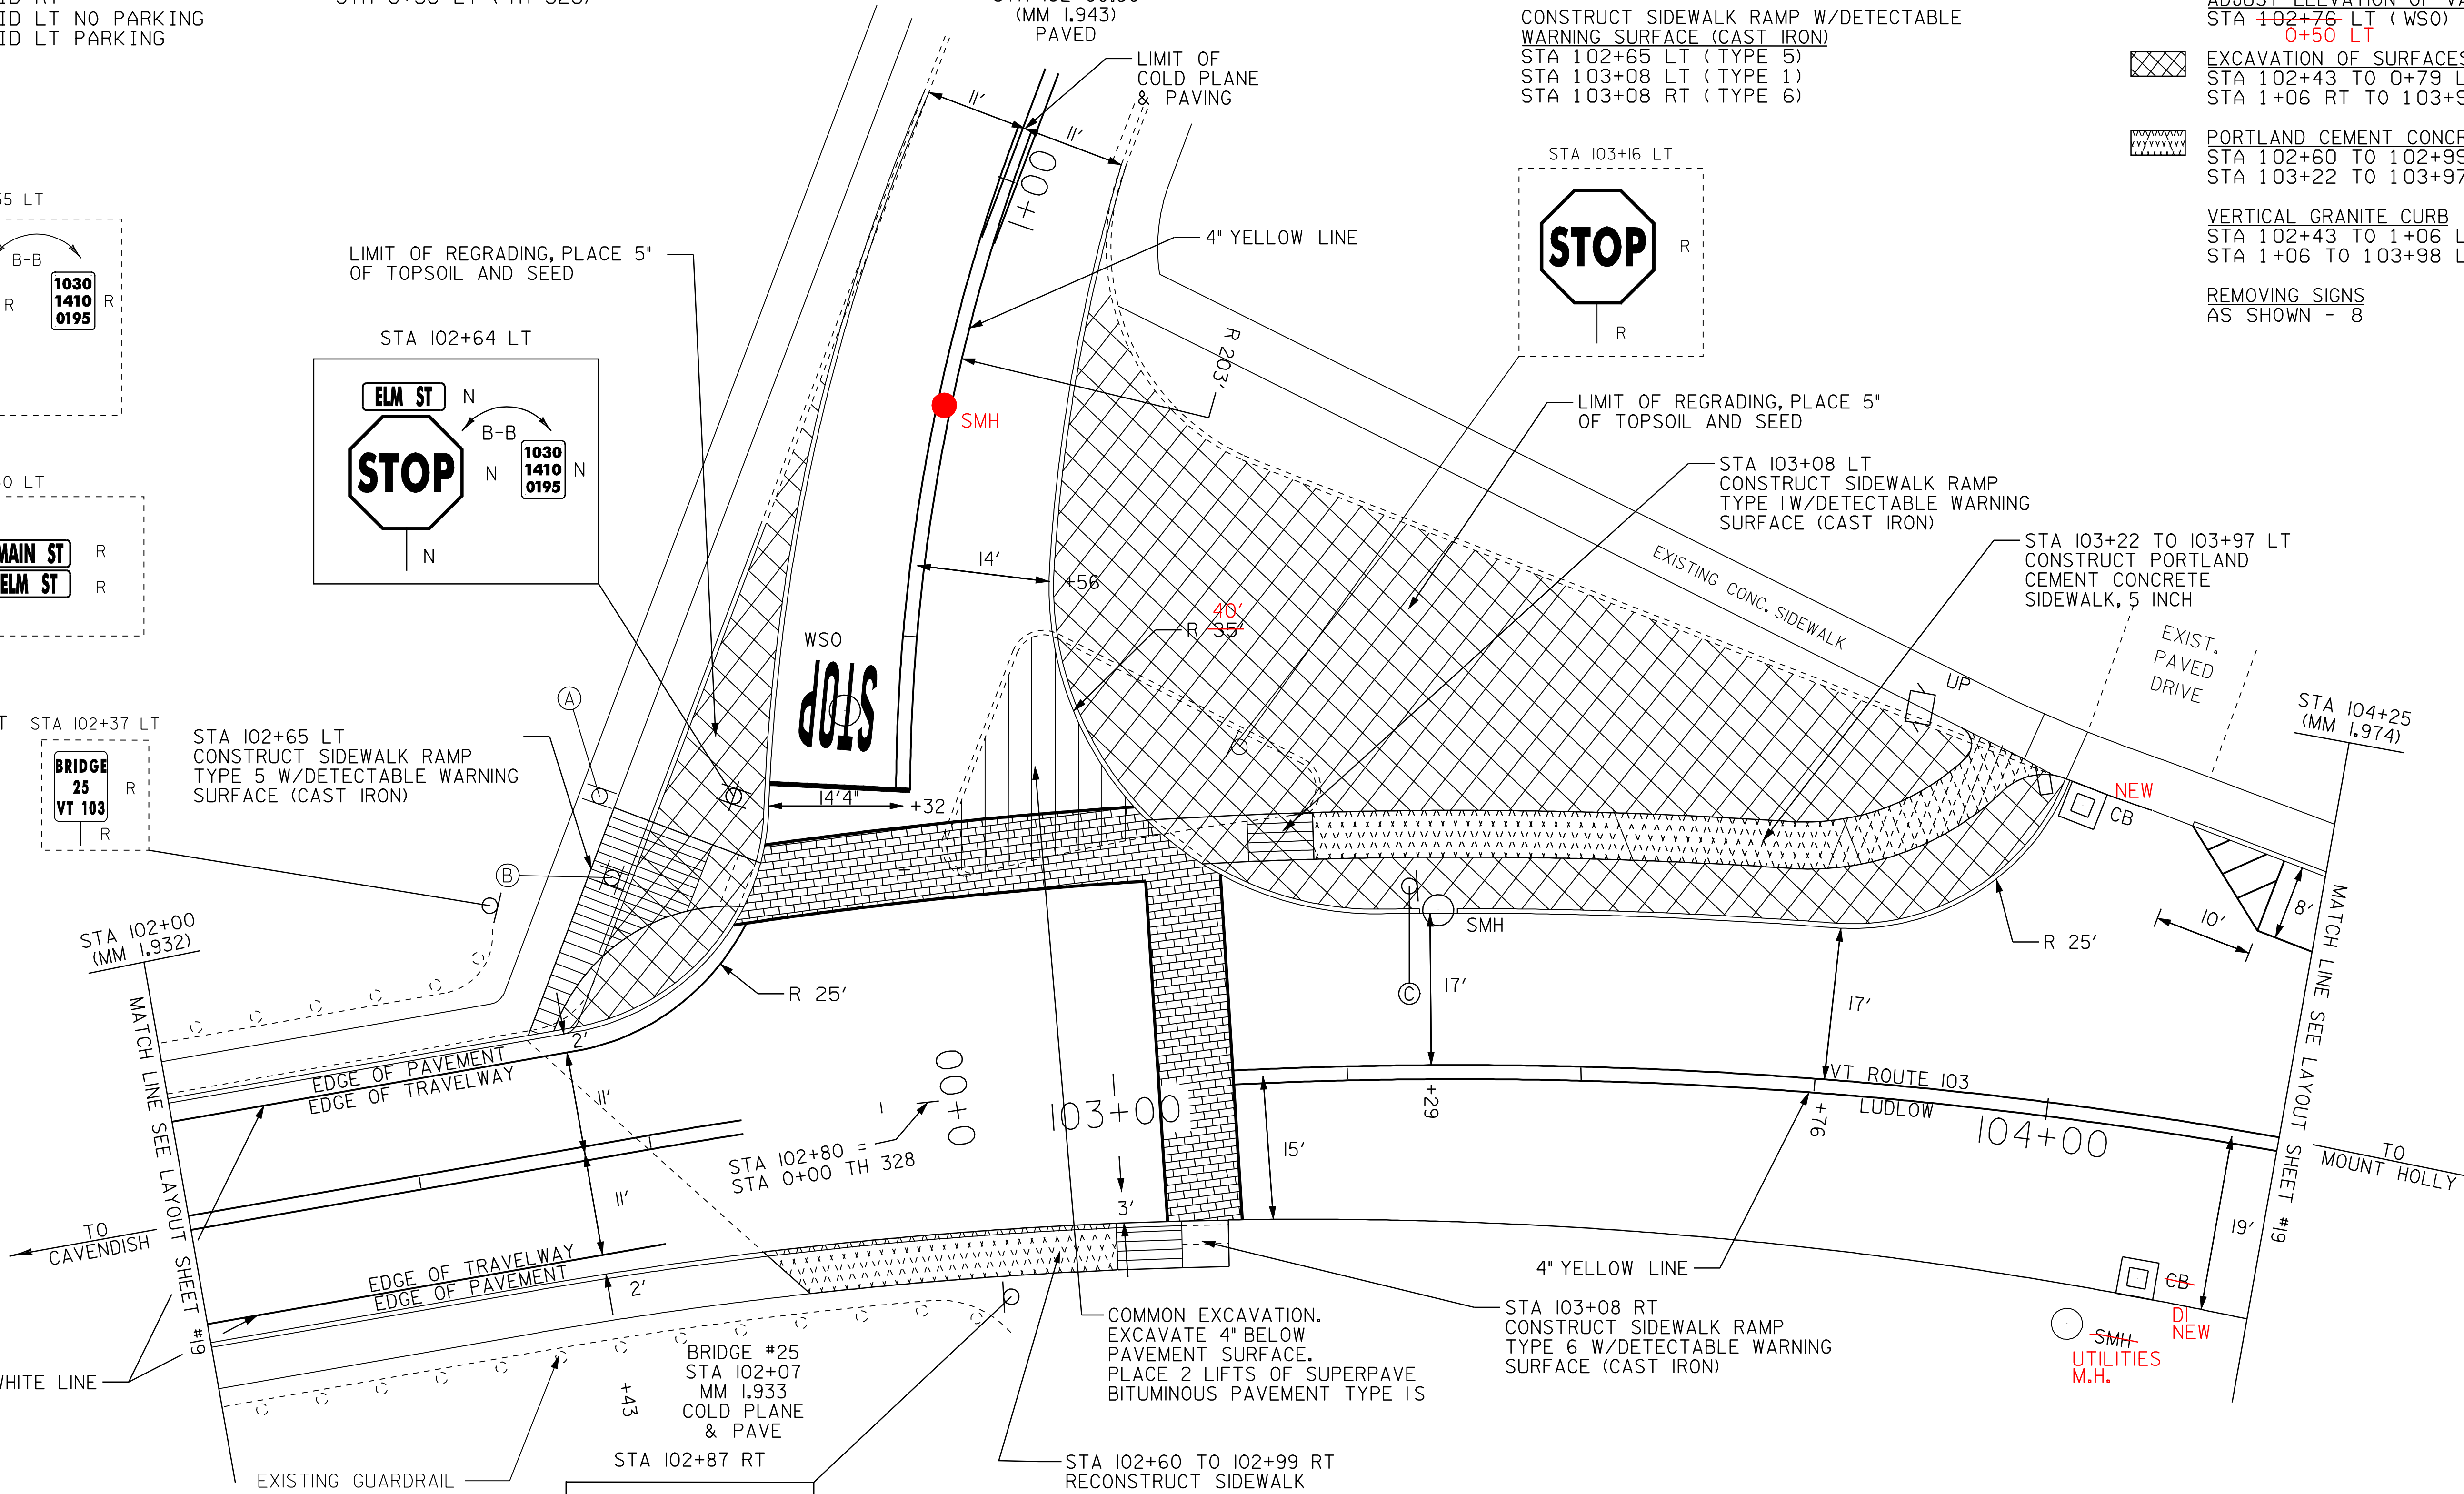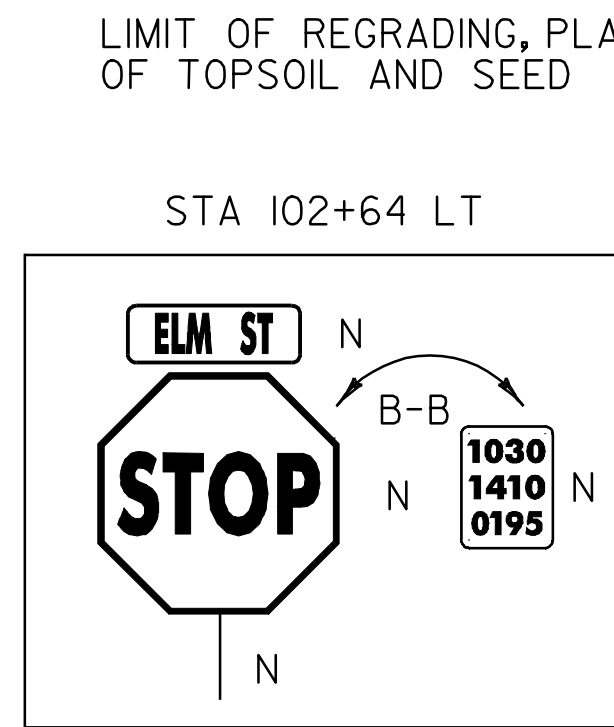

- LEGEND**
- R = REMOVE EXISTING
 - S = SALVAGE
 - R&S = REMOVE AND SALVAGE
 - N = NEW
 - RET = RETAIN
 - B-B = BACK TO BACK
 - = NEW RAIL
 - = EXISTING RAIL

INTERSECTION DETAIL SHEET	PROJECT: LUDLOW	PROJECT NO.: NH 2409(I)S
	DESIGN FILE NAME: /pave/05B008/pb008.dgn	PLOT DATE: 20-MAY-2010 14:
	IPARM FILE NAME: pb008isd01.i	SURVEY DATE: 11/05
	SURVEYED BY: CLD_ENGINEERS, INC	DRAWN BY: MRS
SQUAD LEADER: PIS	CLD REF. NO.: 05-0389	SHEET: 30 OF 51