


CONSTRUCT SIDEWALK RAMP W/DETECTABLE  
WARNING SURFACE (CAST IRON)  
STA 113+72 LT (TYPE 5)  
STA 113+85 LT (TYPE 5)  
STA 113+85 RT (TYPE 6)  
STA 114+25 RT (TYPE 6)  
STA 114+28 LT (TYPE 6)

TH 330  
STA 114+05.03  
(MM 2.160)  
PAVED

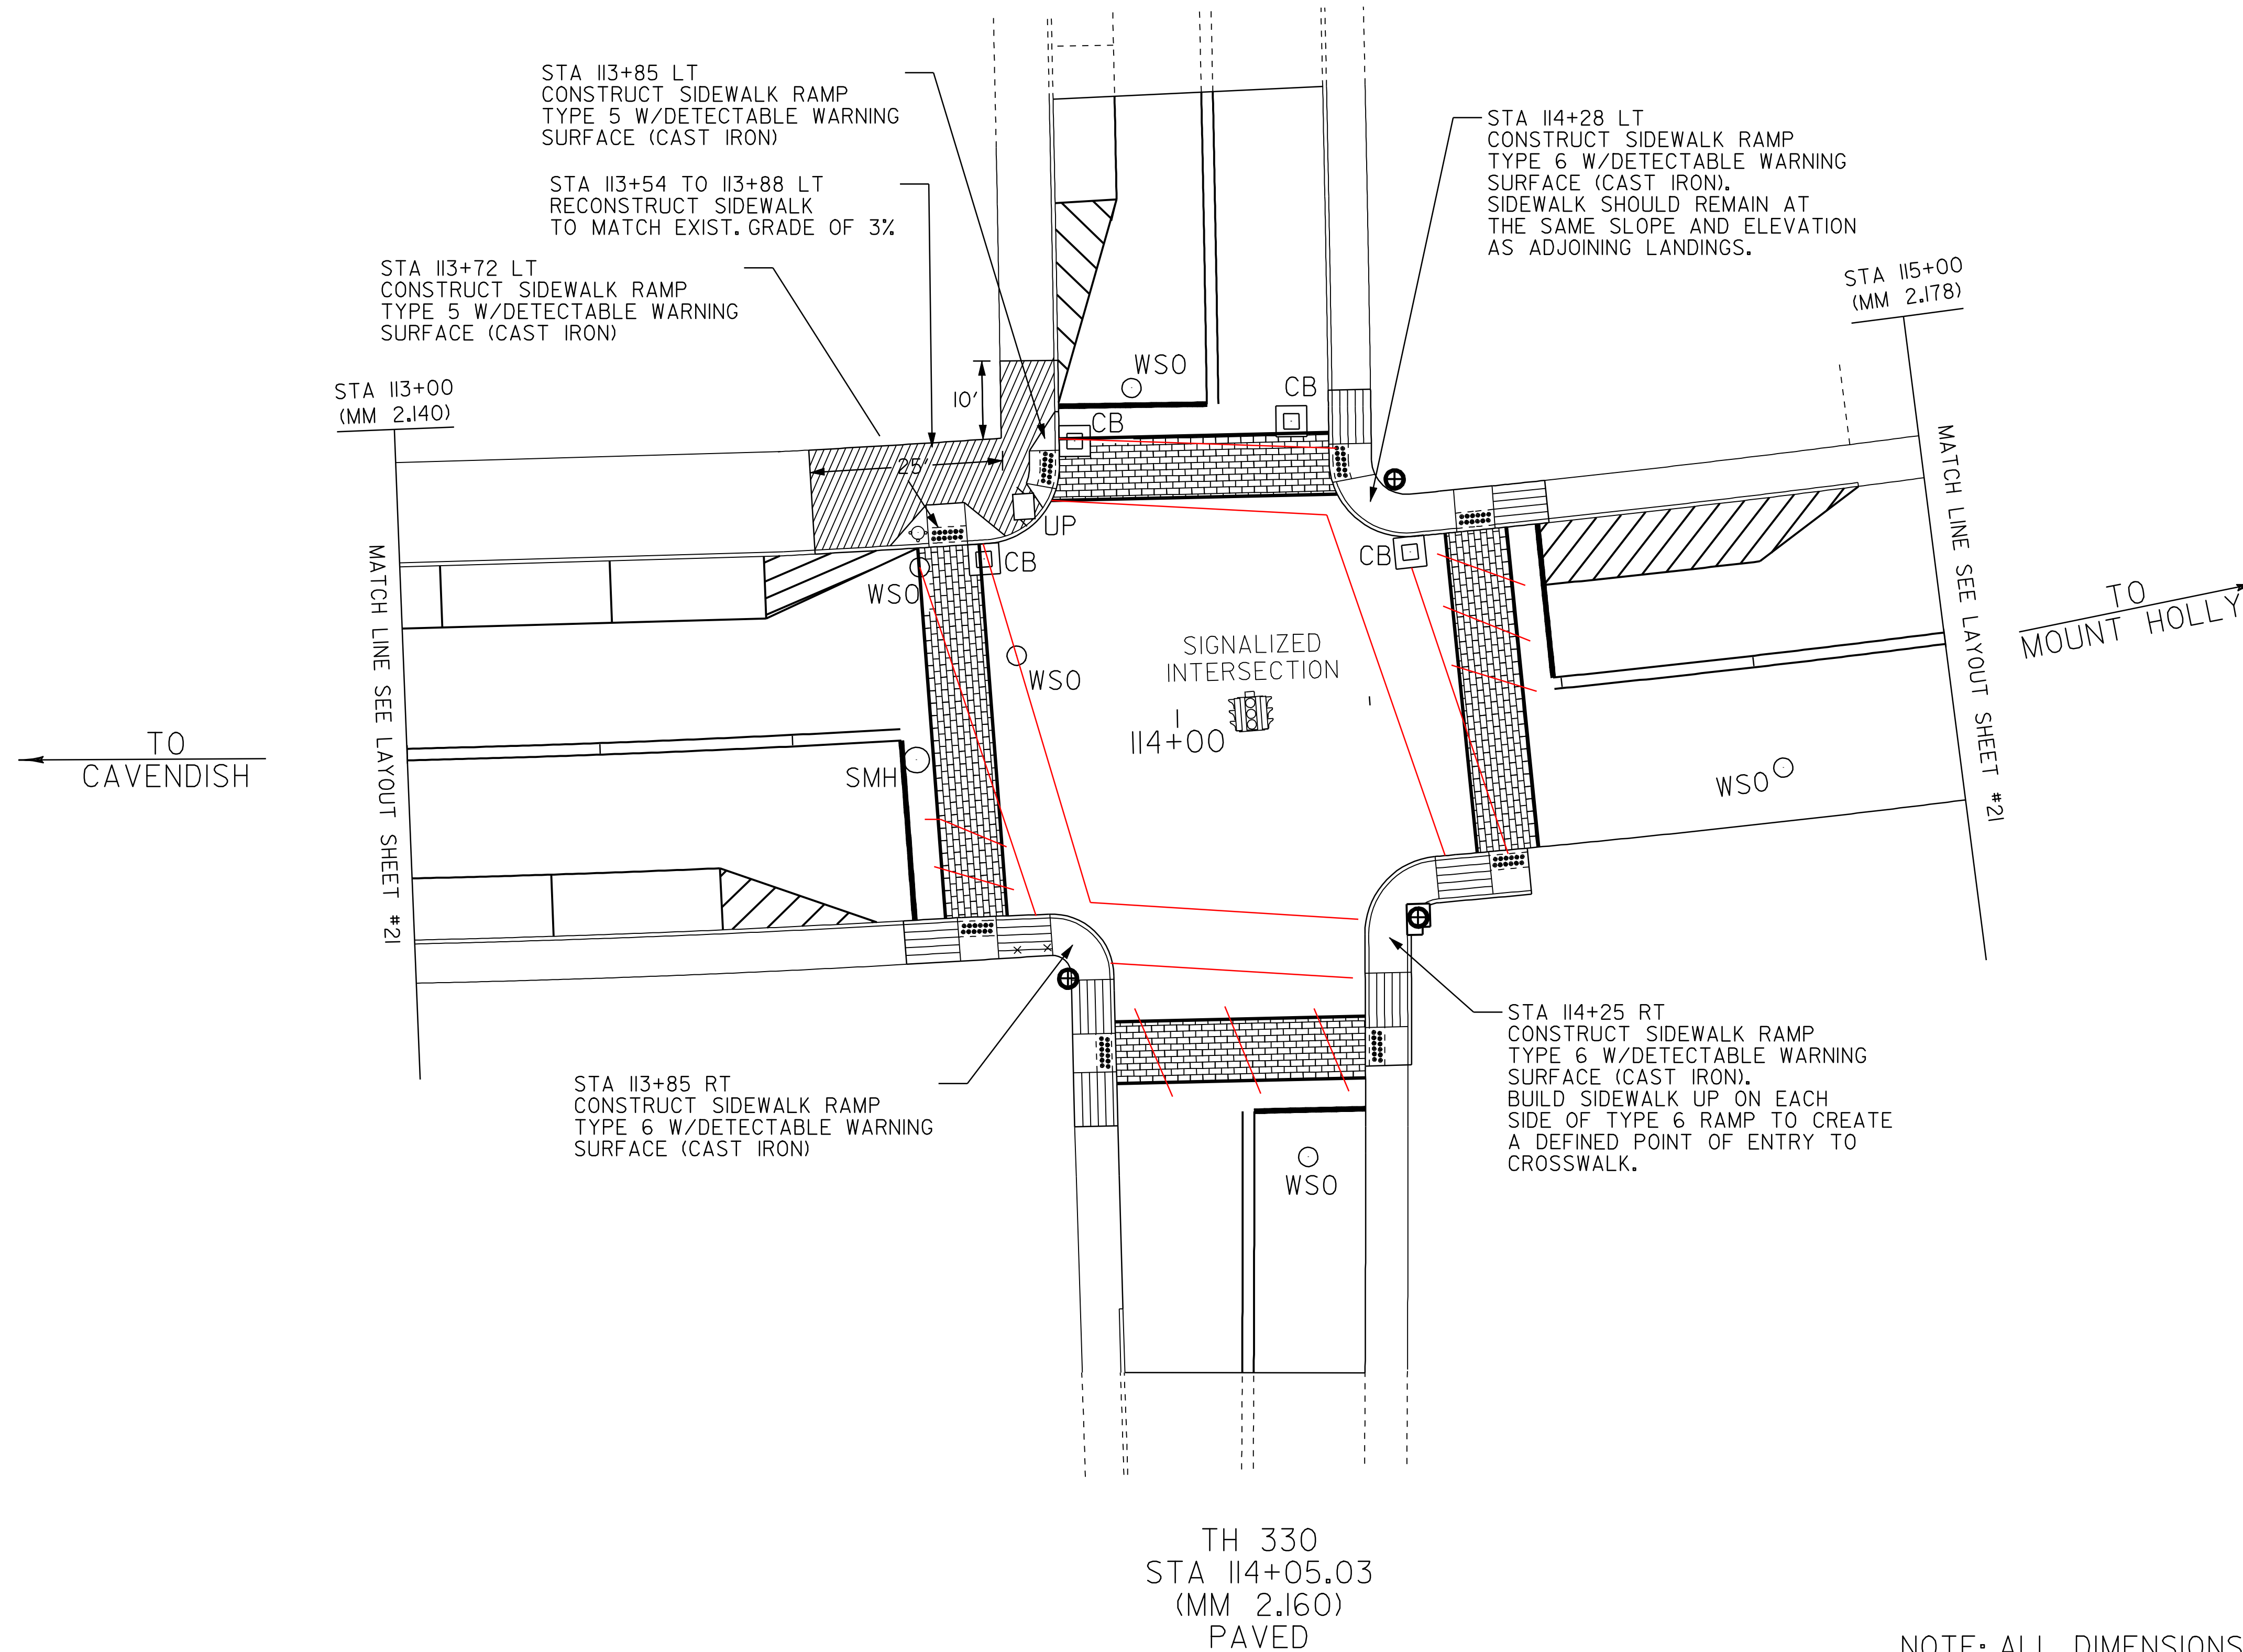

TH 330  
STA 114+05.03  
(MM 2.160)  
PAVED

NOTE: ALL DIMENSIONS ARE FEET EXCEPT AS INDICATED

NOT TO SCALE

<b>SIDEWALK DETAIL SHEET</b>	PROJECT:	LUDLOW	PROJECT NO.:	NH_2409(I)S
	DESIGN FILE NAME:	/pave/05B008/pb008.dgn	PLOT DATE:	20-MAY-2010 14:
	IPARM FILE NAME:	pb008d+03.1	SURVEY DATE:	11/2005
	SURVEYED BY:	CLD_ENGINEERS, INC	DRAWN BY:	MRS
	SQUAD LEADER:	PIS		
	CLD_REF. NO.:	05-0389	SHEET:	32 OF 51