

ASPHALTIC PLUG-TYPE JOINT DETAIL


NOTES:

1. THE JOINT SHALL BE LOCATED CENTRALLY OVER THE DECK EXPANSION GAP OR FIXED JOINT MARKED OUT TO THE MANUFACTURER'S RECOMMENDED WIDTH.
2. THE JOINT SHALL BE EXCAVATED AS SHOWN ON THE PLANS BY USE OF SAWS AND PNEUMATIC HAMMER OR A HAMMER AND CHISEL.
3. THE JOINT AREA SHALL BE BLAST CLEANED OF DEBRIS AND ASPHALT. THE JOINT AREA SHALL BE THOROUGHLY DRIED USING HOT COMPRESSED AIR PRIOR TO APPLYING BINDER MATERIAL.
4. SPALLED AND DEFECTIVE CONCRETE SHALL BE REPAIRED WITH AN APPROVED MATERIAL AS AGREED UPON BY THE RESIDENT ENGINEER.
5. PROPERLY SIZED HEAT RESISTANT BACKER ROD SHALL BE PLACED IN THE MOVEMENT GAP ALLOWING FOR 1 INCH +/- OF BINDER ABOVE THE ROD.
6. THE BINDER MATERIAL SHALL BE HEATED AND PLACED AS RECOMMENDED BY THE MANUFACTURER.
7. PLACE 1/4 INCH THICK BY 8 INCH WIDE SECTIONS OF STEEL PLATE OVER THE CENTER OF THE MOVEMENT GAP. SECURE PLATES FROM MOVING BY INSERTING LOCATING PINS THROUGH THE PRESTAMPED HOLES INTO BACKER ROD AND COVER WITH HOT BINDER.
 - A. THE STEEL PLATES MAY BE OMITTED WHERE THE APPROACH SLAB IS COVERED WITH A STONE BASE OR BITUMINOUS PAVEMENT AND VERTICAL MOVEMENT OF THE PLATES MIGHT OCCUR.
8. THE BINDER MATERIAL AND AGGREGATE SHALL BE HEATED AND MIXED AS RECOMMENDED BY THE MANUFACTURER.
9. THE INSTALLATION OF MATERIAL, COMPACTION, AND TOPCOATING SHALL BE AS RECOMMENDED BY THE MANUFACTURER.
10. IMMEDIATELY AFTER TOPCOATING, AN ANTI-SKID MATERIAL SHALL BE CAST OVER THE JOINT TO REDUCE THE RISK OF TRACKING.
11. JOINT SHALL BE PROTECTED FROM TRAFFIC UNTIL THE MATERIAL HAS COOLED TO 125° F +/-.

WEATHER LIMITATIONS

BINDER MATERIAL SHALL BE APPLIED ONLY WHEN THE FOLLOWING CONDITIONS PREVAIL:


- A. THE AMBIENT AIR TEMPERATURE IS AT LEAST 50° F AND RISING.
- B. THE ROAD SURFACE IS SUFFICIENTLY DRY.
- C. WEATHER CONDITIONS OR OTHER CONDITIONS ARE FAVORABLE AND ARE EXPECTED TO REMAIN SO FOR THE PERFORMANCE OF SATISFACTORY WORK.

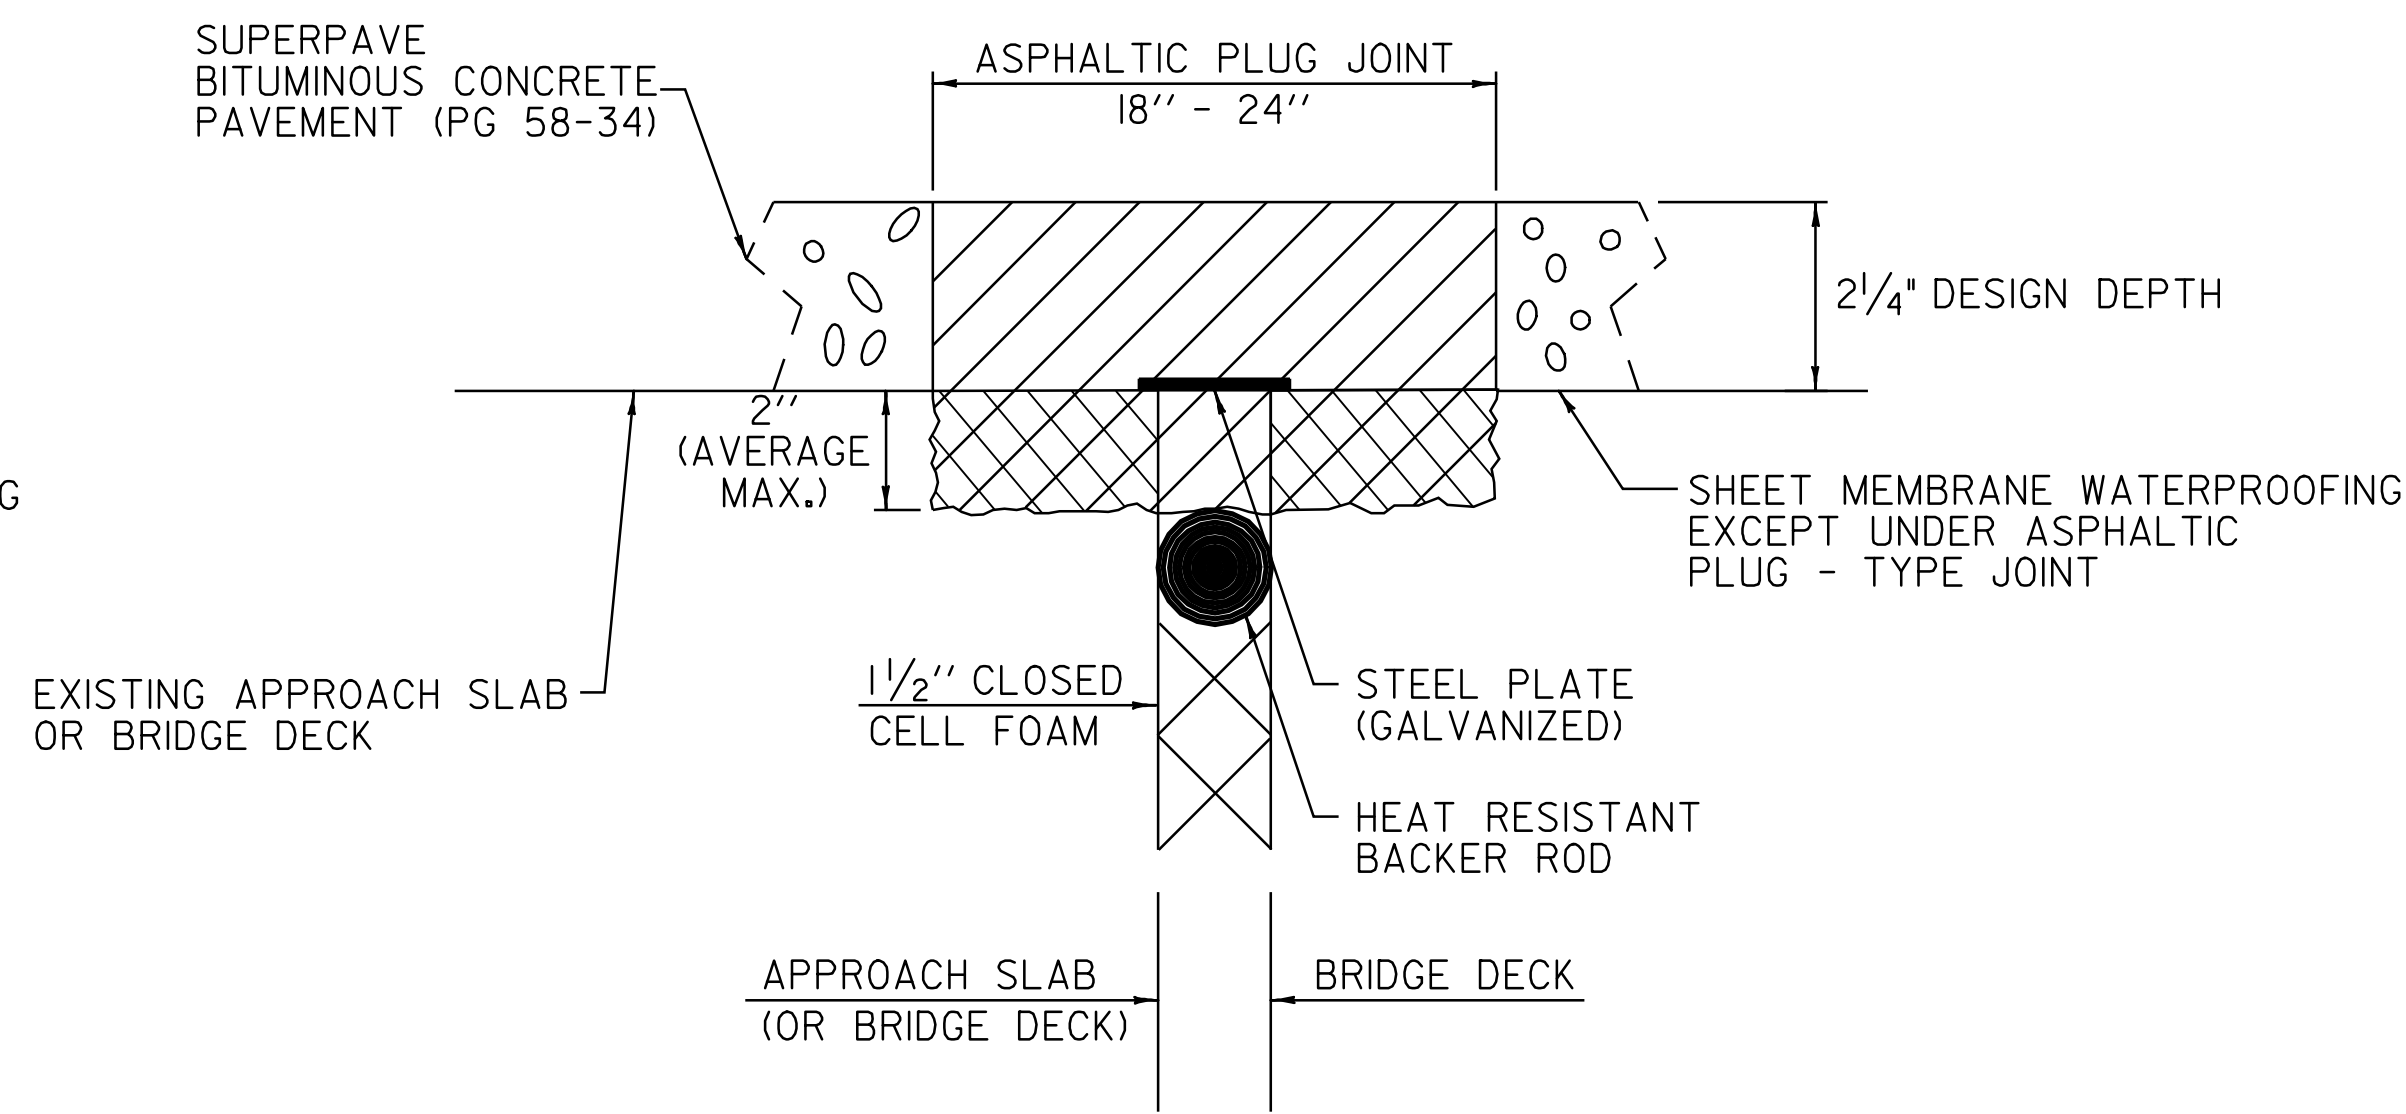

ASPHALTIC PLUG-TYPE JOINT DETAIL REMOVAL OF UP TO 2\"/>

NOTES:


1. UPON ENCOUNTERING UP TO 2\"/>
2. REMOVAL OF THE DETERIORATED CONCRETE WILL NOT BE PAID SEPARATELY BUT WILL BE CONSIDERED INCIDENTAL TO THE UNIT BID PRICE FOR THE ITEM 516.10. THE ADDITIONAL PLUG JOINT MATERIAL BELOW THE DESIGN DEPTH REQUIRED TO REPLACE THE DETERIORATED CONCRETE WILL BE CONSIDERED INCIDENTAL TO THE UNIT BID PRICE FOR THE ITEM 516.10.
3. THE STEEL PLATE IN THE ASPHALTIC PLUG JOINT MAY BE OMITTED ONLY IF THE REPAIRED SURFACE IS SO IRREGULAR IT WILL CAUSE VERTICAL MOVEMENT AND IT IS DIRECTED BY THE RESIDENT ENGINEER.

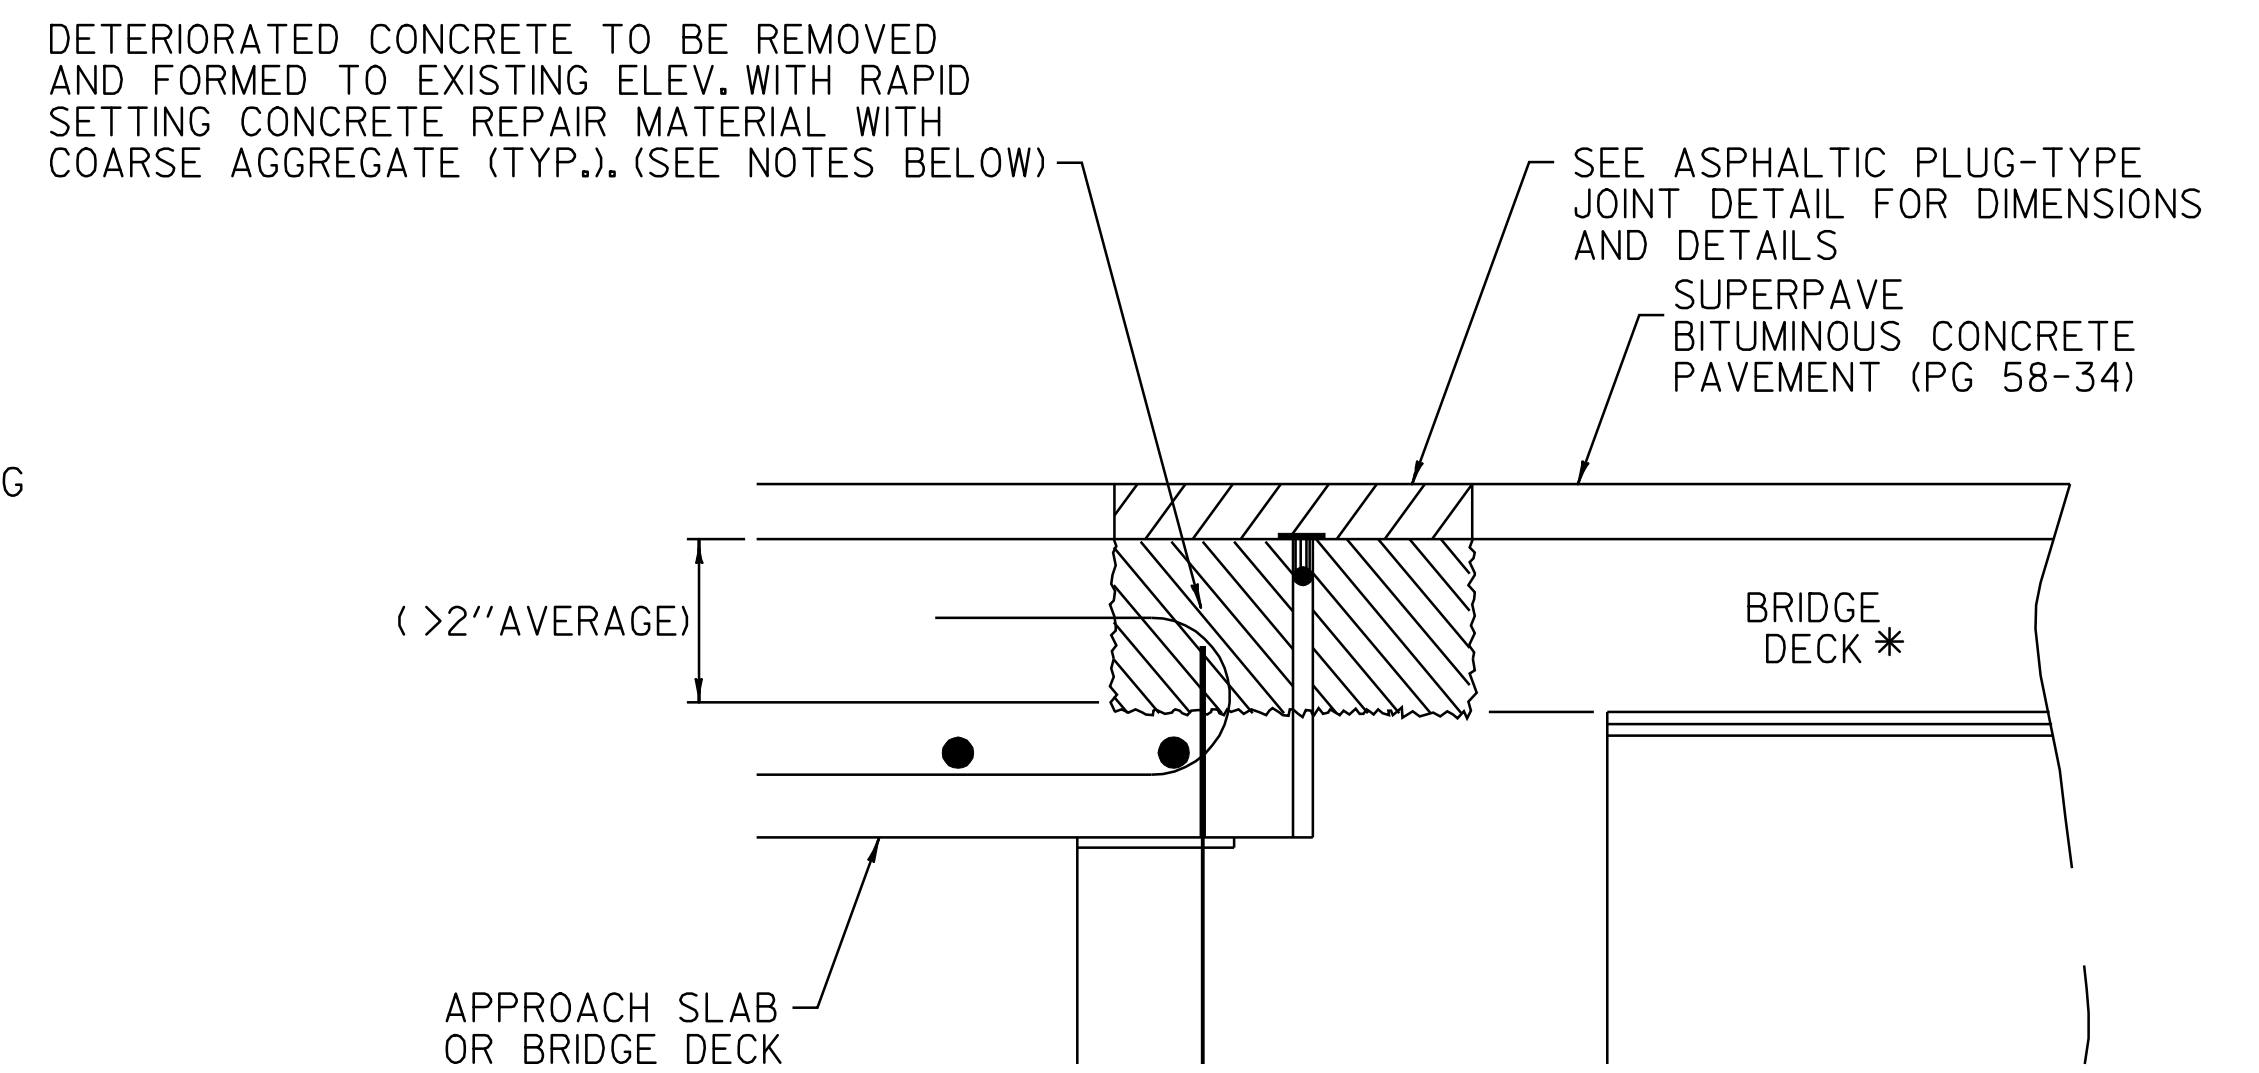

ASPHALTIC PLUG-TYPE JOINT DETAIL REMOVAL OF >2\"/>

NOTES:

1. UPON ENCOUNTERING GREATER THAN 2\"/>
2. REMOVAL OF THE DETERIORATED CONCRETE WILL BE INCLUDED IN THE UNIT BID PRICE FOR ITEM 580.20 RAPID SETTING CONCRETE REPAIR MATERIAL WITH COARSE AGGREGATE.
3. THE STEEL PLATE IN THE ASPHALTIC PLUG JOINT MAY BE OMITTED ONLY IF THE REPAIRED SURFACE IS SO IRREGULAR IT WILL CAUSE VERTICAL MOVEMENT AND IT IS DIRECTED BY THE RESIDENT ENGINEER.

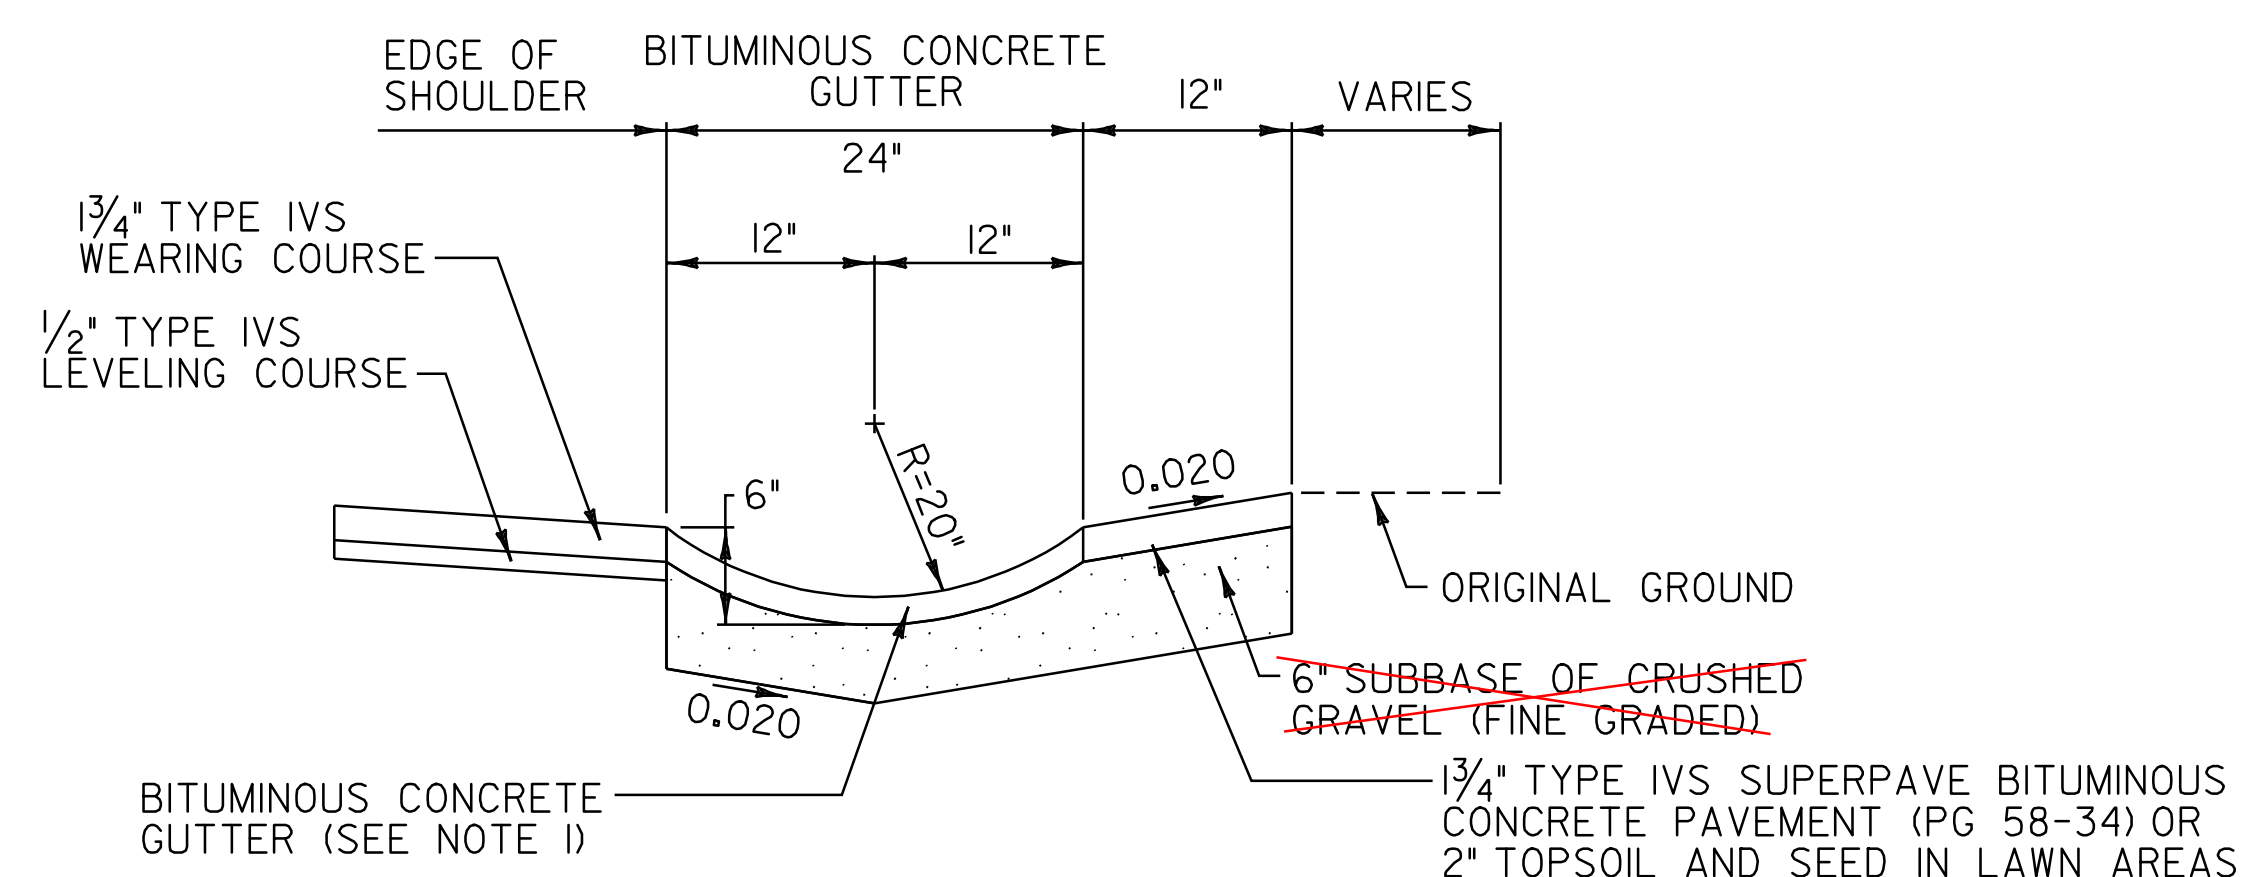

BITUMINOUS CONCRETE GUTTER DETAIL

BRIDGEWATER:
STA. 131+60.0 - STA. 131+65.0 LT (1.0 TON)

NOTE:

BITUMINOUS CONCRETE GUTTER TO BE CONSTRUCTED BY PLACING 1-3/4\"/>

BRIDGE JOINTS			
U.S. ROUTE 4 KILLINGTON	STA. 436+41.50	(59')	60'
U.S. ROUTE 4 KILLINGTON	STA. 436+95.50	(59')	
U.S. ROUTE 4 KILLINGTON	STA. 437+75.00	(59')	62'
U.S. ROUTE 4 KILLINGTON	STA. 438+28.00	(59')	60'
U.S. ROUTE 4 BRIDGEWATER	STA. 3+14.00	(78')	84'
U.S. ROUTE 4 BRIDGEWATER	STA. 5+16.00	(50')	51'
U.S. ROUTE 4 BRIDGEWATER	STA. 66+42.00	(43')	
U.S. ROUTE 4 BRIDGEWATER	STA. 67+80.00	(43')	
U.S. ROUTE 4 BRIDGEWATER	STA. 84+66.50	(30')	31'
U.S. ROUTE 4 BRIDGEWATER	STA. 86+04.00	(30')	
U.S. ROUTE 4 BRIDGEWATER	STA. 118+39.00	(31')	
U.S. ROUTE 4 BRIDGEWATER	STA. 119+40.50	(30')	
U.S. ROUTE 4 BRIDGEWATER	STA. 149+91.00	(47')	49'
U.S. ROUTE 4 BRIDGEWATER	STA. 151+57.00	(37')	41'
U.S. ROUTE 4 BRIDGEWATER	STA. 237+29.00	(50')	
U.S. ROUTE 4 BRIDGEWATER	STA. 237+94.50	(46')	} - NO EXISTING PLUG JOINT
U.S. ROUTE 4 BRIDGEWATER	STA. 238+62.50	(42')	
U.S. ROUTE 4 BRIDGEWATER	STA. 282+04.50	(36')	
U.S. ROUTE 4 BRIDGEWATER	STA. 283+76.00	(33')	35'
BRIDGEWATER		85+35	30'
		150+74	43'

NOT TO SCALE

PAVING DETAILS SHEET #2

PROJECT NAME: KILLINGTON - BRIDGEWATER
PROJECT NUMBER: NH 2502(1)S

FILE NAME: p05b036.dgn PLOT DATE: 15-MAY-2008 14
PROJECT LEADER: D.E.G. DRAWN BY: C.A.K.
DESIGNED BY: J.S.P. CHECKED BY: D.E.G.
IPARM FILE: p05b036pd02.i SHEET 5 OF 74