


646.402 DURABLE 4 INCH WHITE LINE, THERMOPLASTIC
 (ALL LINES WILL INCLUDE EDGE LINE BREAKS AND
 RADIUS FOR TOWN HIGHWAYS)
 KILLINGTON:
 STA. 401+28.00 - STA. 416+00.00 LT & RT

646.412 DURABLE 4 INCH YELLOW LINE, THERMOPLASTIC
 (ALL LINES WILL INCLUDE C/L BREAKS FOR
 TOWN HIGHWAYS) S=SOLID, D=DASHED
 KILLINGTON:
 STA. 401+28.00 - STA. 413+15.00 LT
 STA. 413+15.00 - STA. 416+00.00 RT

646.602 TEMPORARY 4 INCH WHITE LINE, PAINT
 (ALL LINES WILL INCLUDE EDGE LINE BREAKS AND
 RADIUS FOR TOWN HIGHWAYS)
 KILLINGTON:
 STA. 401+28.00 - STA. 416+00.00 LT & RT

646.612 TEMPORARY 4 INCH YELLOW LINE, PAINT
 (ALL LINES WILL INCLUDE C/L BREAKS FOR
 TOWN HIGHWAYS) S=SOLID, D=DASHED
 KILLINGTON:
 STA. 401+28.00 - STA. 413+15.00 LT
 STA. 413+15.00 - STA. 416+00.00 RT

675.50 REMOVING SIGNS
 AS SHOWN - 4

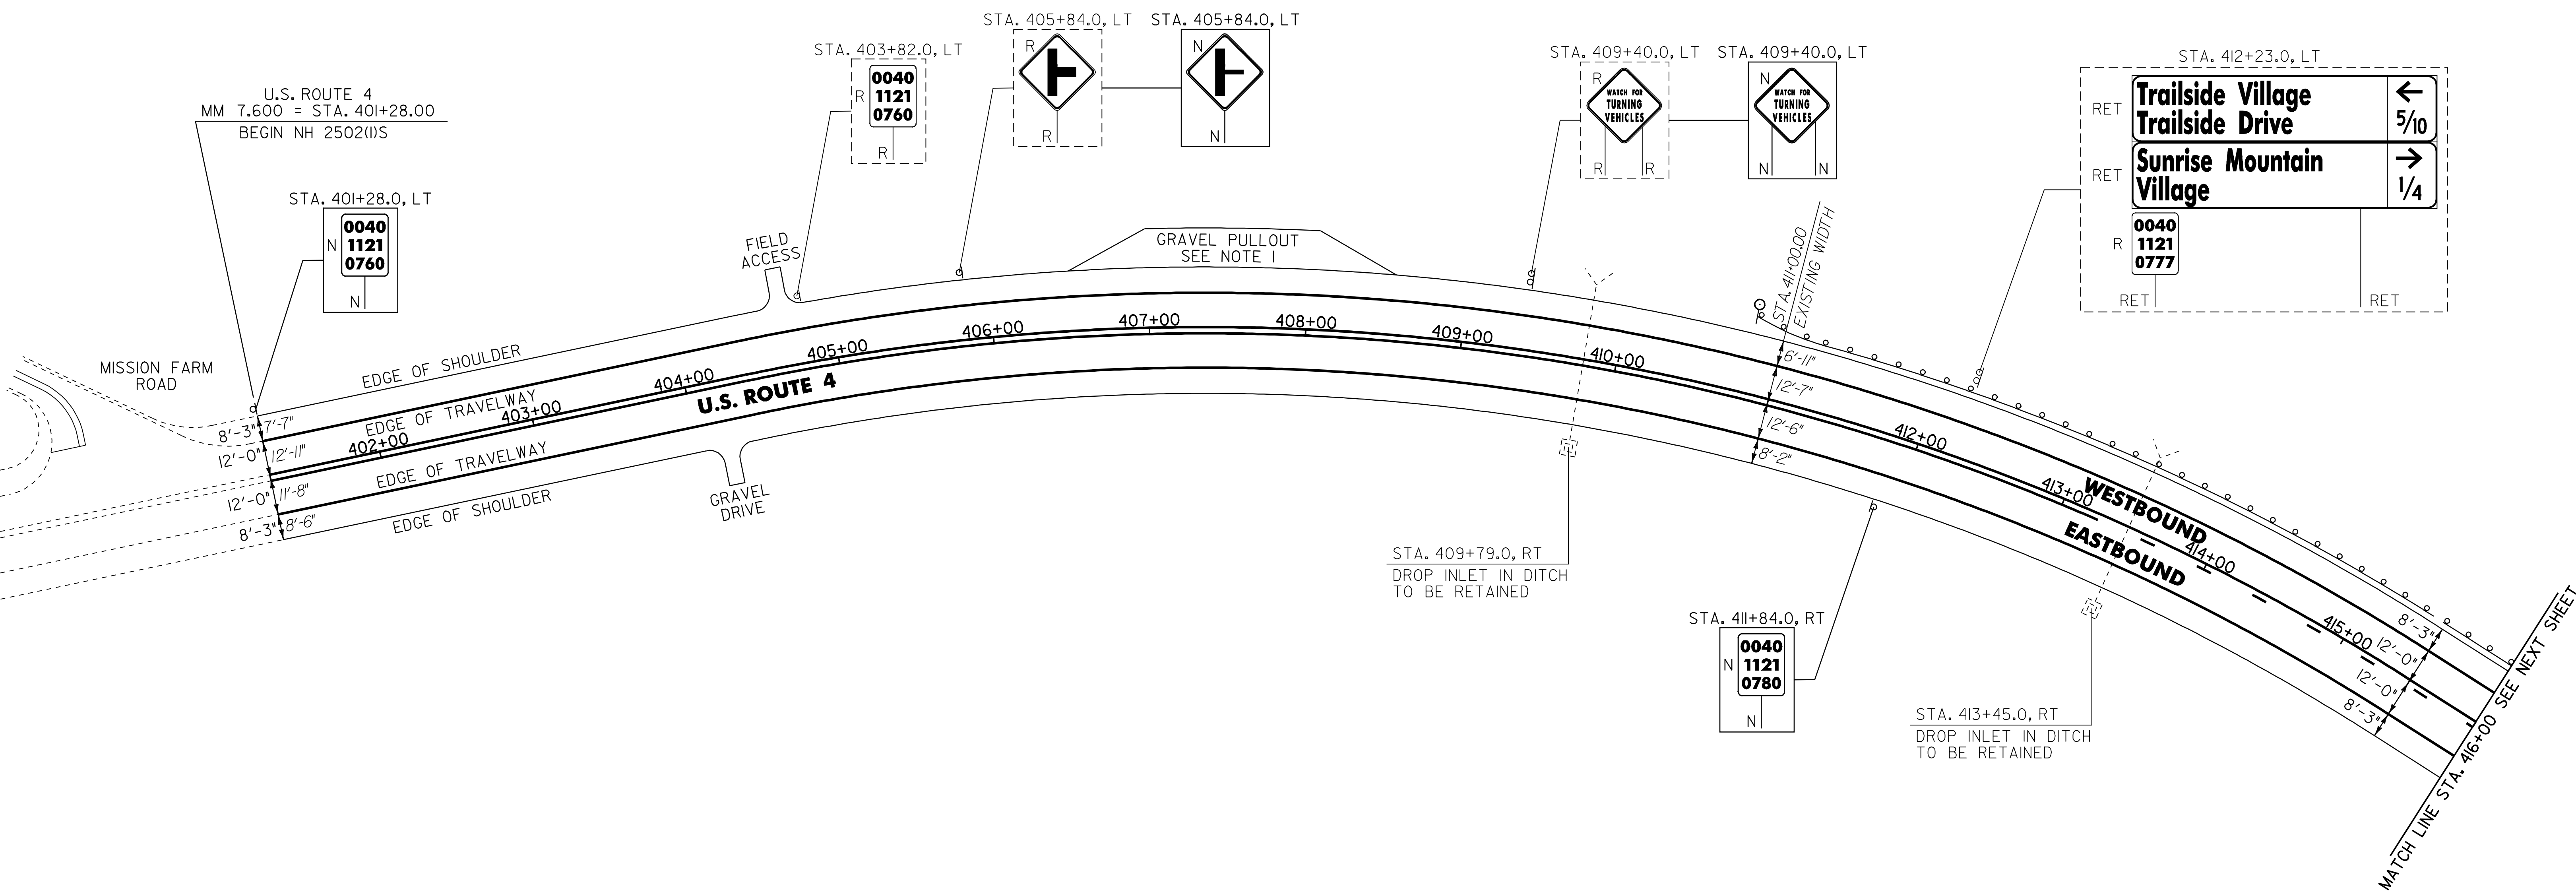

621.20 STEEL BEAM GUARDRAIL
 415+55.5 - 416+00 LT
 413+55.5 - 414+55.5 LT

621.205 STEEL BEAM GUARDRAIL, GALVANIZED W/8 FEET POSTS
 KILLINGTON:
 STA. 411+18.0 - STA. 416+00.0 LT (482.0 LF)
 414+55.5
 621.50 MANUFACTURED TERMINAL SECTION, FLARED
 KILLINGTON:
 STA. 410+80.5 - STA. 411+18.0 LT
 68.5
 411+05.5
 621.80 REMOVAL AND DISPOSAL OF GUARDRAIL
 KILLINGTON:
 STA. 411+29.0 - STA. 416+00.0 LT (471.0 LF)

~~676.10 DELINEATOR WITH STEEL POST
 TYPE I WHITE
 KILLINGTON:
 STA. 410+80.5 LT~~

SIGN LEGEND
 R = REMOVE
 S = SALVAGE
 N = NEW
 RET = RETAIN
 B-B = BACK TO BACK
 EXISTING = - - - - -
 NEW = _____

- NOTES:
1. PROVIDE A 5 FT WIDE, 1 1/4" TYPE III APRON FOR THE EXISTING GRAVEL PULLOUT. ANY REQUIRED EXCAVATION OR GRADING SHALL BE PERFORMED AS DIRECTED BY THE RESIDENT ENGINEER AND PAID FOR UNDER THE APPLICABLE RENTAL ITEM(S).
 2. THERE ARE EXISTING UNDERGROUND UTILITIES LOCATED THROUGHOUT THE U.S. ROUTE 4 CORRIDOR IN THE PROJECT AREA. THE CONTRACTOR IS RESPONSIBLE FOR CONTACTING "DIG SAFE" AT 1-888-344-7233 TO DETERMINE THE LOCATIONS OF THESE UTILITIES PRIOR TO PERFORMING ANY SUBSURFACE OPERATIONS.

NOT TO SCALE

PROJECT LAYOUT SHEET #1

PROJECT NAME: KILLINGTON - BRIDGEWATER
 PROJECT NUMBER: NH 2502(1)S
 FILE NAME: p05b036.dgn
 PROJECT LEADER: D.E.G.
 DESIGNED BY: J.S.P.
 IPARM FILE: p05b036(1).i
 PLOT DATE: 15-MAY-2008 14
 DRAWN BY: C.A.K.
 CHECKED BY: D.E.G.
 SHEET 13 OF 74