

646.482 DURABLE 24 INCH STOP BAR, THERMOPLASTIC
 BRIDGEWATER:
 STA. 2+79.84 RT, VT. ROUTE 100

646.492 DURABLE LETTER OR SYMBOL, THERMOPLASTIC
 BRIDGEWATER:
 STA. 2+79.84 RT, VT. ROUTE 100 "S,T,O,P" (4 EA)

646.682 TEMPORARY 24 INCH STOP BAR, PAINT
 BRIDGEWATER:
 STA. 2+79.84 RT, VT. ROUTE 100

646.692 TEMPORARY LETTER OR SYMBOL, PAINT
 BRIDGEWATER:
 STA. 2+79.84 RT, VT. ROUTE 100 "S,T,O,P" (8 EA)

675.50 REMOVING SIGNS
 AS SHOWN - 33

646.402 DURABLE 4 INCH WHITE LINE, THERMOPLASTIC
 (ALL LINES WILL INCLUDE EDGE LINE BREAKS AND
 RADIUS FOR TOWN HIGHWAYS)
 KILLINGTON:
 STA. 448+00.00 - STA. 450+70.08 LT & RT

BRIDGEWATER:
 STA. 0+00.00 - STA. 4+50.00 LT & RT

646.412 DURABLE 4 INCH YELLOW LINE, THERMOPLASTIC
 (ALL LINES WILL INCLUDE C/L BREAKS FOR
 TOWN HIGHWAYS) S=SOLID, D=DASHED
 KILLINGTON:
 STA. 448+00.00 - STA. 450+70.08 LT & RT

BRIDGEWATER:
 STA. 0+00.00 - STA. 4+50.00 S - S
 STA. 2+79.84 MEDIAN EDGE LINE RT, VT. ROUTE 100


646.602 TEMPORARY 4 INCH WHITE LINE, PAINT
 (ALL LINES WILL INCLUDE EDGE LINE BREAKS AND
 RADIUS FOR TOWN HIGHWAYS)
 KILLINGTON:
 STA. 448+00.00 - STA. 450+70.08 LT & RT

BRIDGEWATER:
 STA. 0+00.00 - STA. 4+50.00 LT & RT

646.612 TEMPORARY 4 INCH YELLOW LINE, PAINT
 (ALL LINES WILL INCLUDE C/L BREAKS FOR
 TOWN HIGHWAYS) S=SOLID, D=DASHED
 KILLINGTON:
 STA. 448+00.00 - STA. 450+70.08 LT & RT

BRIDGEWATER:
 STA. 0+00.00 - STA. 4+50.00 S - S
 STA. 2+79.84 MEDIAN EDGE LINE RT, VT. ROUTE 100

646.81 PAINTED CURB
 BRIDGEWATER:
 STA. 2+79.84 RAISED MEDIAN RT, VT. ROUTE 100 (70 FT)

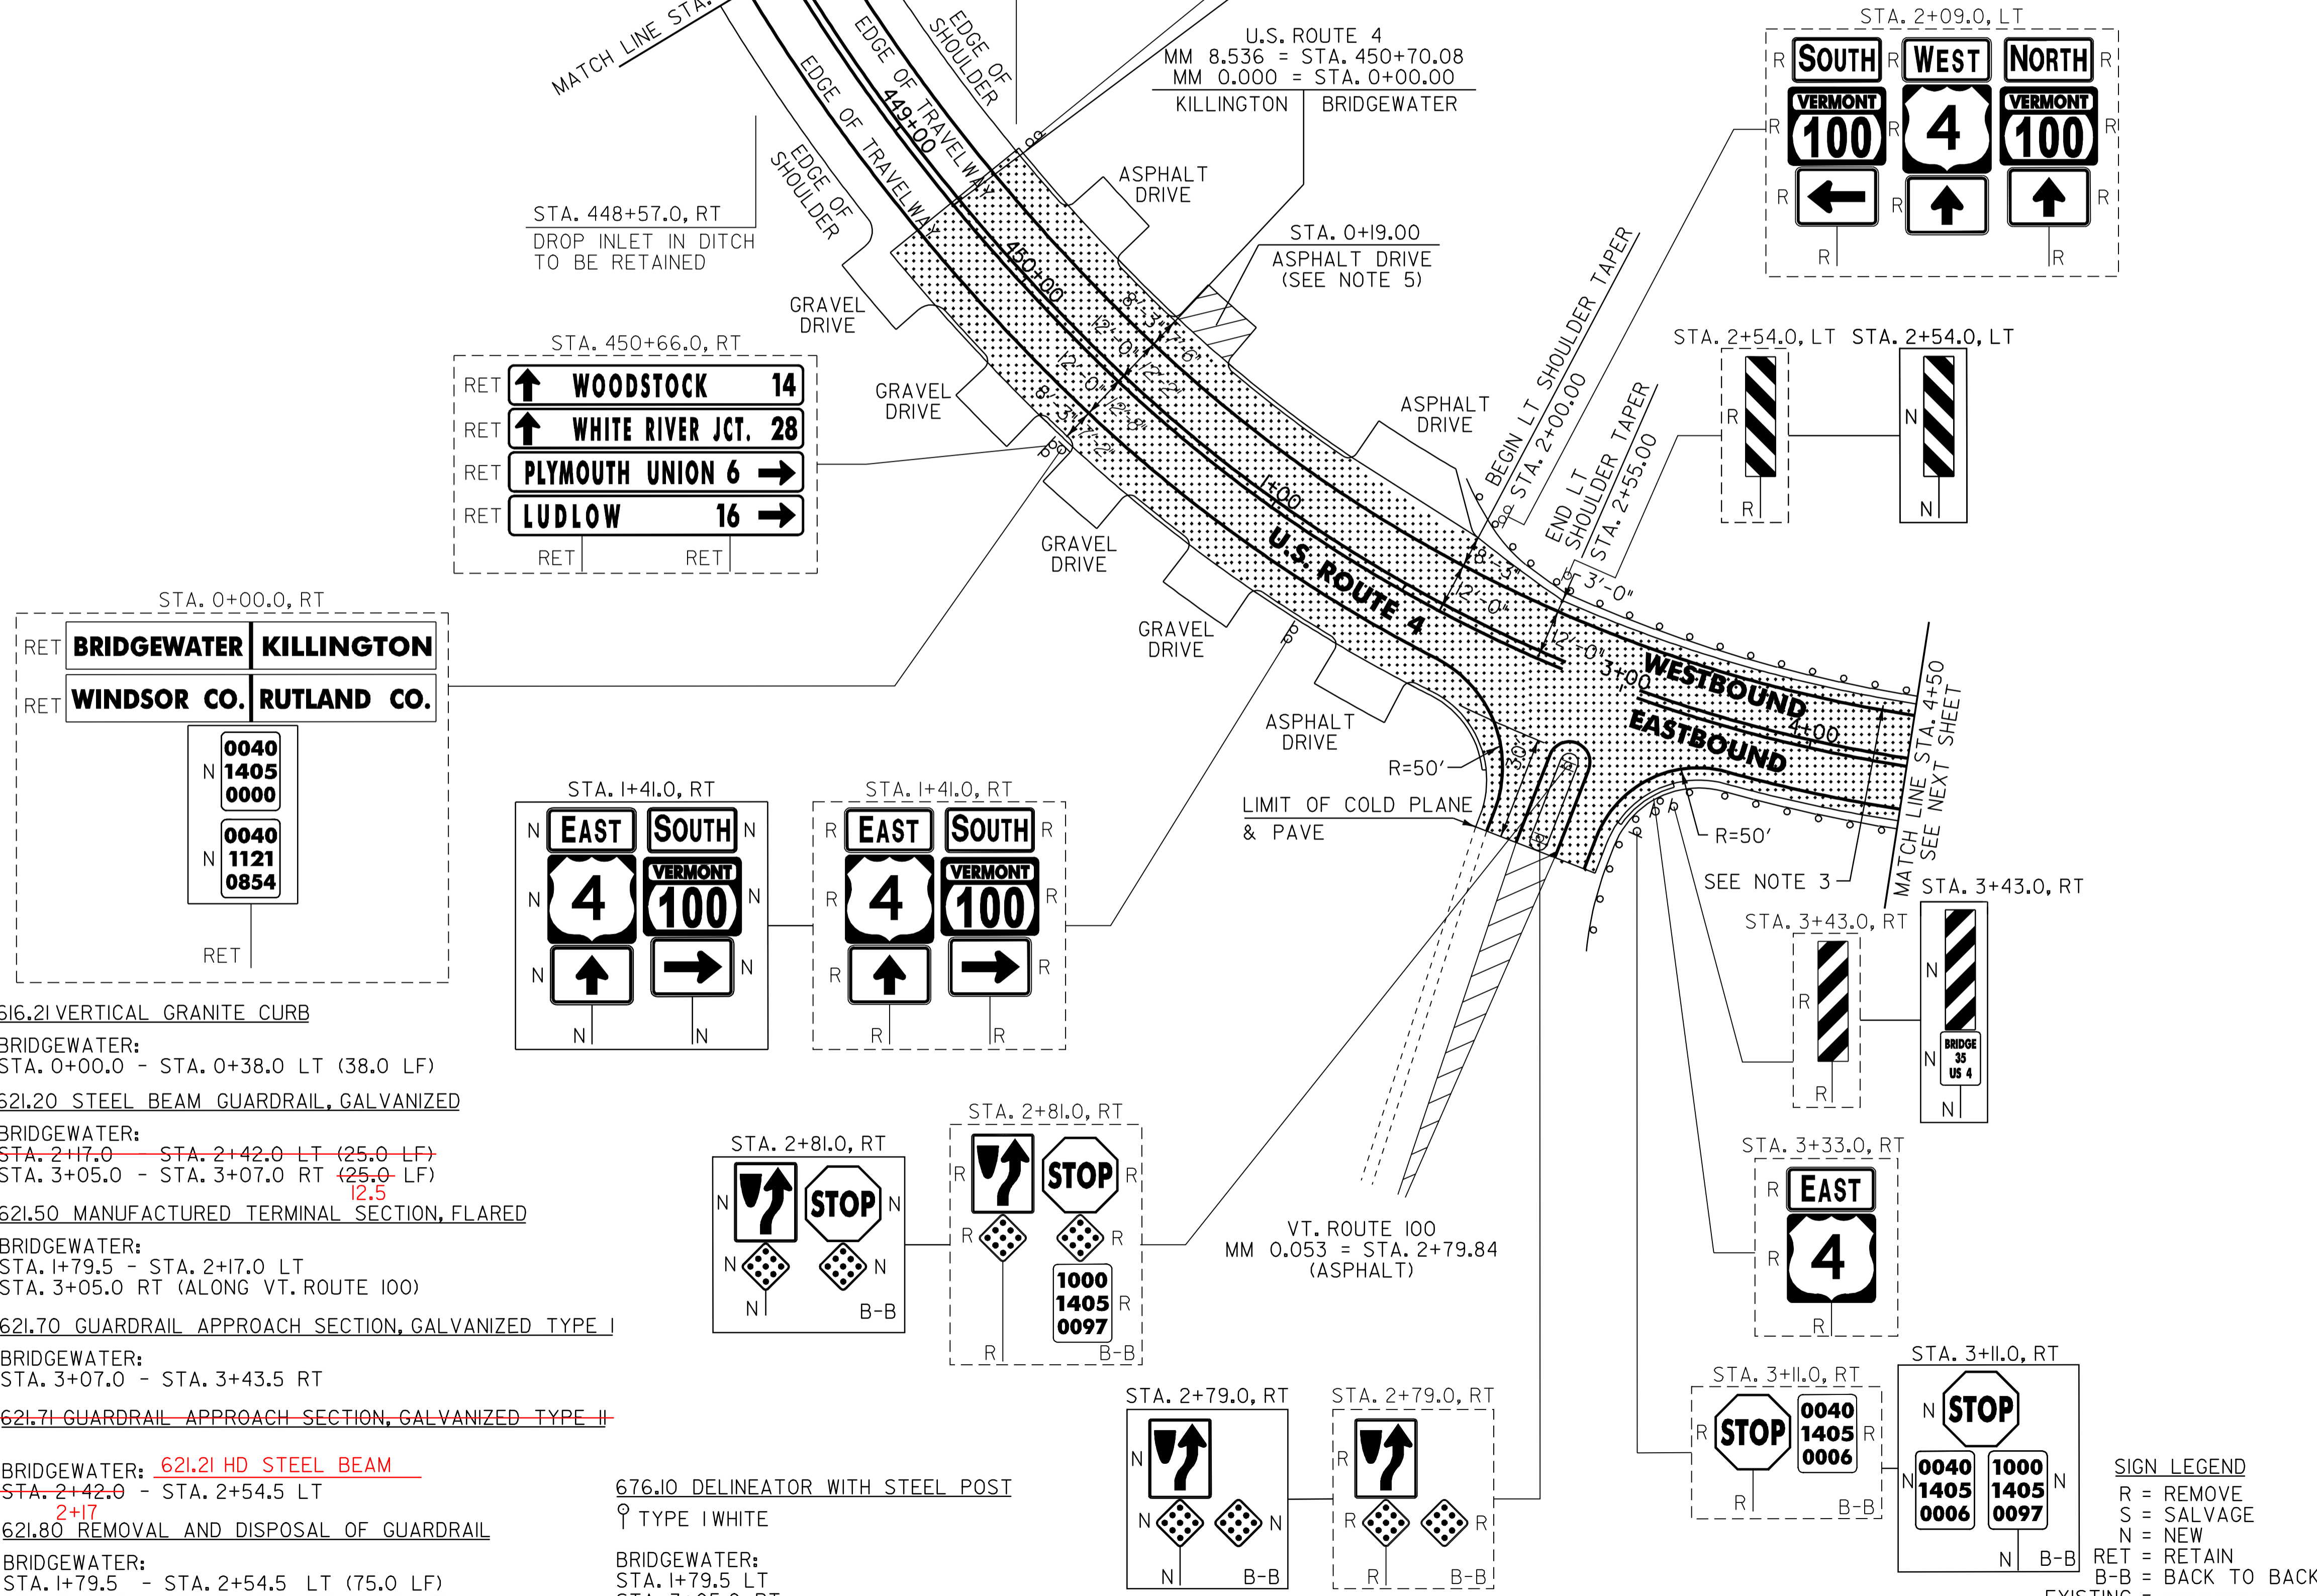

AREA TO BE COLD PLANED & PAVED

- NOTES:
- PAVING LIMIT ON ALL STATE HIGHWAYS SHALL BE MEASURED 25 FT BACK FROM U.S. ROUTE 4 EDGE OF SHOULDER UNLESS DENOTED OTHERWISE ON THE PLANS OR AS DIRECTED BY THE RESIDENT ENGINEER.
 - SEE SHEET 66 FOR BRIDGE 35 DETAILS.
 - THERE ARE FIVE EXISTING DRAINAGE STRUCTURES LOCATED IN THE WESTBOUND SHOULDER ON BR 35. HEIGHT ADJUSTMENTS OR REHABILITATIONS WILL NOT BE REQUIRED.
 - THERE ARE EXISTING UNDERGROUND UTILITIES LOCATED THROUGHOUT THE U.S. ROUTE 4 CORRIDOR IN THE PROJECT AREA. THE CONTRACTOR IS RESPONSIBLE FOR CONTACTING "DIG SAFE" AT 1-888-344-7233 TO DETERMINE THE LOCATIONS OF THESE UTILITIES PRIOR TO PERFORMING ANY SUBSURFACE OPERATIONS.
 - THE CONTRACTOR SHALL REMOVE THE EXISTING DRIVEWAY AS DIRECTED BY THE RESIDENT ENGINEER. ESTIMATE QUANTITIES OF ITEMS 608.25 ALL PURPOSE EXCAVATION RENTAL, TYPE I; ITEM 616.21 VERTICAL GRANITE CURB; ITEM 651.15 SEED AND ITEM 651.35 TOPSOIL HAVE BEEN INCLUDED TO PAY FOR THIS WORK AS DIRECTED BY THE RESIDENT ENGINEER.

616.21 VERTICAL GRANITE CURB
 BRIDGEWATER:
 STA. 0+00.0 - STA. 0+38.0 LT (38.0 LF)

621.20 STEEL BEAM GUARDRAIL, GALVANIZED
 BRIDGEWATER:
~~STA. 2+17.0 - STA. 2+42.0 LT (25.0 LF)~~
~~STA. 3+05.0 - STA. 3+07.0 RT (25.0 LF)~~

621.50 MANUFACTURED TERMINAL SECTION, FLARED
 BRIDGEWATER:
 STA. 1+79.5 - STA. 2+17.0 LT
 STA. 3+05.0 RT (ALONG VT. ROUTE 100)

621.70 GUARDRAIL APPROACH SECTION, GALVANIZED TYPE I
 BRIDGEWATER:
 STA. 3+07.0 - STA. 3+43.5 RT

~~621.71 GUARDRAIL APPROACH SECTION, GALVANIZED TYPE II~~

BRIDGEWATER: 621.21 HD STEEL BEAM
~~STA. 2+42.0 - STA. 2+54.5 LT~~
 2+17

621.80 REMOVAL AND DISPOSAL OF GUARDRAIL
 BRIDGEWATER:
 STA. 1+79.5 - STA. 2+54.5 LT (75.0 LF)
 STA. 3+05.0 - STA. 3+43.5 RT (100.0 LF)

676.10 DELINEATOR WITH STEEL POST
 ♀ TYPE I WHITE
 BRIDGEWATER:
 STA. 1+79.5 LT
 STA. 3+05.0 RT

SIGN LEGEND
 R = REMOVE
 S = SALVAGE
 N = NEW
 RET = RETAIN
 B-B = BACK TO BACK
 EXISTING = - - - - -
 NEW = _____

PROJECT LAYOUT SHEET #4	PROJECT NAME: KILLINGTON - BRIDGEWATER	
	PROJECT NUMBER: NH 2502(1)S	
	FILE NAME: p05b036.dgn	PLOT DATE: 15-MAY-2008 14
	PROJECT LEADER: D.E.G.	DRAWN BY: C.A.K.
	DESIGNED BY: J.S.P.	CHECKED BY: D.E.G.
	IPARM FILE: p05b036i04.i	SHEET 16 OF 74