

646.402 DURABLE 4 INCH WHITE LINE, THERMOPLASTIC  
 (ALL LINES WILL INCLUDE EDGE LINE BREAKS AND  
 RADIUS FOR TOWN HIGHWAYS  
 BRIDGEWATER:  
 STA. 4+50.00 - STA. 16+00.00 LT & RT

646.602 TEMPORARY 4 INCH WHITE LINE, THERMOPLASTIC  
 (ALL LINES WILL INCLUDE EDGE LINE BREAKS AND  
 RADIUS FOR TOWN HIGHWAYS  
 BRIDGEWATER:  
 STA. 4+50.00 - STA. 16+00.00 LT & RT

646.412 DURABLE 4 INCH YELLOW LINE, THERMOPLASTIC  
 (ALL LINES WILL INCLUDE C/L BREAKS FOR  
 TOWN HIGHWAYS) S=SOLID, D=DASHED  
 BRIDGEWATER:  
 STA. 4+50.00 - STA. 9+00.00 LT  
 STA. 9+00.00 - STA. 16+00.00 S  
 STA. 5+96.64 DOUBLE SOLID LT, TH-39

646.612 TEMPORARY 4 INCH YELLOW LINE, THERMOPLASTIC  
 (ALL LINES WILL INCLUDE C/L BREAKS FOR  
 TOWN HIGHWAYS) S=SOLID, D=DASHED  
 BRIDGEWATER:  
 STA. 4+50.00 - STA. 9+00.00 LT  
 STA. 9+00.00 - STA. 16+00.00 S  
 STA. 5+96.64 DOUBLE SOLID LT, TH-39

646.482 DURABLE 24 INCH STOP BAR, THERMOPLASTIC  
 BRIDGEWATER:  
 STA. 5+96.64 LT, TH-39


















646.492 DURABLE LETTER OR SYMBOL, THERMOPLASTIC  
 BRIDGEWATER:  
 STA. 5+96.64 LT, TH-39 "S,T,O,P" (4 EA)

646.682 TEMPORARY 24 INCH STOP BAR, PAINT  
 BRIDGEWATER:  
 STA. 5+96.64 LT, TH-39

646.692 TEMPORARY LETTER OR SYMBOL, PAINT  
 BRIDGEWATER:  
 STA. 5+96.64 LT, TH-39 "S,T,O,P" (4 EA)

675.50 REMOVING SIGNS  
 AS SHOWN - 17

675.60 ERECTING SALVAGED SIGNS  
 AS SHOWN - 1

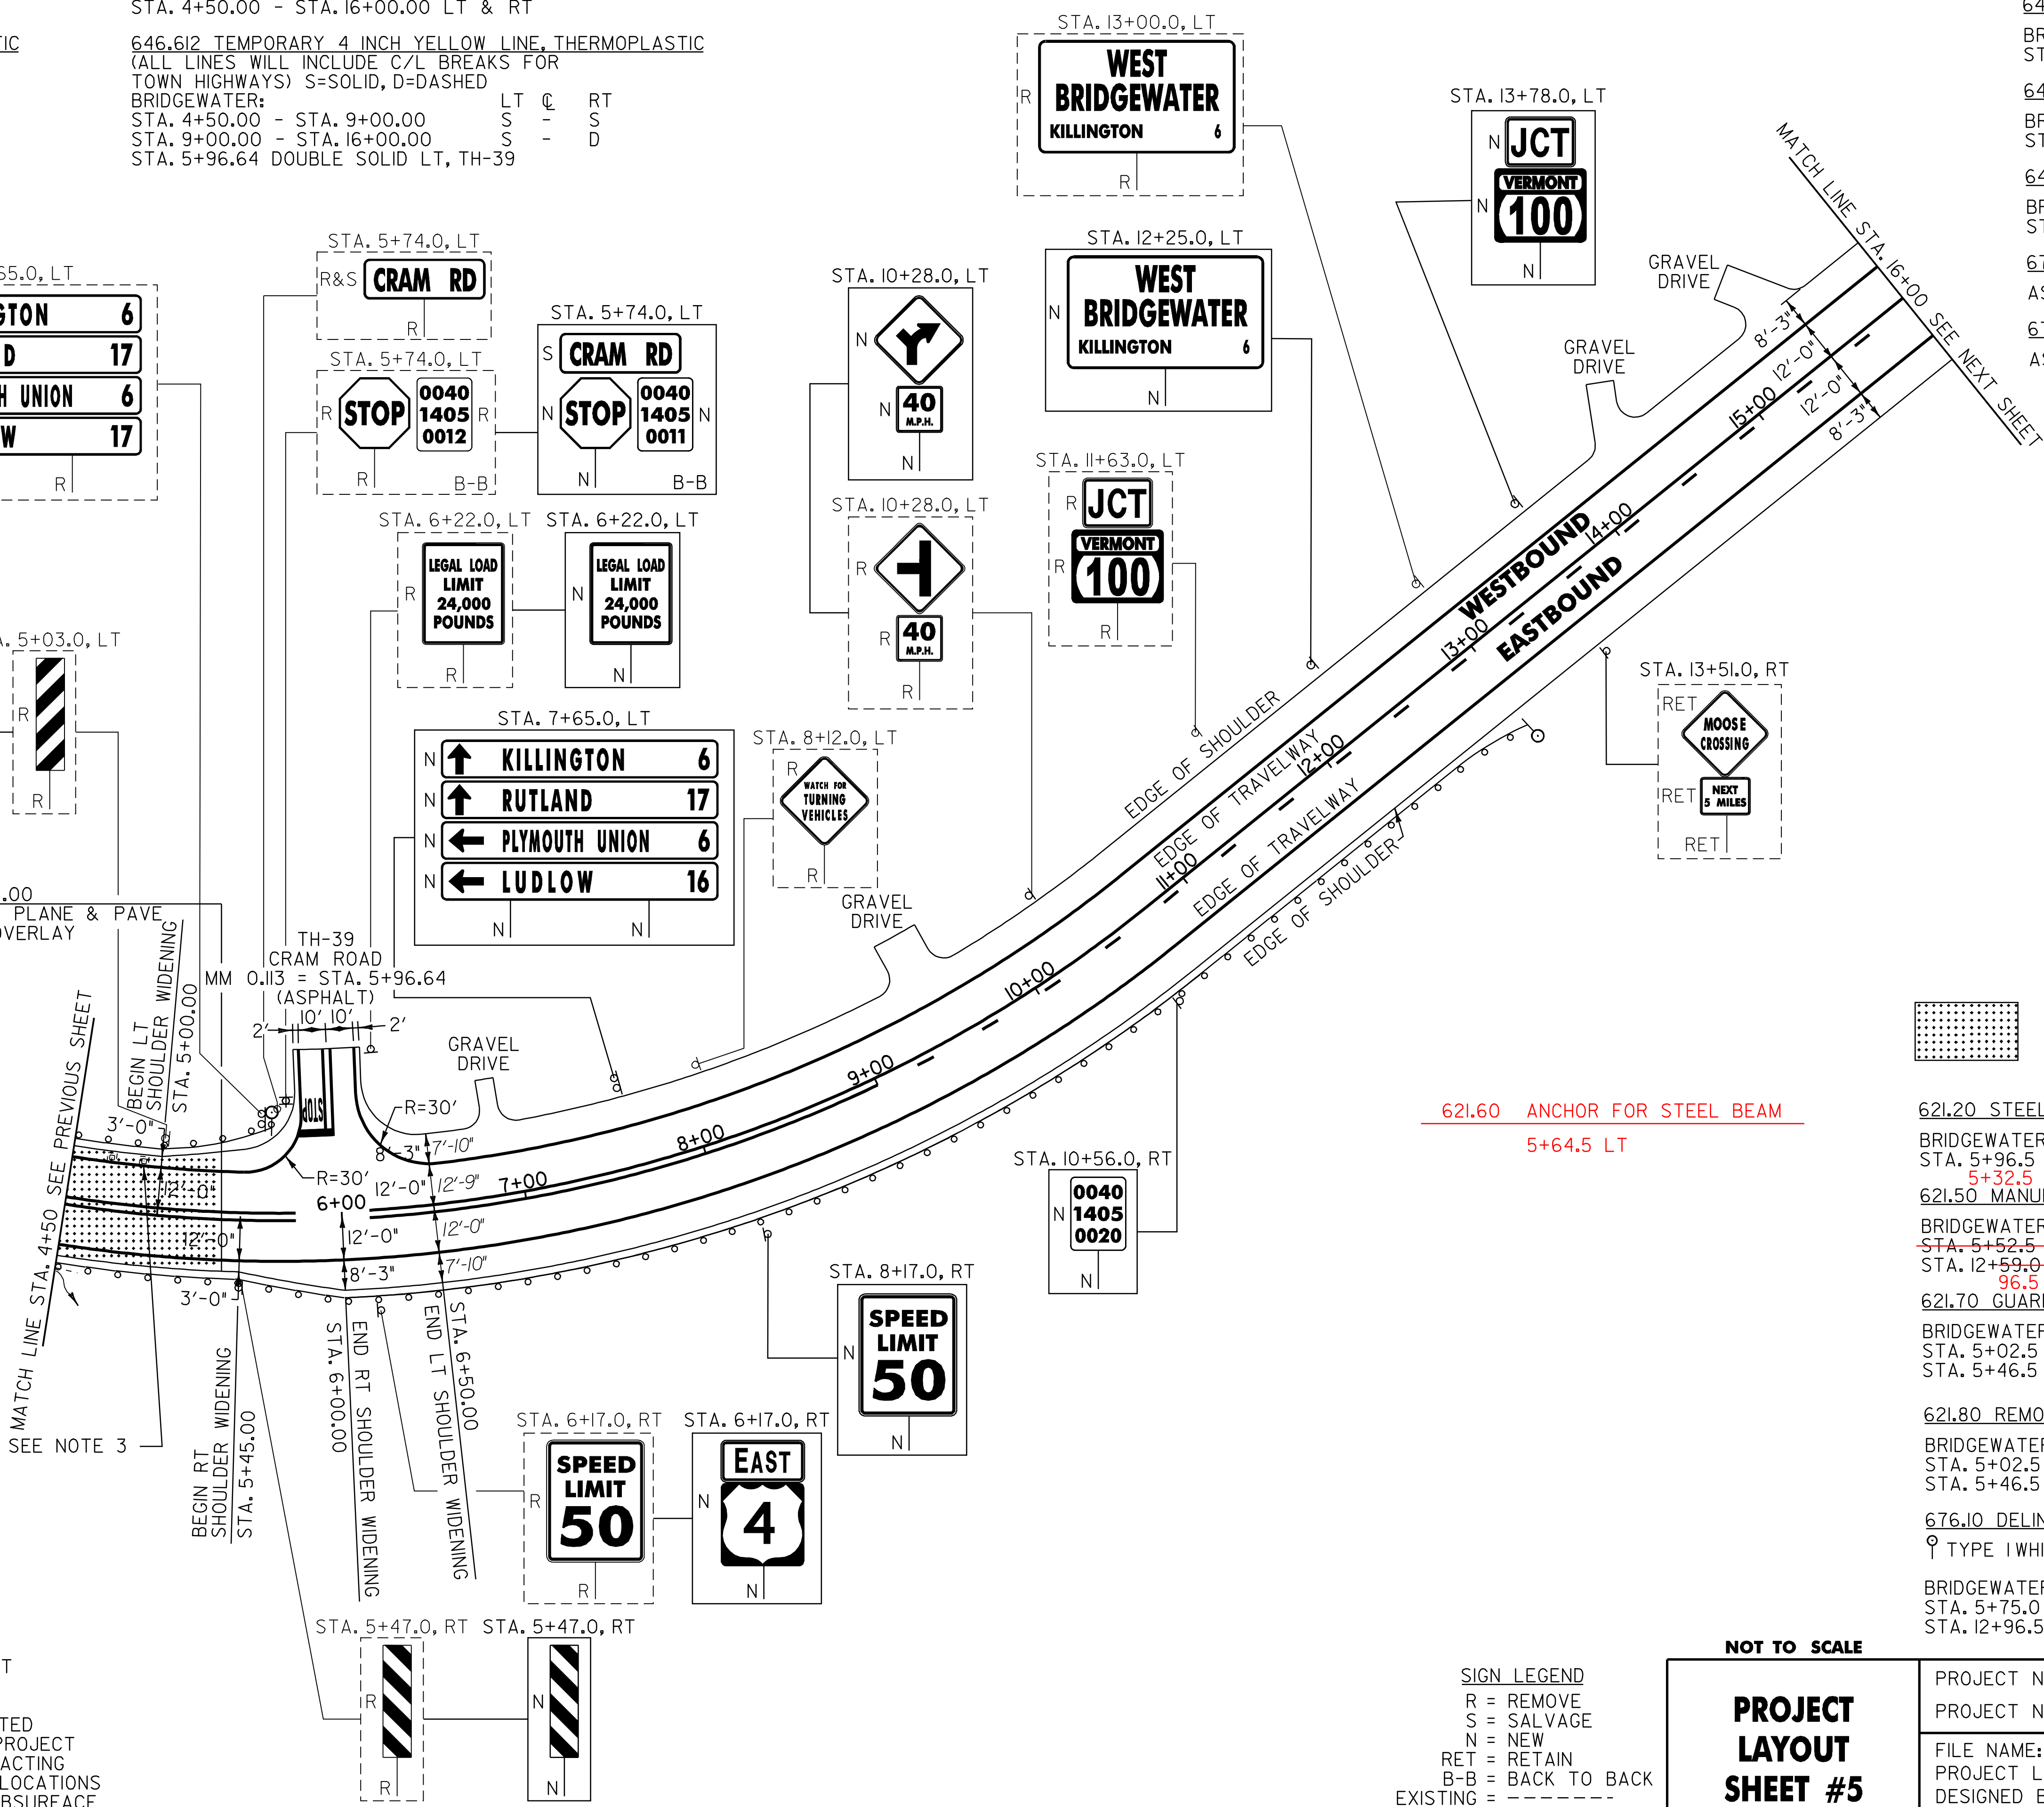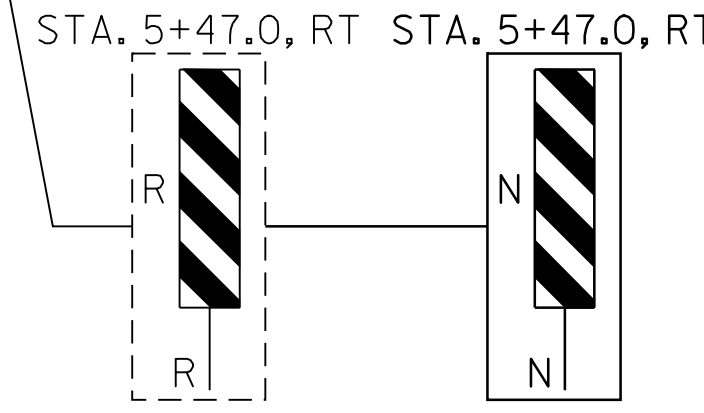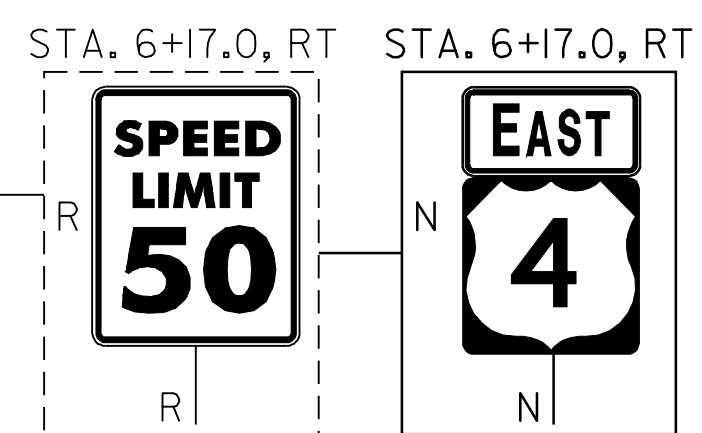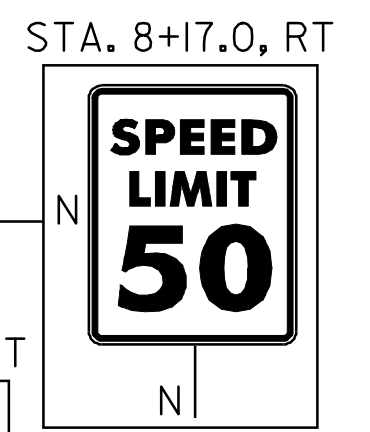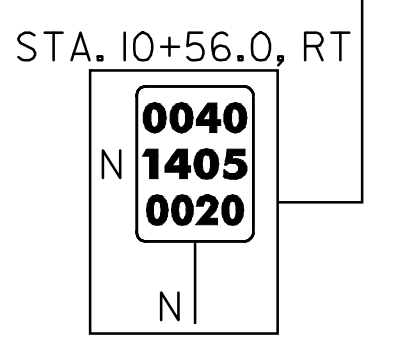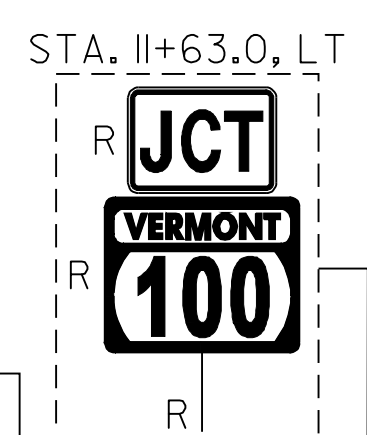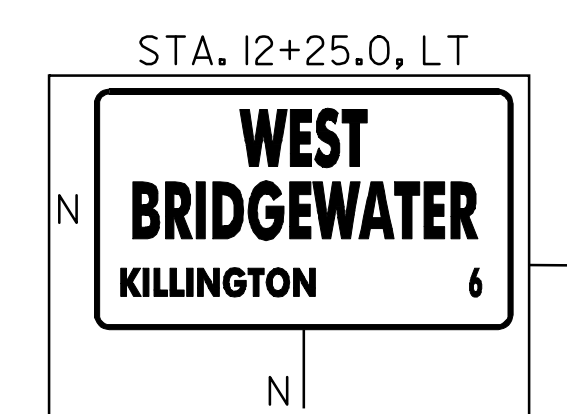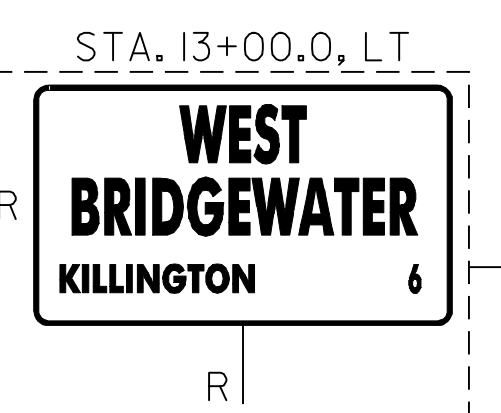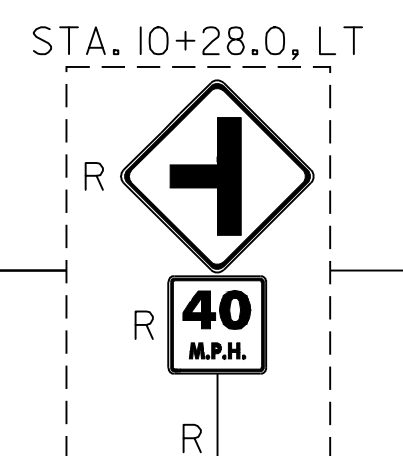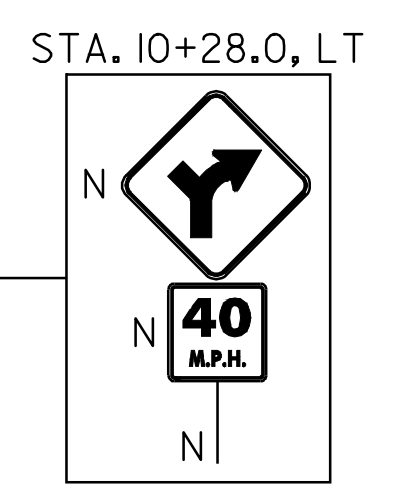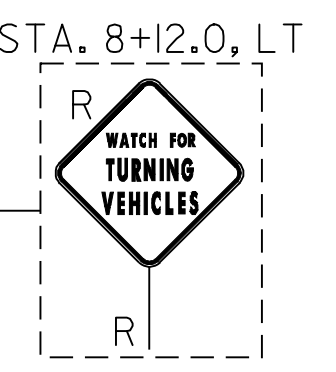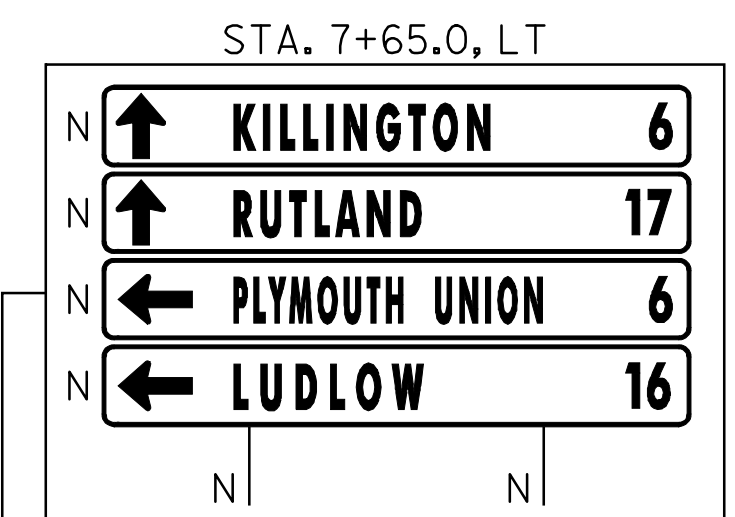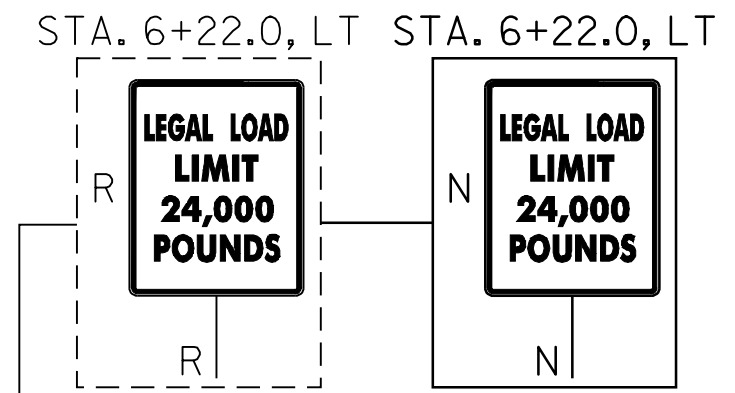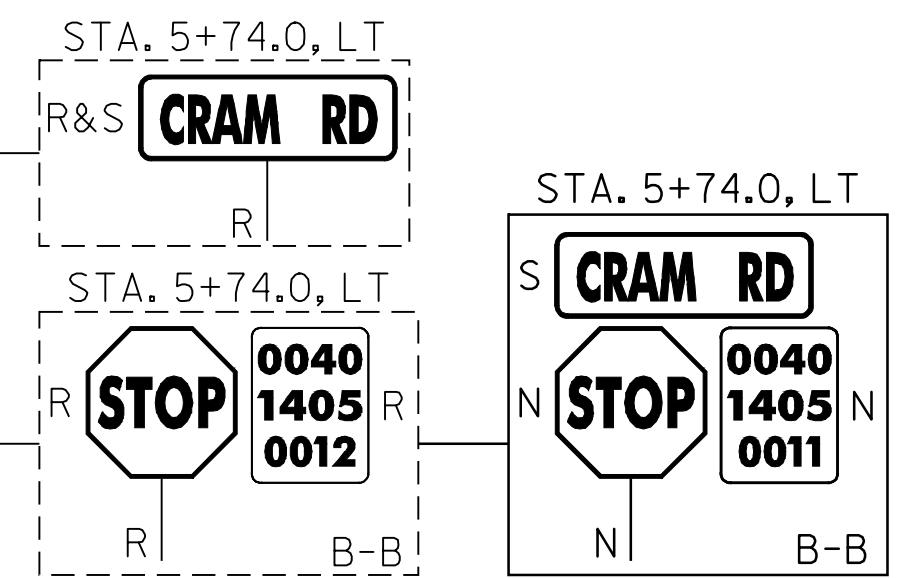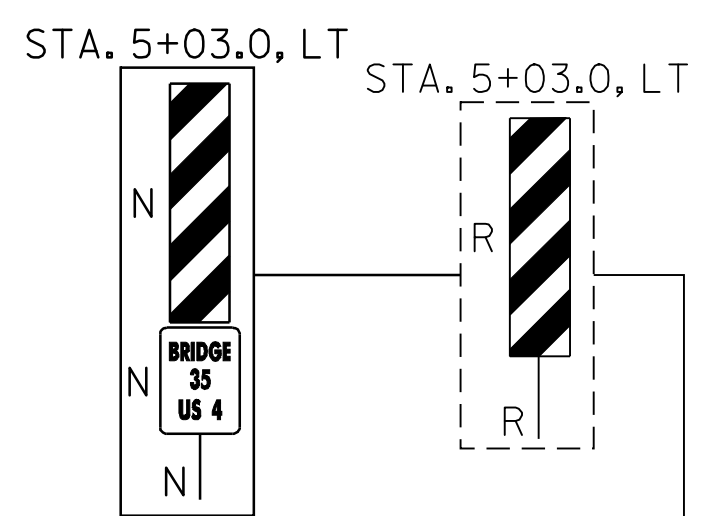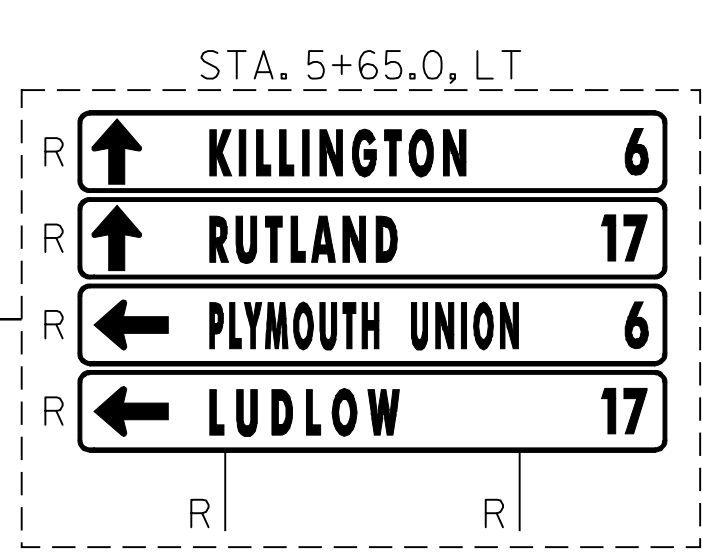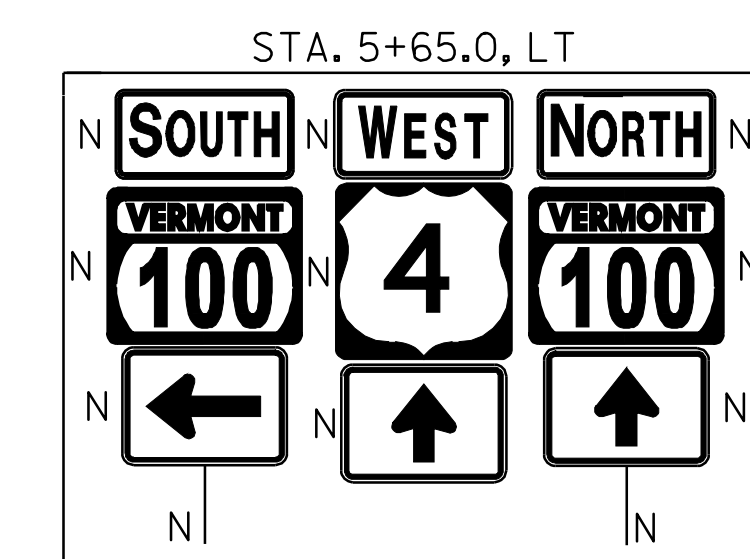

AREA TO BE COLD PLANED & PAVED

621.60 ANCHOR FOR STEEL BEAM  
 5+64.5 LT

621.20 STEEL BEAM GUARDRAIL, GALVANIZED  
 BRIDGEWATER:  
 STA. 5+96.5 - STA. 12+59.0 RT (662.5 LF)  
 5+32.5 - 5+75.5 LT

621.50 MANUFACTURED TERMINAL SECTION, FLARED  
 BRIDGEWATER:  
~~STA. 5+52.5 - STA. 5+75.0 LT~~  
 STA. 12+59.0 - STA. 12+96.5 RT  
 96.5 13+34

621.70 GUARDRAIL APPROACH SECTION, GALVANIZED TYPE I  
 BRIDGEWATER:  
 STA. 5+02.5 - STA. 5+52.5 LT  
 STA. 5+46.5 - STA. 5+96.5 RT

621.80 REMOVAL AND DISPOSAL OF GUARDRAIL  
 BRIDGEWATER:  
 STA. 5+02.5 - STA. 5+75.0 LT (75.0 LF)  
 STA. 5+46.5 - STA. 12+96.5 RT (748.5 LF)  
 13+21.5 775

676.10 DELINEATOR WITH STEEL POST  
 ♀ TYPE I WHITE  
 BRIDGEWATER:  
 STA. 5+75.0 LT  
 STA. 12+96.5 RT

- NOTES:
- PAVING LIMIT ON ALL TOWN HIGHWAYS SHALL BE MEASURED 25 FT BACK FROM U.S. ROUTE 4 EDGE OF SHOULDER UNLESS DENOTED OTHERWISE ON THE PLANS OR AS DIRECTED BY THE RESIDENT ENGINEER.
  - SEE SHEET 66 FOR BRIDGE 35 DETAILS.
  - THERE ARE FIVE EXISTING DRAINAGE STRUCTURES LOCATED IN THE WESTBOUND SHOULDER ON BR 35. HEIGHT ADJUSTMENTS OR REHABILITATIONS WILL NOT BE REQUIRED.
  - THERE ARE EXISTING UNDERGROUND UTILITIES LOCATED THROUGHOUT THE U.S. ROUTE 4 CORRIDOR IN THE PROJECT AREA. THE CONTRACTOR IS RESPONSIBLE FOR CONTACTING "DIG SAFE" AT 1-888-344-7233 TO DETERMINE THE LOCATIONS OF THESE UTILITIES PRIOR TO PERFORMING ANY SUBSURFACE OPERATIONS.

SIGN LEGEND  
 R = REMOVE  
 S = SALVAGE  
 N = NEW  
 RET = RETAIN  
 B-B = BACK TO BACK  
 EXISTING = - - - - -  
 NEW = \_\_\_\_\_

NOT TO SCALE  
**PROJECT LAYOUT SHEET #5**

PROJECT NAME: KILLINGTON - BRIDGEWATER  
 PROJECT NUMBER: NH 2502(1)S  
 FILE NAME: p05b036.dgn  
 PROJECT LEADER: D.E.G.  
 DESIGNED BY: J.S.P.  
 IPARM FILE: p05b036i05.i  
 PLOT DATE: 15-MAY-2008 14  
 DRAWN BY: C.A.K.  
 CHECKED BY: D.E.G.  
 SHEET 17 OF 74