


646.402 DURABLE 4 INCH WHITE LINE, THERMOPLASTIC
 (ALL LINES WILL INCLUDE EDGE LINE BREAKS AND RADIUS FOR TOWN HIGHWAYS)
 BRIDGEWATER:
 STA. 48+00.00 - STA. 64+00.00 LT & RT

646.412 DURABLE 4 INCH YELLOW LINE, THERMOPLASTIC
 (ALL LINES WILL INCLUDE C/L BREAKS FOR TOWN HIGHWAYS) S=SOLID, D=DASHED
 BRIDGEWATER:
 STA. 48+00.00 - STA. 53+35.00 LT C S
 STA. 53+35.00 - STA. 54+10.00 D - S
 STA. 54+10.00 - STA. 61+00.00 S - D
 STA. 61+00.00 - STA. 63+35.00 - D -
 STA. 63+35.00 - STA. 64+00.00 D - S

646.602 TEMPORARY 4 INCH WHITE LINE, PAINT
 (ALL LINES WILL INCLUDE EDGE LINE BREAKS AND RADIUS FOR TOWN HIGHWAYS)
 BRIDGEWATER:
 STA. 48+00.00 - STA. 64+00.00 LT & RT

646.612 TEMPORARY 4 INCH YELLOW LINE, PAINT
 (ALL LINES WILL INCLUDE C/L BREAKS FOR TOWN HIGHWAYS) S=SOLID, D=DASHED
 BRIDGEWATER:
 STA. 48+00.00 - STA. 53+35.00 LT C S
 STA. 53+35.00 - STA. 54+10.00 D - S
 STA. 54+10.00 - STA. 61+00.00 S - D
 STA. 61+00.00 - STA. 63+35.00 - D -
 STA. 63+35.00 - STA. 64+00.00 D - S

675.50 REMOVING SIGNS
 AS SHOWN - I

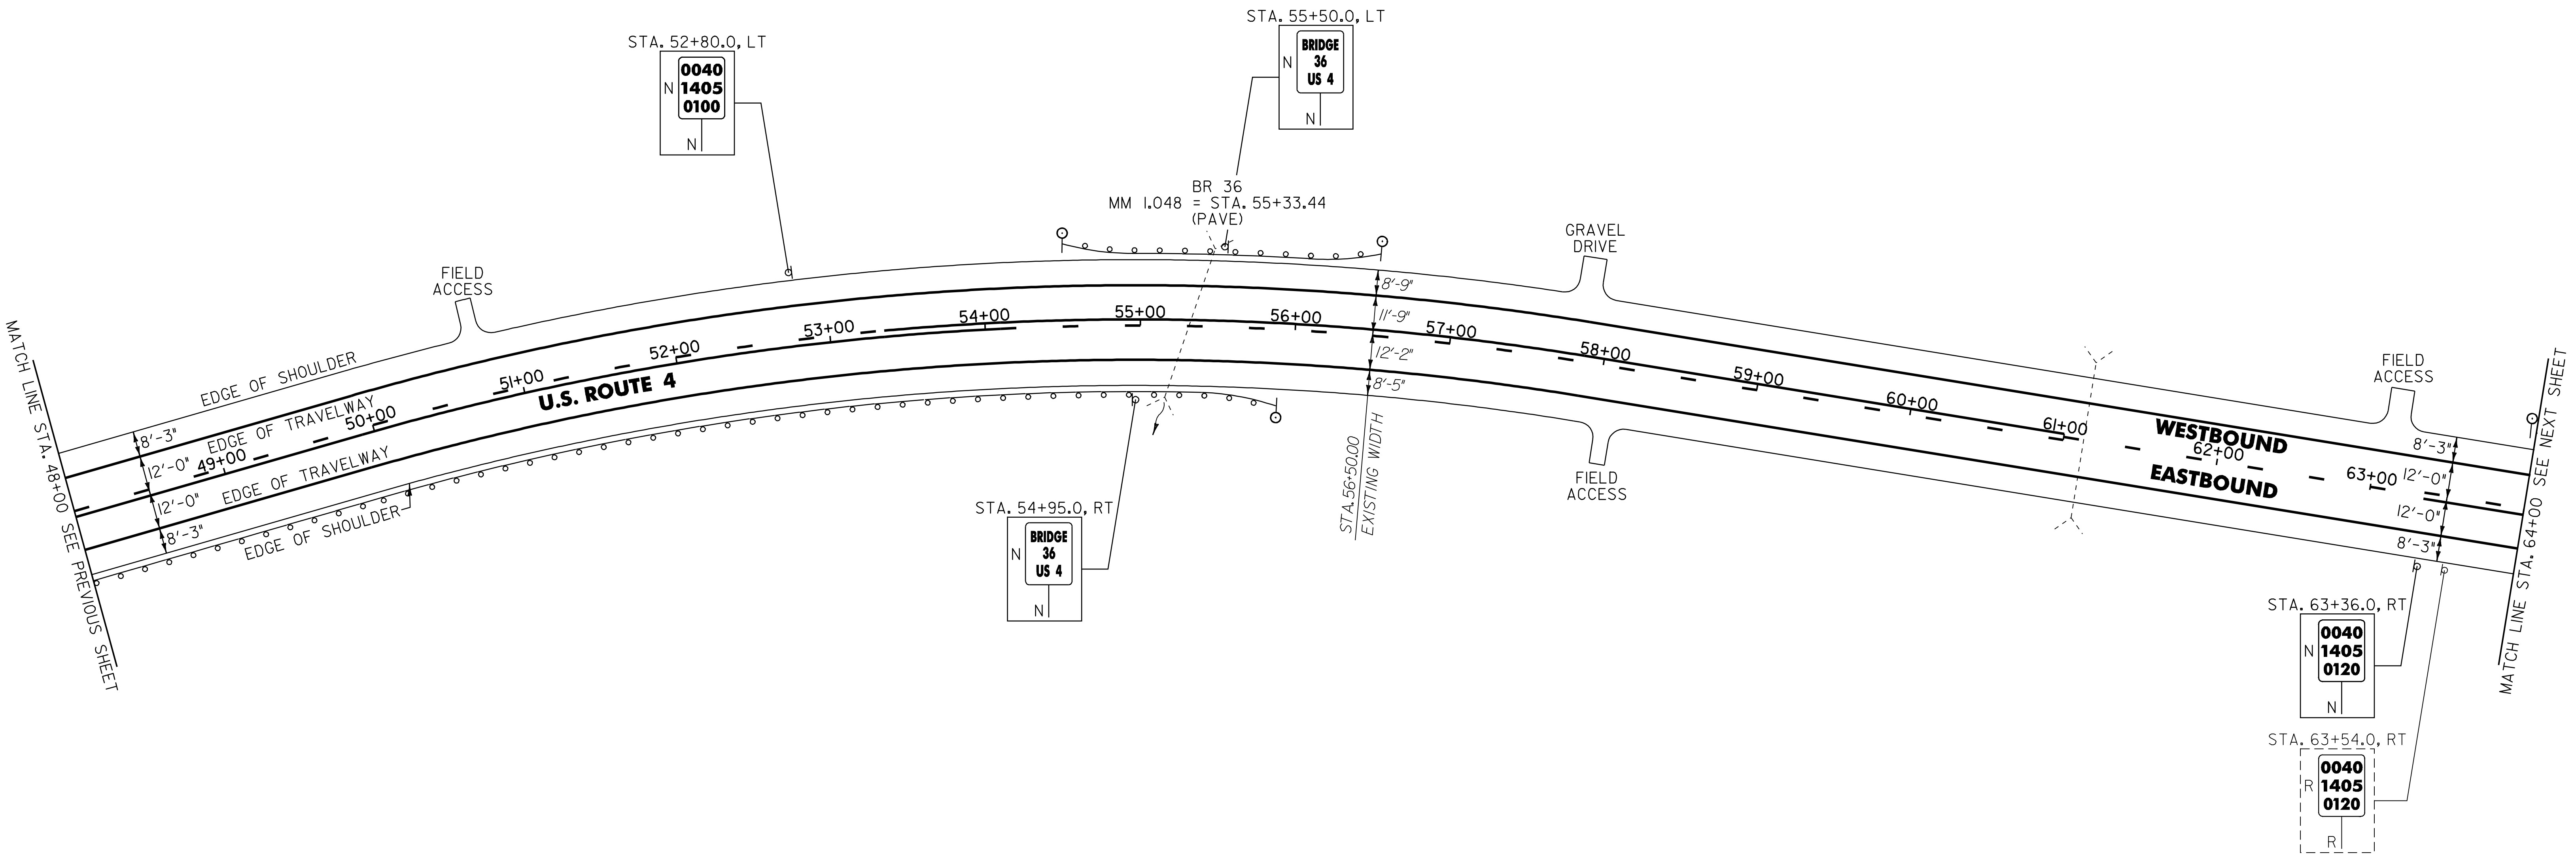

621.205 STEEL BEAM GUARDRAIL W/ 8' POSTS
 49+44 - 50+94 RT (150')

621.20 STEEL BEAM GUARDRAIL, GALVANIZED
 KILLINGTON: 56.5 48+00 - 49+44 RT
 50+94 STA. 48+00.0 - STA. 55+52.0 RT (752.0 LF)
 STA. 54+88.0 - STA. 56+13.0 LT (125.0 LF)

621.50 MANUFACTURED TERMINAL SECTION, FLARED
 KILLINGTON:
 STA. 54+50.5 - STA. 54+88.0 LT
 55+56.5 STA. 55+52.0 - STA. 55+89.5 RT 94
 STA. 56+13.0 - STA. 56+50.5 LT

621.80 REMOVAL AND DISPOSAL OF GUARDRAIL
 KILLINGTON:
 STA. 48+00.0 - STA. 55+67.0 RT (767.0 LF)
 STA. 54+83.0 - STA. 56+10.0 LT (127.0 LF) 125

676.10 DELINEATOR WITH STEEL POST
 ♀ TYPE I WHITE

BRIDGEWATER:
 STA. 54+50.5 LT
 STA. 55+89.5 RT
 STA. 56+50.5 LT
 STA. 63+99.5 LT

SIGN LEGEND
 R = REMOVE
 S = SALVAGE
 N = NEW
 RET = RETAIN
 B-B = BACK TO BACK
 EXISTING = - - - - -
 NEW = _____

NOTE:
 I. THERE ARE EXISTING UNDERGROUND UTILITIES LOCATED THROUGHOUT THE U.S. ROUTE 4 CORRIDOR IN THE PROJECT AREA. THE CONTRACTOR IS RESPONSIBLE FOR CONTACTING "DIG SAFE" AT 1-888-344-7233 TO DETERMINE THE LOCATIONS OF THESE UTILITIES PRIOR TO PERFORMING ANY SUBSURFACE OPERATIONS.

PROJECT LAYOUT SHEET #8	NOT TO SCALE	
	PROJECT NAME: KILLINGTON - BRIDGEWATER	
	PROJECT NUMBER: NH 2502(1)S	
FILE NAME: p05b036.dgn	PLOT DATE: 15-MAY-2008 14	
PROJECT LEADER: D.E.G.	DRAWN BY: C.A.K.	
DESIGNED BY: J.S.P.	CHECKED BY: D.E.G.	
IPARM FILE: p05b036i08.i	SHEET 20 OF 74	