

646.402 DURABLE 4 INCH WHITE LINE, THERMOPLASTIC  
 (ALL LINES WILL INCLUDE EDGE LINE BREAKS AND RADIUS FOR TOWN HIGHWAYS)  
 BRIDGEWATER:  
 STA. 96+00.00 - STA. 112+00.00 LT & RT

646.412 DURABLE 4 INCH YELLOW LINE, THERMOPLASTIC  
 (ALL LINES WILL INCLUDE C/L BREAKS FOR TOWN HIGHWAYS) S=SOLID, D=DASHED  
 BRIDGEWATER:  
 STA. 96+00.00 - STA. 112+00.00 LT & RT  
 STA. 109+50.72 DOUBLE SOLID LT, TH-23

646.482 DURABLE 24 INCH STOP BAR, THERMOPLASTIC  
 BRIDGEWATER:  
 STA. 109+50.72 LT, TH-23

646.492 DURABLE LETTER OR SYMBOL, THERMOPLASTIC  
 BRIDGEWATER:  
 STA. 109+50.72 LT, TH-23, "S,T,O,P" (4 EA)

646.602 TEMPORARY 4 INCH WHITE LINE, PAINT  
 (ALL LINES WILL INCLUDE EDGE LINE BREAKS AND RADIUS FOR TOWN HIGHWAYS)  
 BRIDGEWATER:  
 STA. 96+00.00 - STA. 112+00.00 LT & RT


646.612 TEMPORARY 4 INCH YELLOW LINE, PAINT  
 (ALL LINES WILL INCLUDE C/L BREAKS FOR TOWN HIGHWAYS) S=SOLID, D=DASHED  
 BRIDGEWATER:  
 STA. 96+00.00 - STA. 112+00.00 LT & RT  
 STA. 109+50.72 DOUBLE SOLID LT, TH-23

646.682 TEMPORARY 24 INCH STOP BAR, PAINT  
 BRIDGEWATER:  
 STA. 109+50.72 LT, TH-23

646.692 TEMPORARY LETTER OR SYMBOL, PAINT  
 BRIDGEWATER:  
 STA. 109+50.72 LT, TH-23, "S,T,O,P" (4 EA)  
 STA. 106+02.0, LT

675.50 REMOVING SIGNS  
 AS SHOWN - 7

675.60 ERECTING SALVAGED SIGNS  
 AS SHOWN - 1

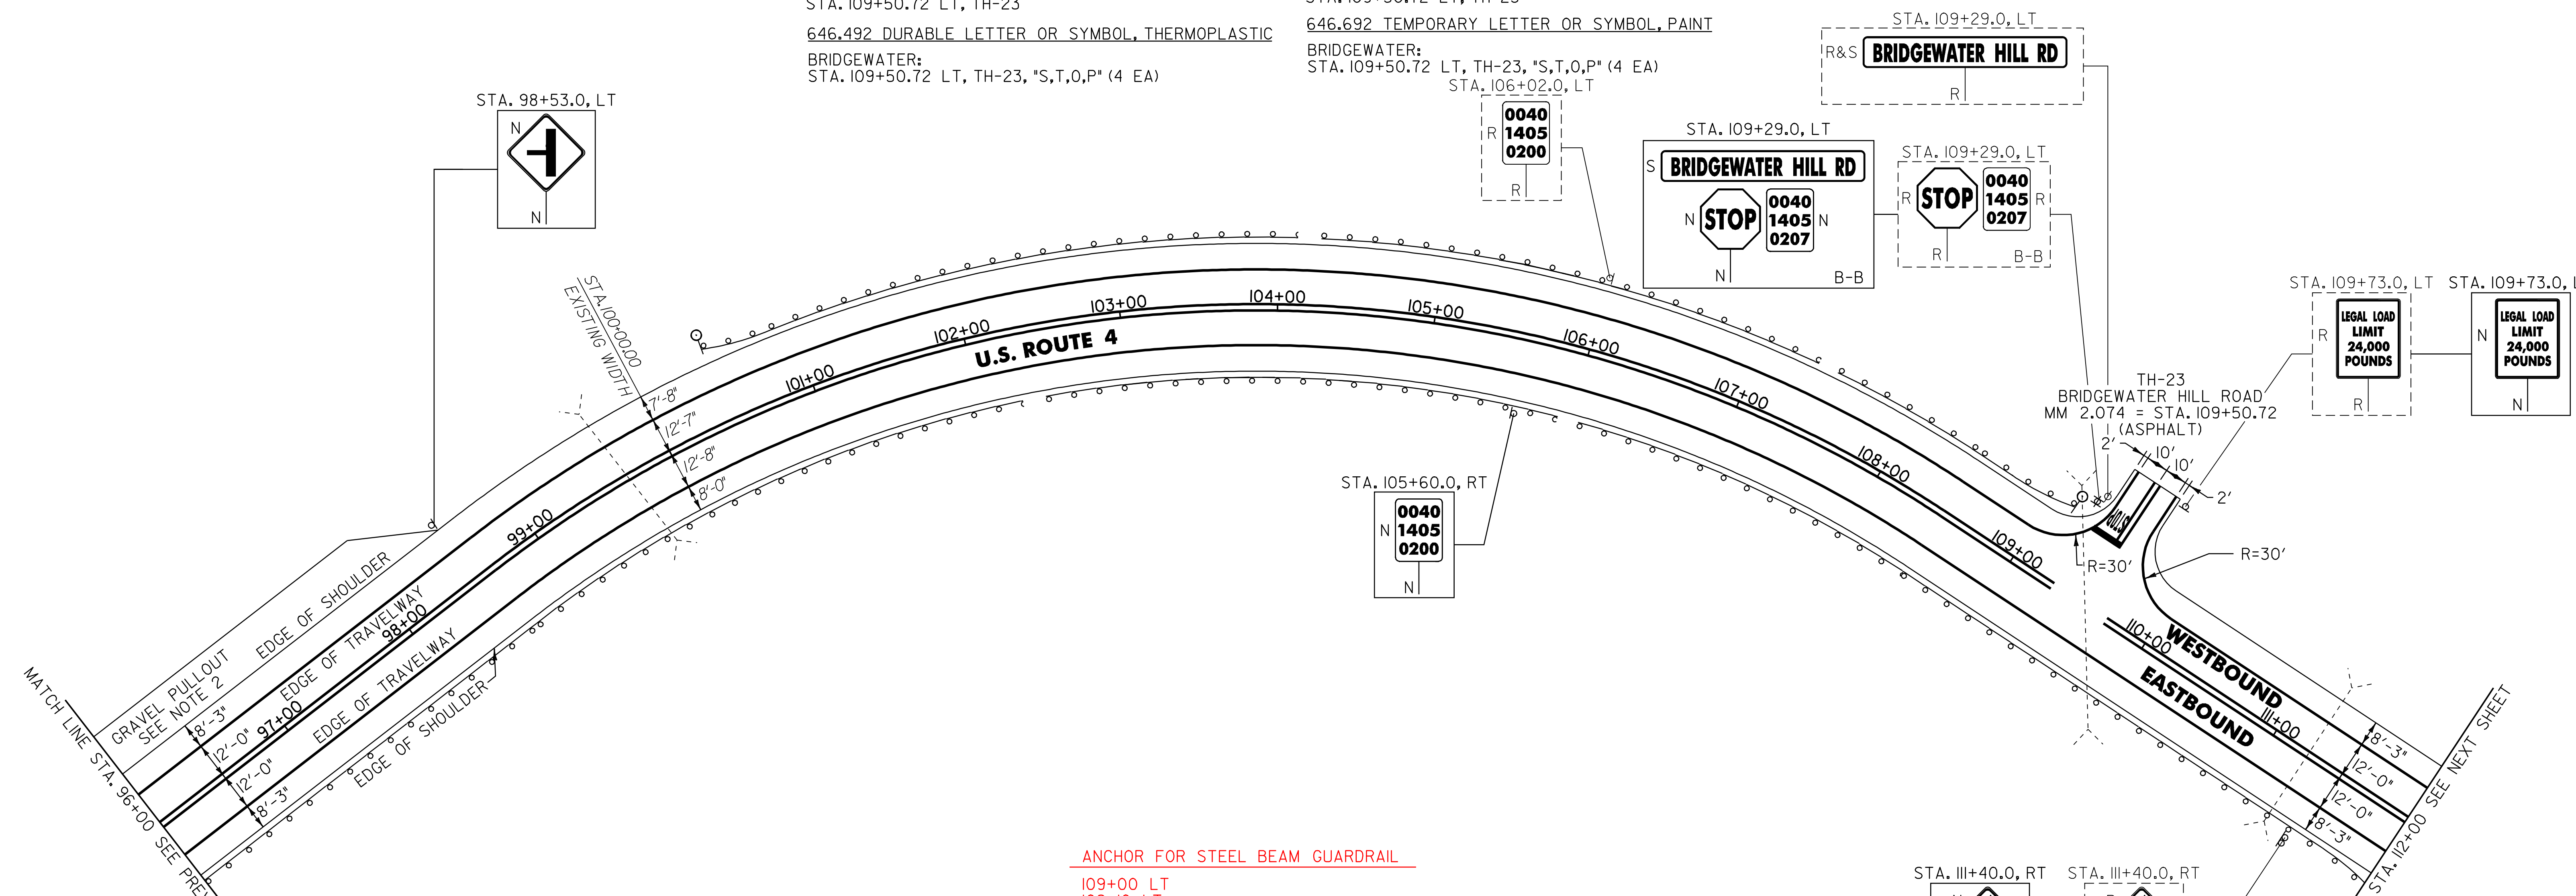

621.20 STEEL BEAM GUARDRAIL, GALVANIZED  
 BRIDGEWATER: 60  
 STA. 96+00.0 - STA. 111+72.5 RT (1572.5 LF)  
 108+57 - 109+10 LT 75

621.205 STEEL BEAM GUARDRAIL, GALVANIZED W/8 FEET POSTS  
 BRIDGEWATER: 57 775  
 STA. 100+82.0 - STA. 108+94.5 LT (812.5 LF)

621.50 MANUFACTURED TERMINAL SECTION, FLARED  
 BRIDGEWATER:  
 STA. 100+44.5 - STA. 100+82.0 LT  
 STA. 108+94.5 - STA. 109+32.0 LT  
 STA. 111+72.5 - STA. 112+10.0 RT  
 60 111+97.5

621.80 REMOVAL AND DISPOSAL OF GUARDRAIL  
 BRIDGEWATER: 35  
 STA. 96+00.0 - STA. 111+52.0 RT (1552.0 LF)  
 STA. 100+81.0 - STA. 109+32.0 LT (851.0 LF)  
 10 850

676.10 DELINEATOR WITH STEEL POST  
 ♯ TYPE I WHITE  
 BRIDGEWATER:  
 STA. 100+44.5 LT  
 STA. 109+32.0 LT

ANCHOR FOR STEEL BEAM GUARDRAIL  
 109+00 LT  
 109+10 LT

- NOTES:
- PAVING LIMIT ON ALL TOWN HIGHWAYS SHALL BE MEASURED 25 FT BACK FROM U.S. ROUTE 4 EDGE OF SHOULDER UNLESS DENOTED OTHERWISE ON THE PLANS OR AS DIRECTED BY THE RESIDENT ENGINEER.
  - PROVIDE A 5 FT WIDE, 1 3/4" TYPE III APRON FOR THE EXISTING GRAVEL PULLOUT. ANY REQUIRED EXCAVATION SHALL BE PERFORMED AS DIRECTED BY THE RESIDENT ENGINEER AND PAID FOR UNDER ITEM 608.25 ALL PURPOSE EXCAVATOR RENTAL, TYPE I.
  - THERE ARE EXISTING UNDERGROUND UTILITIES LOCATED THROUGHOUT THE U.S. ROUTE 4 CORRIDOR IN THE PROJECT AREA. THE CONTRACTOR IS RESPONSIBLE FOR CONTACTING "DIG SAFE" AT 1-888-344-7233 TO DETERMINE THE LOCATIONS OF THESE UTILITIES PRIOR TO PERFORMING ANY SUBSURFACE OPERATIONS.

**SIGN LEGEND**  
 R = REMOVE  
 S = SALVAGE  
 N = NEW  
 RET = RETAIN  
 B-B = BACK TO BACK  
 EXISTING = - - - - -  
 NEW = \_\_\_\_\_

**NOT TO SCALE**  
**PROJECT LAYOUT SHEET #11**

PROJECT NAME: KILLINGTON - BRIDGEWATER  
 PROJECT NUMBER: NH 2502(1)S  
 FILE NAME: p05b036.dgn  
 PROJECT LEADER: D.E.G.  
 DESIGNED BY: J.S.P.  
 IPARM FILE: p05b036III.i  
 PLOT DATE: 15-MAY-2008 14  
 DRAWN BY: C.A.K.  
 CHECKED BY: D.E.G.  
 SHEET 23 OF 74