


646.402 DURABLE 4 INCH WHITE LINE, THERMOPLASTIC
 (ALL LINES WILL INCLUDE EDGE LINE BREAKS AND
 RADIUS FOR TOWN HIGHWAYS)
 BRIDGEWATER:
 STA. 128+00.00 - STA. 144+00.00 LT & RT

646.412 DURABLE 4 INCH YELLOW LINE, THERMOPLASTIC
 (ALL LINES WILL INCLUDE C/L BREAKS FOR
 TOWN HIGHWAYS) S=SOLID, D=DASHED
 BRIDGEWATER:
 STA. 128+00.00 - STA. 144+00.00 LT ☐ RT
 S - S

646.602 TEMPORARY 4 INCH WHITE LINE, PAINT
 (ALL LINES WILL INCLUDE EDGE LINE BREAKS AND
 RADIUS FOR TOWN HIGHWAYS)
 BRIDGEWATER:
 STA. 128+00.00 - STA. 144+00.00 LT & RT

646.612 TEMPORARY 4 INCH YELLOW LINE, PAINT
 (ALL LINES WILL INCLUDE C/L BREAKS FOR
 TOWN HIGHWAYS) S=SOLID, D=DASHED
 BRIDGEWATER:
 STA. 128+00.00 - STA. 144+00.00 LT ☐ RT
 S - S

675.50 REMOVING SIGNS
 AS SHOWN - I

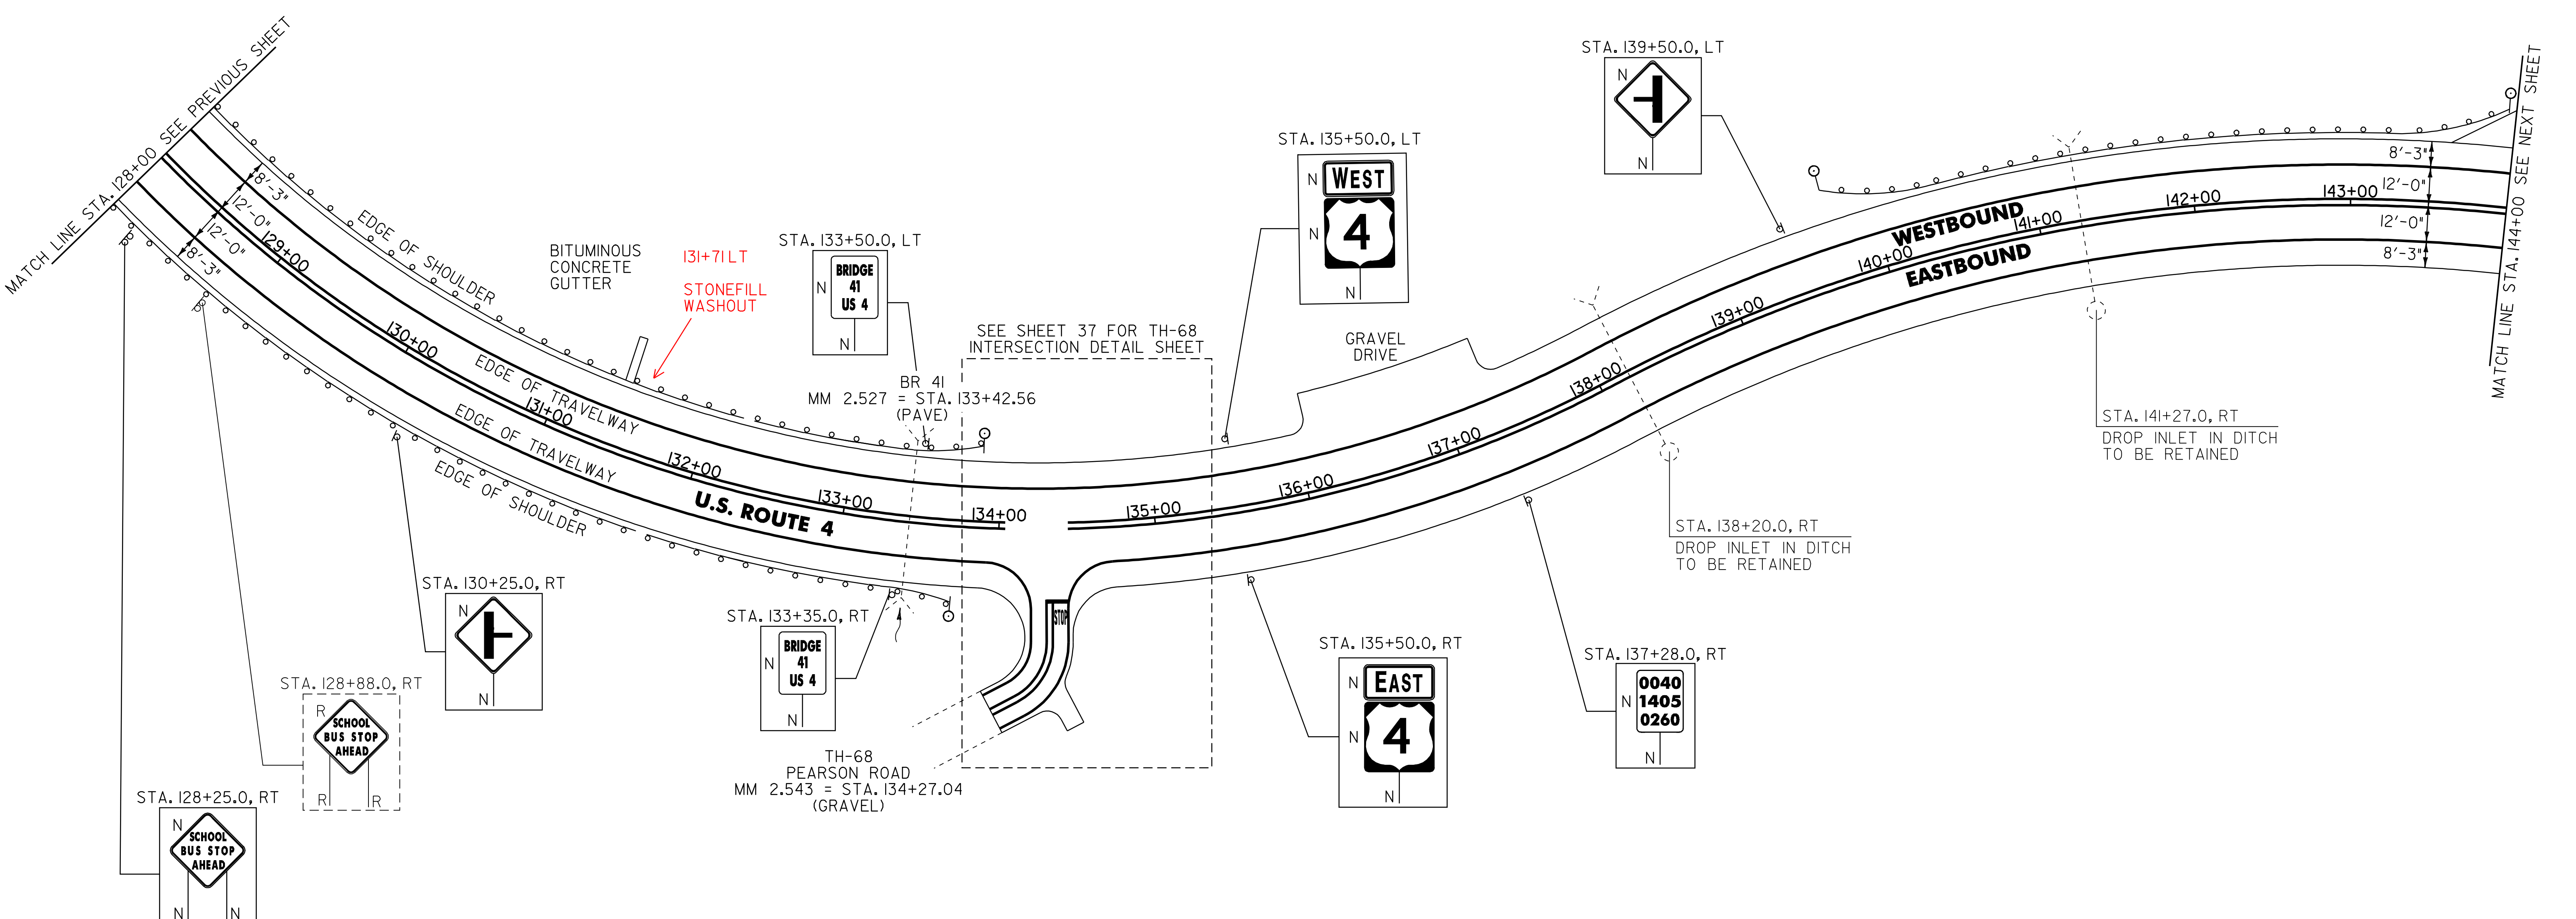

616.35 TREATED TIMBER CURB
 BRIDGEWATER:
 STA. 128+00.0 - STA. 131+60.0 LT (360.0 LF)

616.47 BITUMINOUS CONCRETE GUTTERS AND TRAFFIC ISLANDS
 BRIDGEWATER:
 STA. 131+60.0 - STA. 131+65.0 LT (1.0 TON)

621.20 STEEL BEAM GUARDRAIL, GALVANIZED
 BRIDGEWATER: 70 375 128+00 - 130+59 RT
 STA. 139+99.0 - STA. 143+49.0 LT (350.0 LF)
 132+46 133+46 128+00 - 132+96

621.205 STEEL BEAM GUARDRAIL, GALVANIZED W/8 FEET POSTS
 BRIDGEWATER: 130+59
 STA. 128+00.0 - STA. 133+34.0 RT (534.0 LF)
 STA. 128+00.0 - STA. 133+59.5 LT (550.5 LF)
 132+96 132+46

621.50 MANUFACTURED TERMINAL SECTION, FLARED
 BRIDGEWATER:
 STA. 133+34.0 - STA. 133+71.5 RT
 STA. 133+50.5 - STA. 133+88.0 LT 84
 STA. 139+61.5 - STA. 139+99.0 LT 70
 STA. 143+49.0 - STA. 143+86.5 LT

621.80 REMOVAL AND DISPOSAL OF GUARDRAIL
 BRIDGEWATER:
 STA. 128+00.0 - STA. 133+71.0 RT (571.0 LF)
 STA. 128+00.0 - STA. 133+84.0 LT (584.0 LF)
 STA. 139+99.0 - STA. 143+73.0 LT (374.0 LF)

676.10 DELINEATOR WITH STEEL POST
 ♀ TYPE I WHITE

BRIDGEWATER:
 STA. 133+71.5 RT
 STA. 133+88.0 LT
 STA. 139+61.5 LT
 STA. 143+86.5 LT

NOTE:
 I. THERE ARE EXISTING UNDERGROUND UTILITIES LOCATED THROUGHOUT THE U.S. ROUTE 4 CORRIDOR IN THE PROJECT AREA. THE CONTRACTOR IS RESPONSIBLE FOR CONTACTING 'DIG SAFE' AT 1-888-344-7233 TO DETERMINE THE LOCATIONS OF THESE UTILITIES PRIOR TO PERFORMING ANY SUBSURFACE OPERATIONS.

SIGN LEGEND
 R = REMOVE
 S = SALVAGE
 N = NEW
 RET = RETAIN
 B-B = BACK TO BACK
 EXISTING = - - - - -
 NEW = _____

NOT TO SCALE

PROJECT LAYOUT SHEET #13

PROJECT NAME: KILLINGTON - BRIDGEWATER
 PROJECT NUMBER: NH 2502(1)S

FILE NAME: p05b036.dgn
 PROJECT LEADER: D.E.G.
 DESIGNED BY: J.S.P.
 IPARM FILE: p05b036i13.i
 PLOT DATE: 15-MAY-2008 14
 DRAWN BY: C.A.K.
 CHECKED BY: D.E.G.
 SHEET 25 OF 74