

646.402 DURABLE 4 INCH WHITE LINE, THERMOPLASTIC
 (ALL LINES WILL INCLUDE EDGE LINE BREAKS AND RADIUS FOR TOWN HIGHWAYS)
 BRIDGEWATER:
 STA. 160+00.00 - STA. 176+00.00 LT & RT

646.412 DURABLE 4 INCH YELLOW LINE, THERMOPLASTIC
 (ALL LINES WILL INCLUDE C/L BREAKS FOR TOWN HIGHWAYS) S=SOLID, D=DASHED
 BRIDGEWATER:
 STA. 160+00.00 - STA. 176+00.00 LT ☉ RT
 STA. 160+00.00 - STA. 176+00.00 S - S
 STA. 175+61.28 DOUBLE SOLID RT, TH-70

646.482 DURABLE 24 INCH STOP BAR, THERMOPLASTIC
 BRIDGEWATER:
 STA. 175+61.28 RT, TH-70

646.492 DURABLE LETTER OR SYMBOL, THERMOPLASTIC
 BRIDGEWATER:
 STA. 175+61.28 RT, TH-70, "S,T,O,P" (4 EA)


646.602 TEMPORARY 4 INCH WHITE LINE, PAINT
 (ALL LINES WILL INCLUDE EDGE LINE BREAKS AND RADIUS FOR TOWN HIGHWAYS)
 BRIDGEWATER:
 STA. 160+00.00 - STA. 176+00.00 LT & RT

646.612 TEMPORARY 4 INCH YELLOW LINE, PAINT
 (ALL LINES WILL INCLUDE C/L BREAKS FOR TOWN HIGHWAYS) S=SOLID, D=DASHED
 BRIDGEWATER:
 STA. 160+00.00 - STA. 176+00.00 LT ☉ RT
 STA. 160+00.00 - STA. 176+00.00 S - S
 STA. 175+61.28 DOUBLE SOLID RT, TH-70

646.682 TEMPORARY 24 INCH STOP BAR, PAINT
 BRIDGEWATER:
 STA. 175+61.28 RT, TH-70

646.692 TEMPORARY LETTER OR SYMBOL, PAINT
 BRIDGEWATER:
 STA. 175+61.28 RT, TH-70, "S,T,O,P" (4 EA)

675.50 REMOVING SIGNS AS SHOWN - 5
 675.60 ERECTING SALVAGED SIGNS AS SHOWN - 1

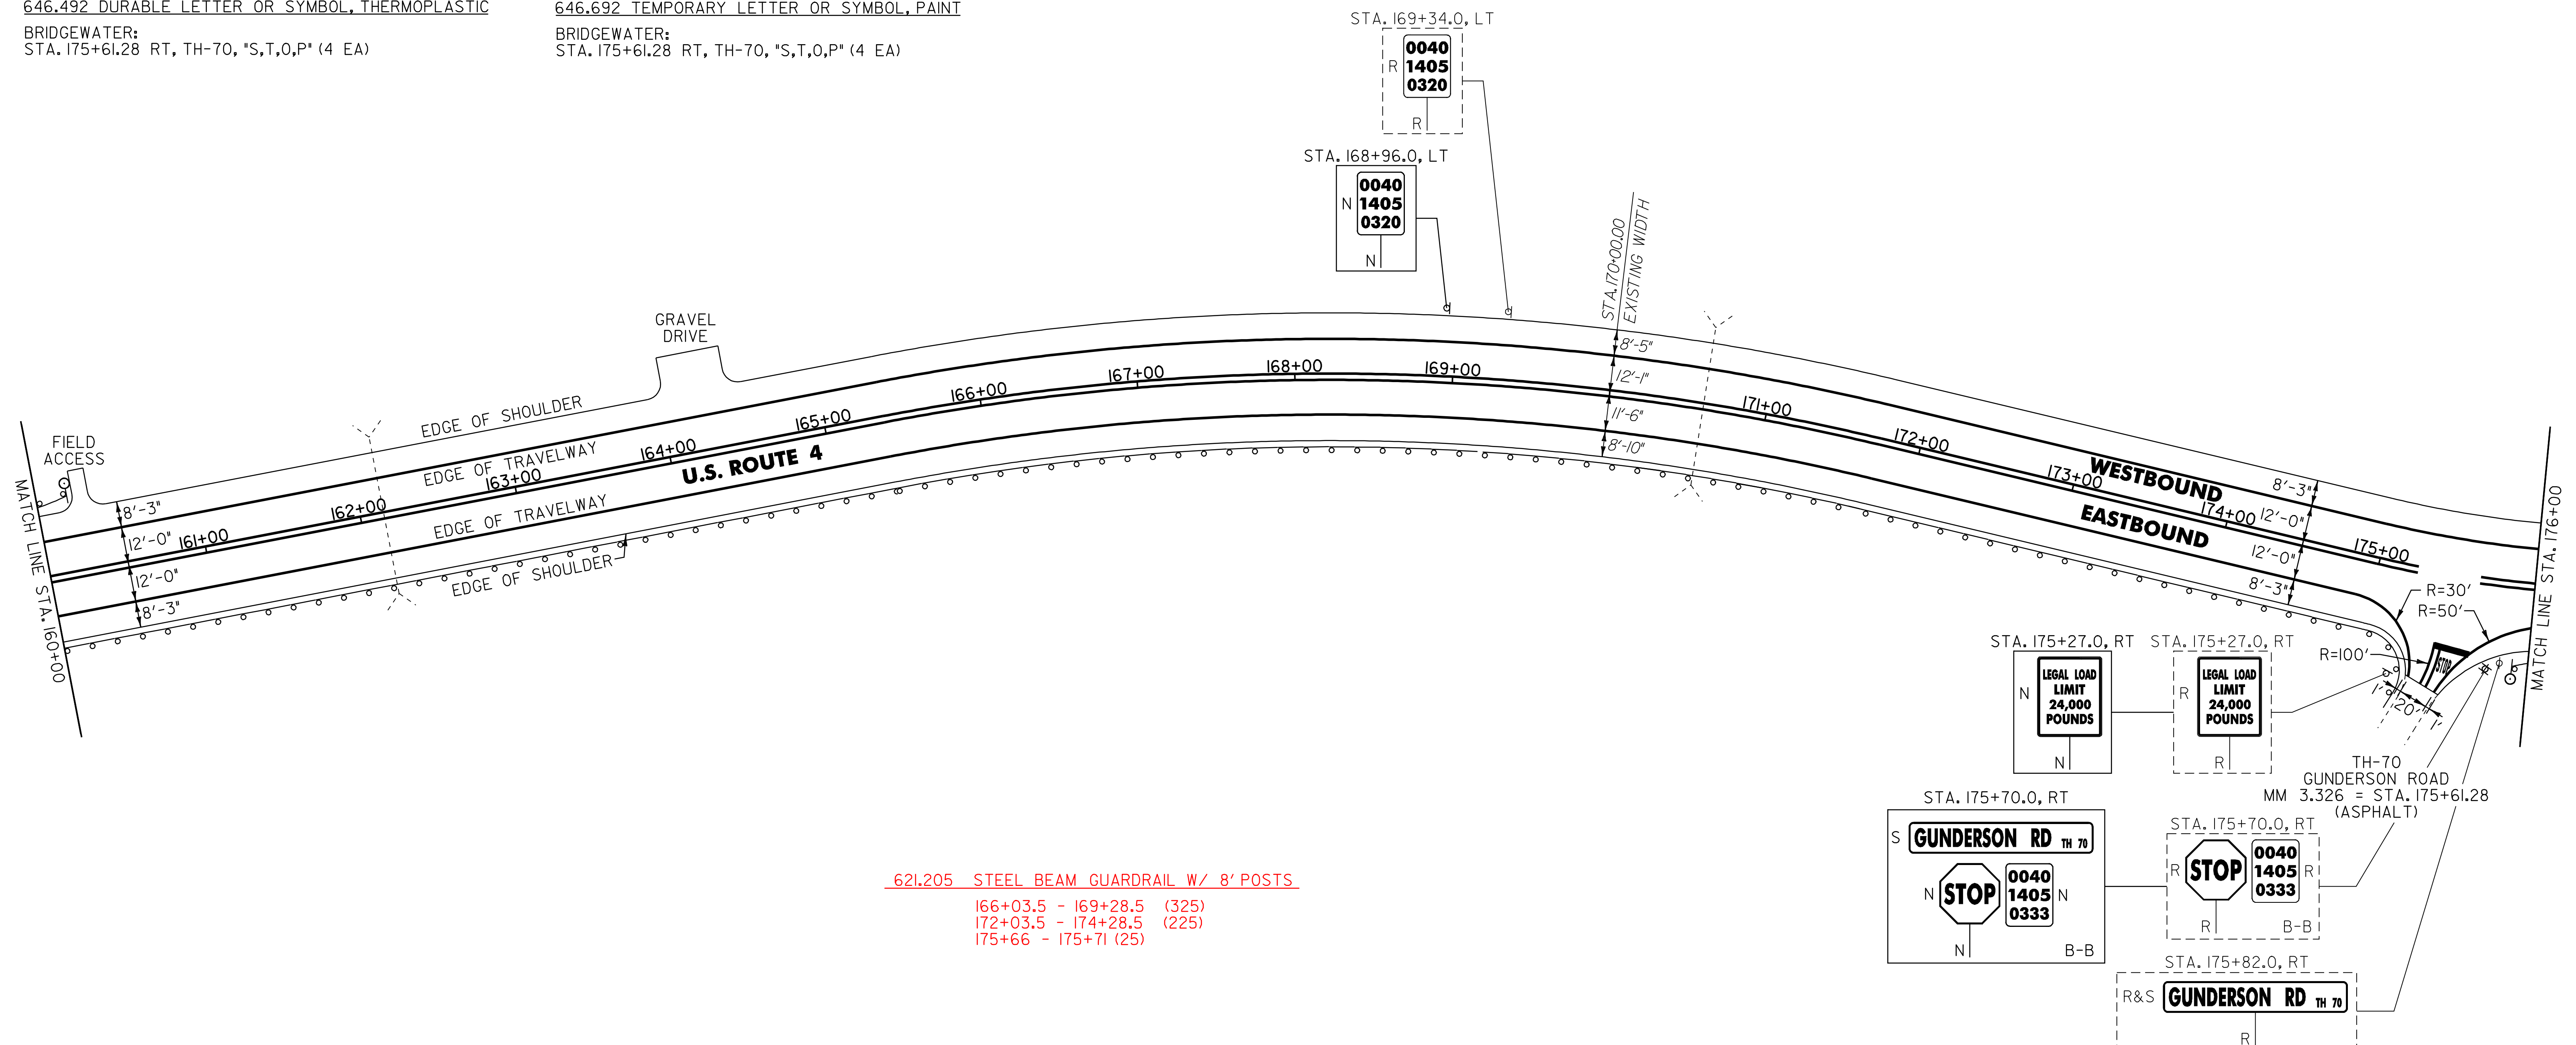

621.205 STEEL BEAM GUARDRAIL W/ 8' POSTS
 166+03.5 - 169+28.5 (325)
 172+03.5 - 174+28.5 (225)
 175+66 - 175+71 (25)

621.20 STEEL BEAM GUARDRAIL, GALVANIZED
 BRIDGEWATER:
 STA. 160+00.0 - STA. 175+34.0 RT (1578.5 LF)
 166+03.5

621.60 ANCHOR FOR STEEL BEAM RAIL
 BRIDGEWATER:
 STA. 175+34.0 RT
 60

621.80 REMOVAL AND DISPOSAL OF GUARDRAIL
 BRIDGEWATER:
 STA. 160+00.0 - STA. 175+34.0 RT (1534.0 LF)
 STA. 160+00.0 - STA. 160+04.0 LT (4.0 LF)
 STA. 175+89.0 - STA. 176+00.0 RT (11.0 LF)

676.10 DELINEATOR WITH STEEL POST
 ☉ TYPE 1 WHITE
 BRIDGEWATER:
 STA. 160+04.0 LT
 STA. 175+89.0 RT

- NOTES:
- PAVING LIMIT ON ALL TOWN HIGHWAYS SHALL BE MEASURED 25 FT BACK FROM U.S. ROUTE 4 EDGE OF SHOULDER UNLESS DENOTED OTHERWISE ON THE PLANS OR AS DIRECTED BY THE RESIDENT ENGINEER.
 - THERE ARE EXISTING UNDERGROUND UTILITIES LOCATED THROUGHOUT THE U.S. ROUTE 4 CORRIDOR IN THE PROJECT AREA. THE CONTRACTOR IS RESPONSIBLE FOR CONTACTING "DIG SAFE" AT 1-888-344-7233 TO DETERMINE THE LOCATIONS OF THESE UTILITIES PRIOR TO PERFORMING ANY SUBSURFACE OPERATIONS.

SIGN LEGEND
 R = REMOVE
 S = SALVAGE
 N = NEW
 RET = RETAIN
 B-B = BACK TO BACK
 EXISTING = -----
 NEW = _____

PROJECT LAYOUT SHEET #15	PROJECT NAME: KILLINGTON - BRIDGEWATER	
	PROJECT NUMBER: NH 2502(1)S	
FILE NAME: p05b036.dgn	PLOT DATE: 15-MAY-2008 14	
PROJECT LEADER: D.E.G.	DRAWN BY: C.A.K.	
DESIGNED BY: J.S.P.	CHECKED BY: D.E.G.	
IPARM FILE: p05b036i15.i	SHEET 27 OF 74	