


646.402 DURABLE 4 INCH WHITE LINE, THERMOPLASTIC
 (ALL LINES WILL INCLUDE EDGE LINE BREAKS AND
 RADIUS FOR TOWN HIGHWAYS)
 BRIDGEWATER:
 STA. 176+00.00 - STA. 192+00.00 LT & RT

646.412 DURABLE 4 INCH YELLOW LINE, THERMOPLASTIC
 (ALL LINES WILL INCLUDE C/L BREAKS FOR
 TOWN HIGHWAYS) S=SOLID, D=DASHED
 BRIDGEWATER:
 STA. 176+00.00 - STA. 192+00.00 LT C RT
 S - S

675.50 REMOVING SIGNS
 AS SHOWN - I

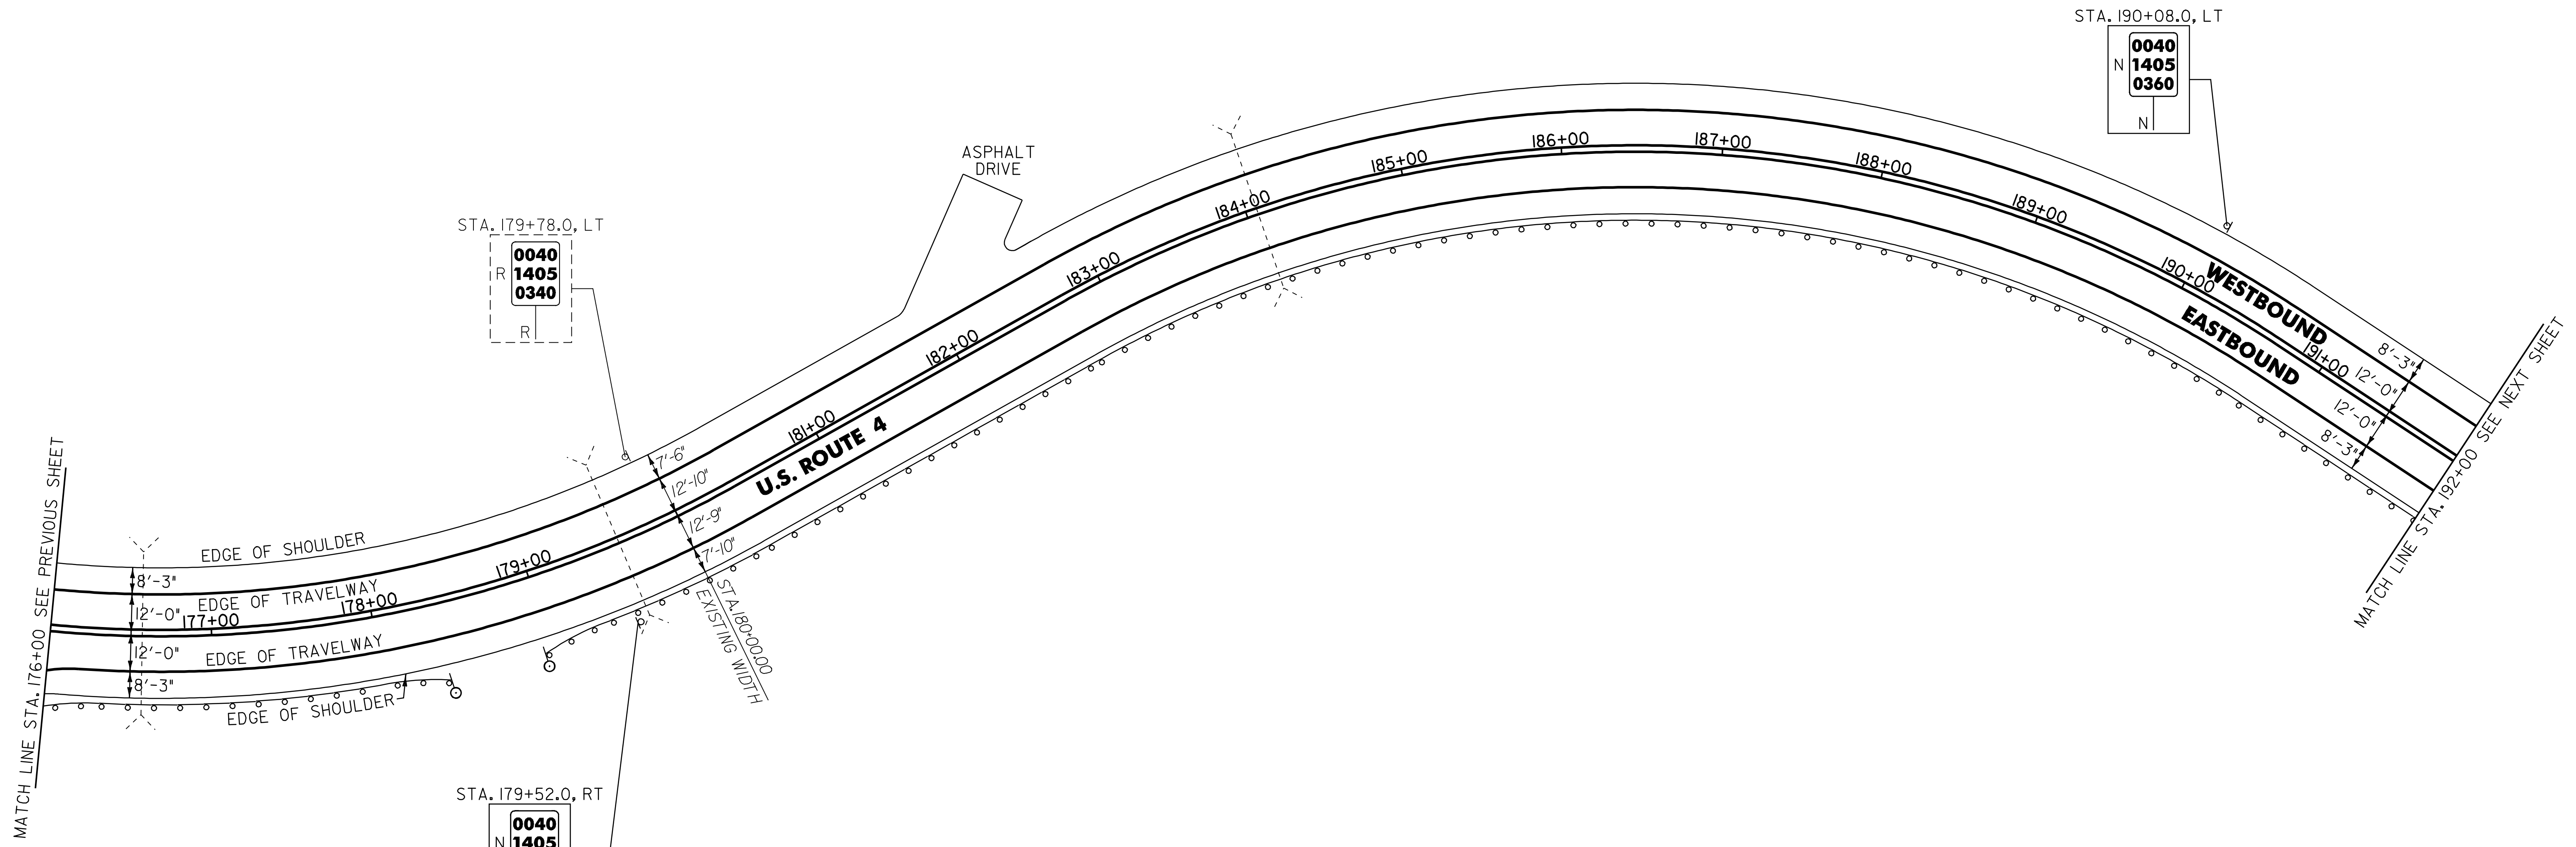

MATCH LINE STA. 176+00 SEE PREVIOUS SHEET

MATCH LINE STA. 192+00 SEE NEXT SHEET

621.20 STEEL BEAM GUARDRAIL, GALVANIZED
 BRIDGEWATER: 23 177+99 191+58 - 192+00 RT
 STA. 176+26.5 - STA. 178+01.5 RT (175.0 LF)
 STA. 179+33.0 - STA. 181+70.5 RT (237.5 LF)
 182+20.5

621.205 STEEL BEAM GUARDRAIL, GALVANIZED W/8 FEET POSTS
 BRIDGEWATER: 191+58
 STA. 181+70.5 - STA. 192+00.0 RT (1029.5 LF)
 182+20.5

621.50 MANUFACTURED TERMINAL SECTION, FLARED
 BRIDGEWATER: 85 23
 STA. 175+89.0 - STA. 176+26.5 RT
 STA. 178+01.5 - STA. 178+39.0 RT 177+99 - 178+36.5
 STA. 178+95.5 - STA. 179+33.0 RT

621.80 REMOVAL AND DISPOSAL OF GUARDRAIL
 BRIDGEWATER:
 STA. 176+00.0 - STA. 178+39.0 RT (239.0 LF)
 STA. 179+00.0 - STA. 192+00.0 RT (1300.0 LF)

676.10 DELINEATOR WITH STEEL POST
 TYPE I WHITE
 BRIDGEWATER:
 STA. 178+39.0 RT
 STA. 178+95.5 RT

SIGN LEGEND
 R = REMOVE
 S = SALVAGE
 N = NEW
 RET = RETAIN
 B-B = BACK TO BACK
 EXISTING = - - - - -
 NEW = _____

NOTE:
 1. THERE ARE EXISTING UNDERGROUND UTILITIES LOCATED THROUGHOUT THE U.S. ROUTE 4 CORRIDOR IN THE PROJECT AREA. THE CONTRACTOR IS RESPONSIBLE FOR CONTACTING "DIG SAFE" AT 1-888-344-7233 TO DETERMINE THE LOCATIONS OF THESE UTILITIES PRIOR TO PERFORMING ANY SUBSURFACE OPERATIONS.

PROJECT LAYOUT SHEET #16	NOT TO SCALE	
	PROJECT NAME: KILLINGTON - BRIDGEWATER PROJECT NUMBER: NH 2502(1)S	PLOT DATE: 15-MAY-2008 14 DRAWN BY: C.A.K. CHECKED BY: D.E.G. SHEET 28 OF 74
FILE NAME: p05b036.dgn PROJECT LEADER: D.E.G. DESIGNED BY: J.S.P. IPARM FILE: p05b036i16.i		