


646.402 DURABLE 4 INCH WHITE LINE, THERMOPLASTIC
 (ALL LINES WILL INCLUDE EDGE LINE BREAKS AND
 RADIUS FOR TOWN HIGHWAYS)
 BRIDGEWATER:
 STA. 192+00.00 - STA. 208+00.00 LT & RT

646.412 DURABLE 4 INCH YELLOW LINE, THERMOPLASTIC
 (ALL LINES WILL INCLUDE C/L BREAKS FOR
 TOWN HIGHWAYS) S=SOLID, D=DASHED
 BRIDGEWATER:
 STA. 192+00.00 - STA. 208+00.00 LT ☐ RT
 S - S

646.602 TEMPORARY 4 INCH WHITE LINE, PAINT
 (ALL LINES WILL INCLUDE EDGE LINE BREAKS AND
 RADIUS FOR TOWN HIGHWAYS)
 BRIDGEWATER:
 STA. 192+00.00 - STA. 208+00.00 LT & RT

646.612 TEMPORARY 4 INCH YELLOW LINE, PAINT
 (ALL LINES WILL INCLUDE C/L BREAKS FOR
 TOWN HIGHWAYS) S=SOLID, D=DASHED
 BRIDGEWATER:
 STA. 192+00.00 - STA. 208+00.00 LT ☐ RT
 S - S

675.50 REMOVING SIGNS
 AS SHOWN - I

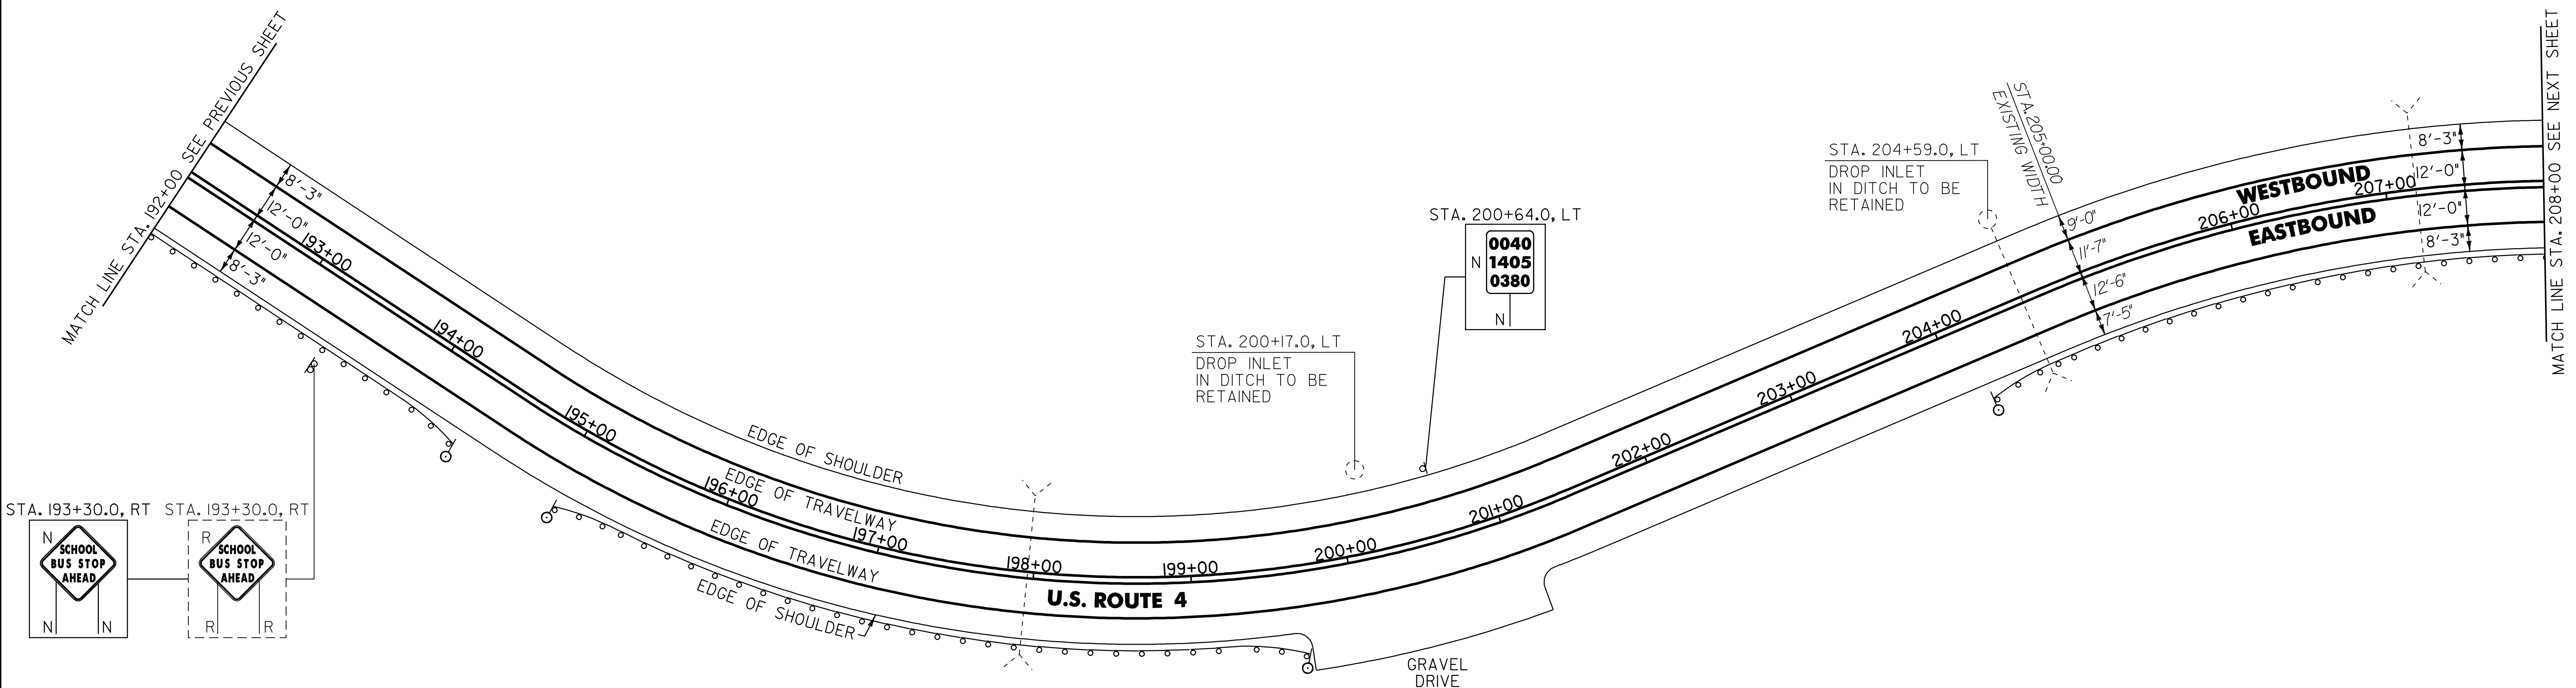

621.20 STEEL BEAM GUARDRAIL, GALVANIZED
 BRIDGEWATER:
 STA. 195+42.5 - STA. 199+30.0 RT (387.5 LF)
 192+00 - 193+95.5 RT
 204+55.5 - 208+00 RT

621.205 STEEL BEAM GUARDRAIL, GALVANIZED W/8 FEET POSTS
 BRIDGEWATER:
~~STA. 192+00.0 - STA. 193+95.5 RT (495.5 LF)~~
~~STA. 204+55.5 - STA. 208+00.0 RT (344.5 LF)~~

621.50 MANUFACTURED TERMINAL SECTION, FLARED
 BRIDGEWATER:
 STA. 193+95.5 - STA. 194+33.0 RT
 STA. 195+05.0 - STA. 195+42.5 RT 39
 STA. 199+30.0 - STA. 199+67.5 RT 64.5
 STA. 204+18.0 - STA. 204+55.5 RT

621.80 REMOVAL AND DISPOSAL OF GUARDRAIL
 BRIDGEWATER:
 STA. 192+00.0 - STA. 194+33.0 RT (233.0 LF)
 STA. 195+05.0 - STA. 199+67.5 RT (462.5 LF)
 STA. 204+52.0 - STA. 208+00.0 RT (348.0 LF)

676.10 DELINEATOR WITH STEEL POST
 ☐ TYPE I WHITE

BRIDGEWATER:
 STA. 194+33.0 RT
 STA. 195+05.0 RT
 STA. 199+67.5 RT
 STA. 204+18.0 RT

SIGN LEGEND
 R = REMOVE
 S = SALVAGE
 N = NEW
 RET = RETAIN
 B-B = BACK TO BACK
 EXISTING = - - - - -
 NEW = _____

NOTE:
 I. THERE ARE EXISTING UNDERGROUND UTILITIES LOCATED THROUGHOUT THE U.S. ROUTE 4 CORRIDOR IN THE PROJECT AREA. THE CONTRACTOR IS RESPONSIBLE FOR CONTACTING "DIG SAFE" AT 1-888-344-7233 TO DETERMINE THE LOCATIONS OF THESE UTILITIES PRIOR TO PERFORMING ANY SUBSURFACE OPERATIONS.

PROJECT LAYOUT SHEET #17	PROJECT NAME: KILLINGTON - BRIDGEWATER	PLOT DATE: 15-MAY-2008 14
	PROJECT NUMBER: NH 2502(1)S	DRAWN BY: C.A.K.
	FILE NAME: p05b036.dgn	CHECKED BY: D.E.G.
	DESIGNED BY: J.S.P.	SHEET 29 OF 74
	IPARM FILE: p05b036i17.1	