


646.402 DURABLE 4 INCH WHITE LINE, THERMOPLASTIC  
 (ALL LINES WILL INCLUDE EDGE LINE BREAKS AND  
 RADIUS FOR TOWN HIGHWAYS)  
 BRIDGEWATER:  
 STA. 224+00.00 - STA. 240+00.00 LT & RT

646.412 DURABLE 4 INCH YELLOW LINE, THERMOPLASTIC  
 (ALL LINES WILL INCLUDE C/L BREAKS FOR  
 TOWN HIGHWAYS) S=SOLID, D=DASHED  
 BRIDGEWATER:  
 STA. 224+00.00 - STA. 227+20.00 D - S  
 STA. 227+20.00 - STA. 240+00.00 S - S

646.602 TEMPORARY 4 INCH WHITE LINE, PAINT  
 (ALL LINES WILL INCLUDE EDGE LINE BREAKS AND  
 RADIUS FOR TOWN HIGHWAYS)  
 BRIDGEWATER:  
 STA. 224+00.00 - STA. 240+00.00 LT & RT

646.612 TEMPORARY 4 INCH YELLOW LINE, PAINT  
 (ALL LINES WILL INCLUDE C/L BREAKS FOR  
 TOWN HIGHWAYS) S=SOLID, D=DASHED  
 BRIDGEWATER:  
 STA. 224+00.00 - STA. 227+20.00 D - S  
 STA. 227+20.00 - STA. 240+00.00 S - S

675.50 REMOVING SIGNS  
 AS SHOWN - 6

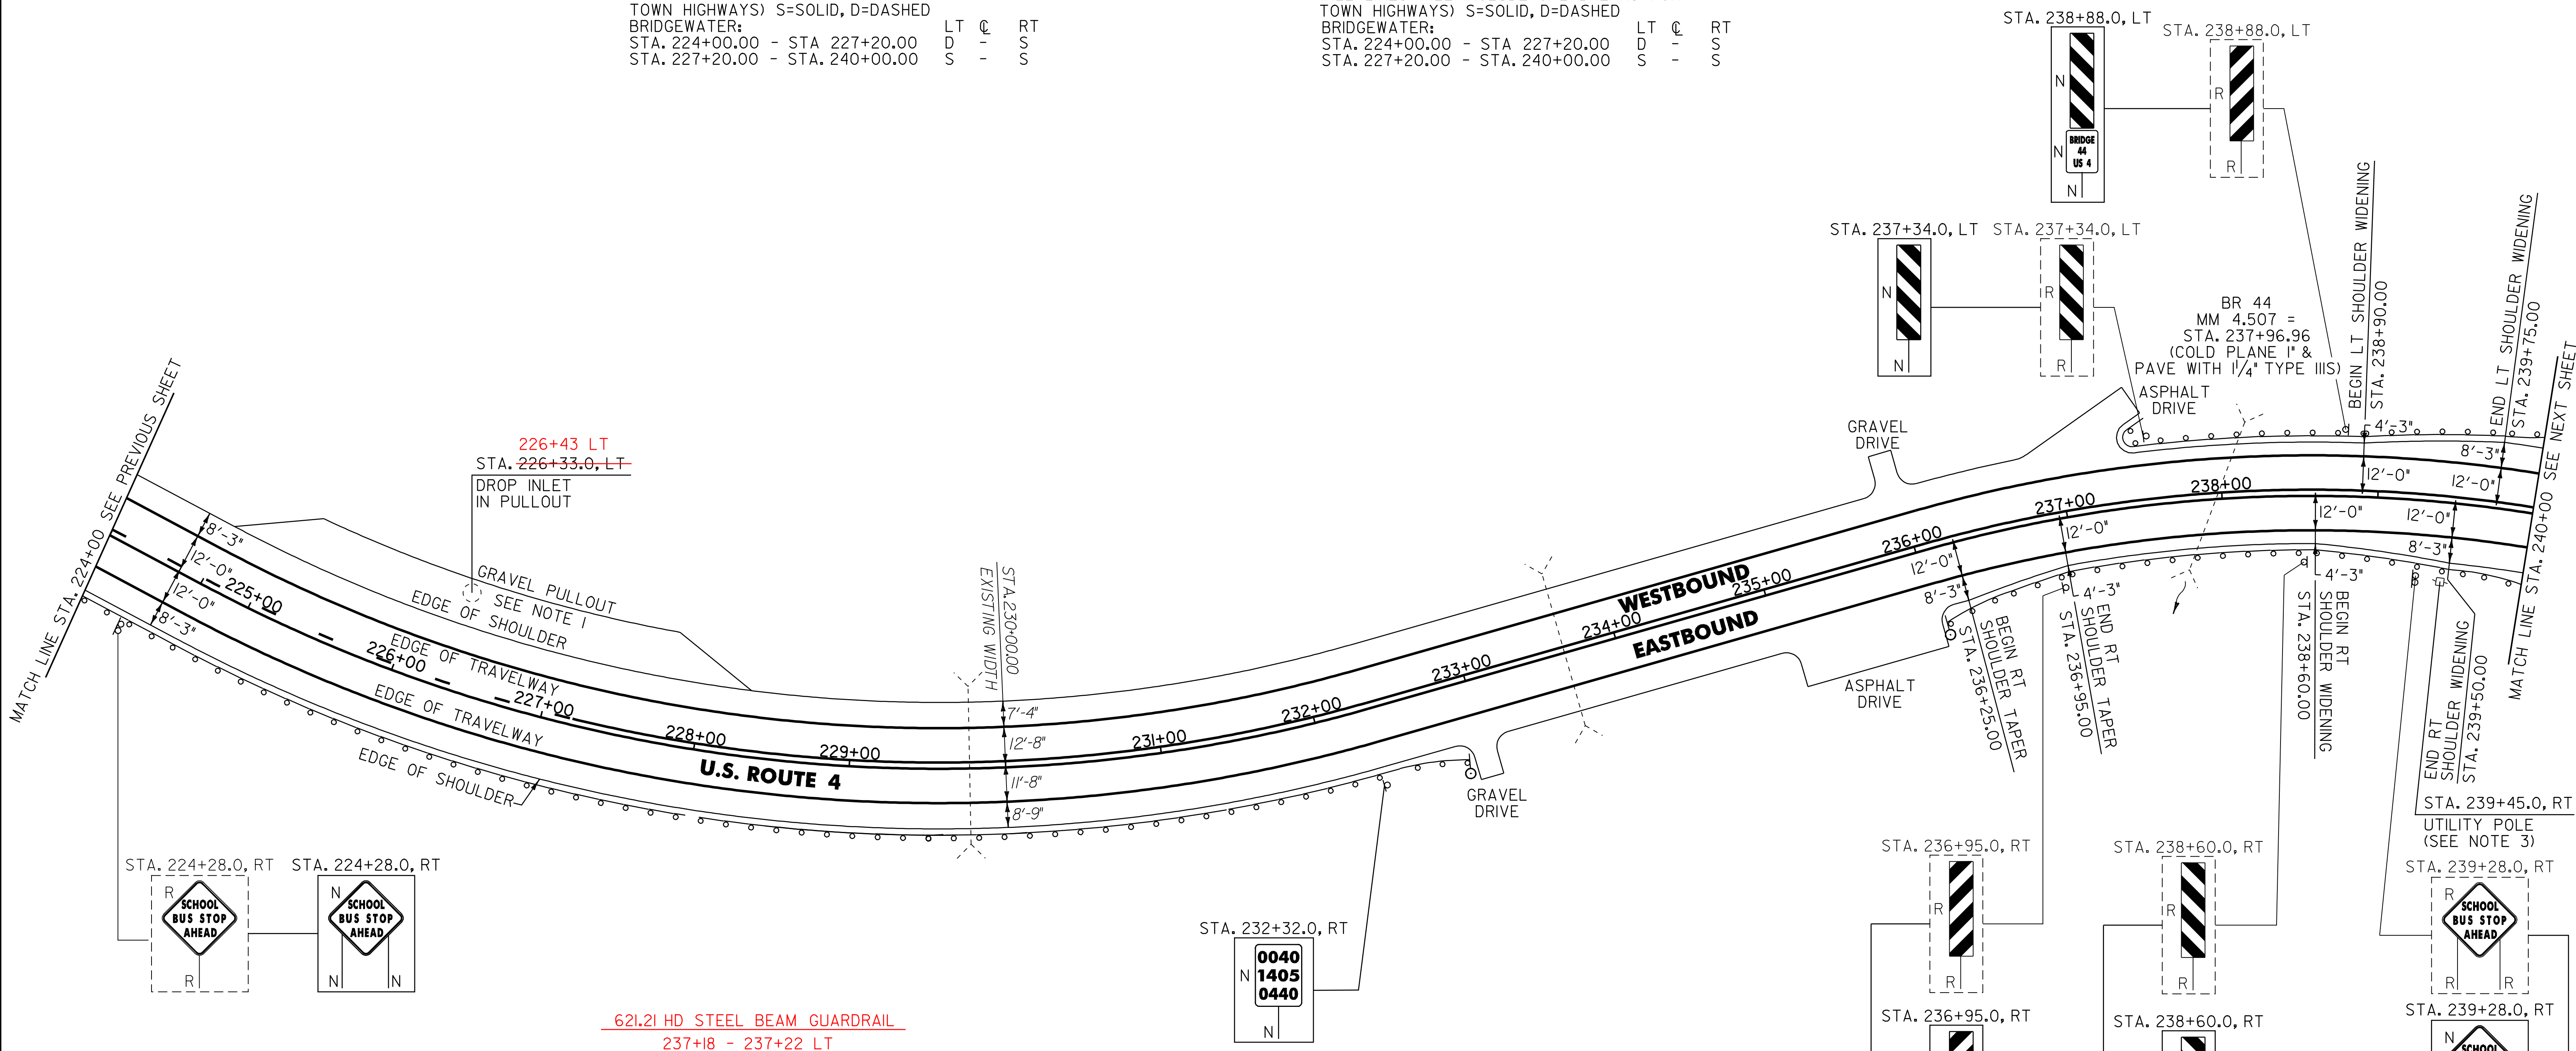

621.21 HD STEEL BEAM GUARDRAIL  
 237+18 - 237+22 LT

604.412 REHAB. DROP INLETS, CATCH BASINS OR MANHOLES, CLASS I  
 BRIDGEWATER:  
 STA. 226+33.0 LT

621.20 STEEL BEAM GUARDRAIL, GALVANIZED  
 BRIDGEWATER:  
 STA. 224+00.0 - STA. 232+46.5 RT (846.5 LF)  
 STA. 237+18.0 - STA. 237+22.0 LT (42.5 LF)  
 STA. 239+09.5 - STA. 239+72.0 RT (82.5 LF)  
 STA. 239+37.5 - STA. 239+75.0 LT (37.5 LF)

621.50 MANUFACTURED TERMINAL SECTION, FLARED  
 BRIDGEWATER:  
 STA. 232+46.5 - STA. 232+84.0 RT  
 STA. 236+07.0 - STA. 236+44.5 RT  
 STA. 239+72.0 - STA. 240+09.5 RT  
 STA. 239+75.0 - STA. 240+12.5 LT

621.70 GUARDRAIL APPROACH SECTION, GALVANIZED TYPE I  
 BRIDGEWATER:  
 STA. 236+44.5 - STA. 236+94.5 RT  
 STA. 238+59.5 - STA. 239+09.5 RT  
 STA. 238+87.5 - STA. 239+37.5 LT

621.60 ANCHOR FOR STEEL BEAM RAIL  
 BRIDGEWATER:  
 STA. 237+18.0 LT

621.71 GUARDRAIL APPROACH SECTION, GALVANIZED TYPE II  
 BRIDGEWATER:  
 STA. 237+22.0 - STA. 237+34.5 LT

621.80 REMOVAL AND DISPOSAL OF GUARDRAIL  
 BRIDGEWATER:  
 STA. 224+00.0 - STA. 232+84.0 RT (884.0 LF)  
 STA. 236+05.0 - STA. 236+94.5 RT (89.5 LF) 87.5  
 STA. 237+18.0 - STA. 237+34.5 LT (25.0 LF)  
 STA. 238+59.5 - STA. 239+36.0 RT (76.5 LF) 75  
 STA. 238+87.5 - STA. 239+75.0 LT (87.5 LF)

676.10 DELINEATOR WITH STEEL POST  
 TYPE I WHITE  
 BRIDGEWATER:  
 STA. 232+84.0 RT  
 STA. 236+07.0 RT

NOTES:

1. PROVIDE A 5 FT WIDE, 1 3/4" TYPE III APRON FOR THE EXISTING GRAVEL PULLOUT. ANY REQUIRED EXCAVATION OR GRADING SHALL BE PERFORMED AS DIRECTED BY THE RESIDENT ENGINEER AND PAID FOR UNDER THE APPLICABLE RENTAL ITEM(S).
2. SEE SHEET 71 FOR BR 44 DETAILS.
3. SEE SHEET 73 FOR REDUCED STEEL BEAM GUARDRAIL POST SPACING AT UTILITY POLE DETAIL.
4. THERE ARE EXISTING UNDERGROUND UTILITIES LOCATED THROUGHOUT THE U.S. ROUTE 4 CORRIDOR IN THE PROJECT AREA. THE CONTRACTOR IS RESPONSIBLE FOR CONTACTING "DIG SAFE" AT 1-888-344-7233 TO DETERMINE THE LOCATIONS OF THESE UTILITIES PRIOR TO PERFORMING ANY SUBSURFACE OPERATIONS.

SIGN LEGEND  
 R = REMOVE  
 S = SALVAGE  
 N = NEW  
 RET = RETAIN  
 B-B = BACK TO BACK  
 EXISTING = - - - - -  
 NEW = \_\_\_\_\_

NOT TO SCALE  
**PROJECT LAYOUT SHEET #19**

PROJECT NAME: KILLINGTON - BRIDGEWATER  
 PROJECT NUMBER: NH 2502(1)S  
 FILE NAME: p05b036.dgn  
 PROJECT LEADER: D.E.G.  
 DESIGNED BY: J.S.P.  
 IPARM FILE: p05b036i19.i  
 PLOT DATE: 15-MAY-2008 14  
 DRAWN BY: C.A.K.  
 CHECKED BY: D.E.G.  
 SHEET 31 OF 74