


646.402 DURABLE 4 INCH WHITE LINE, THERMOPLASTIC
 (ALL LINES WILL INCLUDE EDGE LINE BREAKS AND
 RADIUS FOR TOWN HIGHWAYS)
 BRIDGEWATER:
 STA. 240+00.00 - STA. 256+00.00 LT & RT

646.412 DURABLE 4 INCH YELLOW LINE, THERMOPLASTIC
 (ALL LINES WILL INCLUDE C/L BREAKS FOR
 TOWN HIGHWAYS) S=SOLID, D=DASHED
 BRIDGEWATER:
 STA. 240+00.00 - STA. 249+90.00 LT C RT
 STA. 249+90.00 - STA. 256+00.00 S - D

646.602 TEMPORARY 4 INCH WHITE LINE, PAINT
 (ALL LINES WILL INCLUDE EDGE LINE BREAKS AND
 RADIUS FOR TOWN HIGHWAYS)
 BRIDGEWATER:
 STA. 240+00.00 - STA. 256+00.00 LT & RT

646.612 TEMPORARY 4 INCH YELLOW LINE, PAINT
 (ALL LINES WILL INCLUDE C/L BREAKS FOR
 TOWN HIGHWAYS) S=SOLID, D=DASHED
 BRIDGEWATER:
 STA. 240+00.00 - STA. 249+90.00 LT C RT
 STA. 249+90.00 - STA. 256+00.00 S - D

675.50 REMOVING SIGNS
 AS SHOWN - 3

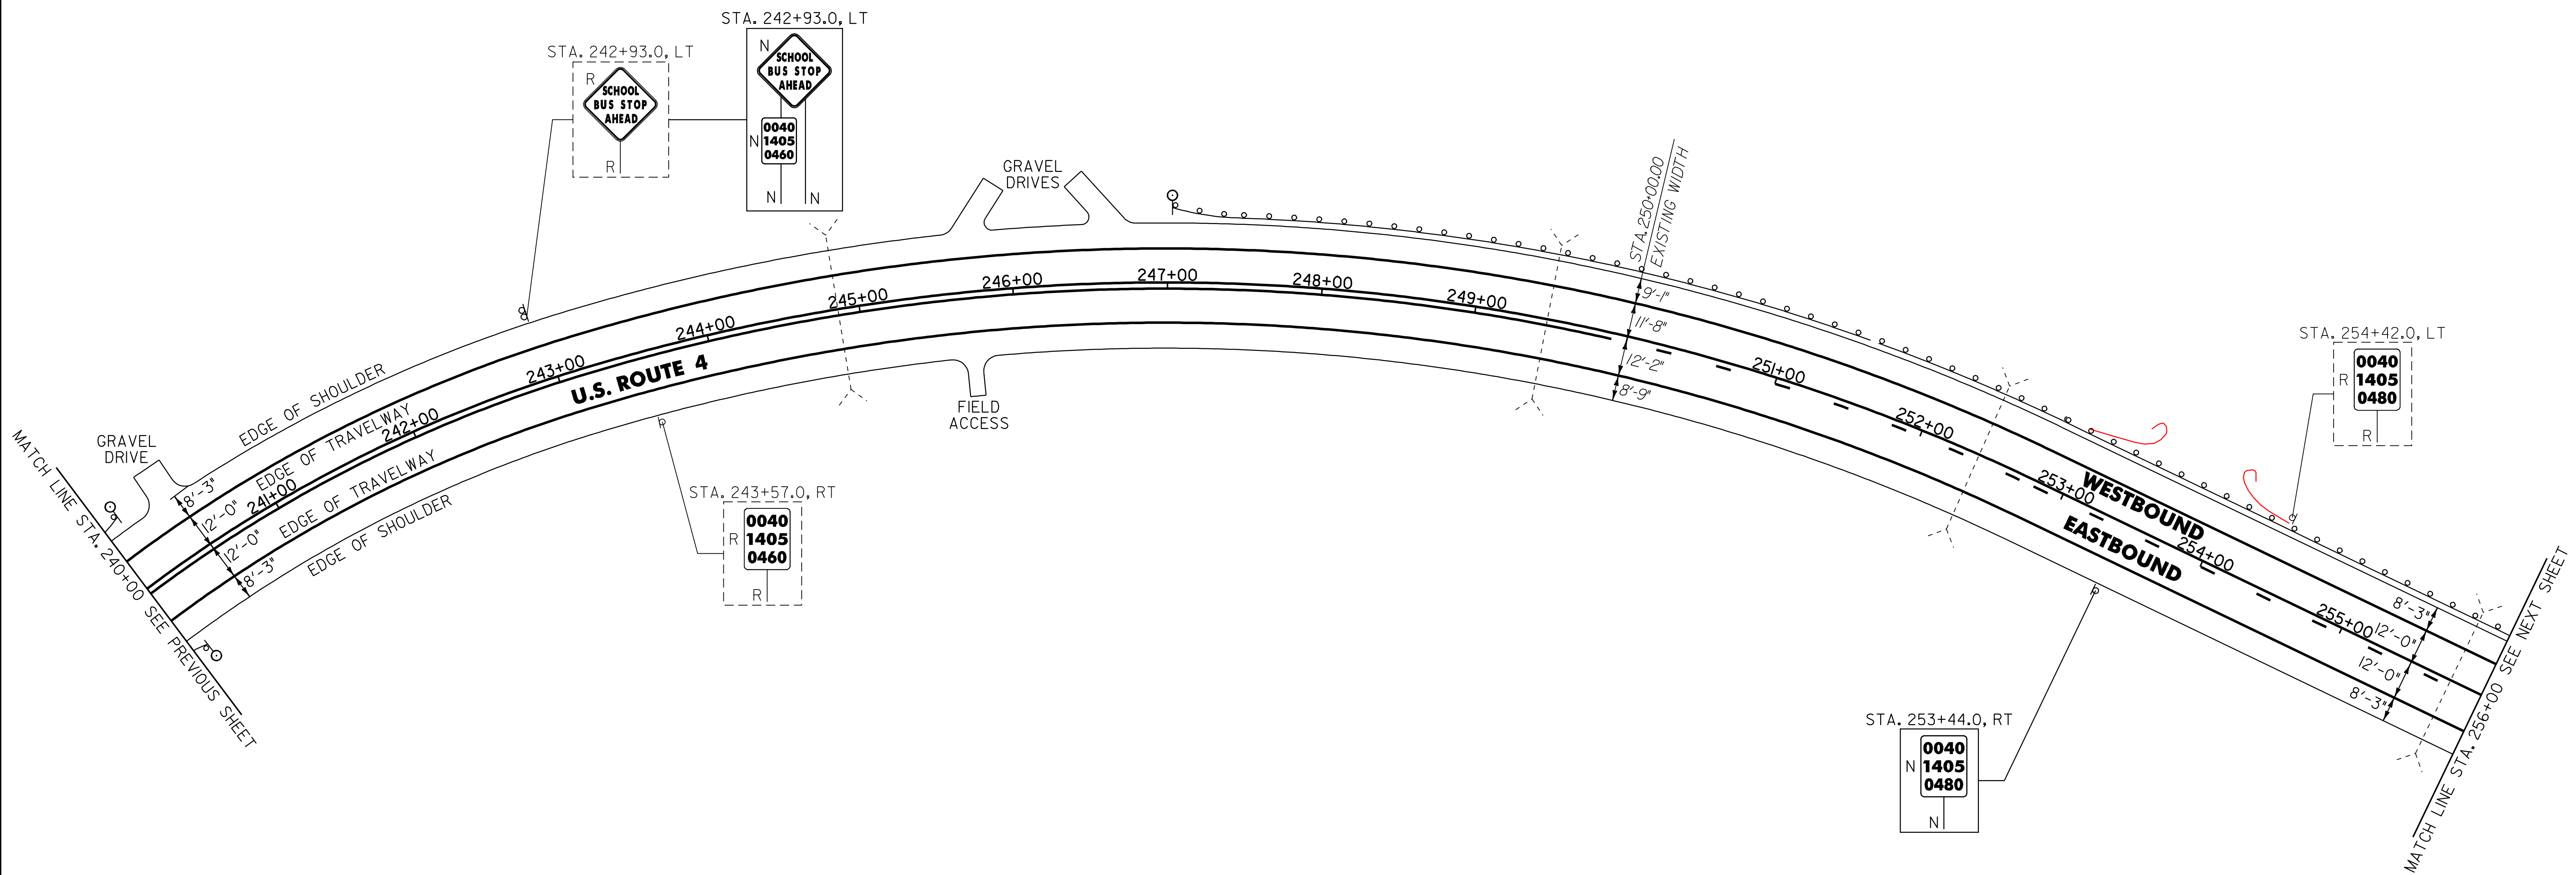

621.20 STEEL BEAM GUARDRAIL, GALVANIZED
 BRIDGEWATER: 27 253+27
 STA. 247+40.5 - STA. 255+03.0 LT (762.5 LF)
 254+40 - 255+65 LT
 621.205 STEEL BEAM GUARDRAIL, GALVANIZED W/8 FEET POSTS
 BRIDGEWATER: 255+65
 STA. 255+03.0 - STA. 256+00.0 LT (97.0 LF)
 621.50 MANUFACTURED TERMINAL SECTION, FLARED
 BRIDGEWATER:
 STA. 247+03.0 - STA. 247+40.5 LT 254+02 - 254+40 LT
 253+27 - 253+65 LT
 621.80 REMOVAL AND DISPOSAL OF GUARDRAIL
 BRIDGEWATER: 246+89
 STA. 247+03.0 - STA. 256+00.0 LT (897.0 LF)

676.10 DELINEATOR WITH STEEL POST
 ♯ TYPE I WHITE
 BRIDGEWATER:
 STA. 240+09.5 RT
 STA. 240+12.5 LT
 STA. 247+03.0 LT

SIGN LEGEND
 R = REMOVE
 S = SALVAGE
 N = NEW
 RET = RETAIN
 B-B = BACK TO BACK
 EXISTING = - - - - -
 NEW = _____

NOTE:
 1. THERE ARE EXISTING UNDERGROUND UTILITIES LOCATED THROUGHOUT THE U.S. ROUTE 4 CORRIDOR IN THE PROJECT AREA. THE CONTRACTOR IS RESPONSIBLE FOR CONTACTING "DIG SAFE" AT 1-888-344-7233 TO DETERMINE THE LOCATIONS OF THESE UTILITIES PRIOR TO PERFORMING ANY SUBSURFACE OPERATIONS.

NOT TO SCALE

PROJECT LAYOUT SHEET #20

PROJECT NAME: KILLINGTON - BRIDGEWATER
 PROJECT NUMBER: NH 2502(1)S
 FILE NAME: p05b036.dgn
 PROJECT LEADER: D.E.G.
 DESIGNED BY: J.S.P.
 IPARM FILE: p05b036i20.i
 PLOT DATE: 15-MAY-2008 14
 DRAWN BY: C.A.K.
 CHECKED BY: D.E.G.
 SHEET 32 OF 74