


646.402 DURABLE 4 INCH WHITE LINE, THERMOPLASTIC
 (ALL LINES WILL INCLUDE EDGE LINE BREAKS AND
 RADIUS FOR TOWN HIGHWAYS)
 BRIDGEWATER:
 STA. 304+00.00 - STA. 318+01.44 LT & RT

646.412 DURABLE 4 INCH YELLOW LINE, THERMOPLASTIC
 (ALL LINES WILL INCLUDE C/L BREAKS FOR
 TOWN HIGHWAYS) S=SOLID, D=DASHED
 BRIDGEWATER:
 STA. 304+00.00 - STA. 318+01.44 LT S C RT
 STA. 312+78.72 DOUBLE SOLID LT, TH-37 S - S

646.482 DURABLE 24 INCH STOP BAR, THERMOPLASTIC
 BRIDGEWATER:
 STA. 312+78.72 LT, TH-37
 646.492 DURABLE LETTER OR SYMBOL, THERMOPLASTIC
 BRIDGEWATER:
 STA. 312+78.72 LT, TH-37 *S,T,O,P* (4 EA)
 646.682 TEMPORARY 24 INCH STOP BAR, PAINT
 BRIDGEWATER:
 STA. 312+78.72 LT, TH-37
 646.692 TEMPORARY LETTER OR SYMBOL, PAINT
 BRIDGEWATER:
 STA. 312+78.72 LT, TH-37 *S,T,O,P* (4 EA)

646.602 TEMPORARY 4 INCH WHITE LINE, PAINT
 (ALL LINES WILL INCLUDE EDGE LINE BREAKS AND
 RADIUS FOR TOWN HIGHWAYS)
 BRIDGEWATER:
 STA. 304+00.00 - STA. 318+01.44
 646.612 TEMPORARY 4 INCH YELLOW LINE, PAINT
 (ALL LINES WILL INCLUDE C/L BREAKS FOR
 TOWN HIGHWAYS) S=SOLID, D=DASHED
 BRIDGEWATER:
 STA. 304+00.00 - STA. 318+01.44 LT C RT
 S - S

675.50 REMOVING SIGNS
 AS SHOWN - 18
 675.60 ERECTING SALVAGED SIGNS
 AS SHOWN - 1

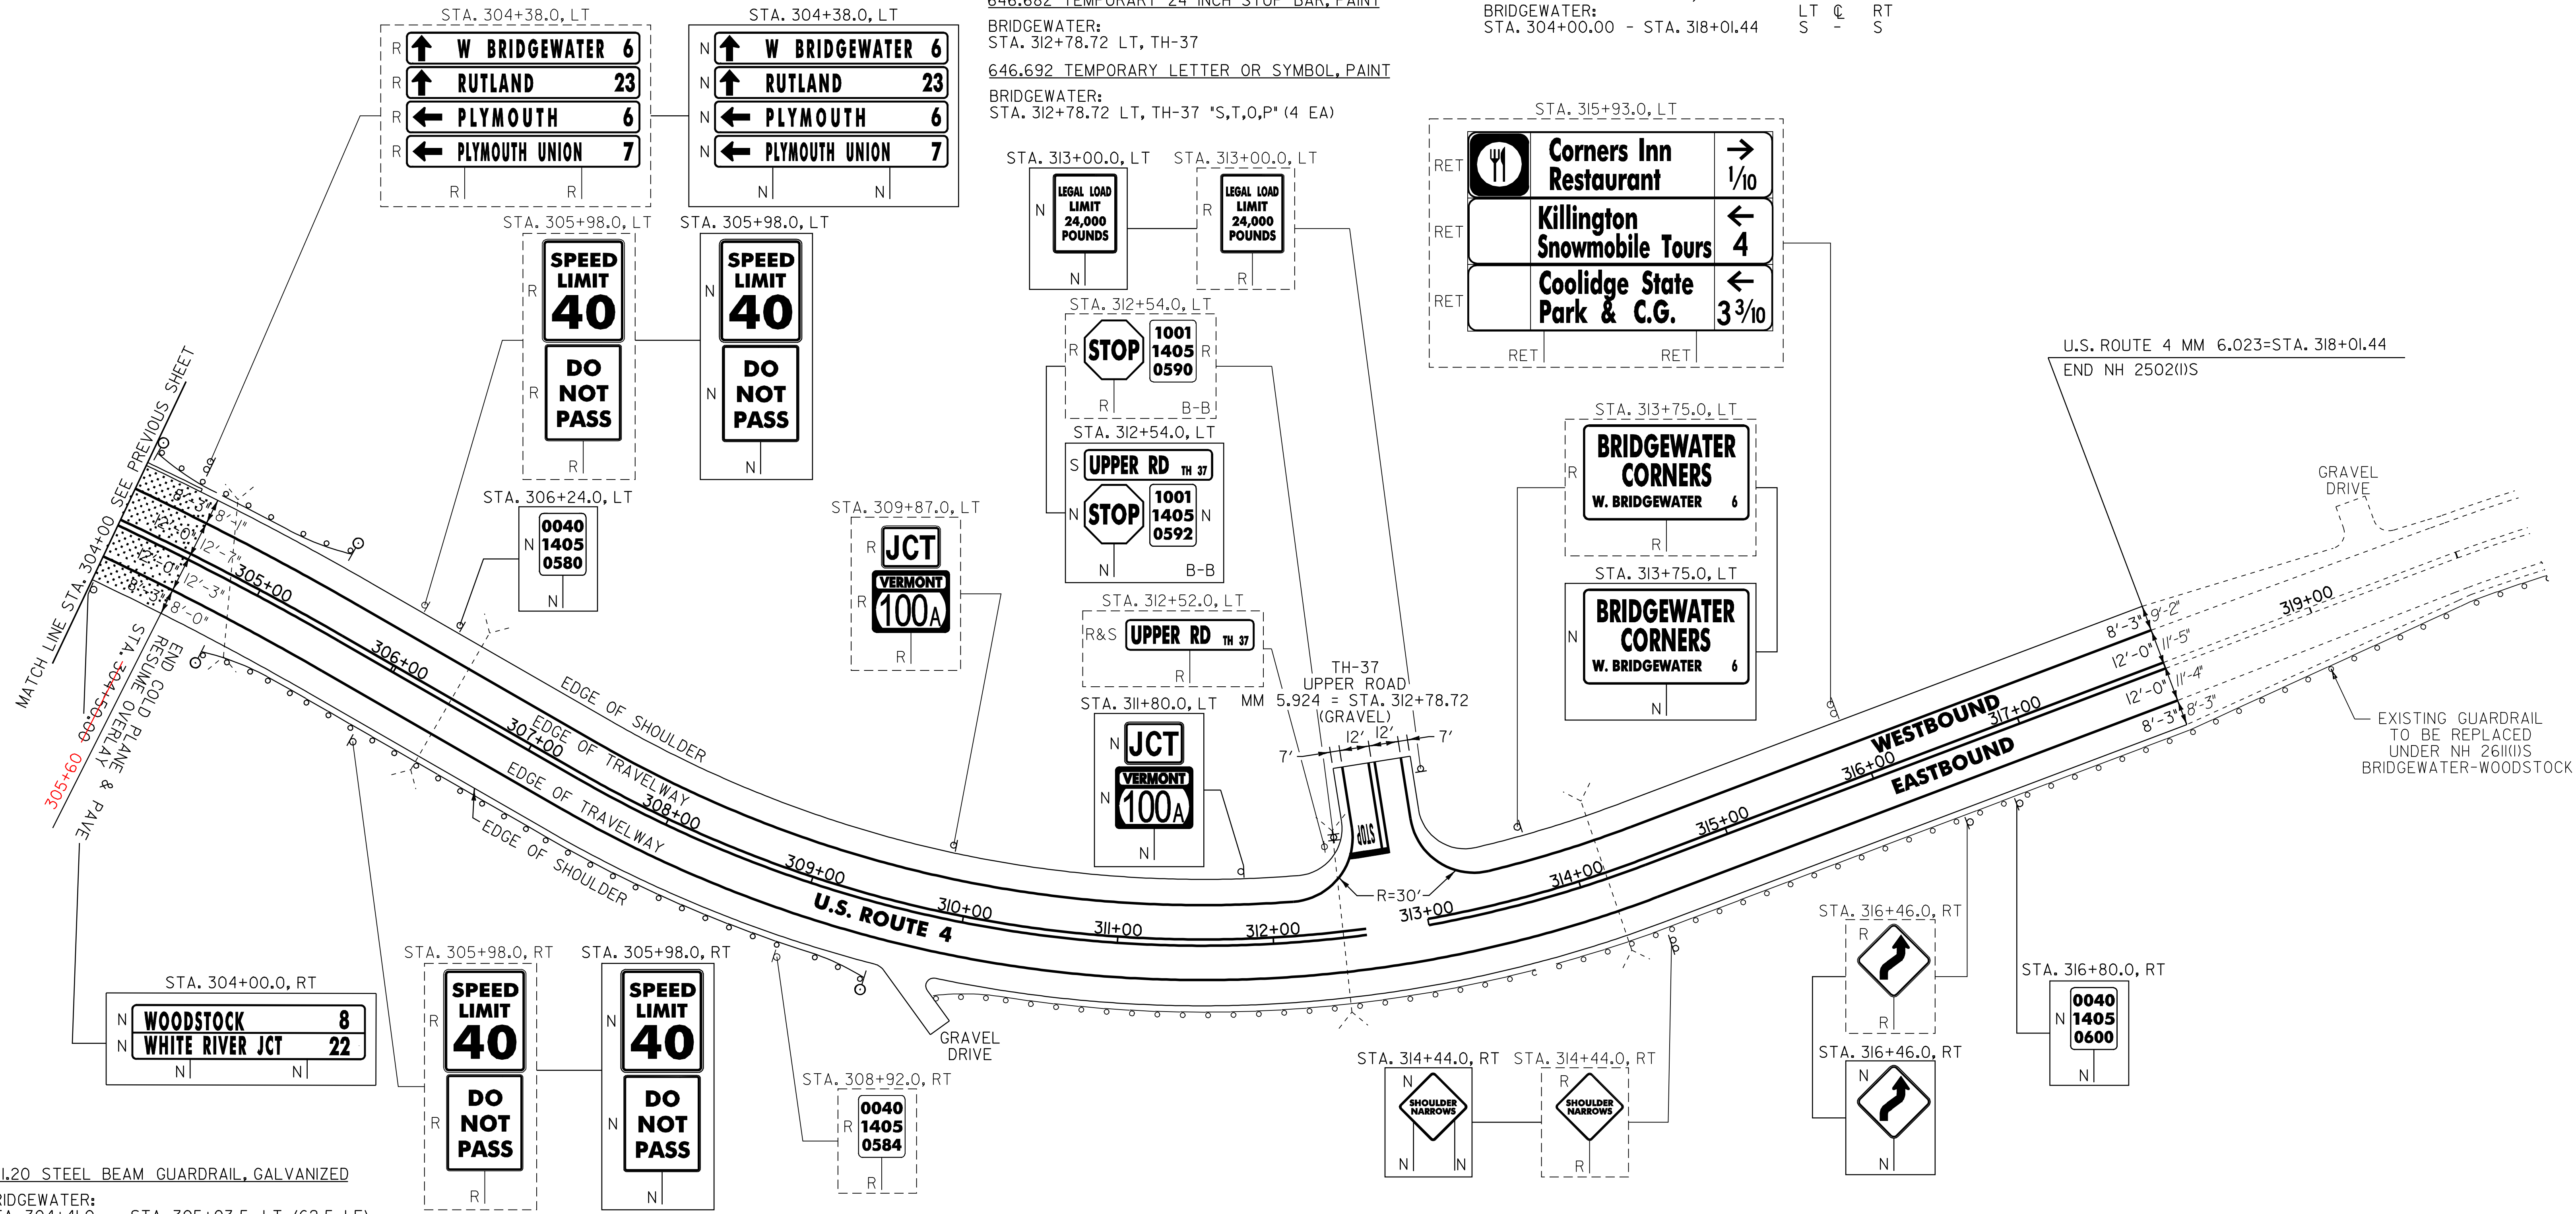

621.20 STEEL BEAM GUARDRAIL, GALVANIZED
 BRIDGEWATER:
 STA. 304+41.0 - STA. 305+03.5 LT (62.5 LF)
 STA. 305+23.0 - STA. 309+10.5 RT (387.5 LF)

621.50 MANUFACTURED TERMINAL SECTION, FLARED
 BRIDGEWATER:
 STA. 304+03.5 - STA. 304+41.0 LT
 STA. 304+85.5 - STA. 305+23.0 RT
 STA. 305+03.5 - STA. 305+41.0 LT
 STA. 309+10.5 - STA. 309+48.0 RT

621.80 REMOVAL AND DISPOSAL OF GUARDRAIL
 BRIDGEWATER:
 STA. 304+27.0 - STA. 305+30.0 LT 100
 STA. 304+96.0 - STA. 309+48.0 RT 480
 (403.0 LF)
 (452.0 LF)

676.10 DELINEATOR WITH STEEL POST
 ♀ TYPE I WHITE
 BRIDGEWATER:
 STA. 304+03.5 LT
 STA. 304+85.5 RT
 STA. 305+41.0 LT
 STA. 309+48.0 RT

NOTES:
 1. PAVING LIMIT ON ALL TOWN HIGHWAYS SHALL BE MEASURED 25 FT BACK FROM U.S. ROUTE 4 EDGE OF SHOULDER UNLESS DENOTED OTHERWISE ON THE PLANS OR AS DIRECTED BY THE RESIDENT ENGINEER.
 2. THERE ARE EXISTING UNDERGROUND UTILITIES LOCATED THROUGHOUT THE U.S. ROUTE 4 CORRIDOR IN THE PROJECT AREA. THE CONTRACTOR IS RESPONSIBLE FOR CONTACTING 'DIG SAFE' AT 1-888-344-7233 TO DETERMINE THE LOCATIONS OF THESE UTILITIES PRIOR TO PERFORMING ANY SUBSURFACE OPERATIONS.

SIGN LEGEND
 R = REMOVE
 S = SALVAGE
 N = NEW
 RET = RETAIN
 B-B = BACK TO BACK
 EXISTING = - - - - -
 NEW = _____

NOT TO SCALE

PROJECT LAYOUT SHEET #24

PROJECT NAME: KILLINGTON - BRIDGEWATER
 PROJECT NUMBER: NH 2502(I)S

FILE NAME: p05b036.dgn
 PROJECT LEADER: D.E.G.
 DESIGNED BY: J.S.P.
 IPARM FILE: p05b036i24.i

PLOT DATE: 15-MAY-2008 14
 DRAWN BY: C.A.K.
 CHECKED BY: D.E.G.
 SHEET 36 OF 74

AREA TO BE COLD PLANED & PAVED