


BRIDGE 137 TRANSITION AREA DETAIL

BR 137 U.S. ROUTE 7 FERRISBURGH STA 136+24.00 TO FERRISBURGH STA 137+83.00


NOTE:
 THE CONTRACTOR MUST USE CARE WHEN COLD PLANING BR 137 AS NOT TO DAMAGE THE BRIDGE MEMBRANE. IF DAMAGE TO THE MEMBRANE SHOULD OCCUR DURING COLD PLANING, THE CONTRACTOR SHALL REPAIR THE BRIDGE MEMBRANE AT NO ADDITIONAL COST TO THE STATE.

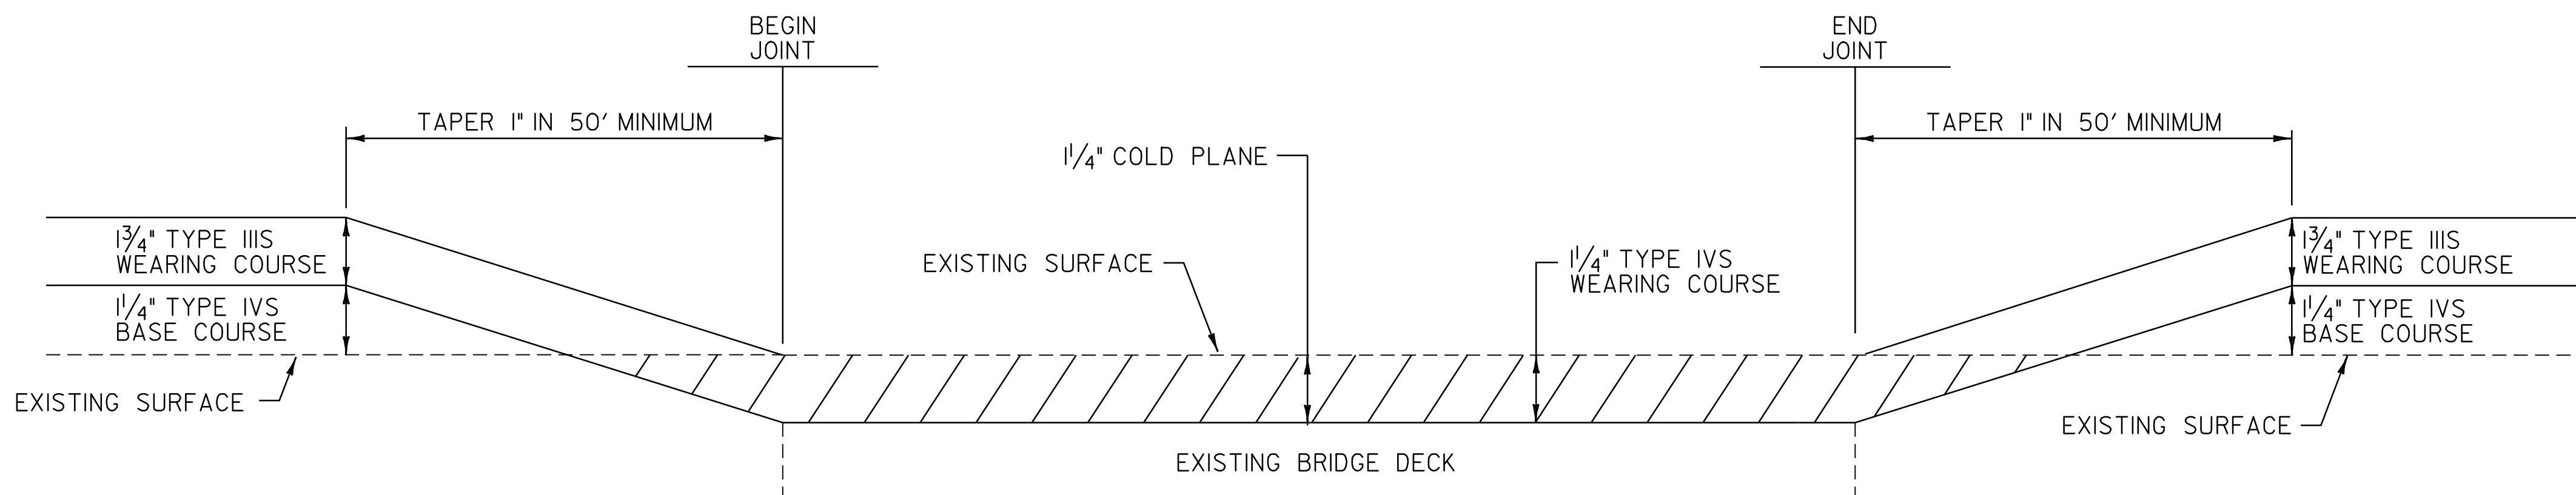

BRIDGE 139 TRANSITION AREA DETAIL


BR 139 U.S. ROUTE 7 FERRISBURGH STA 327+00.00 TO FERRISBURGH STA 329+77.00

NOTE:
 THE CONTRACTOR MUST USE CARE WHEN COLD PLANING BR 139 AS NOT TO DAMAGE THE BRIDGE MEMBRANE. IF DAMAGE TO THE MEMBRANE SHOULD OCCUR DURING COLD PLANING, THE CONTRACTOR SHALL REPAIR THE BRIDGE MEMBRANE AT NO ADDITIONAL COST TO THE STATE.

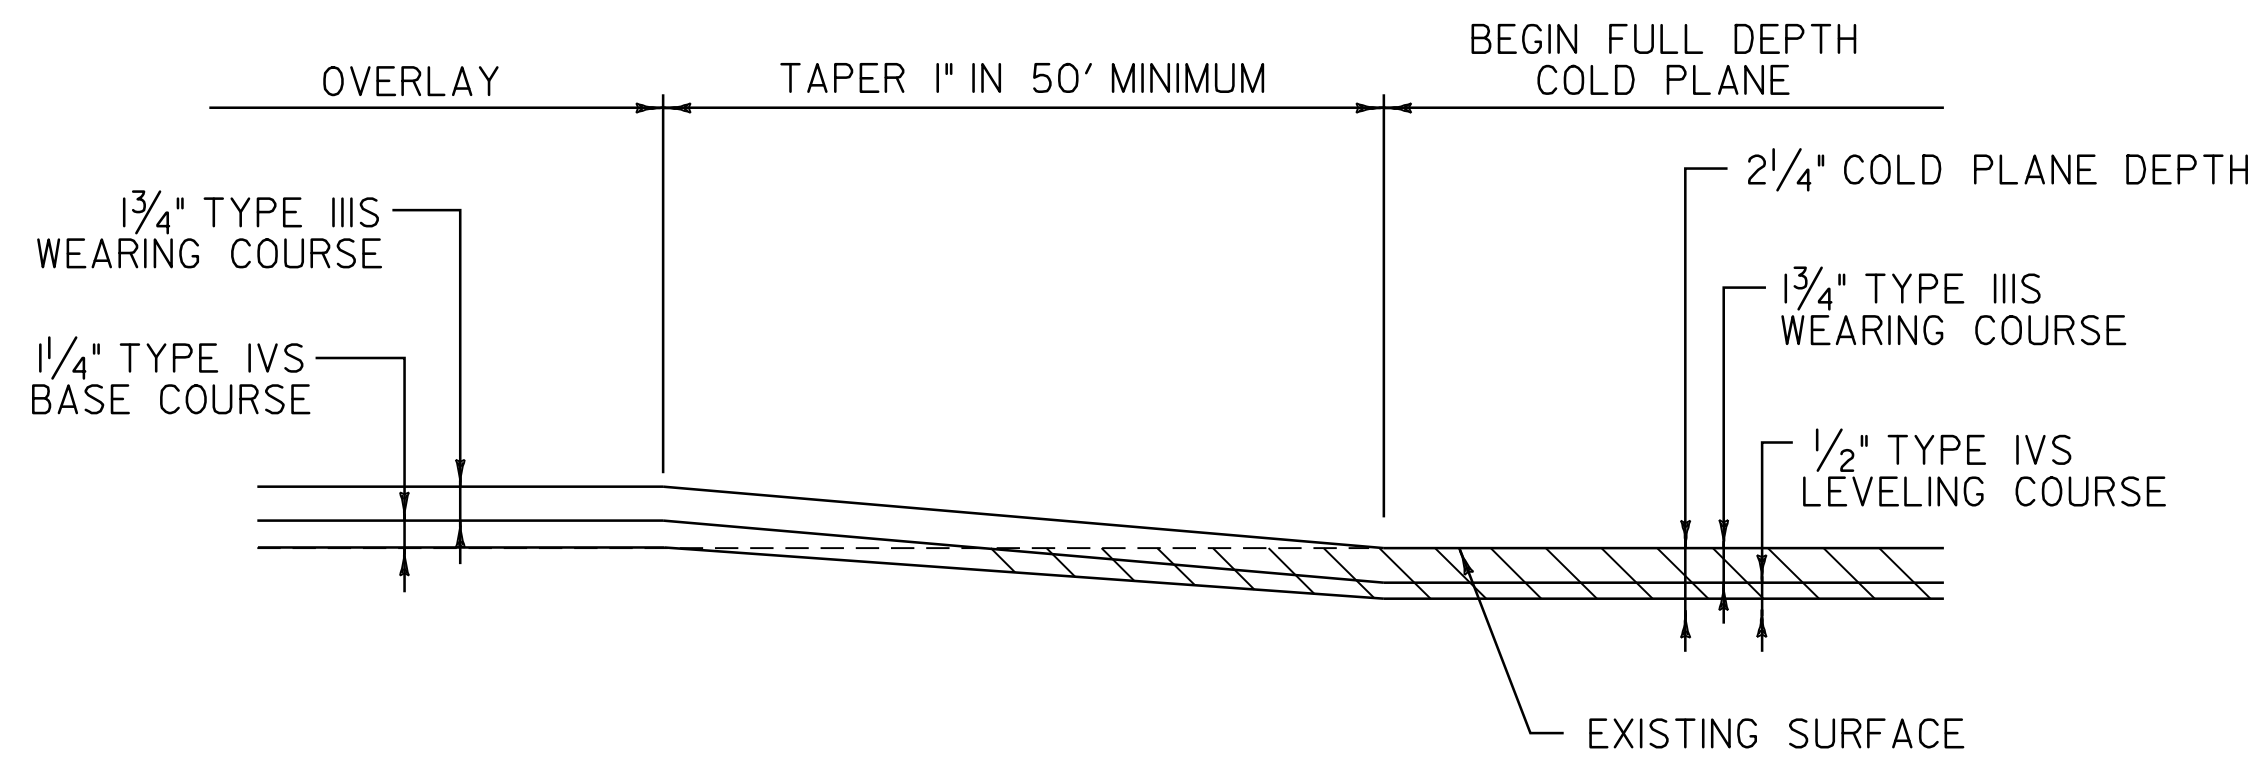


COLD PLANE TRANSITION AREA DETAIL

WALTHAM: STA 85+65.00 FERRISBURGH: STA 17+00.00 STA 192+00.00
 STA 77+60.00 STA 364+30.00
 STA 82+90.00 STA 370+40.00
 STA 133+50.00

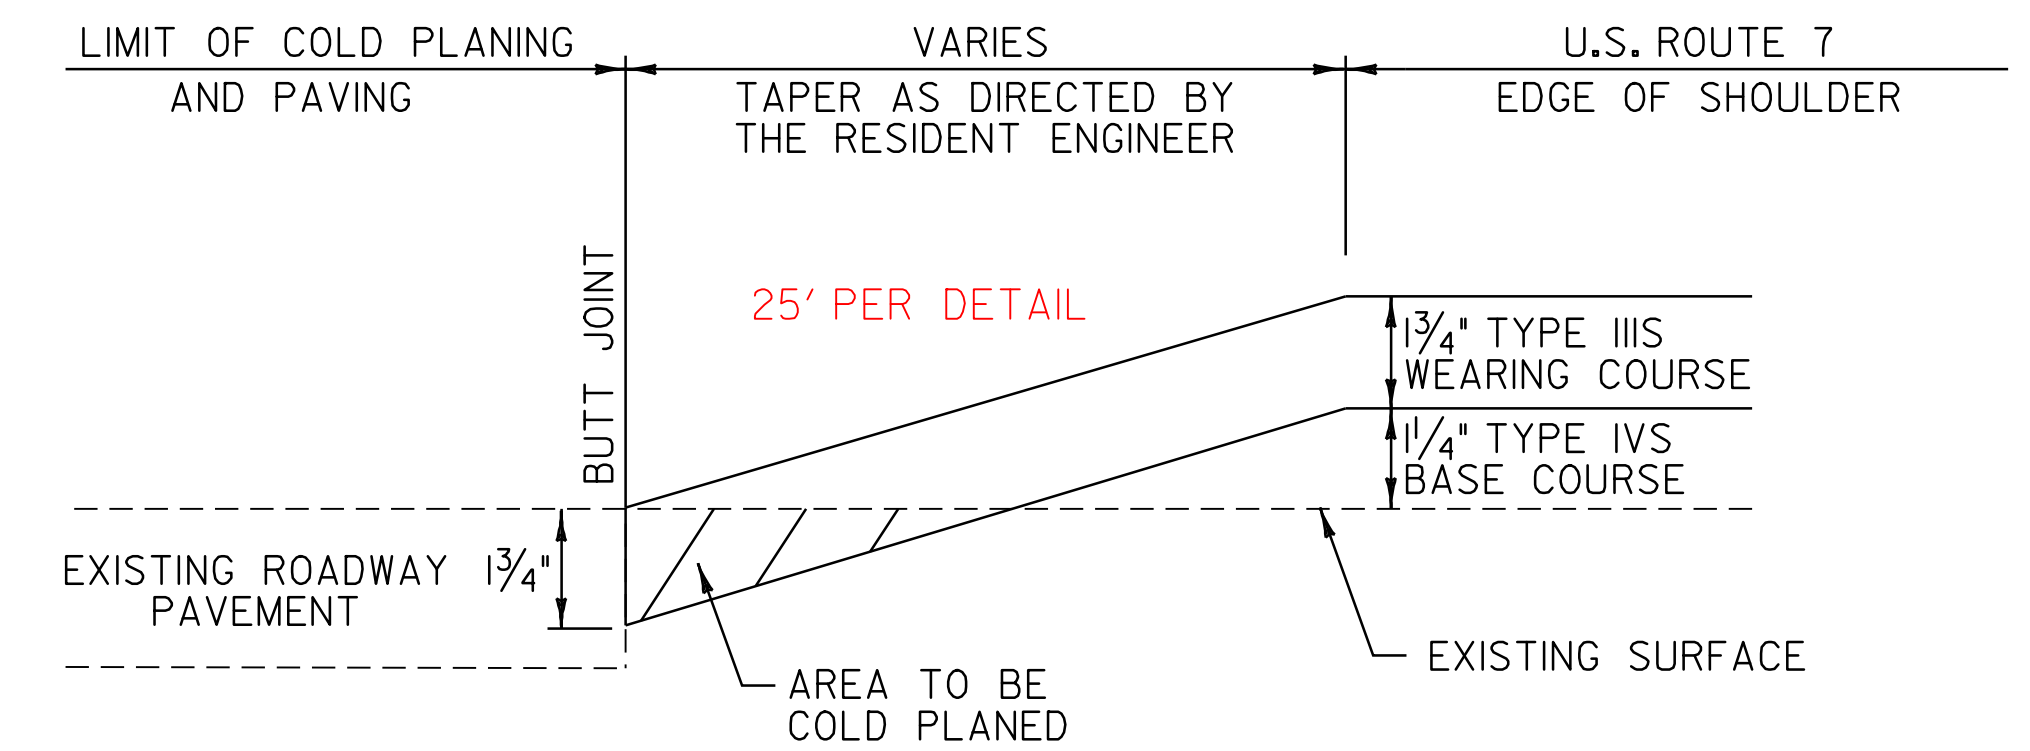


OVERLAY APPROACH AREA DETAIL

NEW HAVEN: TH-8 WALTHAM: TH-3 TH-5 TH-9 FERRISBURGH: TH-2 TH-6 TH-15 TH-18 TH-22 TH-31 TH-34 TH-45

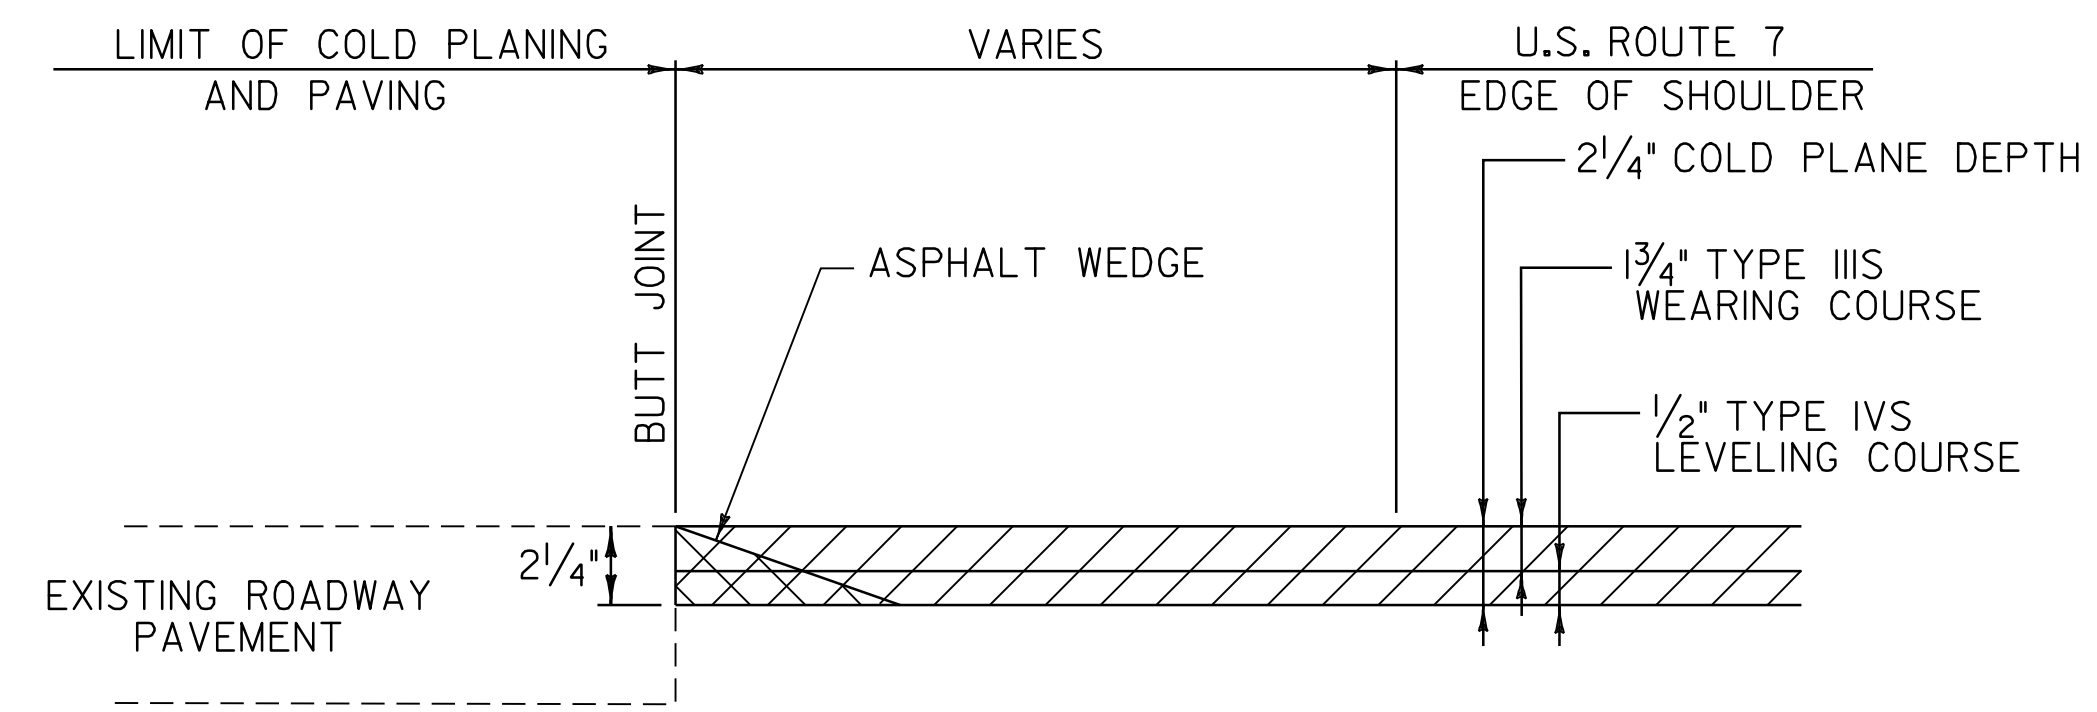

COLD PLANE APPROACH AREA DETAIL

FERRISBURGH: NSH-FSH TH-5 VT. ROUTE 22A TH-1

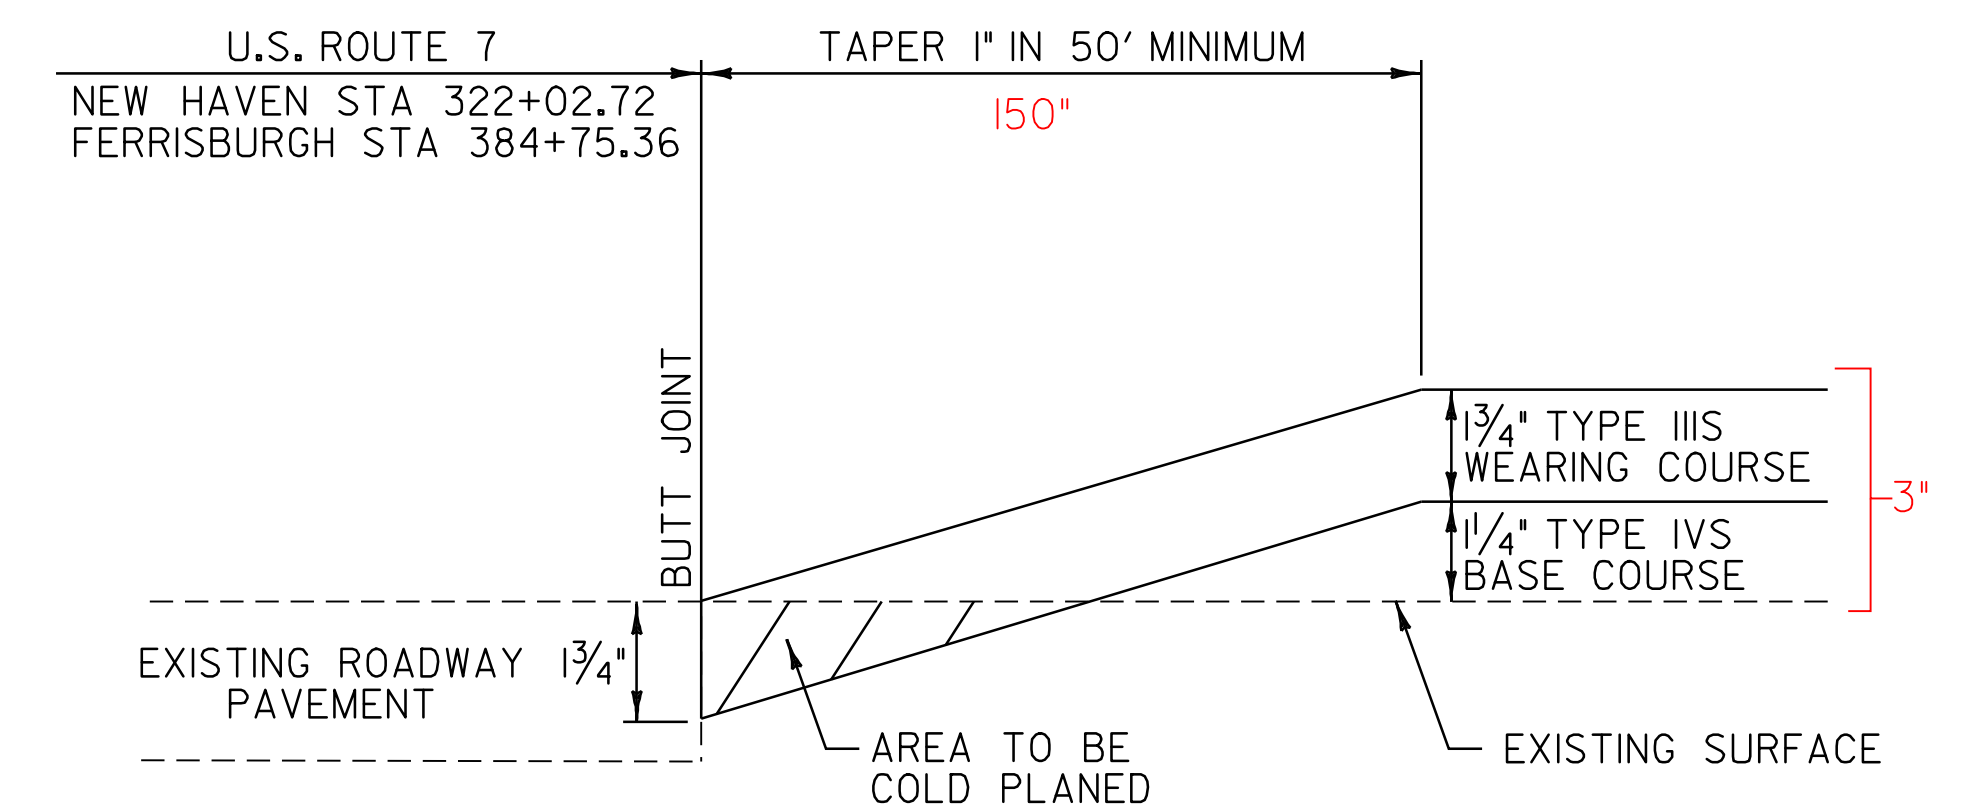

MAINLINE APPROACH AREA DETAIL

NEW HAVEN MM 6.099 = STA 322+02.72 - BEGIN PROJECT
 FERRISBURGH MM 7.287 = STA 384+75.36 - END PROJECT

NOT TO SCALE

PAVING DETAILS SHEET #1

PROJECT NAME: NEW_HAVEN_-_FERRISBURGH
 PROJECT NUMBER: NH_2503(I)S

FILE NAME: Q05b038.dgn PLOT DATE: 31-JUL-2009 15
 PROJECT LEADER: D.E.G. DRAWN BY: C.A.K.
 DESIGNED BY: M.J.M. CHECKED BY: D.W.E.
 IPARM FILE: p05b038pdl.i SHEET 4 OF 87