


**BEGIN PROJECT  
LOCATION TIES**

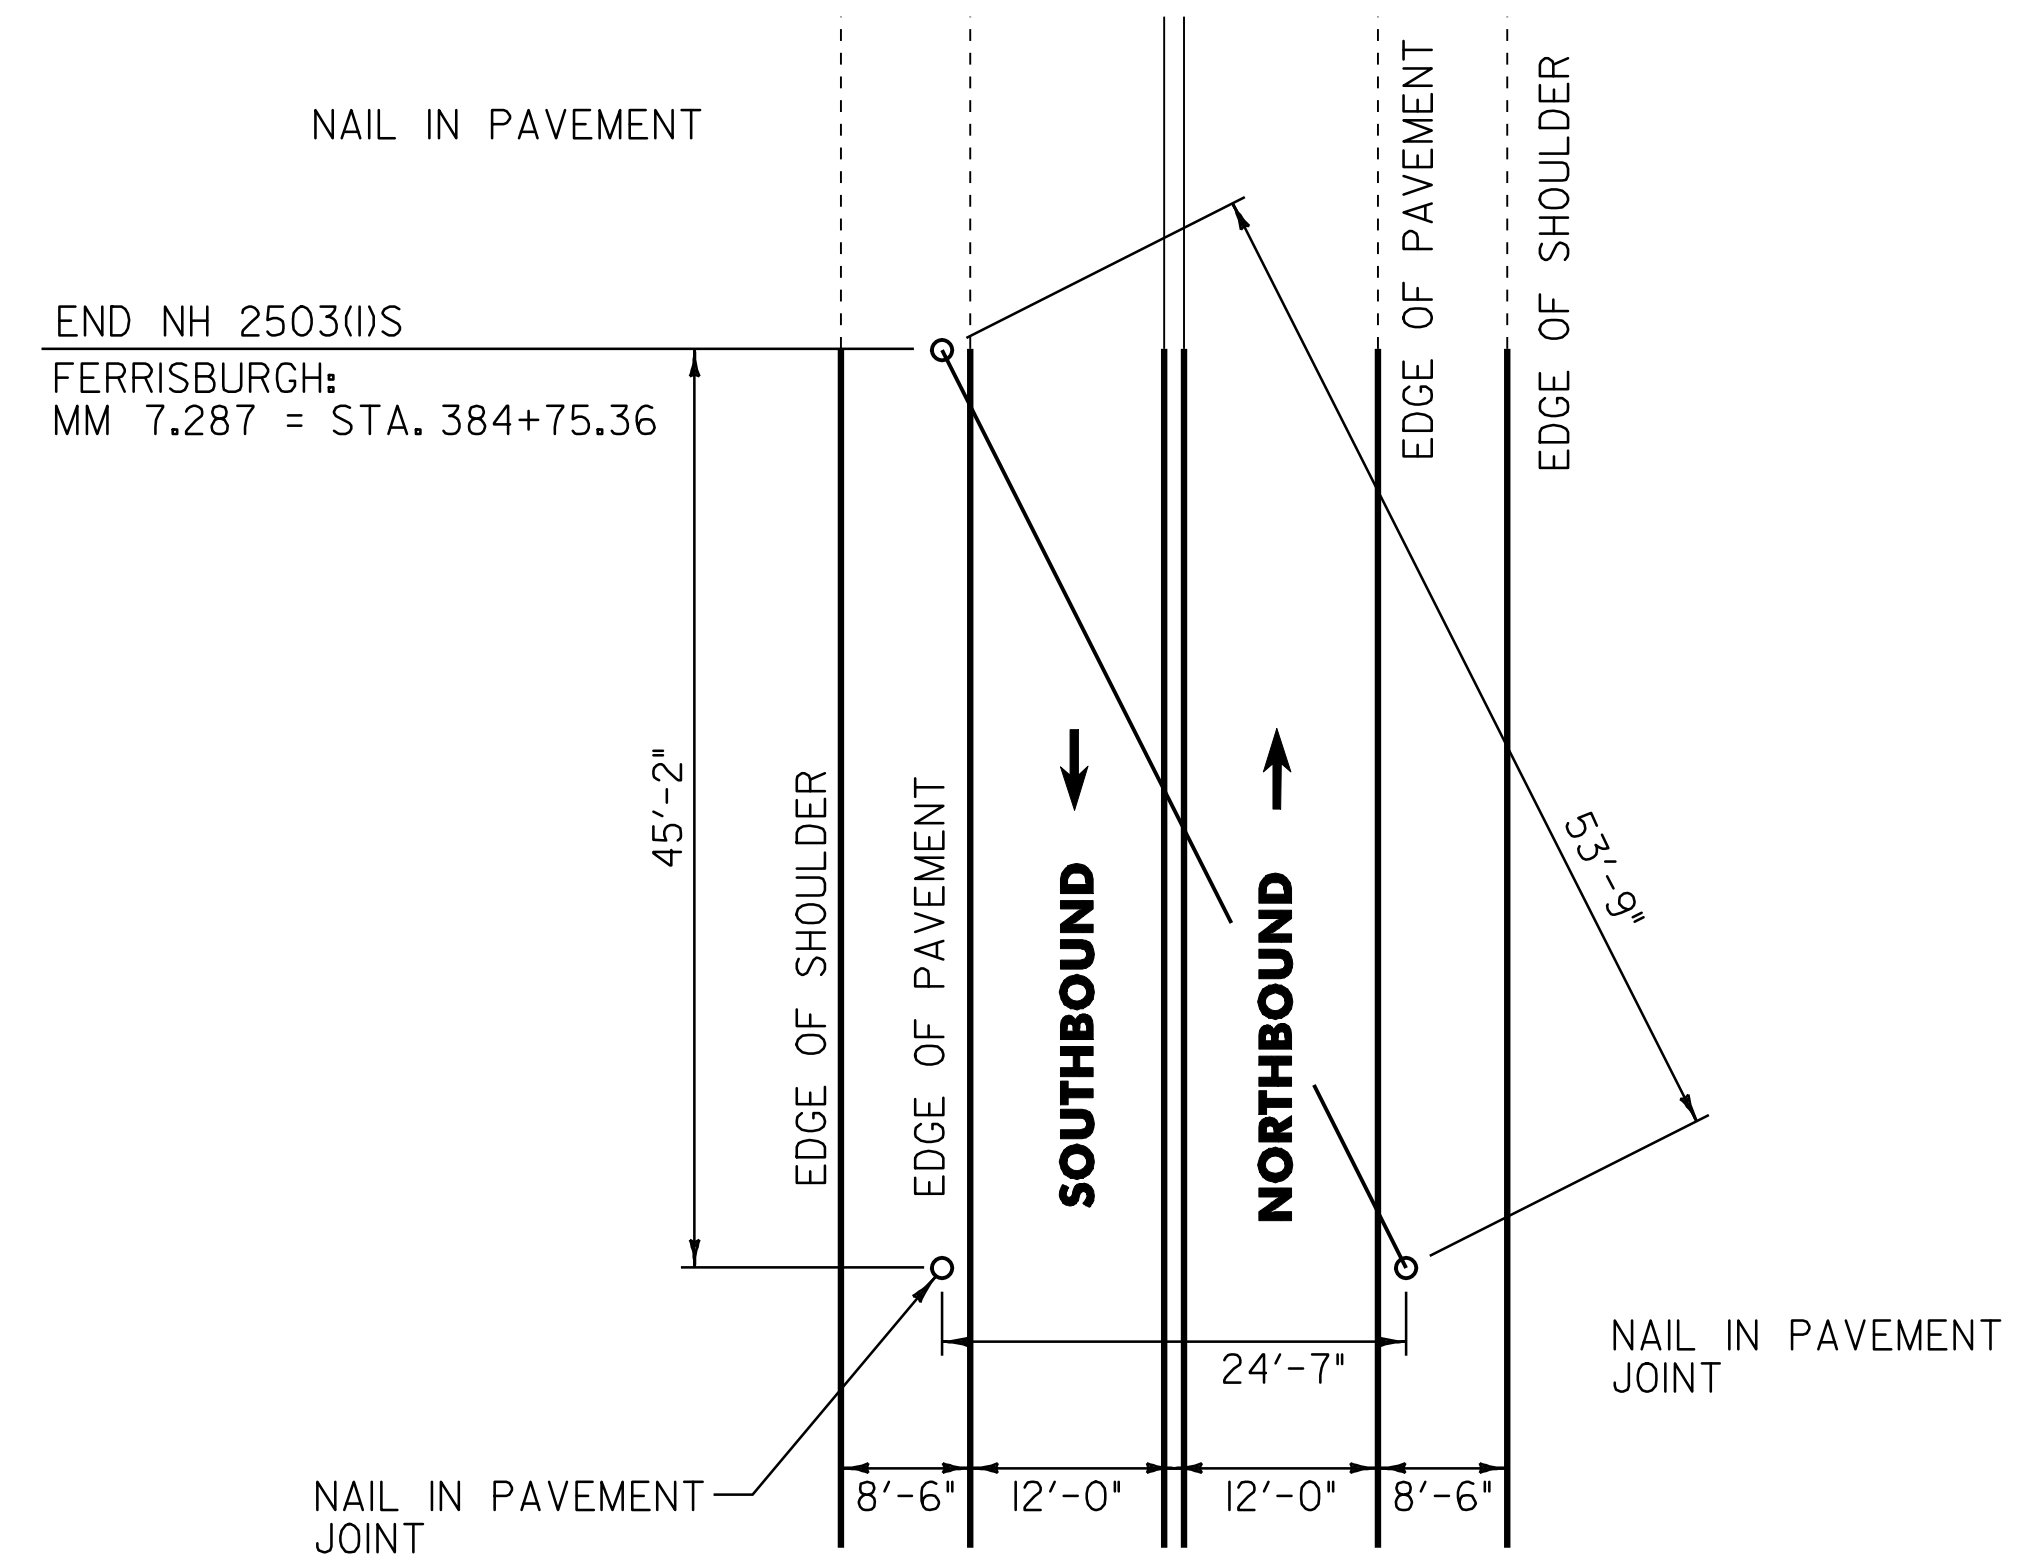

**END PROJECT  
LOCATION TIES**

NOT TO SCALE

**PAVING  
DETAILS  
SHEET #2**

PROJECT NAME: NEW\_HAVEN\_-\_FERRISBURGH  
PROJECT NUMBER: NH\_2503(I)S

FILE NAME: Q5b038.dgn PLOT DATE: 31-JUL-2009 15  
PROJECT LEADER: D.E.G. DRAWN BY: C.A.K.  
DESIGNED BY: M.J.M. CHECKED BY: D.W.E.  
IPARM FILE: P05b038pd2.i SHEET 5 OF 87