

646.402 DURABLE 4 INCH WHITE LINE, THERMOPLASTIC  
 (ALL LINES WILL INCLUDE EDGE LINE BREAKS AND  
 RADIUS FOR TOWN HIGHWAYS)

NEW HAVEN:  
 STA 336+00.00 - STA 352+00.00 EDGE LINE LT & RT

646.602 TEMPORARY 4 INCH WHITE LINE, PAINT  
 (ALL LINES WILL INCLUDE EDGE LINE BREAKS AND  
 RADIUS FOR TOWN HIGHWAYS)

NEW HAVEN:  
 STA 336+00.00 - STA 352+00.00 EDGE LINE LT & RT


646.412 DURABLE 4 INCH YELLOW LINE, THERMOPLASTIC  
 (ALL LINES WILL INCLUDE C/L BREAKS FOR  
 TOWN HIGHWAYS) S=SOLID, D=DASHED

NEW HAVEN: LT C RT  
 STA 336+00.00 - STA 343+20.00 S - D  
 STA 343+20.00 - STA 349+53.00 - D -  
 STA 349+53.00 - STA 352+00.00 D - S

646.612 TEMPORARY 4 INCH YELLOW LINE, PAINT  
 (ALL LINES WILL INCLUDE C/L BREAKS FOR  
 TOWN HIGHWAYS) S=SOLID, D=DASHED

NEW HAVEN: LT C RT  
 STA 336+00.0 - STA 343+20.0 S - D  
 STA 343+20.0 - STA 349+53.0 - D -  
 STA 349+53.0 - STA 352+00.0 D - S

675.50 REMOVING SIGNS  
 AS SHOWN - 2

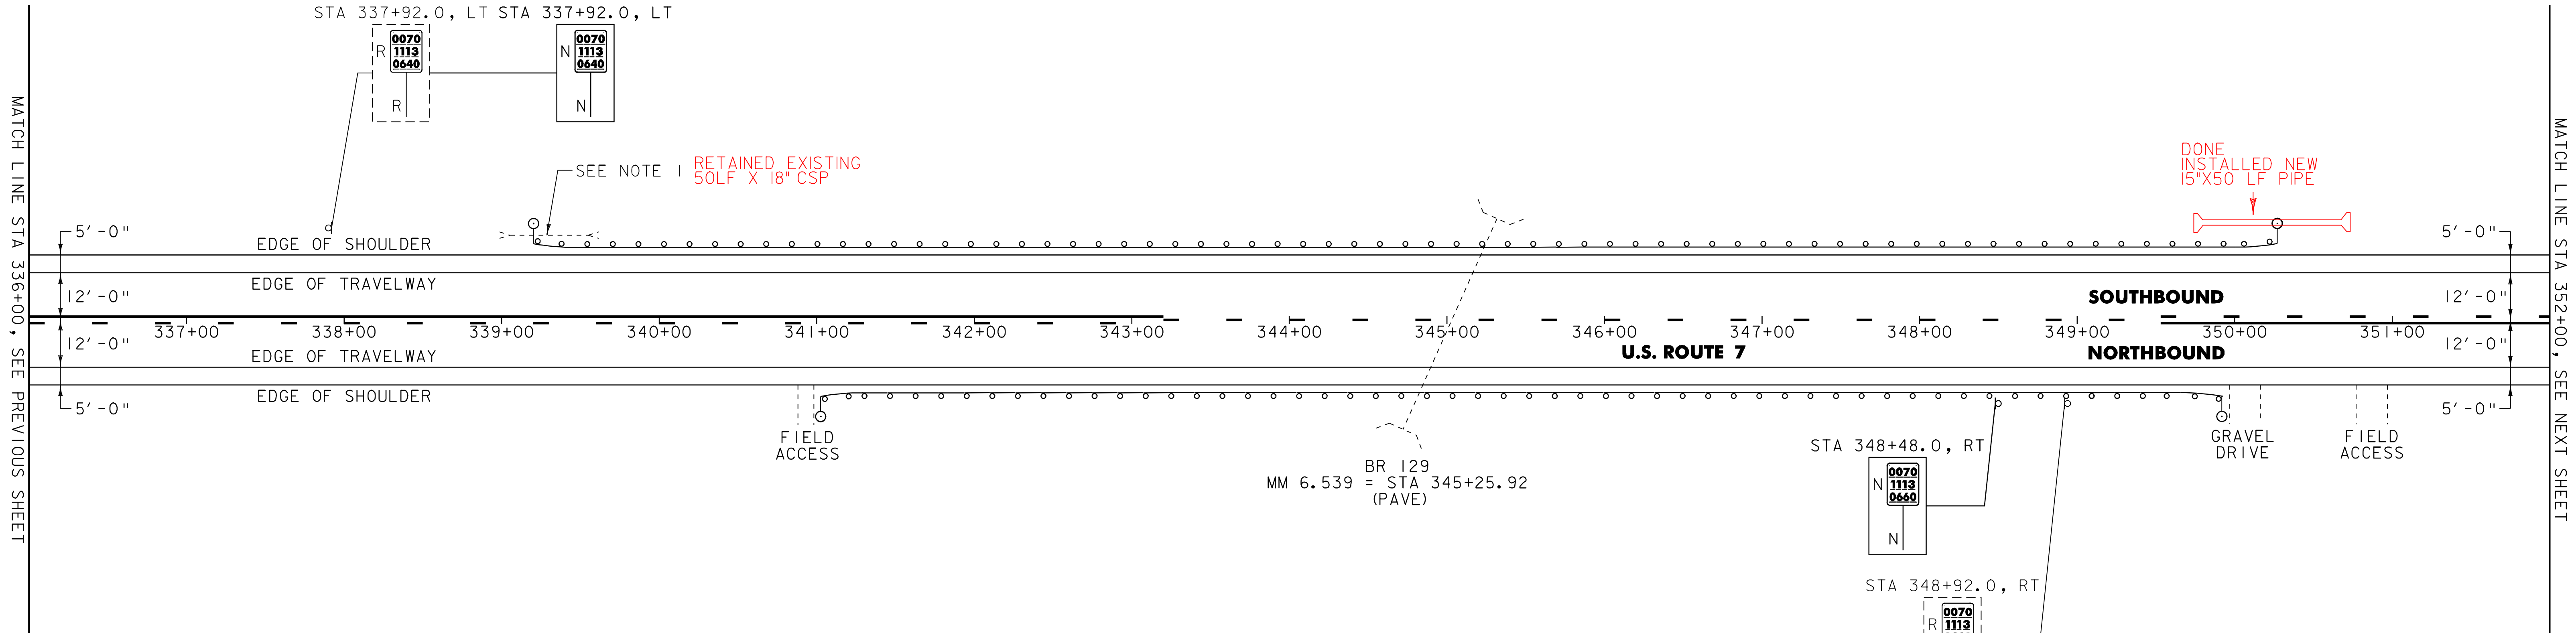

621.20 STEEL BEAM GUARDRAIL, GALVANIZED

NEW HAVEN:  
 STA 339+52.0 - STA 349+89.5 LT (1037.5 LF)  
 STA 341+37.5 - STA 349+62.5 RT (825.0 LF)

621.50 MANUFACTURED TERMINAL SECTION, FLARED

NEW HAVEN:  
 STA 339+14.5 - STA 339+52.0 LT  
 STA 341+00.0 - STA 341+37.5 RT  
 STA 349+62.5 - STA 350+00.0 RT  
 STA 349+89.5 - STA 350+27.0 LT

621.80 REMOVAL AND DISPOSAL OF GUARDRAIL

NEW HAVEN:  
 STA 339+17.0 - STA 349+22.0 LT (1005.0 LF)  
 STA 341+22.0 - STA 349+92.0 RT (870.0 LF)

676.10 DELINEATOR WITH STEEL POST

TYPE I WHITE

NEW HAVEN:  
 STA 339+14.5 LT  
 STA 341+00.0 RT  
 STA 350+00.0 RT  
 STA 350+27.0 LT

SIGN LEGEND

R = REMOVE  
 S = SALVAGE  
 N = NEW  
 RET = RETAIN  
 B-B = BACK TO BACK  
 EXISTING = - - - - -  
 NEW = \_\_\_\_\_

NOTE:  
 1. SEE SHEET 86 FOR FLARED END SECTION  
 WITH CULVERT PIPE DETAIL.

NOT TO SCALE

**PROJECT  
 LAYOUT  
 SHEET #2**

PROJECT NAME: NEW\_HAVEN\_-\_FERRISBURGH  
 PROJECT NUMBER: NH\_2503(1)S  
 FILE NAME: Q5b038.dgn  
 PROJECT LEADER: D.E.G.  
 DESIGNED BY: M.J.M.  
 IPARM FILE: Q05b038I02.i  
 PLOT DATE: 31-JUL-2009 15  
 DRAWN BY: C.A.K.  
 CHECKED BY: D.W.E.  
 SHEET 15 OF 87