

646.402 DURABLE 4 INCH WHITE LINE, THERMOPLASTIC
(ALL LINES WILL INCLUDE EDGE LINE BREAKS AND RADIUS FOR TOWN HIGHWAYS)

NEW HAVEN:
STA 400+00.00 - STA 406+03.20 EDGE LINE LT & RT

WALTHAM:
STA 0+00.00 - STA 10+00.00 EDGE LINE LT & RT

646.602 TEMPORARY 4 INCH WHITE LINE, PAINT
(ALL LINES WILL INCLUDE EDGE LINE BREAKS AND RADIUS FOR TOWN HIGHWAYS)

NEW HAVEN:
STA 400+00.00 - STA 406+03.20 EDGE LINE LT & RT

WALTHAM:
STA 0+00.00 - STA 10+00.00 EDGE LINE LT & RT

646.412 DURABLE 4 INCH YELLOW LINE, THERMOPLASTIC
(ALL LINES WILL INCLUDE C/L BREAKS FOR TOWN HIGHWAYS) S=SOLID, D=DASHED

NEW HAVEN:
STA 400+00.00 - STA 404+98.00 S - D
STA 404+98.00 - STA 406+03.20 - D -

WALTHAM:
STA 0+00.00 - STA 5+28.00 - D -
STA 5+28.00 - STA 10+00.00 D - S

646.612 TEMPORARY 4 INCH YELLOW LINE, PAINT
(ALL LINES WILL INCLUDE C/L BREAKS FOR TOWN HIGHWAYS) S=SOLID, D=DASHED

NEW HAVEN:
STA 400+00.00 - STA 404+98.00 S - D
STA 404+98.00 - STA 406+03.20 - D -


WALTHAM:
STA 0+00.00 - STA 5+28.00 - D -
STA 5+28.00 - STA 10+00.00 D - S

675.50 REMOVING SIGNS
AS SHOWN - 6

END NEW HAVEN
MM 7.690 = STA 406+03.20
BEGIN WALTHAM
MM 0.000 = STA 0+00.00

MATCH LINE STA 400+00, SEE PREVIOUS SHEET

MATCH LINE STA 10+00, SEE NEXT SHEET

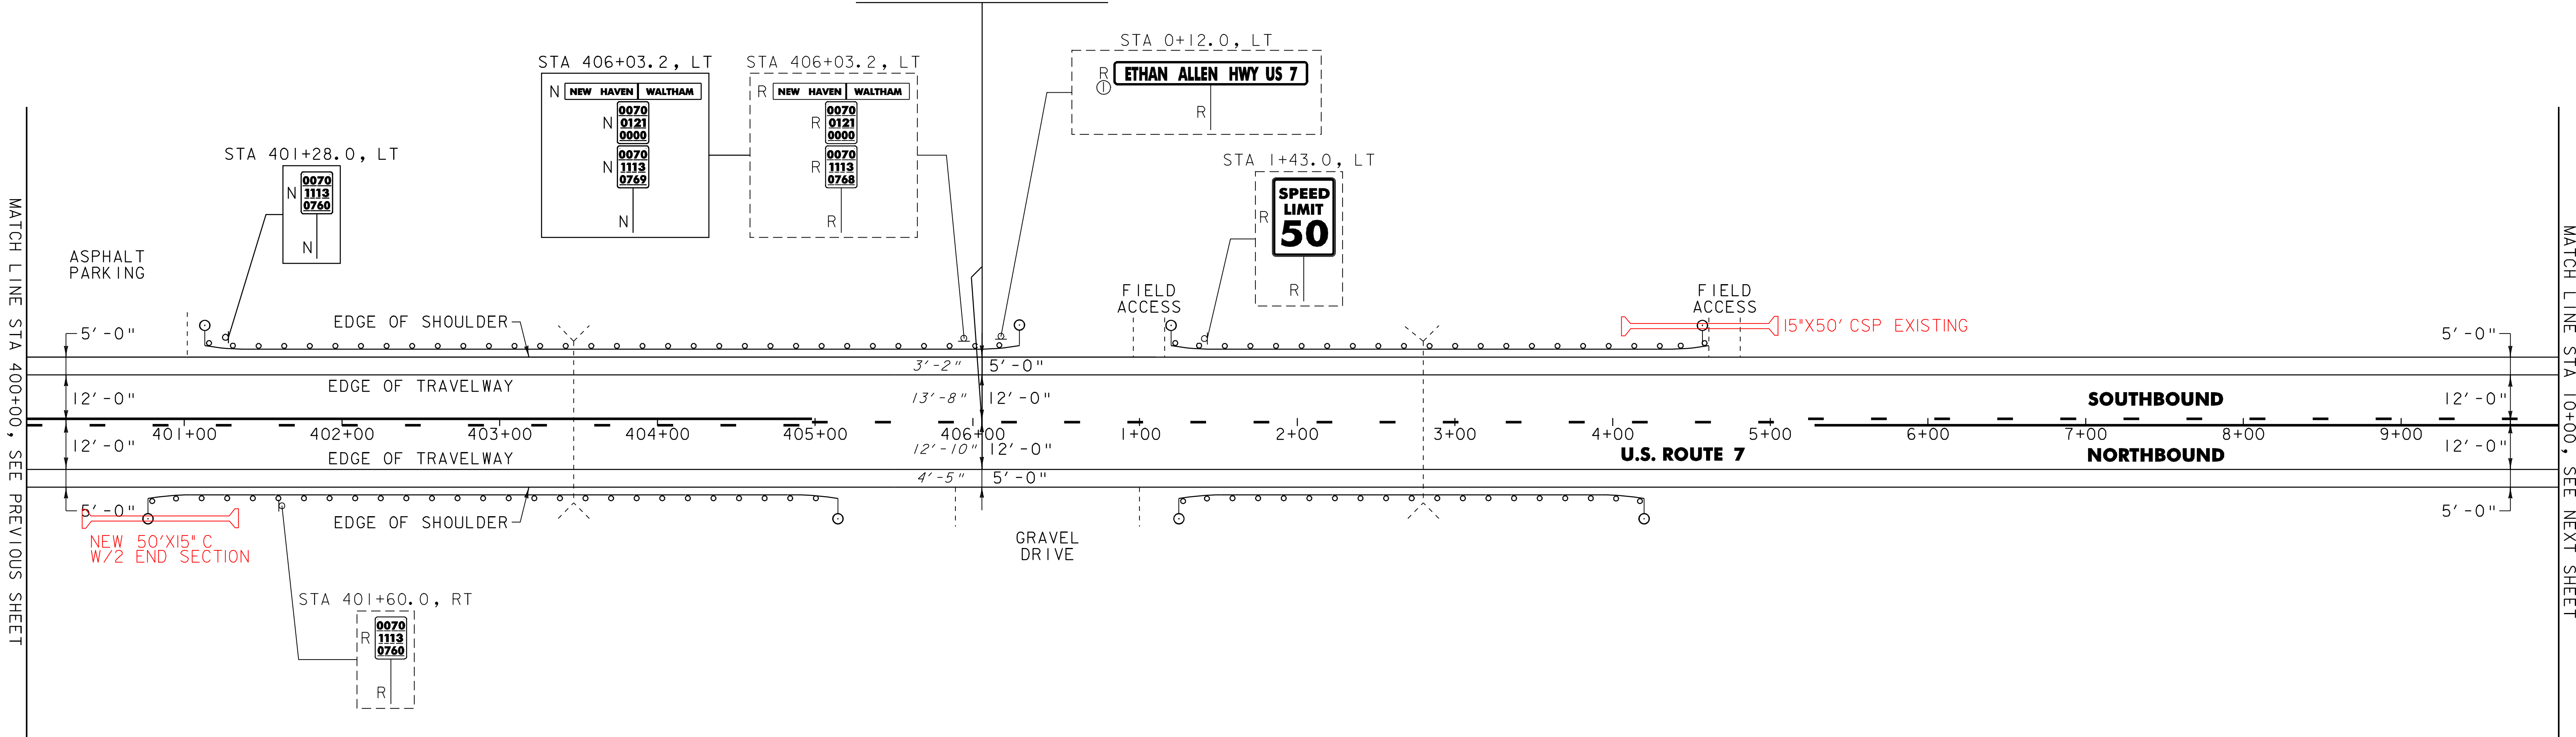

621.20 STEEL BEAM GUARDRAIL, GALVANIZED

NEW HAVEN:
STA 401+14.5 - STA 404+77.0 RT (362.5 LF)
STA 401+50.5 - STA 405+88.0 LT (437.5 LF)

WALTHAM:
STA 1+59.0 - STA 4+21.5 LT (262.5 LF)
STA 1+62.5 - STA 3+87.5 RT (225.0 LF)

621.50 MANUFACTURED TERMINAL SECTION, FLARED

NEW HAVEN:
STA 400+77.0 - STA 401+14.5 RT
STA 401+13.0 - STA 401+50.5 LT
STA 404+77.0 - STA 405+14.5 RT
STA 405+88.0 - STA 406+03.2 LT (SEE NOTE 1)

WALTHAM:
STA 0+00.0 - STA 0+22.3 LT (SEE NOTE 1)
STA 1+21.5 - STA 1+59.0 LT
STA 1+25.0 - STA 1+62.5 RT
STA 3+87.5 - STA 4+25.0 RT
STA 4+21.5 - STA 4+59.0 LT

621.80 REMOVAL AND DISPOSAL OF GUARDRAIL

NEW HAVEN:
STA 401+13.0 - STA 405+17.0 LT (404.0 LF)
STA 401+82.0 - STA 405+00.0 RT (318.0 LF)

WALTHAM:
STA 1+20.0 - STA 4+61.0 LT (341.0 LF)
STA 1+80.0 - STA 4+20.0 RT (240.0 LF)

676.10 DELINEATOR WITH STEEL POST

♀ TYPE 1 WHITE

NEW HAVEN:
STA 400+77.0 RT
STA 401+13.0 LT
STA 405+14.5 RT

WALTHAM:
STA 0+22.3 LT
STA 1+21.5 LT
STA 1+25.0 RT
STA 4+25.0 RT
STA 4+59.0 LT

SIGN LEGEND
R = REMOVE
S = SALVAGE
N = NEW
RET = RETAIN
B-B = BACK TO BACK
EXISTING = - - - - -
NEW = _____
① = SIGN TO BE RETURNED TO THE TOWN OF WALTHAM

NOTE:
1. MANUFACTURED TERMINAL SECTION, FLARED RUNS ACROSS THE TOWN LINE.

PROJECT LAYOUT SHEET #6	NOT TO SCALE	
	PROJECT NAME: <u>NEW HAVEN - FERRISBURGH</u>	PLOT DATE: 31-JUL-2009 15
	PROJECT NUMBER: <u>NH_2503(1)S</u>	DRAWN BY: <u>C.A.K.</u>
	FILE NAME: <u>Q5b038.dgn</u>	CHECKED BY: <u>D.W.E.</u>
	DESIGNED BY: <u>M.J.M.</u>	SHEET <u>19</u> OF <u>87</u>
	IPARM FILE: <u>p05b038106.i</u>	