

646.402 DURABLE 4 INCH WHITE LINE, THERMOPLASTIC
 (ALL LINES WILL INCLUDE EDGE LINE BREAKS AND
 RADIUS FOR TOWN HIGHWAYS)

WALTHAM:
 STA 10+00.00 - STA 26+00.00 EDGE LINE LT & RT

646.602 TEMPORARY 4 INCH WHITE LINE, PAINT
 (ALL LINES WILL INCLUDE EDGE LINE BREAKS AND
 RADIUS FOR TOWN HIGHWAYS)

WALTHAM:
 STA 10+00.00 - STA 26+00.00 EDGE LINE LT & RT


646.412 DURABLE 4 INCH YELLOW LINE, THERMOPLASTIC
 (ALL LINES WILL INCLUDE C/L BREAKS FOR
 TOWN HIGHWAYS) S=SOLID, D=DASHED

WALTHAM:
 STA 10+00.00 - STA 12+67.00 LT C RT
 D - S
 STA 12+67.00 - STA 16+37.00 S - S
 STA 16+37.00 - STA 23+23.00 S - D
 STA 23+23.00 - STA 26+00.00 S - S

646.612 TEMPORARY 4 INCH YELLOW LINE, PAINT
 (ALL LINES WILL INCLUDE C/L BREAKS FOR
 TOWN HIGHWAYS) S=SOLID, D=DASHED

WALTHAM:
 STA 10+00.00 - STA 12+67.00 LT C RT
 D - S
 STA 12+67.00 - STA 16+37.00 S - S
 STA 16+37.00 - STA 23+23.00 S - D
 STA 23+23.00 - STA 26+00.00 S - S

675.50 REMOVING SIGNS
 AS SHOWN - 3

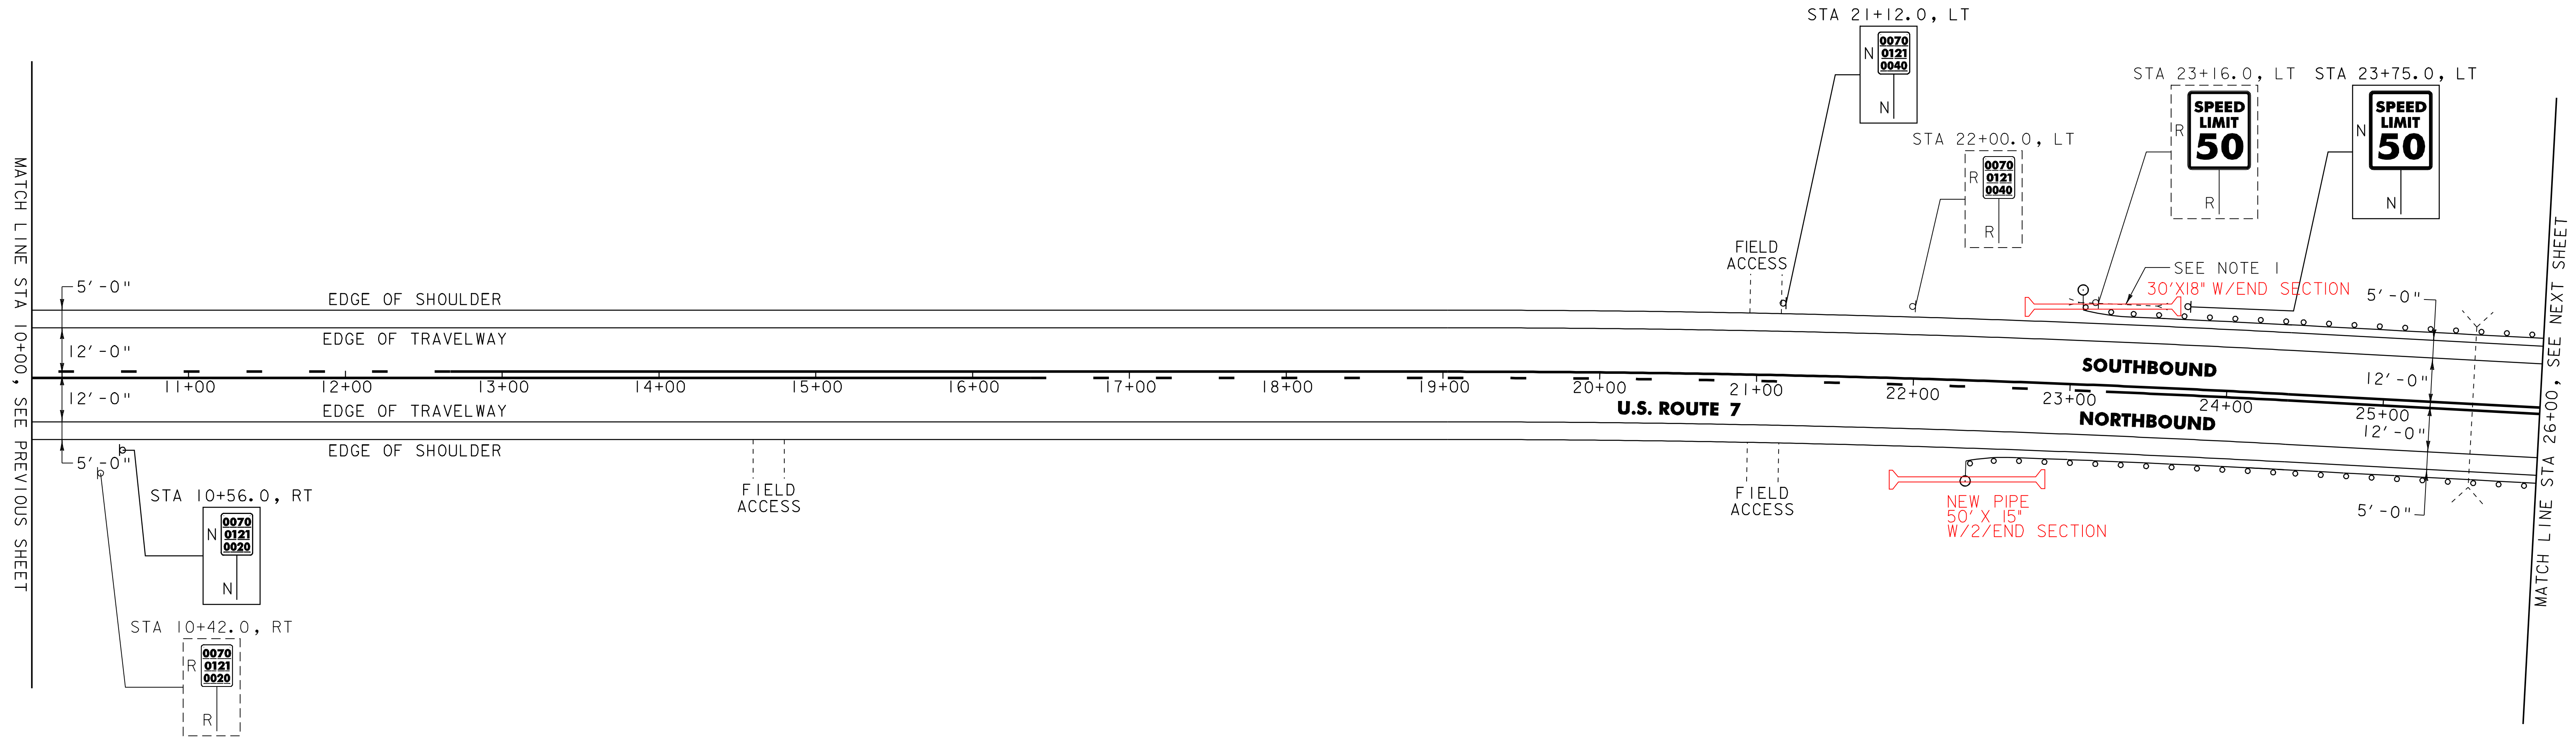

621.20 STEEL BEAM GUARDRAIL, GALVANIZED

WALTHAM:
 STA 22+72.5 - STA 26+00.0 RT (327.5 LF)
 STA 23+44.0 - STA 26+00.0 LT (256.0 LF)

621.50 MANUFACTURED TERMINAL SECTION, FLARED

WALTHAM:
 STA 22+35.0 - STA 22+72.5 RT
 STA 23+06.5 - STA 23+44.0 LT

621.80 REMOVAL AND DISPOSAL OF GUARDRAIL

WALTHAM:
 STA 22+97.0 - STA 26+00.0 RT (303.0 LF)
 STA 23+30.0 - STA 26+00.0 LT (270.0 LF)

676.10 DELINEATOR WITH STEEL POST

♀ TYPE 1 WHITE

WALTHAM:
 STA 23+35.0 RT
 STA 23+06.5 LT

SIGN LEGEND

R = REMOVE
 S = SALVAGE
 N = NEW
 RET = RETAIN
 B-B = BACK TO BACK
 EXISTING = - - - - -
 NEW = _____

NOT TO SCALE

PROJECT LAYOUT SHEET #7

PROJECT NAME: NEW HAVEN - FERRISBURGH
 PROJECT NUMBER: NH_2503(1)S

FILE NAME: Q5b038.dgn_ PLOT DATE: 31-JUL-2009 15
 PROJECT LEADER: D.E.G. DRAWN BY: C.A.K.
 DESIGNED BY: M.J.M. CHECKED BY: D.W.E.
 IPARM FILE: p05b038107.i SHEET 20 OF 87

NOTE:

I. SEE SHEET 86 FOR FLARED END SECTION WITH CULVERT PIPE DETAIL.