

646.402 DURABLE 4 INCH WHITE LINE, THERMOPLASTIC
 (ALL LINES WILL INCLUDE EDGE LINE BREAKS AND RADIUS FOR TOWN HIGHWAYS)
 WALTHAM:
 STA 26+00.00 - STA 42+00.00 EDGE LINE LT & RT

646.602 TEMPORARY 4 INCH WHITE LINE, PAINT
 (ALL LINES WILL INCLUDE EDGE LINE BREAKS AND RADIUS FOR TOWN HIGHWAYS)
 WALTHAM:
 STA 26+00.00 - STA 42+00.00 EDGE LINE LT & RT

646.412 DURABLE 4 INCH YELLOW LINE, THERMOPLASTIC
 (ALL LINES WILL INCLUDE C/L BREAKS FOR TOWN HIGHWAYS) S=SOLID, D=DASHED
 WALTHAM:
 STA 26+00.00 - STA. 40+65.00 LT S C RT S
 STA 40+65.00 - STA. 42+00.00 S - D
 STA 27+82.56 DOUBLE SOLID LT, TH-5
 STA 27+82.56 DOUBLE SOLID RT, TH-5

646.612 TEMPORARY 4 INCH YELLOW LINE, PAINT
 (ALL LINES WILL INCLUDE C/L BREAKS FOR TOWN HIGHWAYS) S=SOLID, D=DASHED
 WALTHAM:
 STA 26+00.00 - STA. 40+65.00 LT S C RT S
 STA 40+65.00 - STA. 42+00.00 S - D
 STA 27+82.56 DOUBLE SOLID LT, TH-5
 STA 27+82.56 DOUBLE SOLID RT, TH-5

646.482 DURABLE 24 INCH STOP BAR, THERMOPLASTIC
 WALTHAM:
 STA 27+82.56 LT, TH-5
 STA 27+82.56 RT, TH-5


646.492 DURABLE LETTER OR SYMBOL, THERMOPLASTIC
 WALTHAM:
 STA 27+82.56 LT, TH-5 "S,T,O,P" (4 EA)
 STA 27+82.56 RT, TH-5 "S,T,O,P" (4 EA)

646.682 TEMPORARY 24 INCH STOP BAR, PAINT
 WALTHAM:
 STA 27+82.56 LT, TH-5
 STA 27+82.56 RT, TH-5

646.692 TEMPORARY LETTER OR SYMBOL, PAINT
 WALTHAM:
 STA 27+82.56 LT, TH-5 "S,T,O,P" (4 EA)
 STA 27+82.56 RT, TH-5 "S,T,O,P" (4 EA)

675.50 REMOVING SIGNS
 AS SHOWN - 10

675.60 ERECTING SALVAGED SIGNS
 AS SHOWN - 4

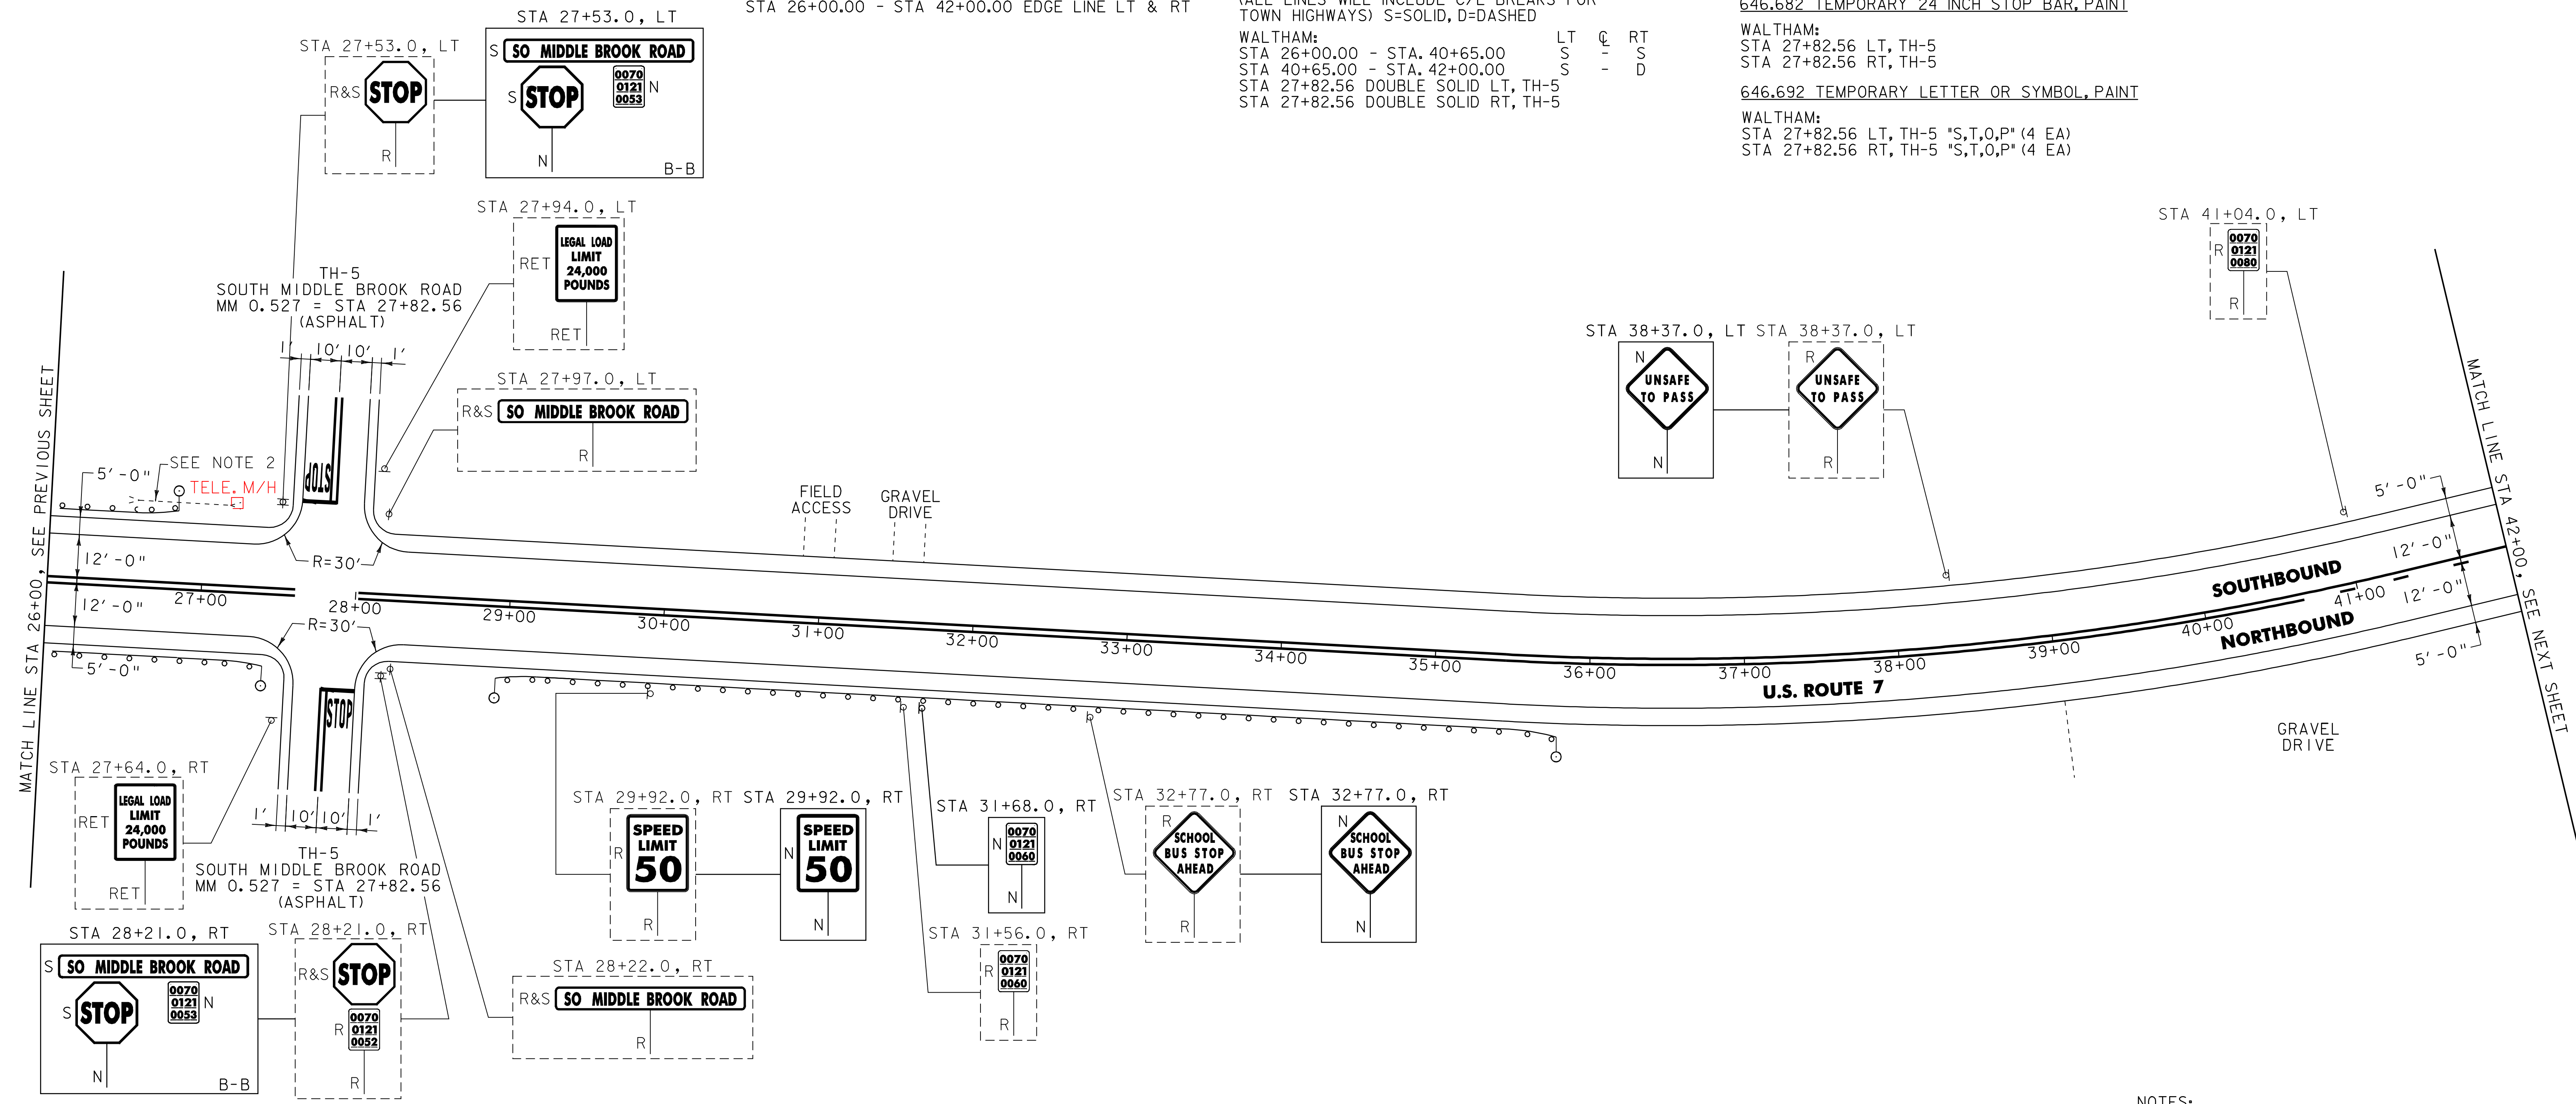

MATCH LINE STA 26+00, SEE PREVIOUS SHEET

MATCH LINE STA 42+00, SEE NEXT SHEET

621.20 STEEL BEAM GUARDRAIL, GALVANIZED
 WALTHAM:
 STA 26+00.0 - STA 26+56.5 LT (56.5 LF)
 STA 26+00.0 - STA 27+22.5 RT (122.5 LF)
 STA 29+30.5 - STA 35+43.0 RT (612.5 LF)

621.50 MANUFACTURED TERMINAL SECTION, FLARED
 WALTHAM:
 STA 26+56.5 - STA 26+94.0 LT
 STA 27+22.5 - STA 27+60.0 RT
 STA 28+93.0 - STA 29+30.5 RT
 STA 35+43.0 - STA 35+80.5 RT

621.80 REMOVAL AND DISPOSAL OF GUARDRAIL
 WALTHAM:
 STA 26+00.0 - STA 26+83.0 RT (83.0 LF) LT
 STA 26+00.0 - STA ~~27+57.0~~ LT (157.0 LF) RT
 STA 28+93.0 - STA 35+16.0 RT (623.0 LF)

676.10 DELINEATOR WITH STEEL POST
 ♀ TYPE I WHITE
 WALTHAM:
 STA 26+94.0 LT
 STA 27+60.0 RT
 STA 28+93.0 RT
 STA 35+80.5 RT

SIGN LEGEND
 R = REMOVE
 S = SALVAGE
 N = NEW
 RET = RETAIN
 B-B = BACK TO BACK
 EXISTING = - - - - -
 NEW = _____

NOT TO SCALE

PROJECT LAYOUT SHEET #8

PROJECT NAME: NEW HAVEN - FERRISBURGH
 PROJECT NUMBER: NH_2503(I)S

FILE NAME: Q5bQ38.dgn PLOT DATE: 31-JUL-2009 15
 PROJECT LEADER: D.E.G. DRAWN BY: C.A.K.
 DESIGNED BY: M.J.M. CHECKED BY: D.W.E.
 IPARM FILE: p05b038108.i SHEET 21 OF 87

NOTES:
 1. PAVING LIMIT ON ALL TOWN HIGHWAYS SHALL BE MEASURED 25 FT BACK FROM U.S. ROUTE 7 EDGE OF SHOULDER UNLESS DENOTED OTHERWISE ON THE PLANS OR AS DIRECTED BY THE RESIDENT ENGINEER.
 2. SEE SHEET 86 FOR FLARED END SECTION WITH CULVERT PIPE DETAIL.