

646.402 DURABLE 4 INCH WHITE LINE, THERMOPLASTIC  
 (ALL LINES WILL INCLUDE EDGE LINE BREAKS AND  
 RADIUS FOR TOWN HIGHWAYS)

WALTHAM:  
 STA 42+00.00 - STA 58+00.00 EDGE LINE LT & RT

646.602 TEMPORARY 4 INCH WHITE LINE, PAINT  
 (ALL LINES WILL INCLUDE EDGE LINE BREAKS AND  
 RADIUS FOR TOWN HIGHWAYS)

WALTHAM:  
 STA 42+00.00 - STA 58+00.00 EDGE LINE LT & RT


646.412 DURABLE 4 INCH YELLOW LINE, THERMOPLASTIC  
 (ALL LINES WILL INCLUDE C/L BREAKS FOR  
 TOWN HIGHWAYS) S=SOLID, D=DASHED

WALTHAM:  
 STA 42+00.00 - STA 46+65.00 S - D  
 STA 46+65.00 - STA 58+00.00 S - S

646.612 TEMPORARY 4 INCH YELLOW LINE, PAINT  
 (ALL LINES WILL INCLUDE C/L BREAKS FOR  
 TOWN HIGHWAYS) S=SOLID, D=DASHED

WALTHAM:  
 STA 42+00.00 - STA 46+65.00 S - D  
 STA 46+65.00 - STA 58+00.00 S - S

675.50 REMOVING SIGNS  
 AS SHOWN - 2

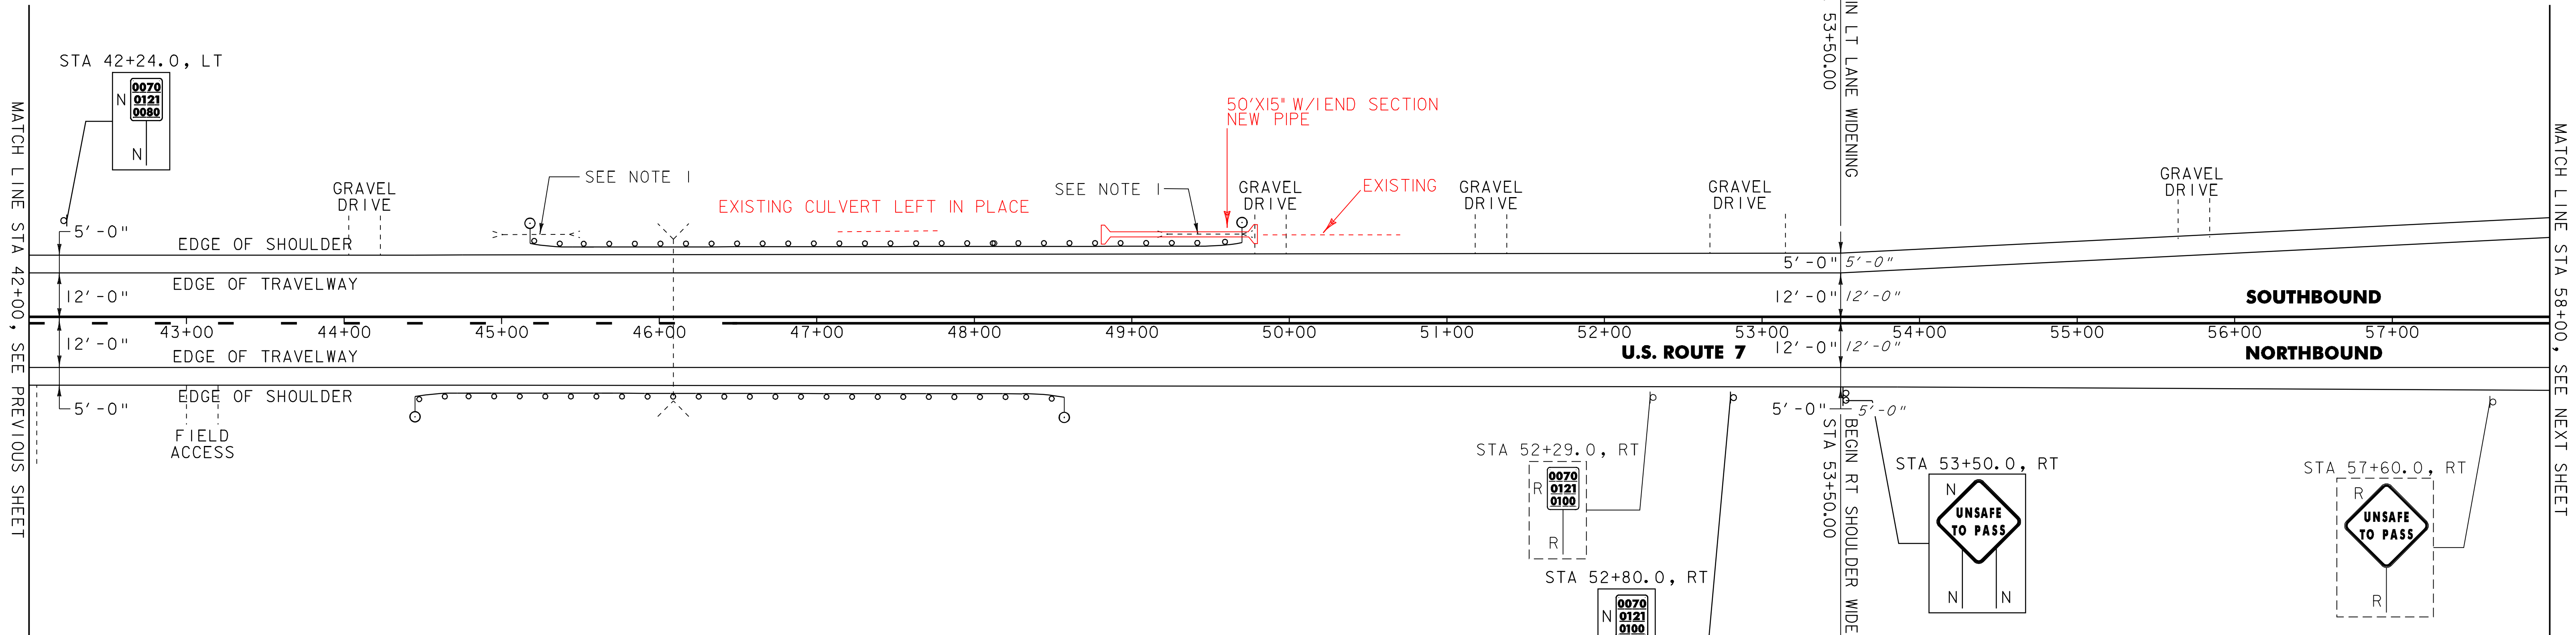

613.10 STONE FILL, TYPE I

WALTHAM:  
 STA 46+70.0 LT (2.0 CY)

621.20 STEEL BEAM GUARDRAIL, GALVANIZED

WALTHAM:  
 STA 44+82.5 - STA 48+20.0 RT (337.5 LF)  
 STA 45+45.0 - STA 49+32.5 LT (387.5 LF)

621.50 MANUFACTURED TERMINAL SECTION, FLARED

WALTHAM:  
 STA 44+45.0 - STA 44+82.5 RT  
 STA 45+07.5 - STA 45+45.0 LT  
 STA 48+20.0 - STA 48+57.5 RT  
 STA 49+32.5 - STA 49+70.0 LT

621.80 REMOVAL AND DISPOSAL OF GUARDRAIL

WALTHAM:  
 STA 45+18.0 - STA 48+40.0 LT (322.0 LF)  
 STA 45+37.0 - STA 48+40.0 RT (303.0 LF)

676.10 DELINEATOR WITH STEEL POST  
 ♀ TYPE I WHITE

WALTHAM:  
 STA 44+45.0 RT  
 STA 45+07.5 LT  
 STA 48+57.5 RT  
 STA 49+70.0 LT

SIGN LEGEND  
 R = REMOVE  
 S = SALVAGE  
 N = NEW  
 RET = RETAIN  
 B-B = BACK TO BACK  
 EXISTING = - - - - -  
 NEW = \_\_\_\_\_

NOTE:

I. SEE SHEET 86 FOR FLARED END SECTION  
 WITH CULVERT PIPE DETAIL.

NOT TO SCALE

**PROJECT  
 LAYOUT  
 SHEET #9**

PROJECT NAME: NEW\_HAVEN\_-\_FERRISBURGH  
 PROJECT NUMBER: NH\_2503(I)S

FILE NAME: Q5b038.dgn\_ PLOT DATE: 31-JUL-2009 15  
 PROJECT LEADER: D.E.G. DRAWN BY: C.A.K.  
 DESIGNED BY: M.J.M. CHECKED BY: D.W.E.  
 IPARM FILE: p05b038109.i SHEET 22 OF 87