


646.402 DURABLE 4 INCH WHITE LINE, THERMOPLASTIC
 (ALL LINES WILL INCLUDE EDGE LINE BREAKS AND RADIUS FOR TOWN HIGHWAYS)
 WALTHAM:
 STA 58+00.00 - STA 74+00.00 EDGE LINE LT & RT
 STA 65+37.50 - STA 74+00.00 DASHED LANE LINE LT

646.602 TEMPORARY 4 INCH WHITE LINE, PAINT
 (ALL LINES WILL INCLUDE EDGE LINE BREAKS AND RADIUS FOR TOWN HIGHWAYS)
 WALTHAM:
 STA 58+00.00 - STA 74+00.00 EDGE LINE LT & RT
 STA 65+37.50 - STA 74+00.00 DASHED LANE LINE LT

646.412 DURABLE 4 INCH YELLOW LINE, THERMOPLASTIC
 (ALL LINES WILL INCLUDE C/L BREAKS FOR TOWN HIGHWAYS) S=SOLID, D=DASHED
 WALTHAM:
 STA 58+00.00 - STA 74+00.00 LT C RT S - S

646.612 TEMPORARY 4 INCH YELLOW LINE, PAINT
 (ALL LINES WILL INCLUDE C/L BREAKS FOR TOWN HIGHWAYS) S=SOLID, D=DASHED
 WALTHAM:
 STA 58+00.00 - STA 74+00.00 LT C RT S - S

675.50 REMOVING SIGNS
 AS SHOWN - 4

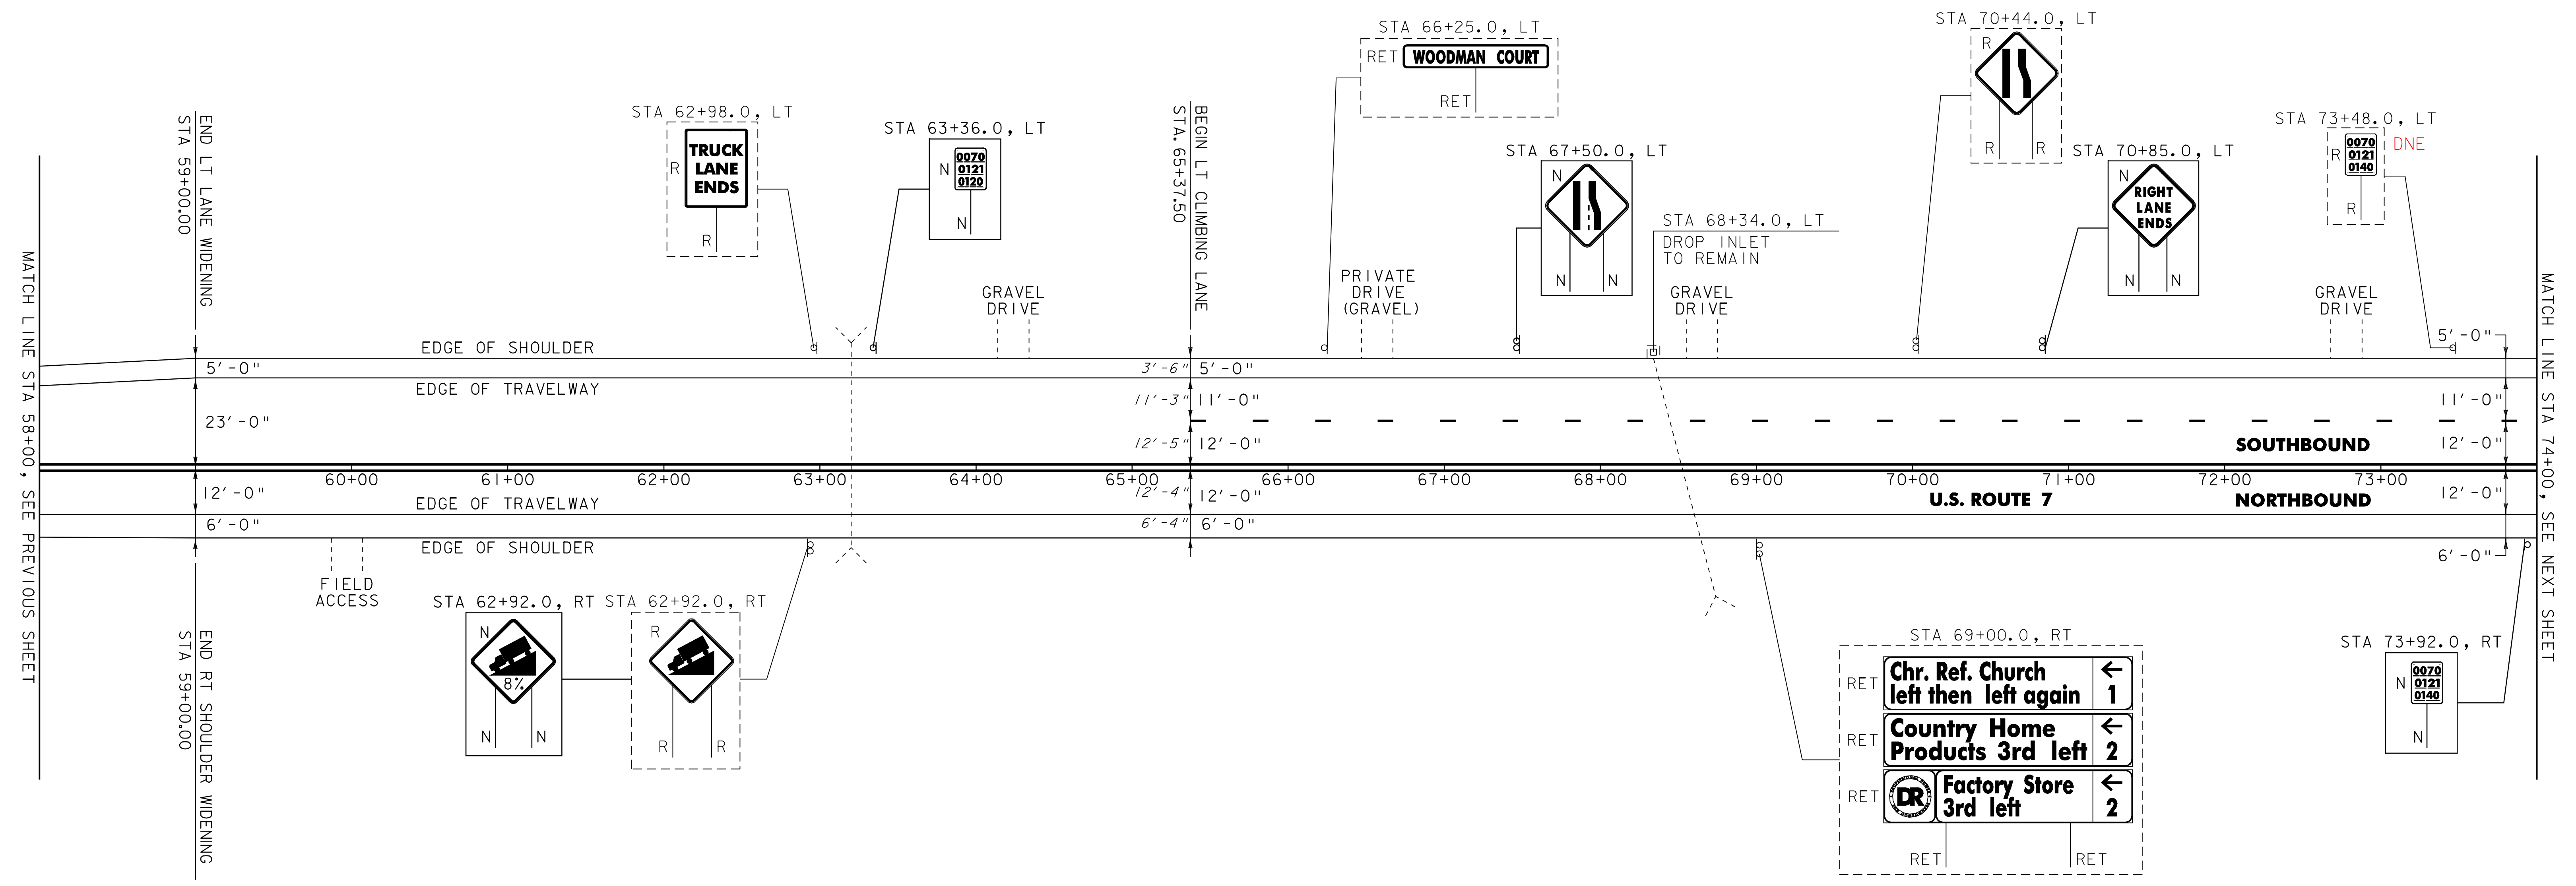

MATCH LINE STA 58+00, SEE PREVIOUS SHEET

MATCH LINE STA 74+00, SEE NEXT SHEET

SIGN LEGEND
 R = REMOVE
 S = SALVAGE
 N = NEW
 RET = RETAIN
 B-B = BACK TO BACK
 EXISTING = - - - - -
 NEW = _____

NOT TO SCALE
PROJECT LAYOUT SHEET #10

PROJECT NAME: NEW_HAVEN_-_FERRISBURGH
 PROJECT NUMBER: NH_2503(1)S
 FILE NAME: Q5b038.dgn
 PROJECT LEADER: D.E.G.
 DESIGNED BY: M.J.M.
 IPARM FILE: p05b038110.i
 PLOT DATE: 31-JUL-2009 15
 DRAWN BY: C.A.K.
 CHECKED BY: D.W.E.
 SHEET 23 OF 87