


646.402 DURABLE 4 INCH WHITE LINE, THERMOPLASTIC
 (ALL LINES WILL INCLUDE EDGE LINE BREAKS AND RADIUS FOR TOWN HIGHWAYS)
 FERRISBURGH:
 STA 51+00.00 - STA 67+00.00 EDGE LINE LT & RT
 646.602 TEMPORARY 4 INCH WHITE LINE, PAINT
 (ALL LINES WILL INCLUDE EDGE LINE BREAKS AND RADIUS FOR TOWN HIGHWAYS)
 FERRISBURGH:
 STA 51+00.00 - STA 67+00.00 EDGE LINE LT & RT

646.412 DURABLE 4 INCH YELLOW LINE, THERMOPLASTIC
 (ALL LINES WILL INCLUDE C/L BREAKS FOR TOWN HIGHWAYS) S=SOLID, D=DASHED
 FERRISBURGH:
 STA 51+00.00 - STA 51+69.00 S - C - RT
 STA 51+69.00 - STA 66+00.00 - D - D
 STA 66+00.00 - STA 67+00.00 D - - S
 646.612 TEMPORARY 4 INCH YELLOW LINE, PAINT
 (ALL LINES WILL INCLUDE C/L BREAKS FOR TOWN HIGHWAYS) S=SOLID, D=DASHED
 FERRISBURGH:
 STA 51+00.00 - STA 51+69.00 S - C - RT
 STA 51+69.00 - STA 66+00.00 - D - D -
 STA 66+00.00 - STA 67+00.00 D - - S

675.50 REMOVING SIGNS
 AS SHOWN - 2

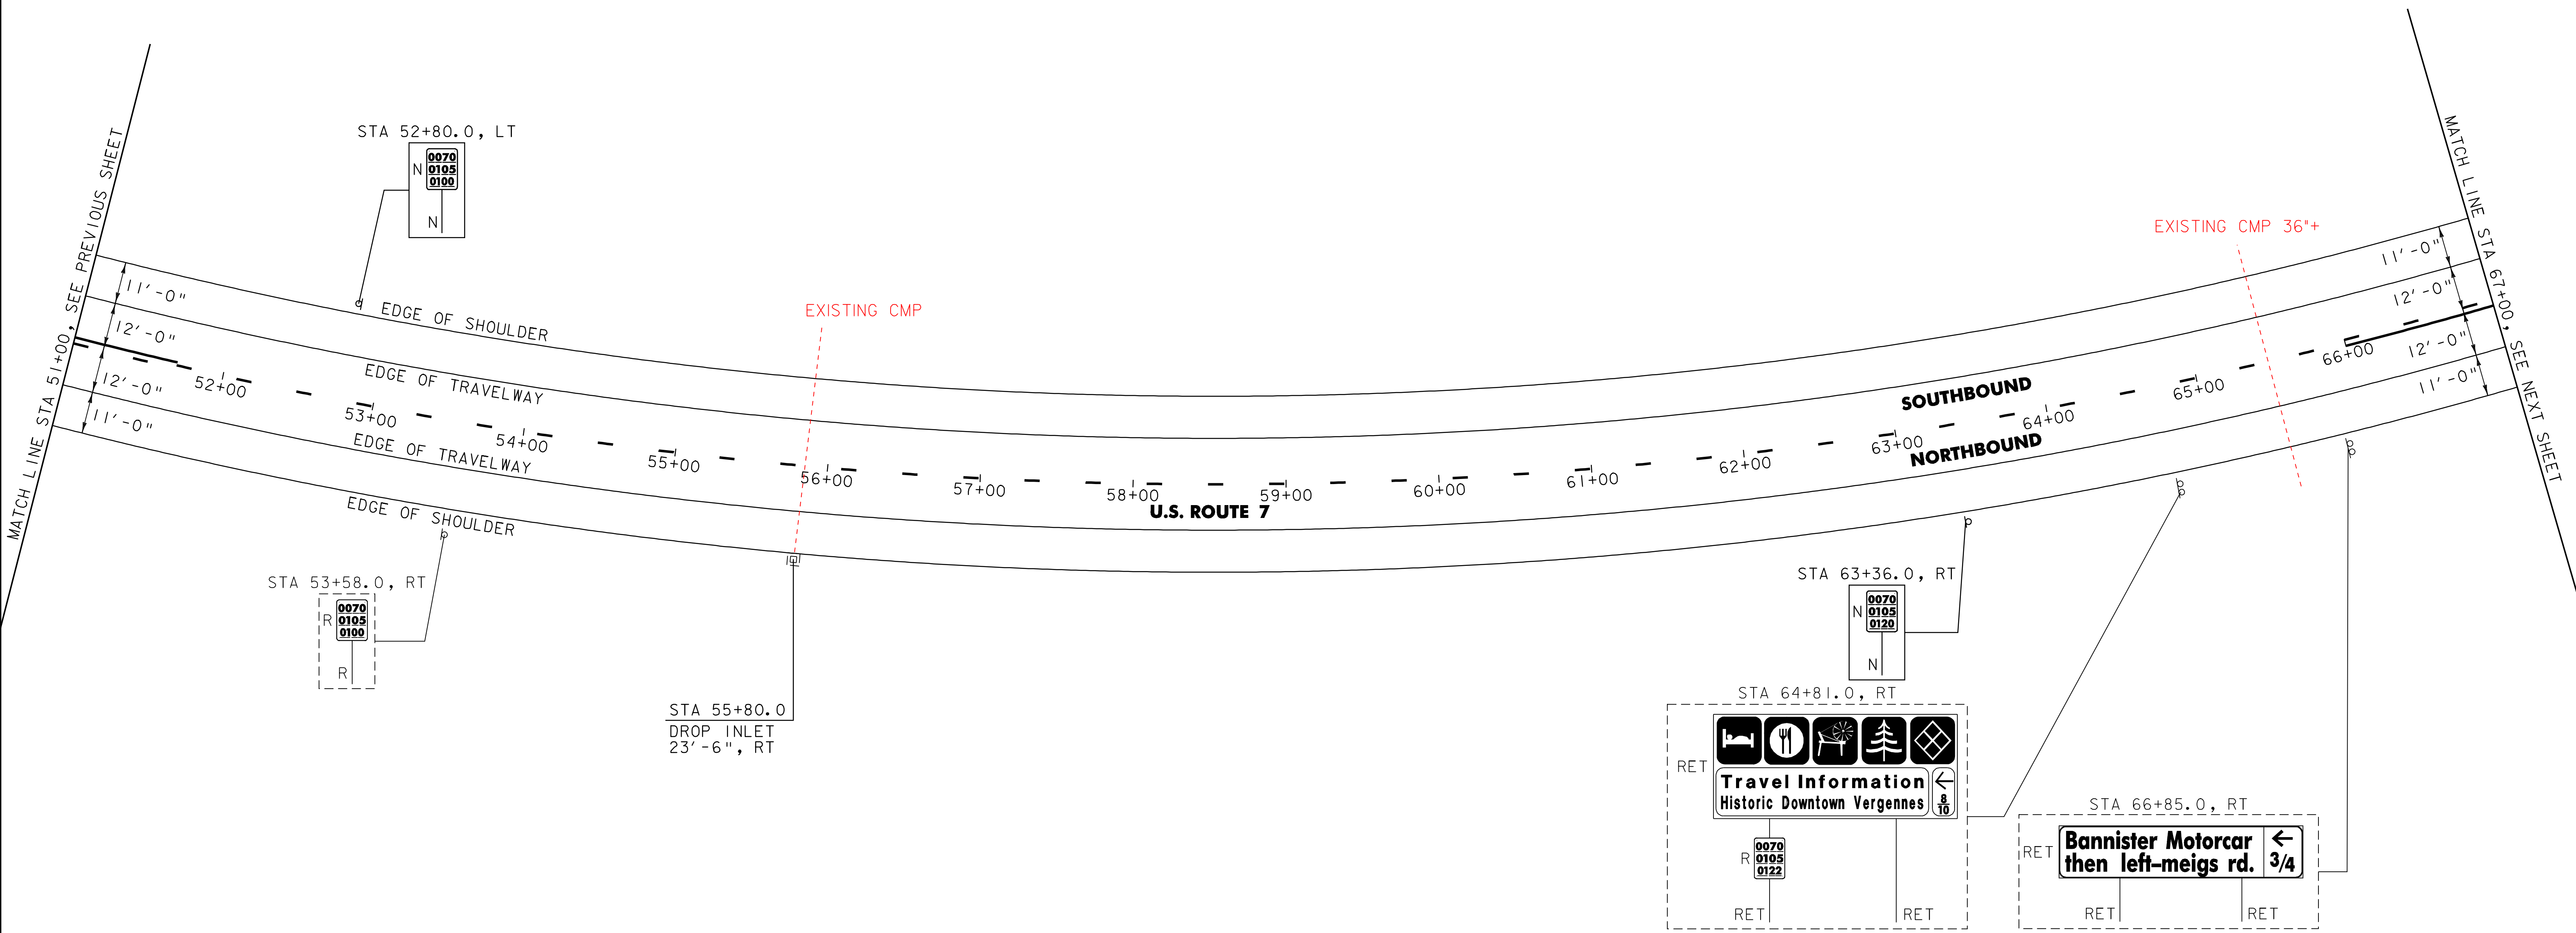

604.412 REHAB. DROP INLETS, CATCH BASINS, OR MANHOLES, CLASS I
 FERRISBURGH:
 STA 55+80.0 RT

SIGN LEGEND
 R = REMOVE
 S = SALVAGE
 N = NEW
 RET = RETAIN
 B-B = BACK TO BACK
 EXISTING = - - - - -
 NEW = _____

NOT TO SCALE
PROJECT LAYOUT SHEET #15

PROJECT NAME: NEW_HAVEN_-_FERRISBURGH
 PROJECT NUMBER: NH_2503(I)S
 FILE NAME: Q5b038.dgn PLOT DATE: 31-JUL-2009 15
 PROJECT LEADER: D.E.G. DRAWN BY: C.A.K.
 DESIGNED BY: M.J.M. CHECKED BY: D.W.E.
 IPARM FILE: Q05b038115.i SHEET 28 OF 87