

646.402 DURABLE 4 INCH WHITE LINE, THERMOPLASTIC
 (ALL LINES WILL INCLUDE EDGE LINE BREAKS AND RADIUS FOR TOWN HIGHWAYS)

FERRISBURGH:
 STA 67+00.00 - STA 83+00.00 EDGE LINE LT & RT
 STA 76+00.00 - STA 77+80.00 DOTTED LANE LINE RT
 STA 77+80.00 - STA 79+35.00 SOLID LANE LINE LT
 STA 80+04.48 SOLID LANE LINE LT, VT. ROUTE 22A
 STA 80+04.48 SOLID EDGE LINE LT, VT. ROUTE 22A
 STA 82+55.00 - STA 83+00.00 SOLID LANE LINE LT

646.602 TEMPORARY 4 INCH WHITE LINE, PAINT
 (ALL LINES WILL INCLUDE EDGE LINE BREAKS AND RADIUS FOR TOWN HIGHWAYS)

FERRISBURGH:
 STA 67+00.00 - STA 83+00.00 EDGE LINE LT & RT
 STA 76+00.00 - STA 77+80.00 DOTTED LANE LINE RT
 STA 77+80.00 - STA 79+35.00 SOLID LANE LINE LT
 STA 80+04.48 SOLID LANE LINE LT, VT. ROUTE 22A
 STA 80+04.48 SOLID EDGE LINE LT, VT. ROUTE 22A
 STA 82+55.00 - STA 83+00.00 SOLID LANE LINE LT

646.442 DURABLE 8 INCH WHITE LINE, THERMOPLASTIC

FERRISBURGH:
 STA 81+40.00 - STA 82+55.00 GORE AREA LT

646.412 DURABLE 4 INCH YELLOW LINE, THERMOPLASTIC
 (ALL LINES WILL INCLUDE C/L BREAKS FOR TOWN HIGHWAYS) S=SOLID, D=DASHED

FERRISBURGH:
 STA 67+00.00 - STA 70+00.00 D S
 STA 70+00.00 - STA 77+00.00 DOUBLE SOLID MEDIAN CL & RT
 STA 77+14.08 DOUBLE SOLID RT, TH-45
 STA 77+40.00 - STA 79+35.00 DOUBLE SOLID MEDIAN CL & RT
 STA 80+04.48 DOUBLE SOLID MEDIAN LT, VT. ROUTE 22A
 STA 80+55.00 - STA 83+00.00 DOUBLE SOLID MEDIAN CL & RT

646.612 TEMPORARY 4 INCH YELLOW LINE, PAINT
 (ALL LINES WILL INCLUDE C/L BREAKS FOR TOWN HIGHWAYS) S=SOLID, D=DASHED

FERRISBURGH:
 STA 67+00.00 - STA 70+00.00 D S
 STA 70+00.00 - STA 77+00.00 DOUBLE SOLID MEDIAN CL & RT
 STA 77+14.08 DOUBLE SOLID RT, TH-45
 STA 77+40.00 - STA 79+35.00 DOUBLE SOLID MEDIAN CL & RT
 STA 80+04.48 DOUBLE SOLID MEDIAN LT, VT. ROUTE 22A
 STA 80+55.00 - STA 83+00.00 DOUBLE SOLID MEDIAN CL & RT

646.452 DURABLE 8 INCH YELLOW LINE, THERMOPLASTIC

FERRISBURGH:
 STA 70+00.00 - STA 77+00.00 HATCHED MEDIAN RT
 STA 77+40.00 - STA 79+35.00 HATCHED MEDIAN RT
 STA 80+55.00 - STA 83+00.00 HATCHED MEDIAN RT
 STA 80+04.48 HATCHED MEDIAN LT, VT. ROUTE 22A

646.492 DURABLE LETTER OR SYMBOL, THERMOPLASTIC

FERRISBURGH:
 STA 71+60.0 RT, "S,I,G,N,A,L" (6 EA)
 STA 71+92.0 RT, "A,H,E,A,D" (5 EA)
 STA 77+14.08 RT, TH-45 "S,T,O,P" (4 EA)
 STA 77+84.3 RT, ARROW (1EA)
 STA 78+57.5 RT, "O,N,L,Y" (4 EA)
 STA 79+26.8 RT, ARROW (1EA)
 STA 80+04.48 LT, "O,N,L,Y" (4 EA)
 STA 80+04.48 LT, "O,N,L,Y" (4 EA)
 STA 80+04.48 LT, ARROW (1EA)
 STA 80+04.48 LT, ARROW (1EA)
 STA 80+50.0 LT, YIELD LINE (4 EA)
 STA 81+59.0 LT, "A,H,E,A,D" (5 EA)
 STA 81+91.0 LT, "Y,I,E,L,D" (5 EA)
 STA 82+07.8 LT, ARROW (1EA)
 STA 82+95.3 LT, "O,N,L,Y" (4 EA)

646.692 DURABLE LETTER OR SYMBOL, PAINT

FERRISBURGH:
 STA 71+60.0 RT, "S,I,G,N,A,L" (6 EA)
 STA 71+92.0 RT, "A,H,E,A,D" (5 EA)
 STA 77+14.08 RT, TH-45 "S,T,O,P" (4 EA)
 STA 77+84.3 RT, ARROW (2 EA)
 STA 79+26.8 RT, ARROW (2 EA)
 STA 80+04.48 LT, ARROW (2 EA)
 STA 80+04.48 LT, ARROW (2 EA)
 STA 80+50.0 LT, YIELD LINE (4 EA)
 STA 81+59.0 LT, "A,H,E,A,D" (5 EA)
 STA 81+91.0 LT, "Y,I,E,L,D" (5 EA)
 STA 82+07.8 LT, ARROW (1EA)

646.482 DURABLE 24 INCH STOP BAR, THERMOPLASTIC

FERRISBURGH:
 STA 77+14.08 RT, TH-45
 STA 79+36.00 RT
 STA 80+04.48 LT, VT. ROUTE 22A
 STA 80+62.00 LT

675.50 REMOVING SIGNS
 AS SHOWN - 37


675.60 ERECTING SALVAGED SIGNS
 AS SHOWN - 1

646.682 TEMPORARY 24 INCH STOP BAR, PAINT

FERRISBURGH:
 STA 77+14.08 RT, TH-45
 STA 79+36.00 RT
 STA 80+04.48 LT, VT. ROUTE 22A
 STA 80+62.00 LT

646.81 PAINTED CURB

FERRISBURGH:
 STA 80+30.00 - STA 81+40.0 LT (425.0 LF)

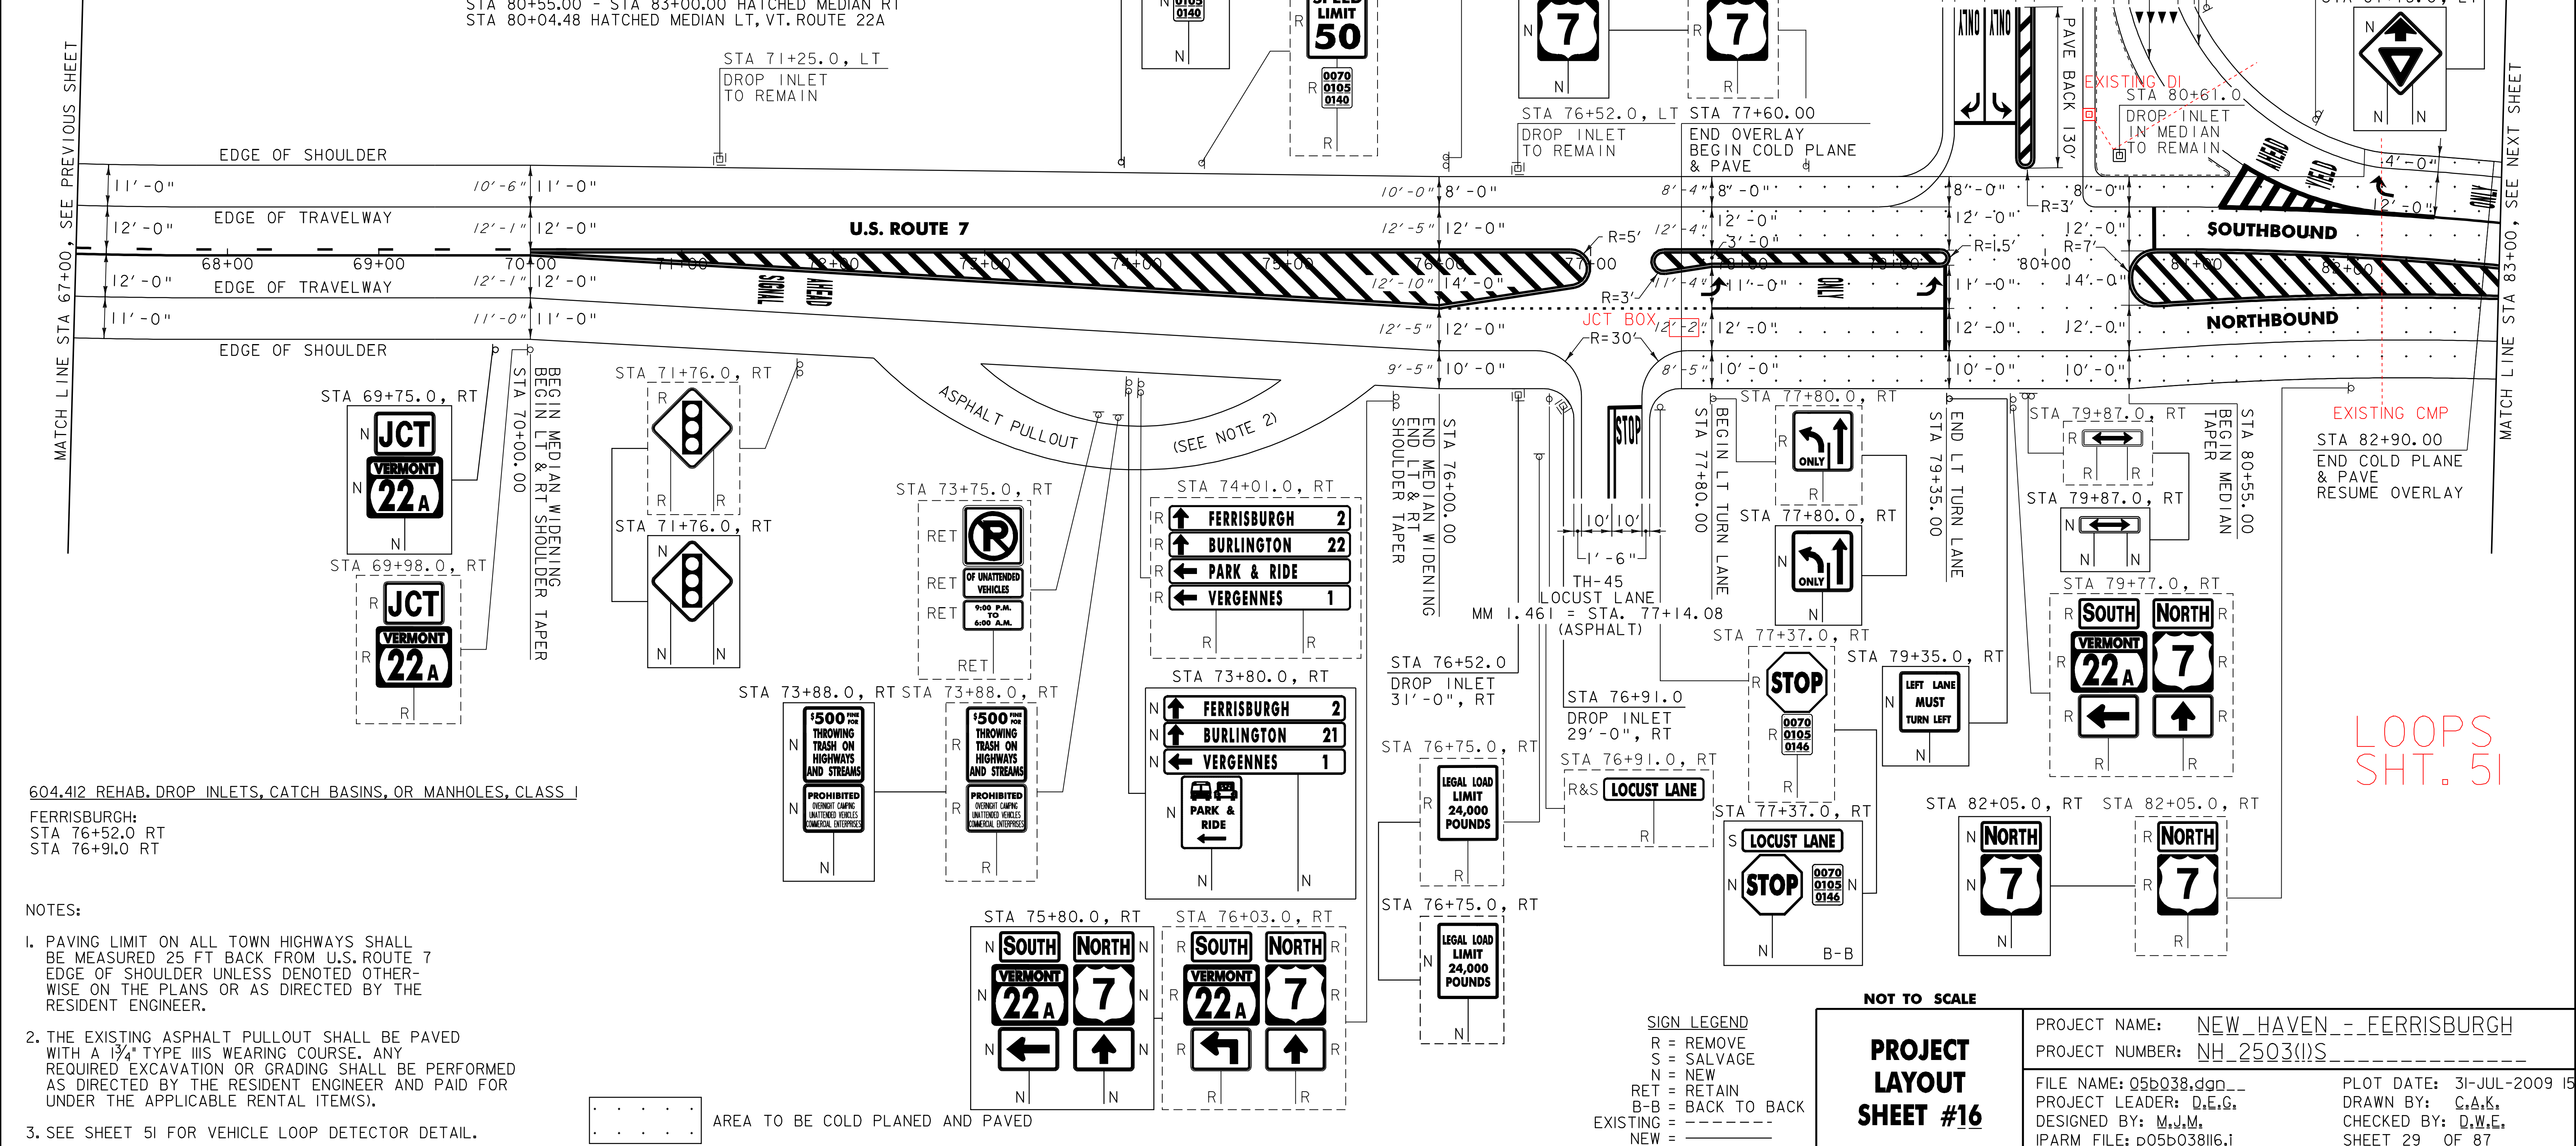

MATCH LINE STA 67+00, SEE PREVIOUS SHEET

MATCH LINE STA 83+00, SEE NEXT SHEET

604.412 REHAB. DROP INLETS, CATCH BASINS, OR MANHOLES, CLASS I

FERRISBURGH:
 STA 76+52.0 RT
 STA 76+91.0 RT

- NOTES:
1. PAVING LIMIT ON ALL TOWN HIGHWAYS SHALL BE MEASURED 25 FT BACK FROM U.S. ROUTE 7 EDGE OF SHOULDER UNLESS DENOTED OTHERWISE ON THE PLANS OR AS DIRECTED BY THE RESIDENT ENGINEER.
 2. THE EXISTING ASPHALT PULLOUT SHALL BE PAVED WITH A 1 3/4" TYPE III WEARING COURSE. ANY REQUIRED EXCAVATION OR GRADING SHALL BE PERFORMED AS DIRECTED BY THE RESIDENT ENGINEER AND PAID FOR UNDER THE APPLICABLE RENTAL ITEM(S).
 3. SEE SHEET 51 FOR VEHICLE LOOP DETECTOR DETAIL.

..... AREA TO BE COLD PLANNED AND PAVED

SIGN LEGEND
 R = REMOVE
 S = SALVAGE
 N = NEW
 RET = RETAIN
 B-B = BACK TO BACK
 EXISTING = - - - - -
 NEW = _____

NOT TO SCALE
PROJECT LAYOUT SHEET #16

PROJECT NAME: NEW_HAVEN_-_FERRISBURGH
 PROJECT NUMBER: NH_2503(1)S
 FILE NAME: Q5b038.dgn
 PROJECT LEADER: D.E.G.
 DESIGNED BY: M.J.M.
 IPARM FILE: p05b038i16.i
 PLOT DATE: 31-JUL-2009 15
 DRAWN BY: C.A.K.
 CHECKED BY: D.W.E.
 SHEET 29 OF 87