

646.402 DURABLE 4 INCH WHITE LINE, THERMOPLASTIC
(ALL LINES WILL INCLUDE EDGE LINE BREAKS AND RADIUS FOR TOWN HIGHWAYS)

FERRISBURGH:
STA 99+00.00 - STA 115+00.00 EDGE LINE LT & RT

646.602 TEMPORARY 4 INCH WHITE LINE, PAINT
(ALL LINES WILL INCLUDE EDGE LINE BREAKS AND RADIUS FOR TOWN HIGHWAYS)

FERRISBURGH:
STA 99+00.00 - STA 115+00.00 EDGE LINE LT & RT

646.412 DURABLE 4 INCH YELLOW LINE, THERMOPLASTIC
(ALL LINES WILL INCLUDE C/L BREAKS FOR TOWN HIGHWAYS) S=SOLID, D=DASHED

FERRISBURGH:
STA 99+00.00 - STA 111+94.00 LT C RT
STA 99+00.00 - STA 111+94.00 S S
STA 111+94.00 - STA 115+00.00 S - D
STA 102+11.52 DOUBLE SOLID RT, TH-34
STA 106+70.88 DOUBLE SOLID LT, TH-31

646.612 TEMPORARY 4 INCH YELLOW LINE, PAINT
(ALL LINES WILL INCLUDE C/L BREAKS FOR TOWN HIGHWAYS) S=SOLID, D=DASHED

FERRISBURGH:
STA 99+00.00 - STA 111+94.00 LT C RT
STA 99+00.00 - STA 111+94.00 S S
STA 111+94.00 - STA 115+00.00 S - D
STA 102+11.52 DOUBLE SOLID RT, TH-34
STA 106+70.88 DOUBLE SOLID LT, TH-31

646.482 DURABLE 24 INCH STOP BAR, THERMOPLASTIC

FERRISBURGH:
STA 102+11.52 RT, TH-34
STA 106+70.88 LT, TH-31

646.492 DURABLE LETTER OR SYMBOL, THERMOPLASTIC

FERRISBURGH:
STA 102+11.52 RT, TH-34 "S,T,O,P" (4 EA)
STA 106+70.88 LT, TH-31 "S,T,O,P" (4 EA)

646.682 TEMPORARY 24 INCH STOP BAR, PAINT

FERRISBURGH:
STA 102+11.52 RT, TH-34
STA 106+70.88 LT, TH-31

646.692 TEMPORARY LETTER OR SYMBOL, PAINT


FERRISBURGH:
STA 102+11.52 RT, TH-34 "S,T,O,P" (4 EA)
STA 106+70.88 LT, TH-31 "S,T,O,P" (4 EA)

675.50 REMOVING SIGNS

AS SHOWN - 10

675.60 ERECTING SALVAGED SIGNS

AS SHOWN - 3

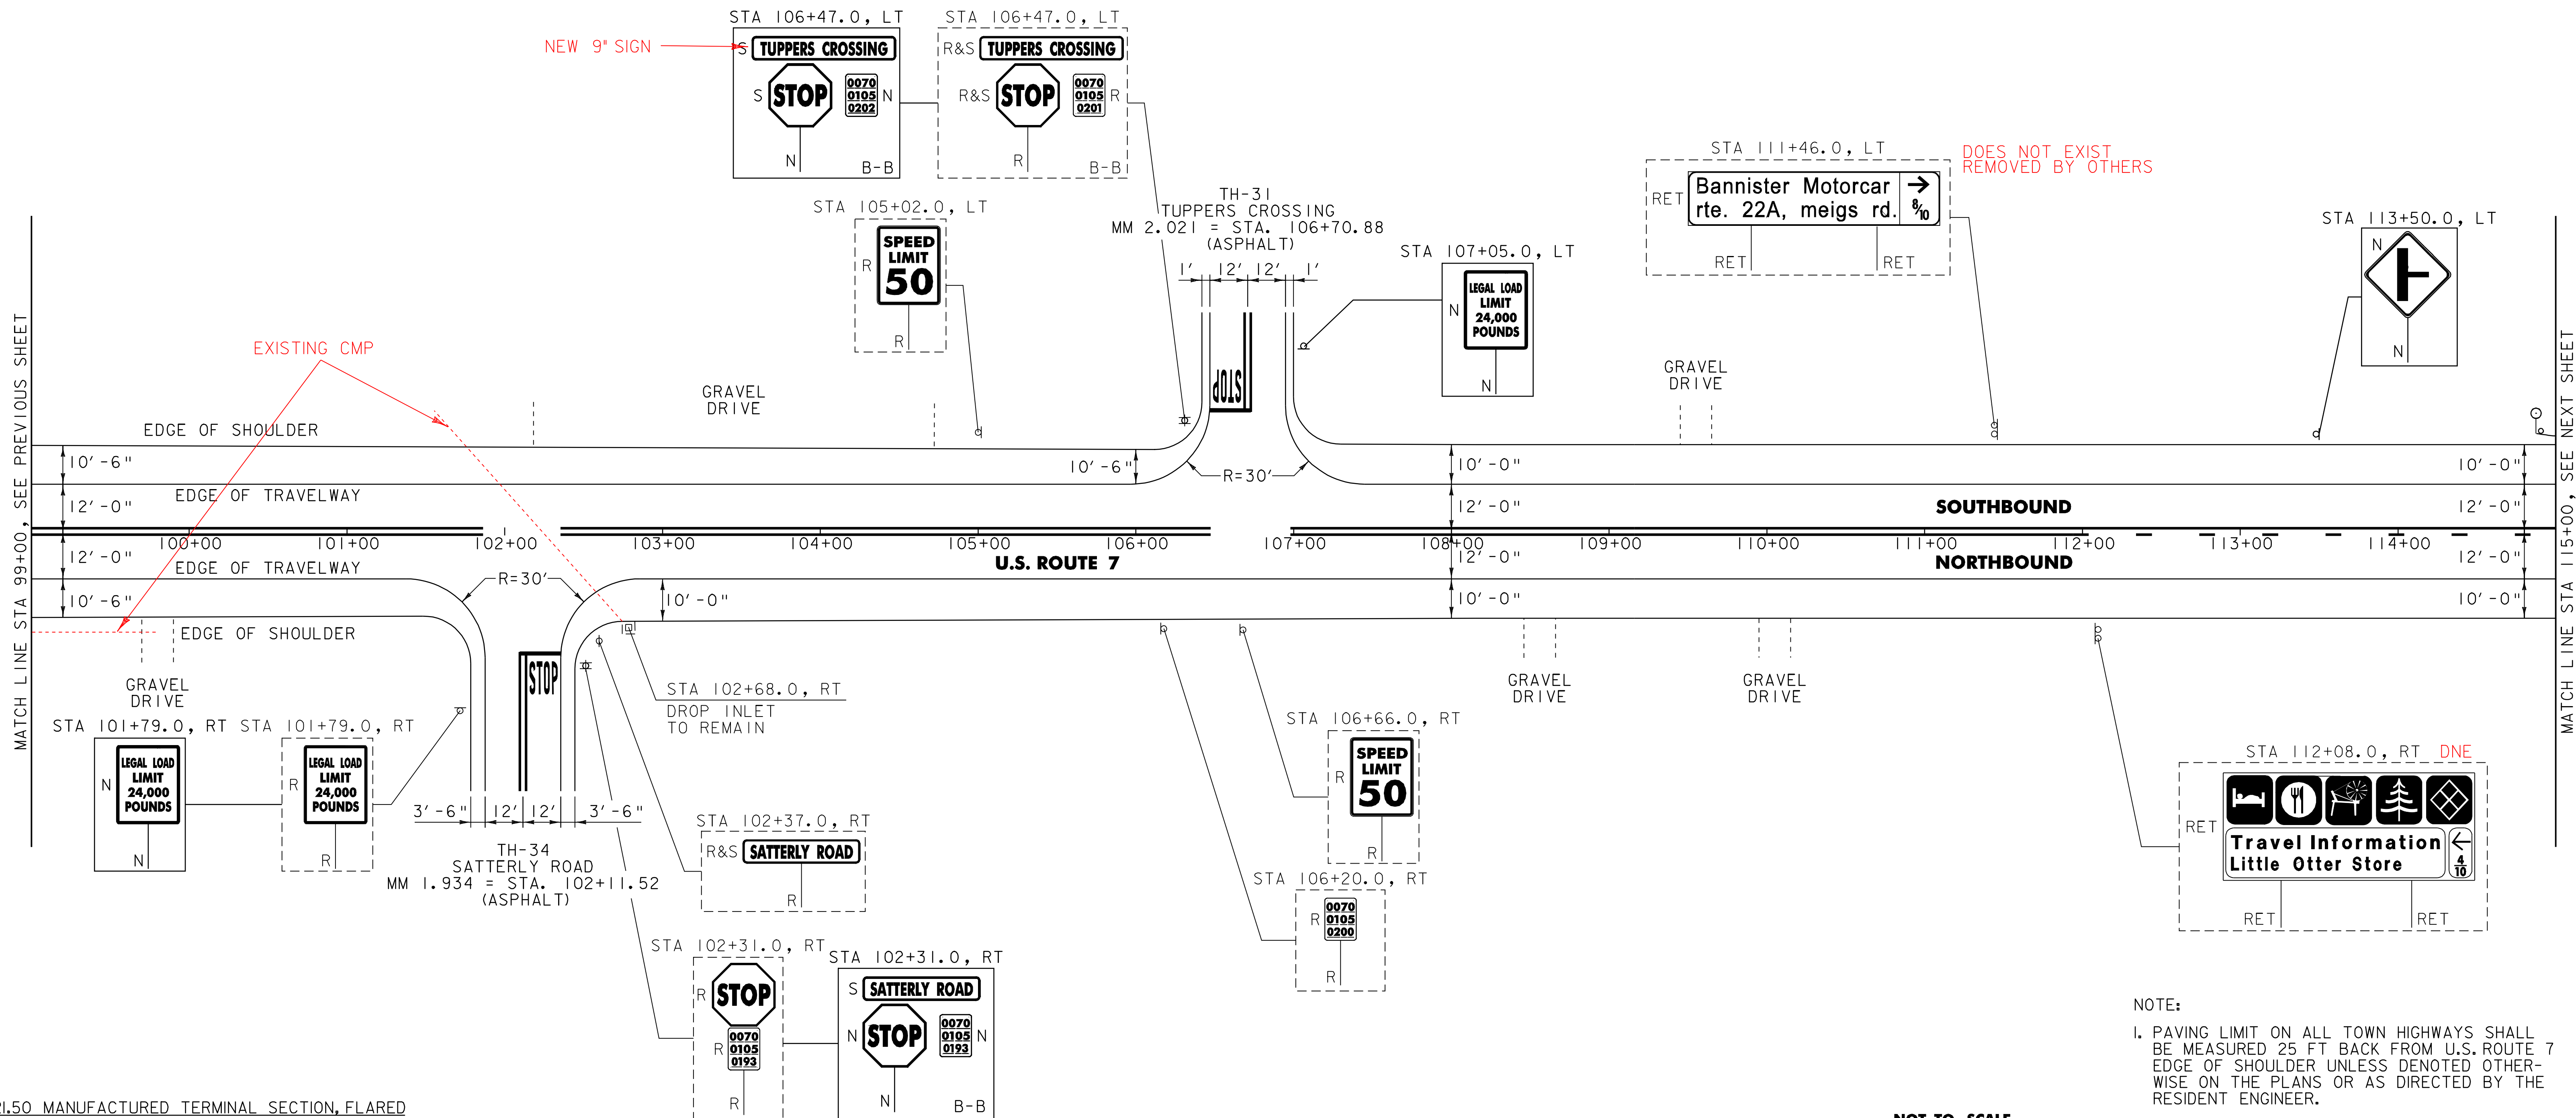

MATCH LINE STA 99+00, SEE PREVIOUS SHEET

MATCH LINE STA 115+00, SEE NEXT SHEET

621.50 MANUFACTURED TERMINAL SECTION, FLARED

FERRISBURGH:
STA 114+87.5 - STA 115+00.0 LT

676.10 DELINEATOR WITH STEEL POST

⊙ TYPE I WHITE

FERRISBURGH:
STA 114+87.5 LT

NOTE:
1. PAVING LIMIT ON ALL TOWN HIGHWAYS SHALL BE MEASURED 25 FT BACK FROM U.S. ROUTE 7 EDGE OF SHOULDER UNLESS DENOTED OTHERWISE ON THE PLANS OR AS DIRECTED BY THE RESIDENT ENGINEER.

SIGN LEGEND
R = REMOVE
S = SALVAGE
N = NEW
RET = RETAIN
B-B = BACK TO BACK
EXISTING = - - - - -
NEW = _____

NOT TO SCALE

PROJECT LAYOUT SHEET #18

PROJECT NAME: NEW_HAVEN_-_FERRISBURGH
PROJECT NUMBER: NH_2503(1)S
FILE NAME: Q5b038.dgn
PROJECT LEADER: D.E.G.
DESIGNED BY: M.J.M.
IPARM FILE: p05b038118.i
PLOT DATE: 31-JUL-2009 15
DRAWN BY: C.A.K.
CHECKED BY: D.W.E.
SHEET 31 OF 87