


646.402 DURABLE 4 INCH WHITE LINE, THERMOPLASTIC
 (ALL LINES WILL INCLUDE EDGE LINE BREAKS AND RADIUS FOR TOWN HIGHWAYS)
 FERRISBURGH:
 STA 131+00.00 - STA 147+00.00 EDGE LINE LT & RT
 646.602 TEMPORARY 4 INCH WHITE LINE, PAINT
 (ALL LINES WILL INCLUDE EDGE LINE BREAKS AND RADIUS FOR TOWN HIGHWAYS)
 FERRISBURGH:
 STA 131+00.00 - STA 147+00.00 EDGE LINE LT & RT

646.412 DURABLE 4 INCH YELLOW LINE, THERMOPLASTIC
 (ALL LINES WILL INCLUDE C/L BREAKS FOR TOWN HIGHWAYS) S=SOLID, D=DASHED
 FERRISBURGH:
 STA 131+00.00 - STA 135+17.00 LT @ RT
 STA 135+17.00 - STA 147+00.00 D - S
 S - S
 646.612 TEMPORARY 4 INCH YELLOW LINE, PAINT
 (ALL LINES WILL INCLUDE C/L BREAKS FOR TOWN HIGHWAYS) S=SOLID, D=DASHED
 FERRISBURGH:
 STA 131+00.00 - STA 135+17.00 LT @ RT
 STA 135+17.00 - STA 147+00.00 D - S
 S - S

675.50 REMOVING SIGNS
 AS SHOWN - 6
 675.60 ERECTING SALVAGED SIGNS
 AS SHOWN - 1

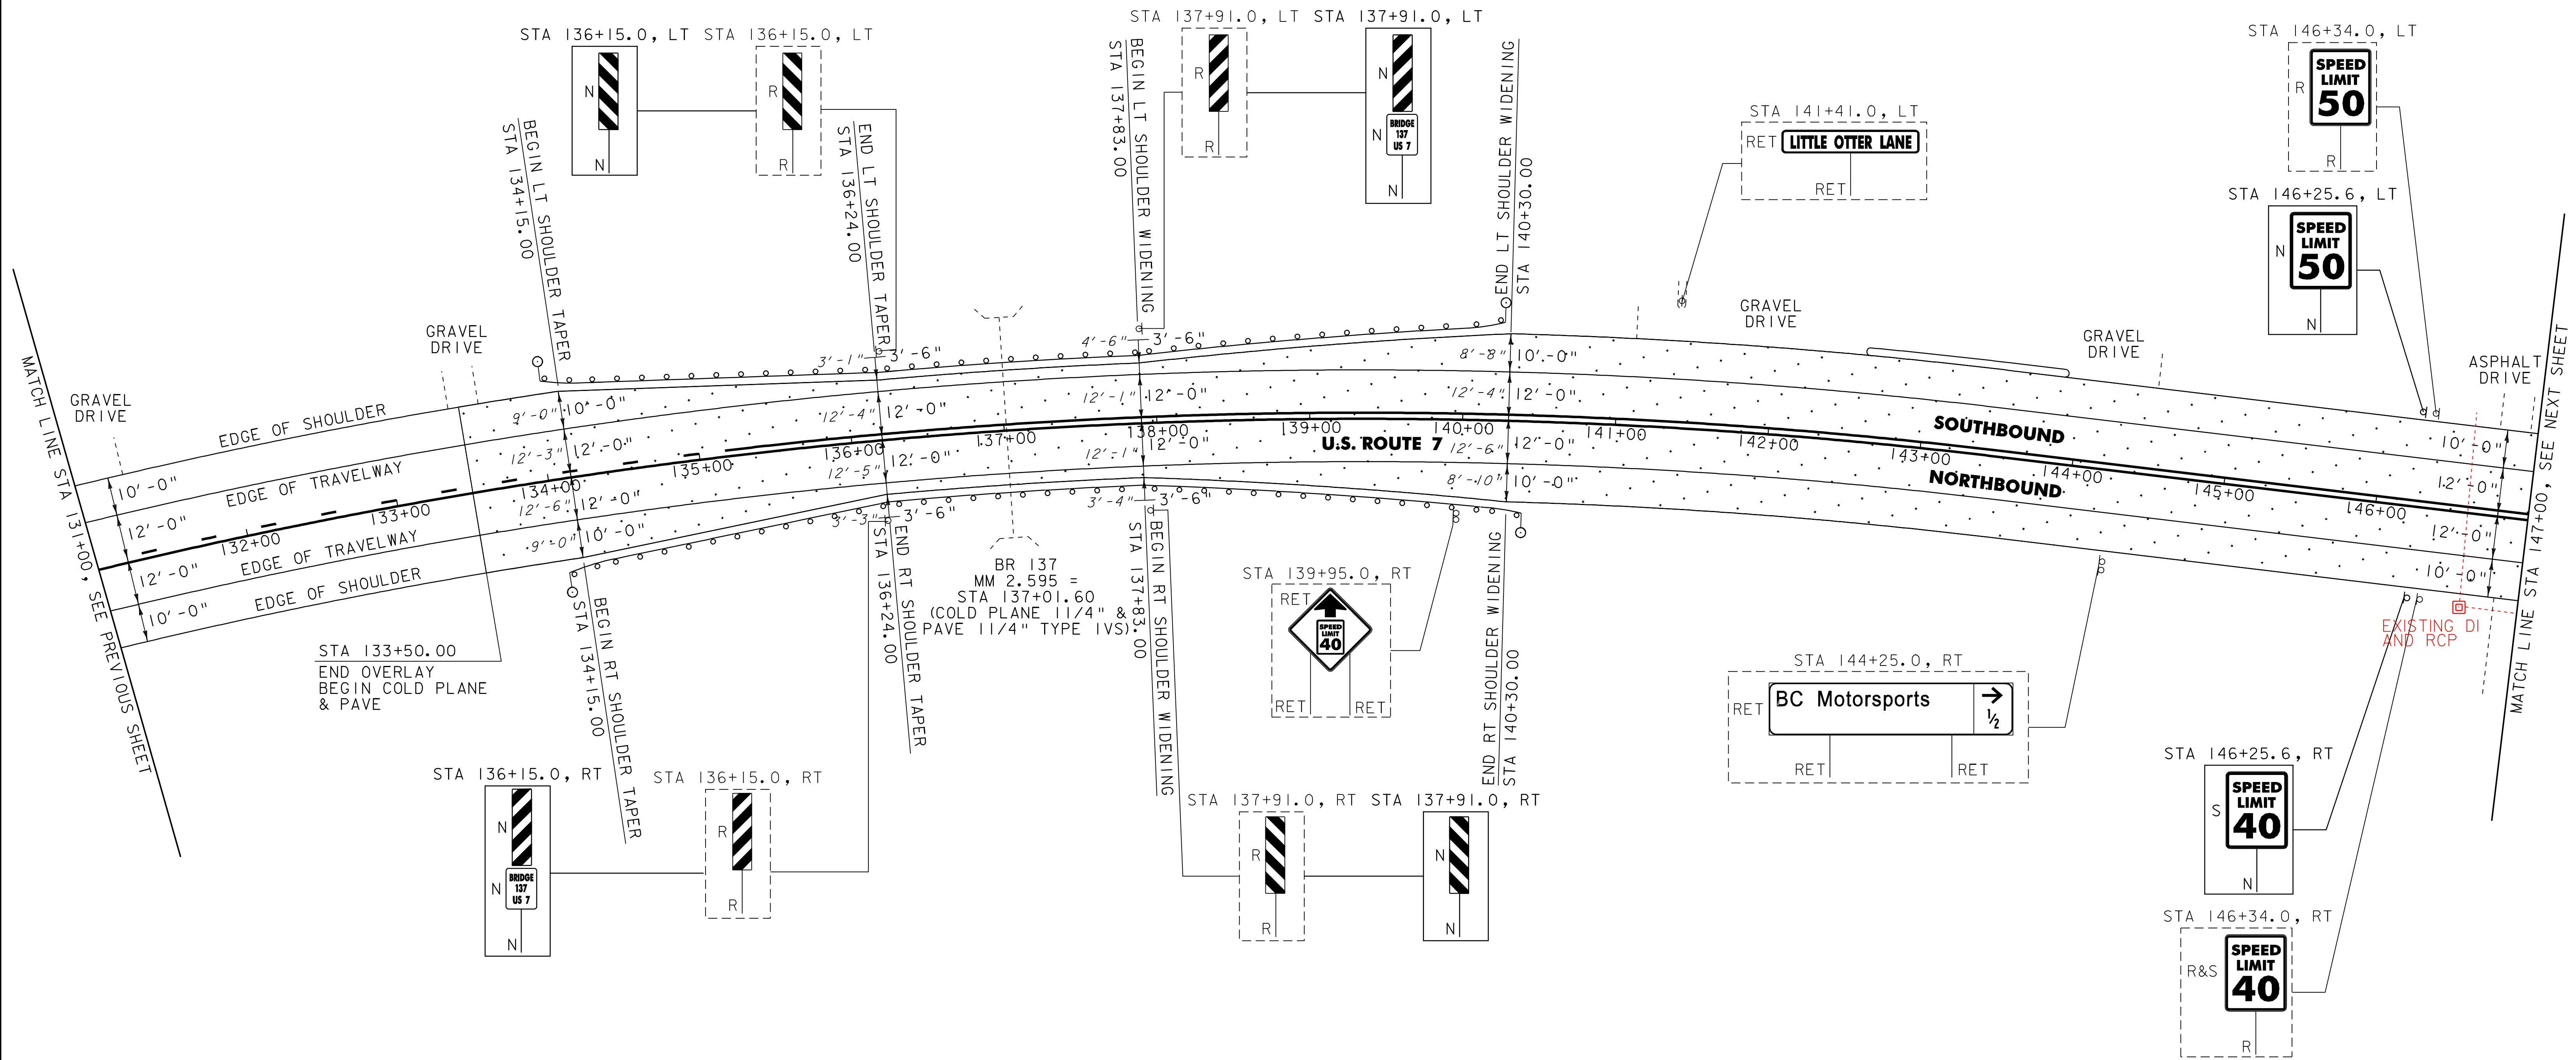

621.20 STEEL BEAM GUARDRAIL, GALVANIZED

FERRISBURGH:
 STA 134+42.0 - STA 135+67.0 LT (125.0 LF)
 STA 134+42.0 - STA 135+67.0 RT (125.0 LF)
 STA 138+40.0 - STA 139+90.0 LT (150.0 LF)
 STA 138+40.0 - STA 140+02.5 RT (162.5 LF)

621.70 GUARDRAIL APPROACH SECTION, GALVANIZED TYPE I

FERRISBURGH:
 STA 135+67.0 - STA 136+17.0 LT (50.0 LF)
 STA 135+67.0 - STA 136+17.0 RT (50.0 LF)
 STA 137+90.0 - STA 138+40.0 LT (50.0 LF)
 STA 137+90.0 - STA 138+40.0 RT (50.0 LF)

676.10 DELINEATOR WITH STEEL POST

TYPE I WHITE
 FERRISBURGH:
 STA 134+04.5 LT
 STA 134+04.5 RT
 STA 140+27.5 LT
 STA 140+40.0 RT

621.50 MANUFACTURED TERMINAL SECTION, FLARED

FERRISBURGH:
 STA 134+04.5 - STA 134+42.0 LT
 STA 134+04.5 - STA 134+42.0 RT
 STA 139+90.0 - STA 140+27.5 LT
 STA 140+02.5 - STA 140+40.0 RT

621.80 REMOVAL AND DISPOSAL OF GUARDRAIL

FERRISBURGH:
 STA 134+12.0 - STA 136+17.0 LT (205.0 LF)
 STA 134+12.0 - STA 136+17.0 RT (202.0 LF)
 STA 137+90.0 - STA 140+17.0 LT (227.0 LF)
 STA 137+90.0 - STA 140+32.0 RT (242.0 LF)

AREA TO BE COLD PLANED AND PAVED

SIGN LEGEND
 R = REMOVE
 S = SALVAGE
 N = NEW
 RET = RETAIN
 B-B = BACK TO BACK
 EXISTING = - - - - -
 NEW = _____

NOTE:
 1. SEE SHEET 84 FOR BR 137 DETAILS.
 SEE SHEETS 82 & 83 FOR GUARDRAIL APPROACH SECTION DETAILS.

NOT TO SCALE PROJECT LAYOUT SHEET #20	PROJECT NAME: <u>NEW HAVEN - FERRISBURGH</u> PROJECT NUMBER: <u>NH_2503(1)S</u>
	FILE NAME: <u>Q5b038.dgn</u> PROJECT LEADER: <u>D.E.G.</u> DESIGNED BY: <u>M.J.M.</u> IPARM FILE: <u>p05b038i20.i</u>