


646.402 DURABLE 4 INCH WHITE LINE, THERMOPLASTIC
 (ALL LINES WILL INCLUDE EDGE LINE BREAKS AND RADIUS FOR TOWN HIGHWAYS)
 FERRISBURGH:
 STA 147+00.00 - STA 163+00.00 EDGE LINE LT & RT
 STA 162+50.00 - STA 163+00.00 DOTTED LANE LINE, RT
 646.602 TEMPORARY 4 INCH WHITE LINE, PAINT
 (ALL LINES WILL INCLUDE EDGE LINE BREAKS AND RADIUS FOR TOWN HIGHWAYS)
 FERRISBURGH:
 STA 147+00.00 - STA 163+00.00 EDGE LINE LT & RT
 STA 162+50.00 - STA 163+00.00 DOTTED LANE LINE, RT

646.412 DURABLE 4 INCH YELLOW LINE, THERMOPLASTIC
 (ALL LINES WILL INCLUDE C/L BREAKS FOR TOWN HIGHWAYS) S=SOLID, D=DASHED
 FERRISBURGH:
 STA 147+00.00 - STA 160+50.00 LT C RT S = S
 STA 160+50.00 - STA 163+00.00 DOUBLE SOLID MEDIAN LT & RT
 646.612 TEMPORARY 4 INCH YELLOW LINE, PAINT
 (ALL LINES WILL INCLUDE C/L BREAKS FOR TOWN HIGHWAYS) S=SOLID, D=DASHED
 FERRISBURGH:
 STA 147+00.00 - STA 160+50.00 LT C RT S = S
 STA 160+50.00 - STA 163+00.00 DOUBEL SOILD MEDIAN LT & RT

646.452 DURABLE 8 INCH YELLOW LINE, THERMOPLASTIC
 FERRISBURGH:
 STA 160+50.00 - STA 163+00.00 HATCHED MEDIAN LT & RT

675.50 SIGNING AS SHOWN - 8

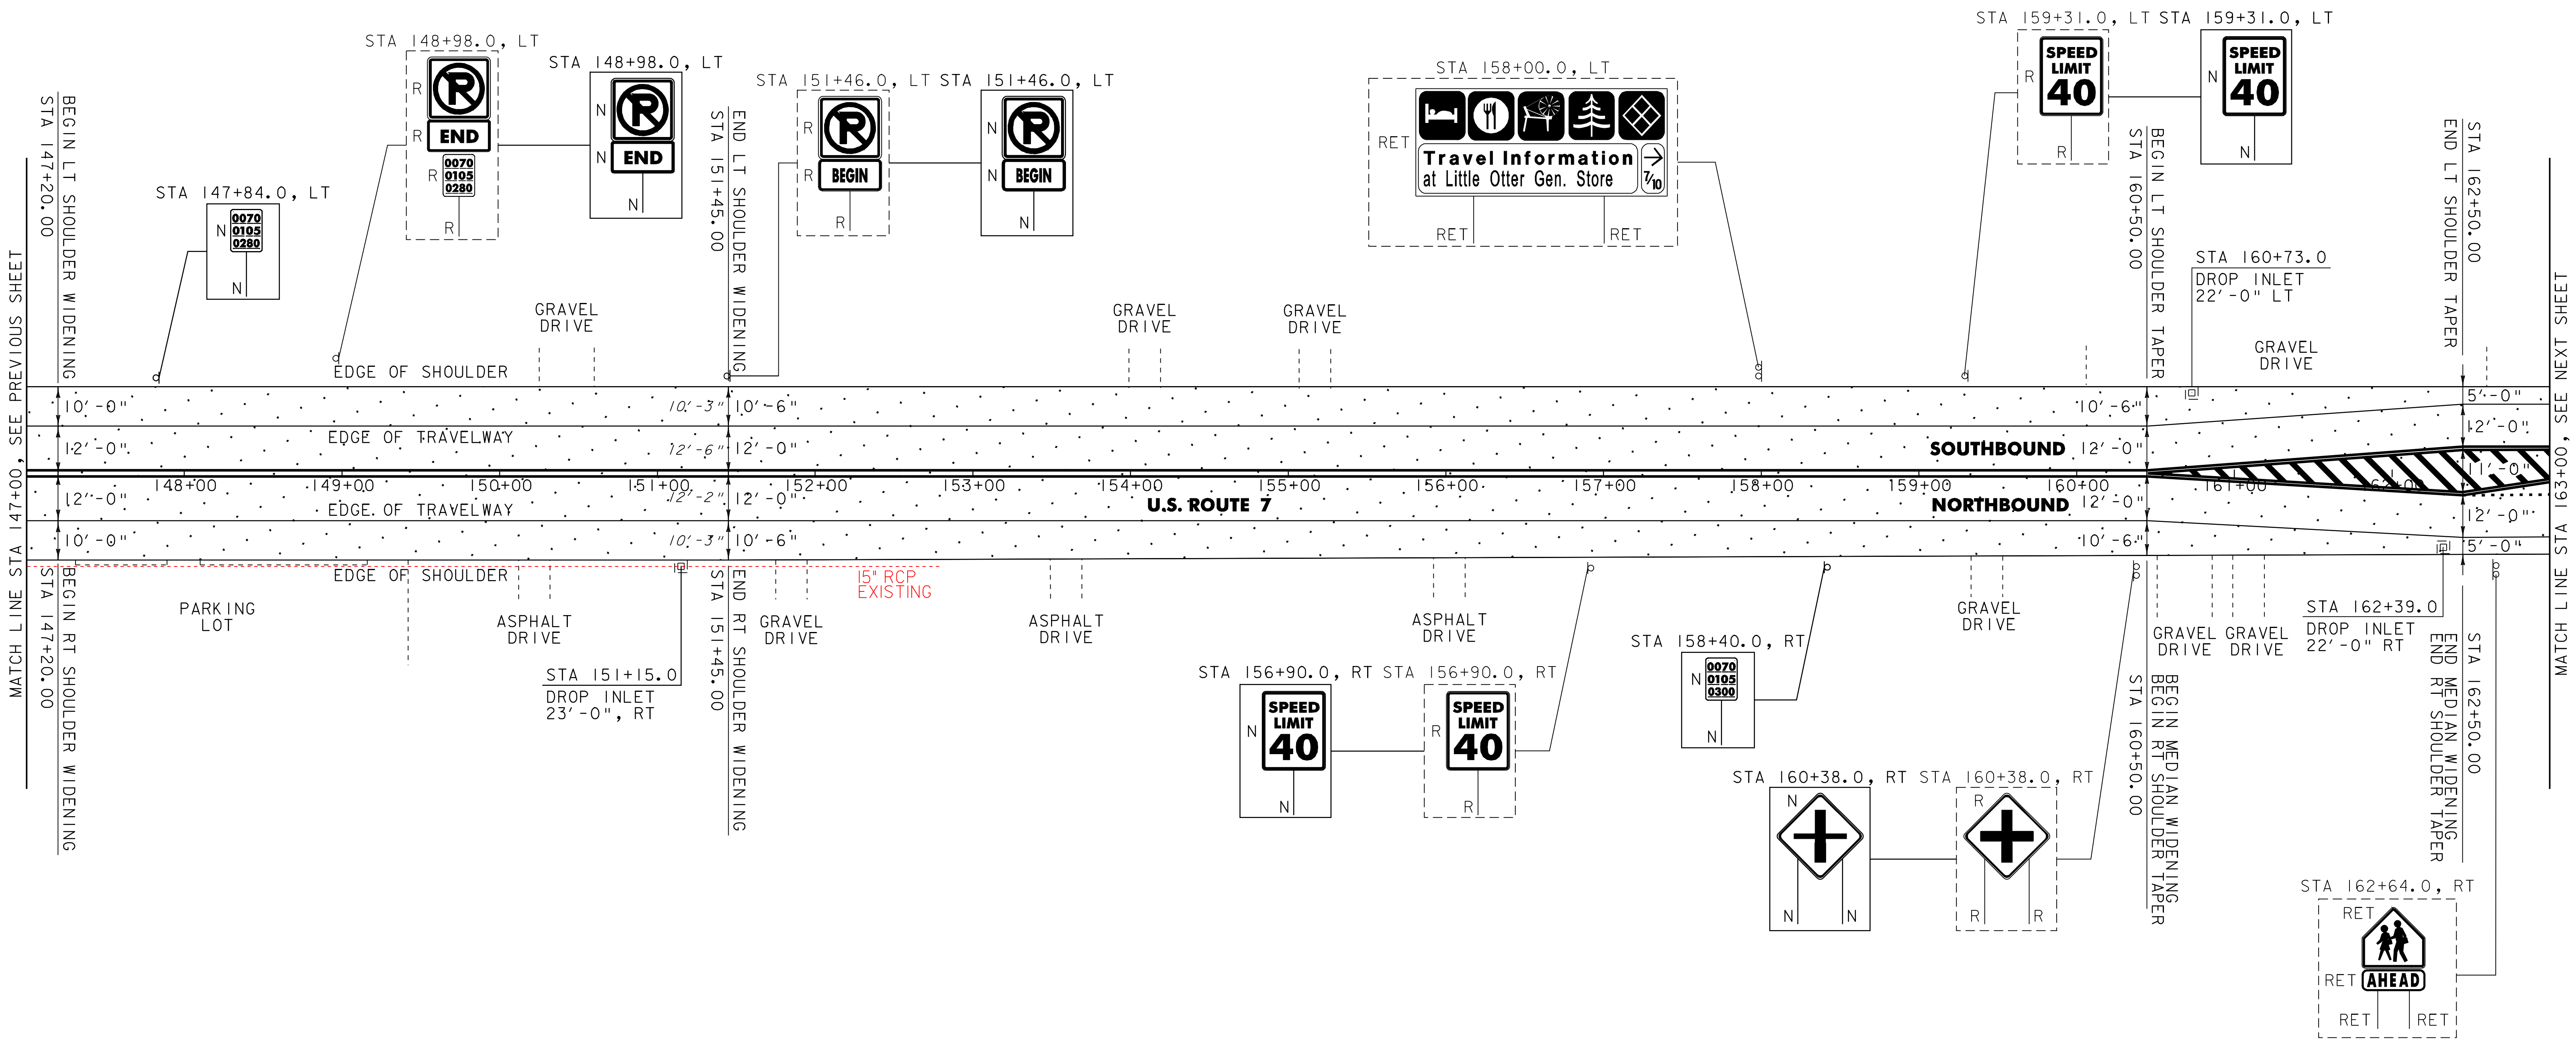

604.412 REHAB. DROP INLETS, CATCH BASINS OR MANHOLES, CLASS 1

FERRISBURGH:
 STA 151+15.0 RT
 STA 160+73.0 LT
 STA 162+39.0 RT

AREA TO BE COLD PLANNED AND PAVED

SIGN LEGEND
 R = REMOVE
 S = SALVAGE
 N = NEW
 RET = RETAIN
 B-B = BACK TO BACK
 EXISTING = - - - - -
 NEW = _____

NOT TO SCALE

PROJECT LAYOUT SHEET #21

PROJECT NAME: NEW_HAVEN_-_FERRISBURGH
 PROJECT NUMBER: NH_2503(1)S

FILE NAME: Q5b038.dgn_
 PROJECT LEADER: D.E.G.
 DESIGNED BY: M.J.M.
 IPARM FILE: p05b038121.i
 PLOT DATE: 31-JUL-2009 15
 DRAWN BY: C.A.K.
 CHECKED BY: D.W.E.
 SHEET 34 OF 87