

646.402 DURABLE 4 INCH WHITE LINE, THERMOPLASTIC
(ALL LINES WILL INCLUDE EDGE LINE BREAKS AND RADIUS FOR TOWN HIGHWAYS)

FERRISBURGH:
STA 163+00.00 - STA 179+00.00 EDGE LINE LT & RT
STA 163+00.00 - STA 164+30.00 DOTTED LANE LINE RT
STA 164+30.00 - STA 165+05.00 SOLID LANE LINE RT
STA 165+80.00 - STA 166+55.00 SOLID LANE LINE LT
STA 166+55.00 - STA 168+35.00 DOTTED LANE LINE LT

646.422 DURABLE 4 INCH WHITE LINE, THERMOPLASTIC
(ALL LINES WILL INCLUDE EDGE LINE BREAKS AND RADIUS FOR TOWN HIGHWAYS)

FERRISBURGH:
STA 163+00.00 - STA 179+00.00 EDGE LINE LT & RT
STA 163+00.00 - STA 164+30.00 DOTTED LANE LINE RT
STA 164+30.00 - STA 165+05.00 SOLID LANE LINE RT
STA 165+80.00 - STA 166+55.00 SOLID LANE LINE LT
STA 166+55.00 - STA 168+35.00 DOTTED LANE LINE LT

646.412 DURABLE 4 INCH YELLOW LINE, THERMOPLASTIC
(ALL LINES WILL INCLUDE C/L BREAKS FOR TOWN HIGHWAYS) S=SOLID, D=DASHED

FERRISBURGH:
STA 170+35.00 - STA 179+00.00 LT C RT S L S
STA 163+00.00 - STA 164+30.00 DOUBLE SOLID MEDIAN LT & RT
STA 164+30.00 - STA 166+55.00 DOUBLE SOLID CENTERLINE
STA 166+55.00 - STA 170+35.00 DOUBLE SOLID MEDIAN LT & RT
STA 165+26.40 DOUBLE SOLID LT, TH-5
STA 165+58.08 DOUBLE SOLID RT, TH-14

646.612 TEMPORARY 4 INCH YELLOW LINE, PAINT
(ALL LINES WILL INCLUDE C/L BREAKS FOR TOWN HIGHWAYS) S=SOLID, D=DASHED

FERRISBURGH:
STA 170+35.00 - STA 179+00.00 LT C RT S L S
STA 163+00.00 - STA 164+30.00 DOUBLE SOLID MEDIAN LT & RT
STA 164+30.00 - STA 166+55.00 DOUBLE SOLID CENTERLINE
STA 166+55.00 - STA 170+35.00 DOUBLE SOLID MEDIAN LT & RT
STA 165+26.40 DOUBLE SOLID LT, TH-5
STA 165+58.08 DOUBLE SOLID RT, TH-14

646.682 TEMPORARY 24 INCH STOP BAR, PAINT

FERRISBURGH:
STA 165+26.40 LT, TH-5
STA 165+58.08 RT, TH-14

646.452 DURABLE 8 INCH YELLOW LINE, THERMOPLASTIC

FERRISBURGH:
STA 163+00.00 - STA 164+30.00 HATCHED MEDIAN LT & RT
STA 166+55.00 - STA 170+35.00 HATCHED MEDIAN LT & RT
STA 170+14.0, LT STA 170+14.0, LT

646.482 DURABLE 24 INCH STOP BAR, THERMOPLASTIC

FERRISBURGH:
STA 165+26.40 LT, TH-5
STA 165+58.08 RT, TH-14

646.492 DURABLE LETTER OR SYMBOL, THERMOPLASTIC


FERRISBURGH:
STA 164+34.50 RT, "O,N,L,Y" (4 EA)
STA 165+00.70 RT, ARROW (1EA)
STA 165+26.40 LT, TH-5 "S,T,O,P" (4 EA)
STA 165+58.08 RT, TH-14 "S,T,O,P" (4 EA)
STA 165+84.30 RT, ARROW (1EA)
STA 166+50.50 RT, "O,N,L,Y" (4 EA)

675.50 REMOVING SIGNS

AS SHOWN - II

675.60 ERECTING SALVAGED SIGNS

AS SHOWN - 2

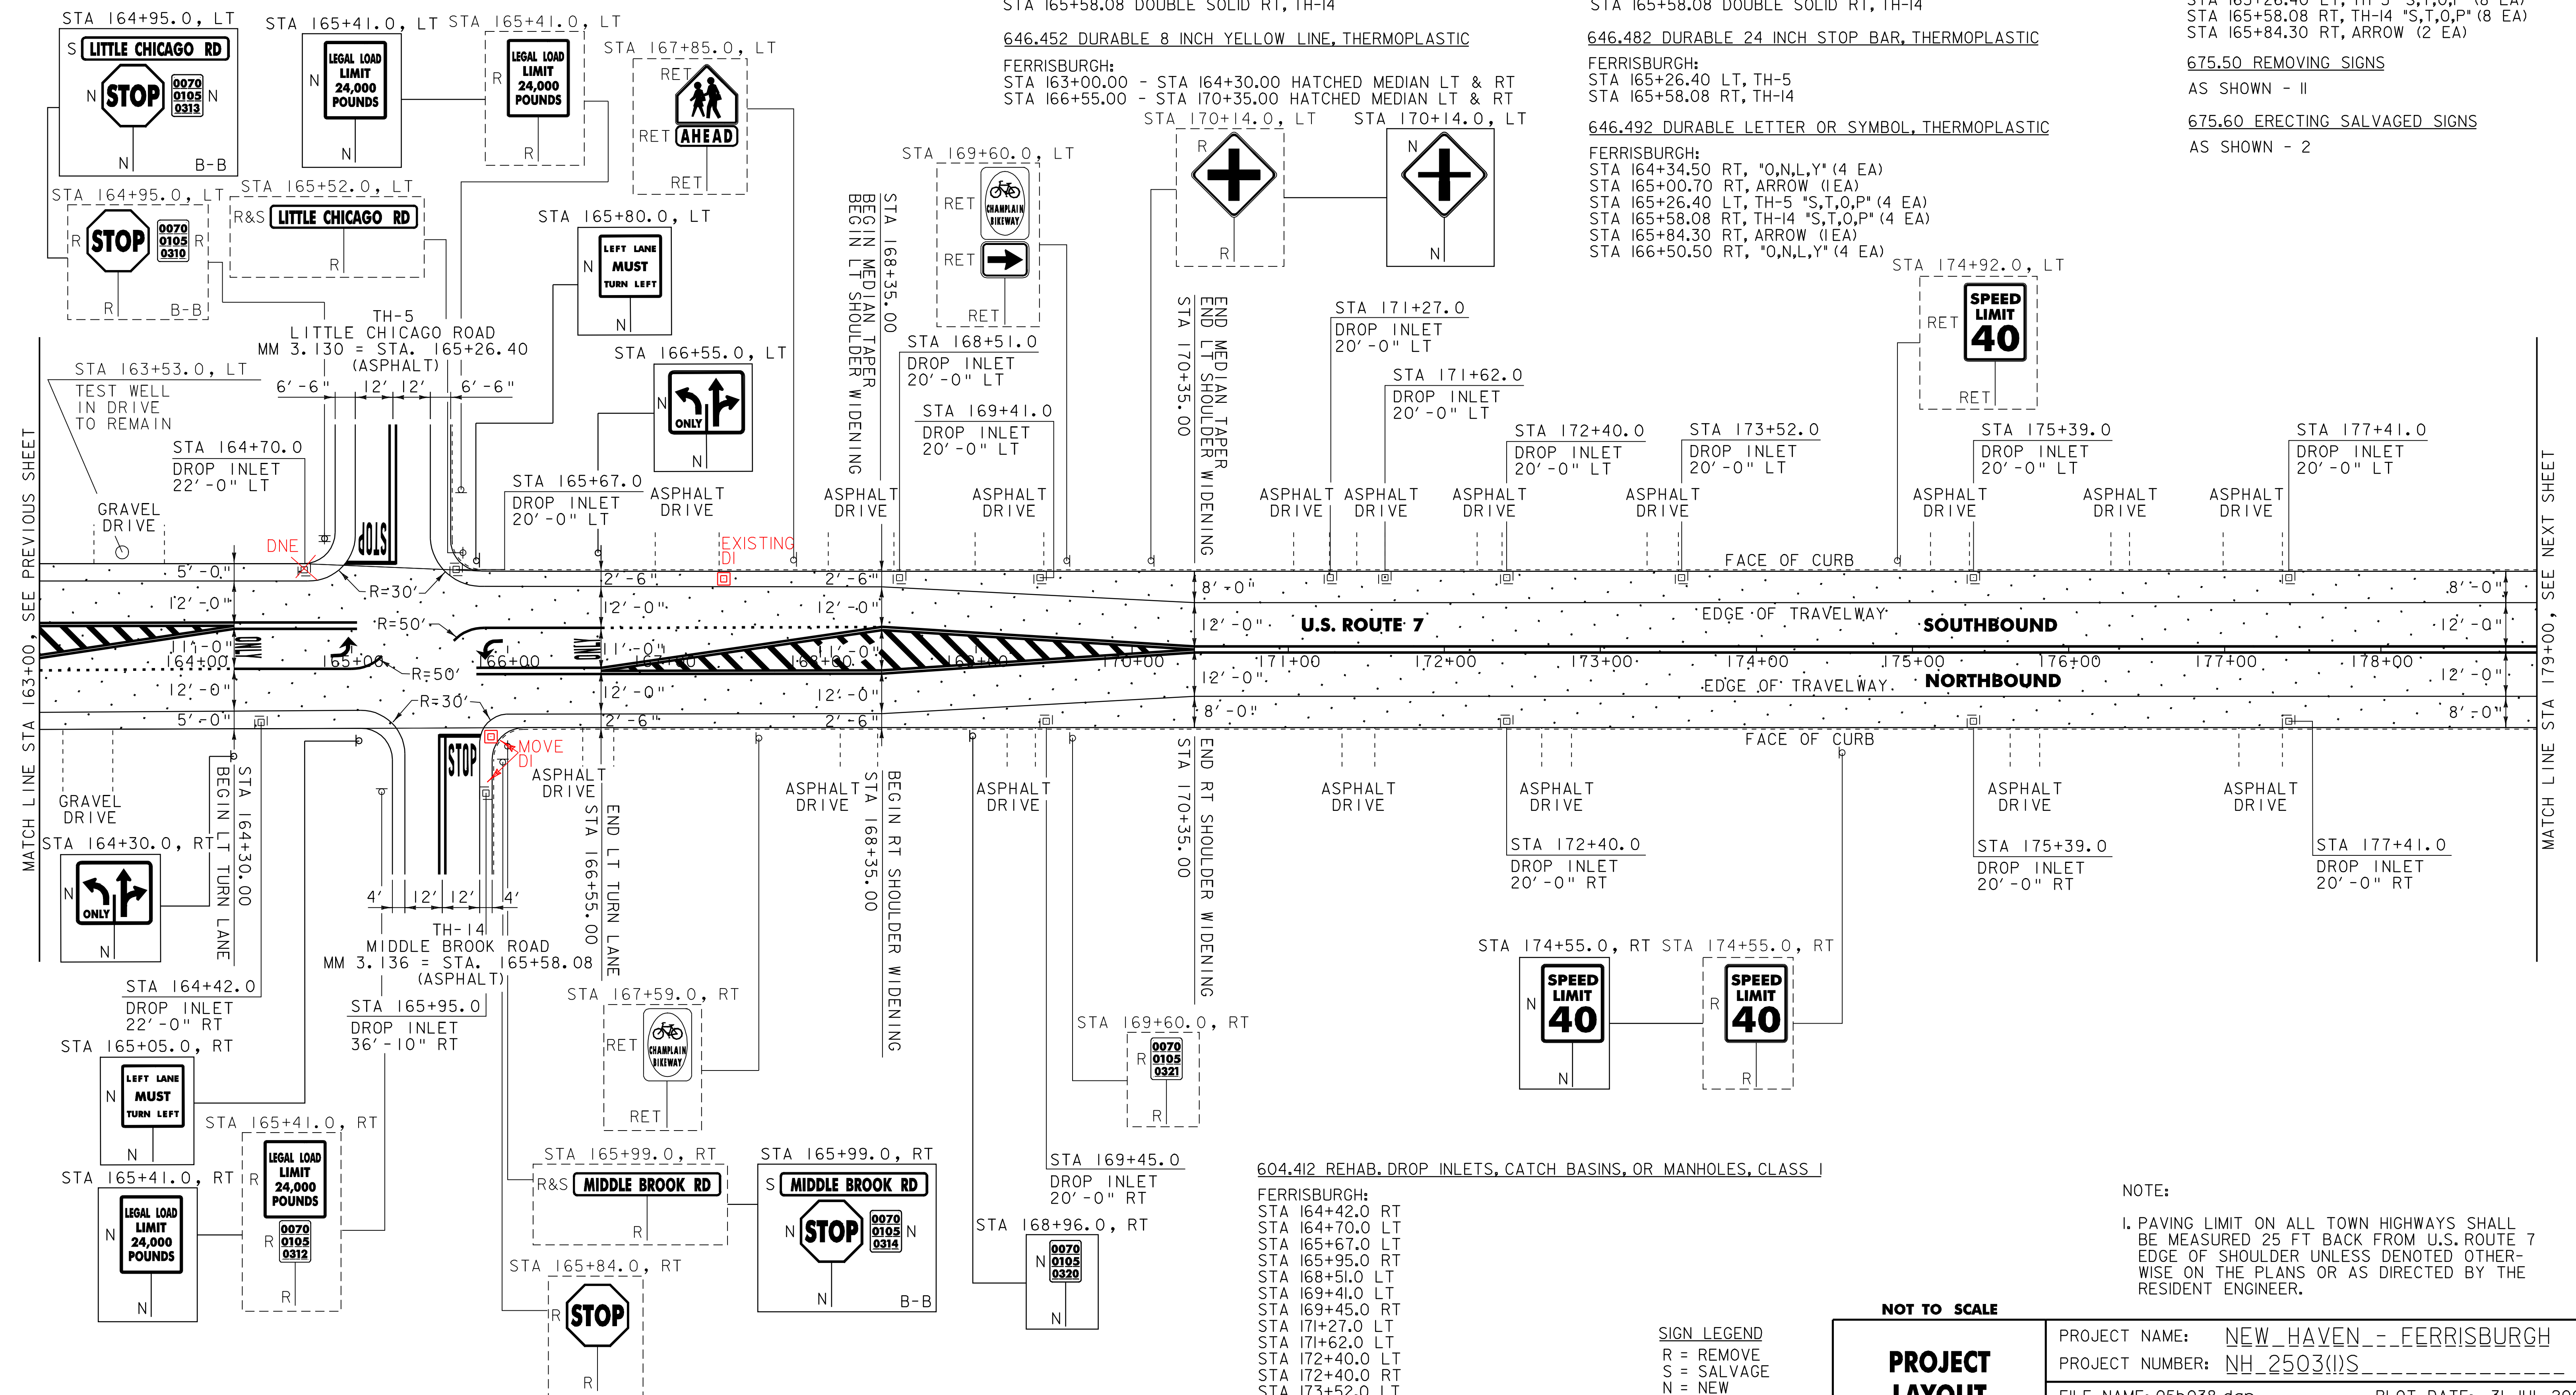

604.412 REHAB. DROP INLETS, CATCH BASINS, OR MANHOLES, CLASS I

FERRISBURGH:
STA 164+42.0 RT
STA 164+70.0 LT
STA 165+67.0 LT
STA 165+95.0 RT
STA 168+51.0 LT
STA 169+41.0 LT
STA 169+45.0 RT
STA 171+27.0 LT
STA 171+62.0 LT
STA 172+40.0 LT
STA 172+40.0 RT
STA 173+52.0 LT
STA 175+39.0 LT
STA 175+39.0 RT
STA 177+41.0 LT
STA 177+41.0 RT

SIGN LEGEND
R = REMOVE
S = SALVAGE
N = NEW
RET = RETAIN
B-B = BACK TO BACK
EXISTING = -----
NEW = _____

NOTE:
I. PAVING LIMIT ON ALL TOWN HIGHWAYS SHALL BE MEASURED 25 FT BACK FROM U.S. ROUTE 7 EDGE OF SHOULDER UNLESS DENOTED OTHERWISE ON THE PLANS OR AS DIRECTED BY THE RESIDENT ENGINEER.

PROJECT LAYOUT SHEET #22	PROJECT NAME: <u>NEW HAVEN - FERRISBURGH</u>	
	PROJECT NUMBER: <u>NH_2503(I)S</u>	
	FILE NAME: <u>Q5b038.dgn</u>	PLOT DATE: <u>31-JUL-2009 15</u>
	DESIGNED BY: <u>M.J.M.</u>	CHECKED BY: <u>D.W.E.</u>
	IPARM FILE: <u>p05b038i22.i</u>	SHEET <u>35</u> OF <u>87</u>