


646.402 DURABLE 4 INCH WHITE LINE, THERMOPLASTIC  
 (ALL LINES WILL INCLUDE EDGE LINE BREAKS AND RADIUS FOR TOWN HIGHWAYS)  
 FERRISBURGH:  
 STA 211+00.00 - STA. 227+00.00 EDGE LINE LT & RT

646.602 TEMPORARY 4 INCH WHITE LINE, PAINT  
 (ALL LINES WILL INCLUDE EDGE LINE BREAKS AND RADIUS FOR TOWN HIGHWAYS)  
 FERRISBURGH:  
 STA 211+00.00 - STA. 227+00.00 EDGE LINE LT & RT

646.412 DURABLE 4 INCH YELLOW LINE, THERMOPLASTIC  
 (ALL LINES WILL INCLUDE C/L BREAKS FOR TOWN HIGHWAYS) S=SOLID, D=DASHED  
 FERRISBURGH:  
 STA 211+00.00 - STA 227+00.00 LT C RT - D -

646.612 TEMPORARY 4 INCH YELLOW LINE, PAINT  
 (ALL LINES WILL INCLUDE C/L BREAKS FOR TOWN HIGHWAYS) S=SOLID, D=DASHED  
 FERRISBURGH:  
 STA 211+00.00 - STA 227+00.00 LT C RT - D -

675.50 REMOVING SIGNS  
 AS SHOWN - 3

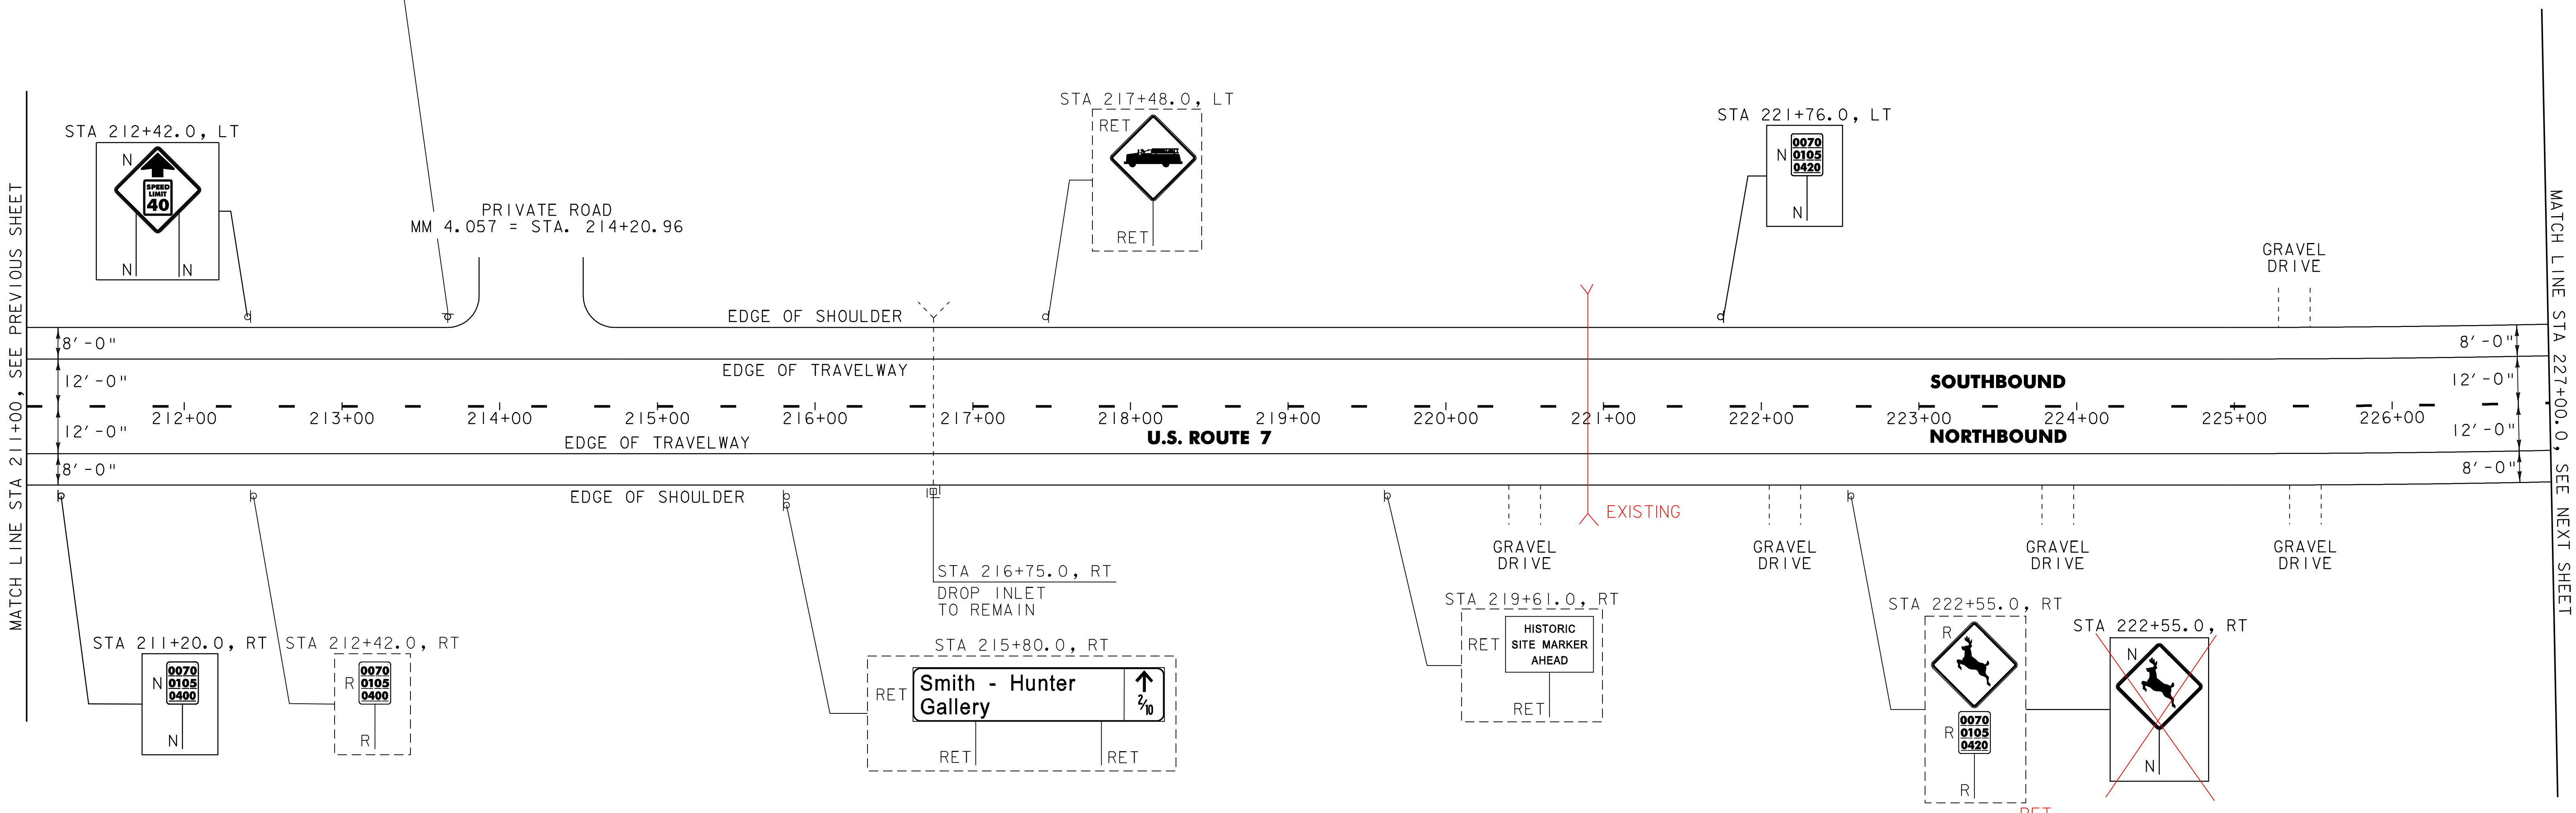

MATCH LINE STA 211+00, SEE PREVIOUS SHEET

MATCH LINE STA 227+00, SEE NEXT SHEET

**SIGN LEGEND**  
 R = REMOVE  
 S = SALVAGE  
 N = NEW  
 RET = RETAIN  
 B-B = BACK TO BACK  
 EXISTING = - - - - -  
 NEW = \_\_\_\_\_

<b>PROJECT LAYOUT SHEET #25</b>	<b>NOT TO SCALE</b>	
	PROJECT NAME: <u>NEW_HAVEN_-_FERRISBURGH</u>	PROJECT NUMBER: <u>NH_2503(I)S</u>
	FILE NAME: <u>Q5b038.dgn</u>	PLOT DATE: <u>31-JUL-2009 15</u>
	PROJECT LEADER: <u>D.E.G.</u>	DRAWN BY: <u>C.A.K.</u>
	DESIGNED BY: <u>M.J.M.</u>	CHECKED BY: <u>D.W.E.</u>
	IPARM FILE: <u>p05b038125.i</u>	SHEET <u>38</u> OF <u>87</u>