

646.402 DURABLE 4 INCH WHITE LINE, THERMOPLASTIC
 (ALL LINES WILL INCLUDE EDGE LINE BREAKS AND
 RADIUS FOR TOWN HIGHWAYS)

FERRISBURGH:
 STA 227+00.00 - STA. 243+00.00 EDGE LINE LT & RT

646.602 TEMPORARY 4 INCH WHITE LINE, PAINT
 (ALL LINES WILL INCLUDE EDGE LINE BREAKS AND
 RADIUS FOR TOWN HIGHWAYS)

FERRISBURGH:
 STA 227+00.00 - STA. 243+00.00 EDGE LINE LT & RT

646.412 DURABLE 4 INCH YELLOW LINE, THERMOPLASTIC
 (ALL LINES WILL INCLUDE C/L BREAKS FOR
 TOWN HIGHWAYS) S=SOLID, D=DASHED

FERRISBURGH:
 STA 227+00.00 - STA 227+57.00 - D - S
 STA 227+57.00 - STA 236+55.00 - D - S
 STA 236+55.00 - STA 243+00.00 - S - S
 STA 239+76.48 DOUBLE SOLID RT, TH-22
 STA 240+60.96 DOUBLE SOLID LT, TH-6

646.612 TEMPORARY 4 INCH YELLOW LINE, PAINT
 (ALL LINES WILL INCLUDE C/L BREAKS FOR
 TOWN HIGHWAYS) S=SOLID, D=DASHED

FERRISBURGH:
 STA 227+00.00 - STA 227+57.00 - D - S
 STA 227+57.00 - STA 236+55.00 - D - S
 STA 236+55.00 - STA 243+00.00 - S - S
 STA 239+76.48 DOUBLE SOLID RT, TH-22
 STA 240+60.96 DOUBLE SOLID LT, TH-6

646.482 DURABLE 24 INCH STOP BAR, THERMOPLASTIC

FERRISBURGH:
 STA 239+76.48 RT, TH-22
 STA 240+60.96 LT, TH-6

646.492 DURABLE LETTER OR SYMBOL, THERMOPLASTIC

FERRISBURGH:
 STA 239+76.48 RT, TH-22 "S,T,O,P" (4 EA)
 STA 240+60.96 LT, TH-6 "S,T,O,P" (4 EA)

646.682 TEMPORARY 24 INCH STOP BAR, PAINT 8

FERRISBURGH:
 STA 239+76.48 RT, TH-22
 STA 240+60.96 LT, TH-6

646.692 TEMPORARY LETTER OR SYMBOL, PAINT

FERRISBURGH:
 STA 239+76.48 RT, TH-22 "S,T,O,P" (4 EA)
 STA 240+60.96 LT, TH-6 "S,T,O,P" (4 EA)

675.50 REMOVING SIGNS


AS SHOWN - II

675.60 ERECTING SALVAGED SIGNS

AS SHOWN - 4

MATCH LINE STA 227+00, SEE PREVIOUS SHEET

MATCH LINE STA 243+00, SEE NEXT SHEET

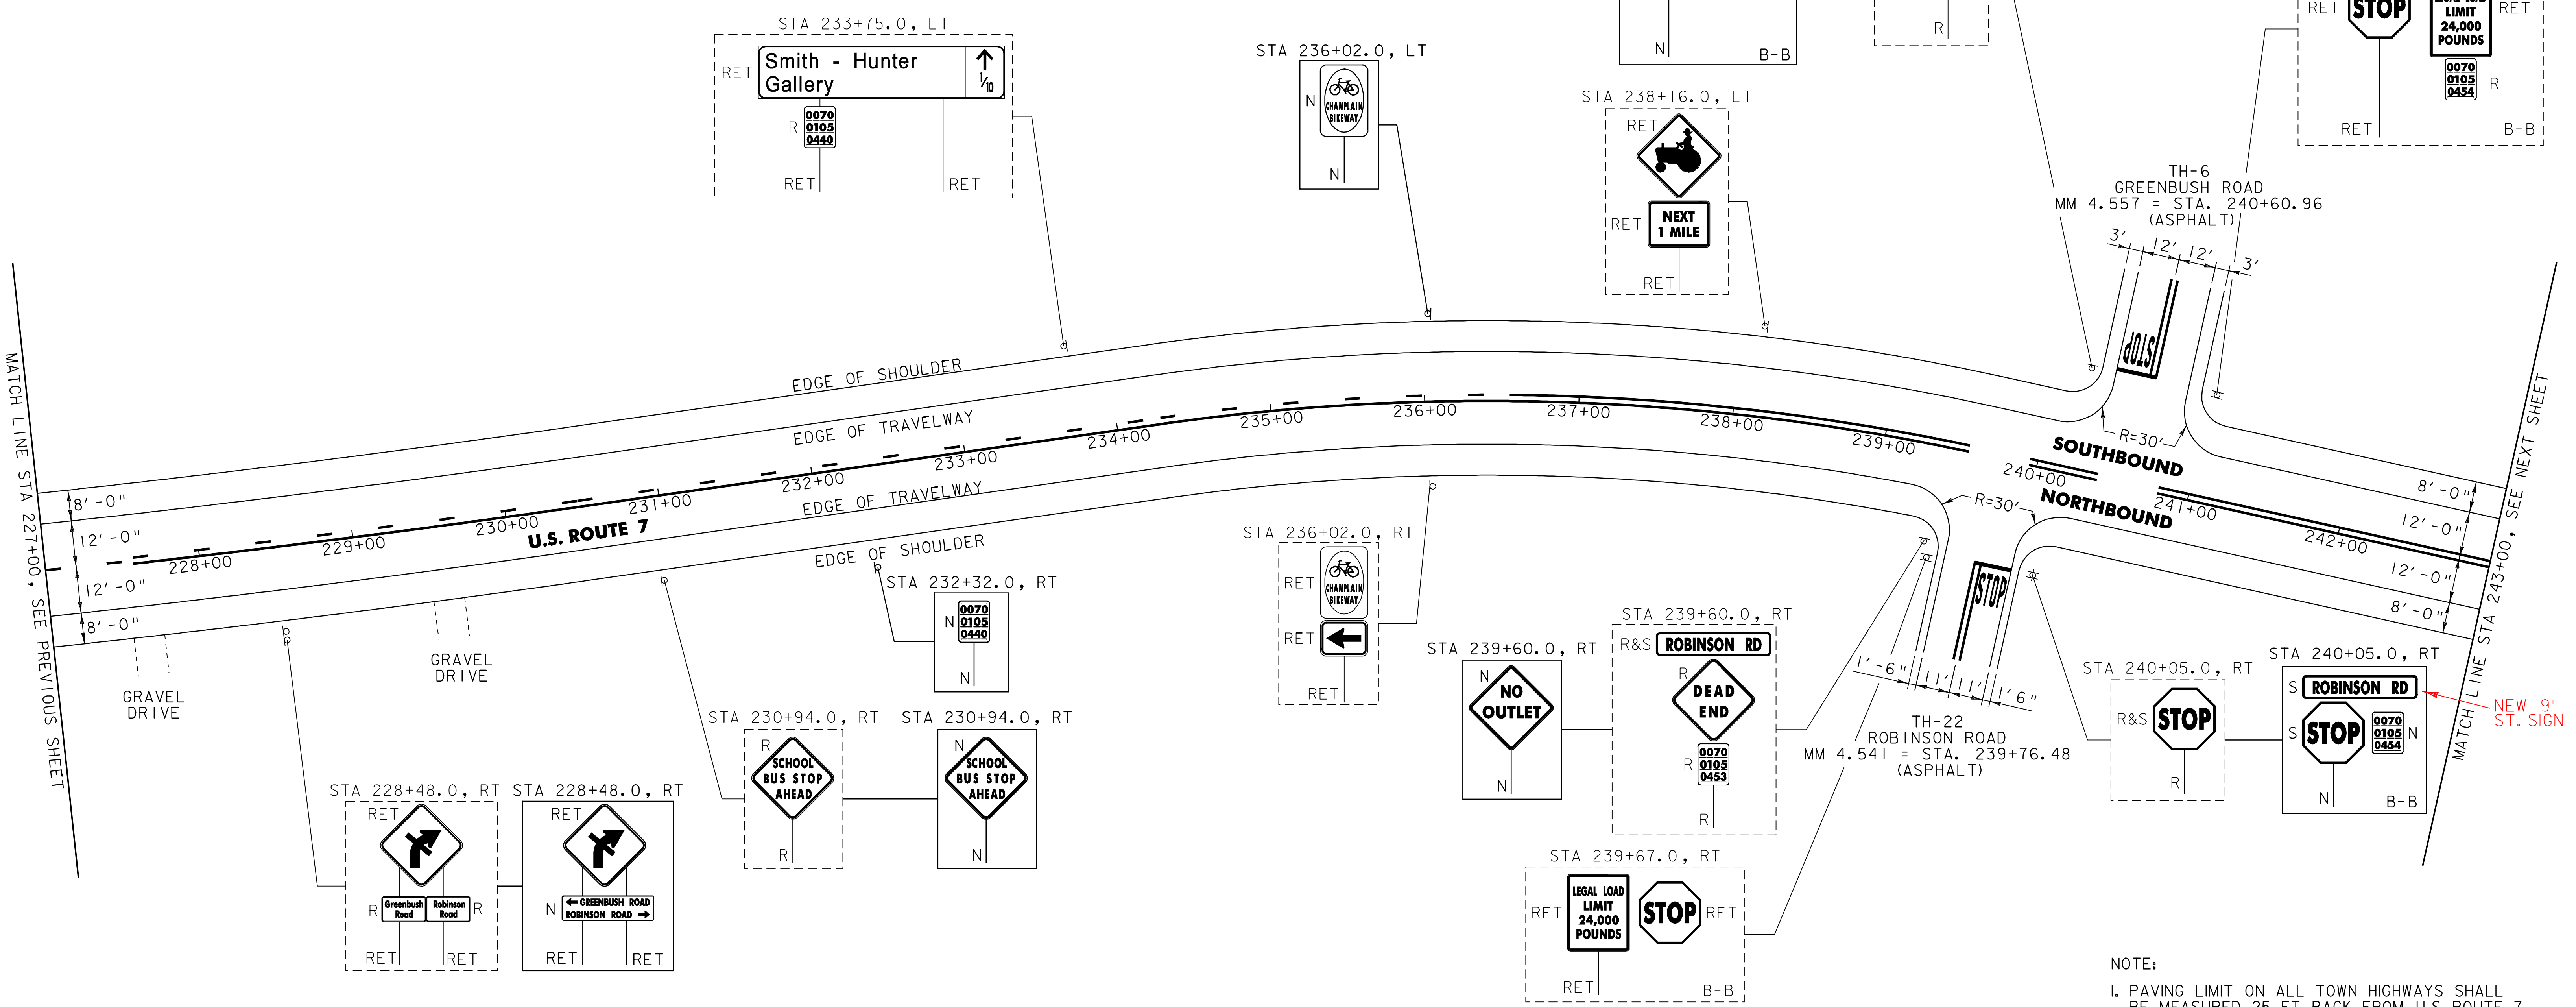

NOTE:
 1. PAVING LIMIT ON ALL TOWN HIGHWAYS SHALL
 BE MEASURED 25 FT BACK FROM U.S. ROUTE 7
 EDGE OF SHOULDER UNLESS DENOTED OTHER-
 WISE ON THE PLANS OR AS DIRECTED BY THE
 RESIDENT ENGINEER.

SIGN LEGEND
 R = REMOVE
 S = SALVAGE
 N = NEW
 RET = RETAIN
 B-B = BACK TO BACK
 EXISTING = - - - - -
 NEW = _____

PROJECT LAYOUT SHEET #26	NOT TO SCALE	
	PROJECT NAME: <u>NEW HAVEN - FERRISBURGH</u>	PROJECT NUMBER: <u>NH_2503(1)S</u>
FILE NAME: <u>Q5b038.dgn</u>	PLOT DATE: <u>31-JUL-2009 15</u>	
PROJECT LEADER: <u>D.E.G.</u>	DRAWN BY: <u>C.A.K.</u>	
DESIGNED BY: <u>M.J.M.</u>	CHECKED BY: <u>D.W.E.</u>	
IPARM FILE: <u>p05b038126.i</u>	SHEET <u>39</u> OF <u>87</u>	