

646.402 DURABLE 4 INCH WHITE LINE, THERMOPLASTIC
 (ALL LINES WILL INCLUDE EDGE LINE BREAKS AND
 RADIUS FOR TOWN HIGHWAYS)

FERRISBURGH:
 STA 259+00.00 - STA. 275+00.00 EDGE LINE LT & RT

646.602 TEMPORARY 4 INCH WHITE LINE, PAINT
 (ALL LINES WILL INCLUDE EDGE LINE BREAKS AND
 RADIUS FOR TOWN HIGHWAYS)

FERRISBURGH:
 STA 259+00.00 - STA. 275+00.00 EDGE LINE LT & RT


646.412 DURABLE 4 INCH YELLOW LINE, THERMOPLASTIC
 (ALL LINES WILL INCLUDE C/L BREAKS FOR
 TOWN HIGHWAYS) S=SOLID, D=DASHED

FERRISBURGH: LT C RT
 STA 259+00.00 - STA 264+80.00 D - S
 STA 264+80.00 - STA 272+98.00 S - S
 STA 272+98.00 - STA 275+00.00 S - D

646.612 TEMPORARY 4 INCH YELLOW LINE, PAINT
 (ALL LINES WILL INCLUDE C/L BREAKS FOR
 TOWN HIGHWAYS) S=SOLID, D=DASHED

FERRISBURGH: LT C RT
 STA 259+00.00 - STA 264+80.00 D - S
 STA 264+80.00 - STA 272+98.00 S - S
 STA 272+98.00 - STA 275+00.00 S - D

675.50 REMOVING SIGNS
 AS SHOWN - I

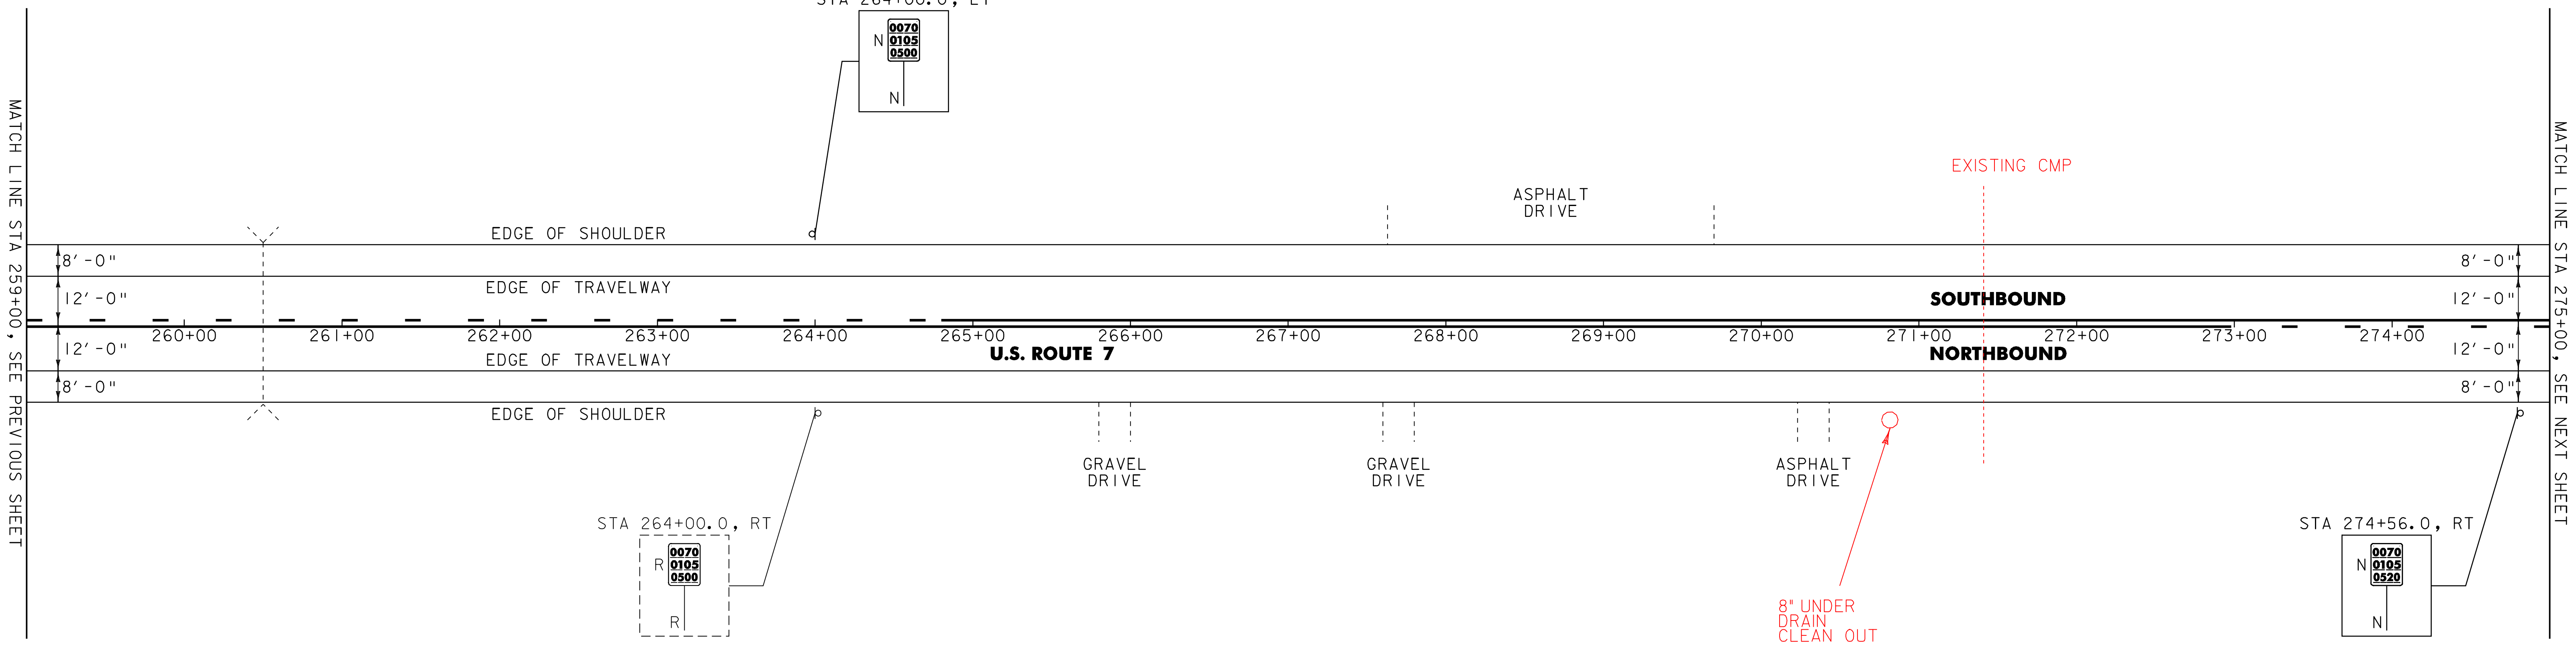

MATCH LINE STA 259+00, SEE PREVIOUS SHEET

MATCH LINE STA 275+00, SEE NEXT SHEET

SIGN LEGEND
 R = REMOVE
 S = SALVAGE
 N = NEW
 RET = RETAIN
 B-B = BACK TO BACK
 EXISTING = - - - - -
 NEW = _____

NOT TO SCALE

PROJECT LAYOUT SHEET #28

PROJECT NAME: NEW_HAVEN_-_FERRISBURGH	PLOT DATE: 31-JUL-2009 15
PROJECT NUMBER: NH_2503(I)S	DRAWN BY: C.A.K.
FILE NAME: Q5bQ38.dgn	CHECKED BY: D.W.E.
DESIGNED BY: M.J.M.	SHEET 41 OF 87
IPARM FILE: p05b038128.i	