

646.402 DURABLE 4 INCH WHITE LINE, THERMOPLASTIC
 (ALL LINES WILL INCLUDE EDGE LINE BREAKS AND RADIUS FOR TOWN HIGHWAYS)
 FERRISBURGH:
 STA 275+00.00 - STA. 291+00.00 EDGE LINE LT & RT

646.602 TEMPORARY 4 INCH WHITE LINE, PAINT
 (ALL LINES WILL INCLUDE EDGE LINE BREAKS AND RADIUS FOR TOWN HIGHWAYS)
 FERRISBURGH:
 STA 275+00.00 - STA. 291+00.00 EDGE LINE LT & RT


646.412 DURABLE 4 INCH YELLOW LINE, THERMOPLASTIC
 (ALL LINES WILL INCLUDE C/L BREAKS FOR TOWN HIGHWAYS) S=SOLID, D=DASHED

FERRISBURGH: LT C RT
 STA 275+00.00 - STA 275+10.00 S - D
 STA 275+10.00 - STA 290+40.00 - D -
 STA 290+40.00 - STA 291+00.00 D - S

646.612 TEMPORARY 4 INCH YELLOW LINE, PAINT
 (ALL LINES WILL INCLUDE C/L BREAKS FOR TOWN HIGHWAYS) S=SOLID, D=DASHED

FERRISBURGH: LT C RT
 STA 275+00.00 - STA 275+10.00 S - D
 STA 275+10.00 - STA 290+40.00 - D -
 STA 290+40.00 - STA 291+00.00 D - S

675.50 REMOVING SIGNS
 AS SHOWN - 2

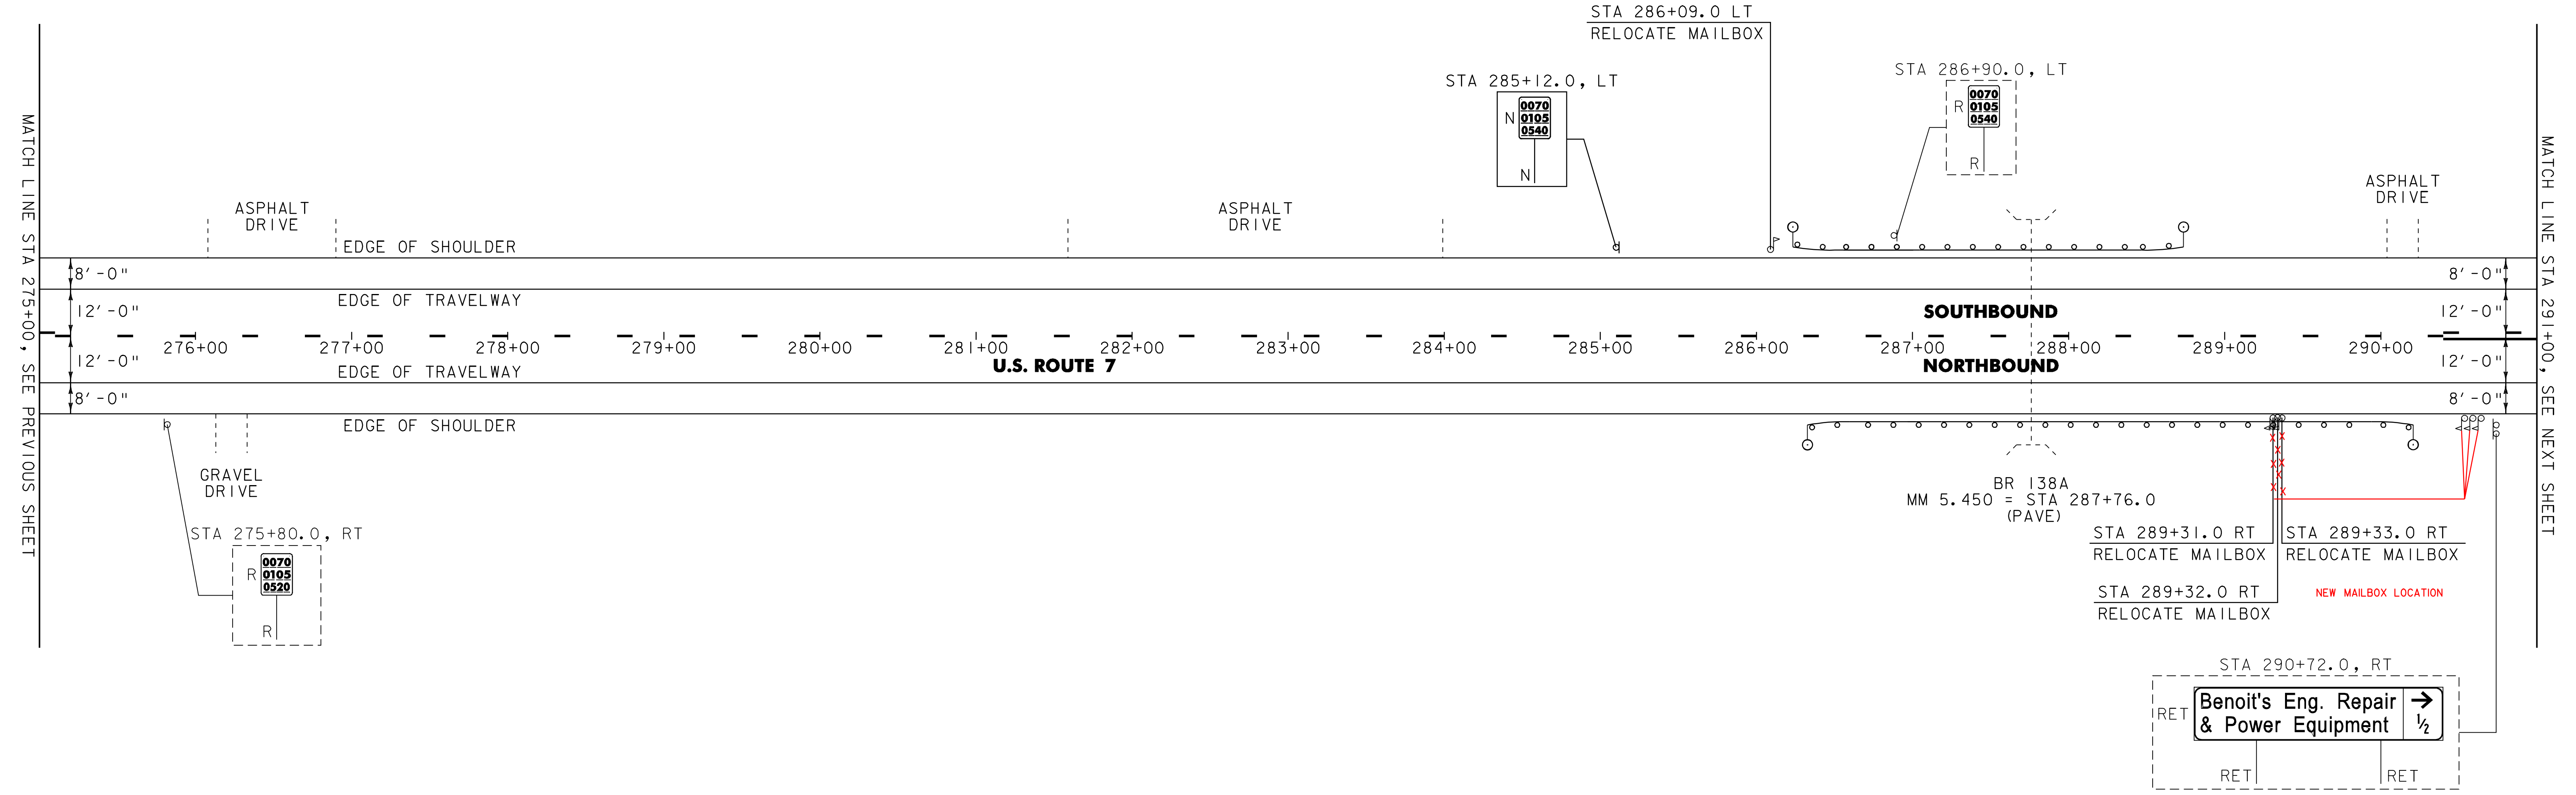

617.10 RELOCATE MAILBOX, SINGLE SUPPORT

FERRISBURGH:
 STA 286+09.0 LT
 STA 289+31.0 RT
 STA 289+32.0 RT
 STA 289+33.0 RT

621.20 STEEL BEAM GUARDRAIL, GALVANIZED

FERRISBURGH:
 STA 286+61.0 - STA 288+36.0 LT (175.0 LF)
 STA 286+70.0 - STA 289+82.5 RT (312.5 LF)

621.50 MANUFACTURED TERMINAL SECTION, FLARED

FERRISBURGH:
 STA 286+23.5 - STA 286+61.0 LT
 STA 286+32.5 - STA 286+70.0 RT
 STA 288+36.0 - STA 288+73.5 LT
 STA 289+82.5 - STA 290+20.0 RT

621.80 REMOVAL AND DISPOSAL OF GUARDRAIL

FERRISBURGH:
 STA 286+23.0 - STA 288+74.0 LT (251.0 LF)
 STA 286+35.0 - STA 289+23.0 RT (288.0 LF)

676.10 DELINEATOR WITH STEEL POST

♀ TYPE I WHITE

FERRISBURGH:
 STA 286+23.5 LT
 STA 286+32.5 RT
 STA 288+73.5 LT
 STA 290+20.0 RT

SIGN LEGEND
 R = REMOVE
 S = SALVAGE
 N = NEW
 RET = RETAIN
 B-B = BACK TO BACK
 EXISTING = - - - - -
 NEW = _____

NOT TO SCALE

PROJECT LAYOUT SHEET #29

PROJECT NAME: NEW_HAVEN_-_FERRISBURGH
 PROJECT NUMBER: NH_2503(1)S

FILE NAME: Q5b038.dgn PLOT DATE: 31-JUL-2009 15
 PROJECT LEADER: D.E.G. DRAWN BY: C.A.K.
 DESIGNED BY: M.J.M. CHECKED BY: D.W.E.
 IPARM FILE: p05b038129.i SHEET 42 OF 87