


646.402 DURABLE 4 INCH WHITE LINE, THERMOPLASTIC  
 (ALL LINES WILL INCLUDE EDGE LINE BREAKS AND RADIUS FOR TOWN HIGHWAYS)  
 FERRISBURGH:  
 STA 291+00.00 - STA. 307+00.00 EDGE LINE LT & RT  
 646.602 TEMPORARY 4 INCH WHITE LINE, PAINT  
 (ALL LINES WILL INCLUDE EDGE LINE BREAKS AND RADIUS FOR TOWN HIGHWAYS)  
 FERRISBURGH:  
 STA 291+00.00 - STA. 307+00.00 EDGE LINE LT & RT

646.412 DURABLE 4 INCH YELLOW LINE, THERMOPLASTIC  
 (ALL LINES WILL INCLUDE C/L BREAKS FOR TOWN HIGHWAYS) S=SOLID, D=DASHED  
 FERRISBURGH:  
 STA 291+00.00 - STA 298+32.00 D - S  
 STA 298+32.00 - STA 307+00.00 S - S  
 STA 299+85.12 DOUBLE SOLID RT, TH-15  
 646.612 TEMPORARY 4 INCH YELLOW LINE, PAINT  
 (ALL LINES WILL INCLUDE C/L BREAKS FOR TOWN HIGHWAYS) S=SOLID, D=DASHED  
 FERRISBURGH:  
 STA 291+00.00 - STA 298+32.00 LT C RT S  
 STA 298+32.00 - STA 307+00.00 D - S  
 STA 299+85.12 DOUBLE SOLID RT, TH-15

646.482 DURABLE 24 INCH STOP BAR, THERMOPLASTIC  
 FERRISBURGH:  
 STA 299+85.12 RT, TH-15  
 646.492 DURABLE LETTER OR SYMBOL, THERMOPLASTIC  
 FERRISBURGH:  
 STA 299+85.12 RT, TH-15 "S,T,O,P" (4-~~EA~~) 8 EA  
 646.682 TEMPORARY 24 INCH STOP BAR, PAINT  
 FERRISBURGH:  
 STA 299+85.12 RT, TH-15  
 646.692 TEMPORARY LETTER OR SYMBOL, PAINT  
 FERRISBURGH:  
 STA 299+85.12 RT, TH-15 "S,T,O,P" (4 EA)

675.50 REMOVING SIGNS  
 AS SHOWN - 5  
 675.60 ERECTING SALVAGED SIGNS  
 AS SHOWN - 1

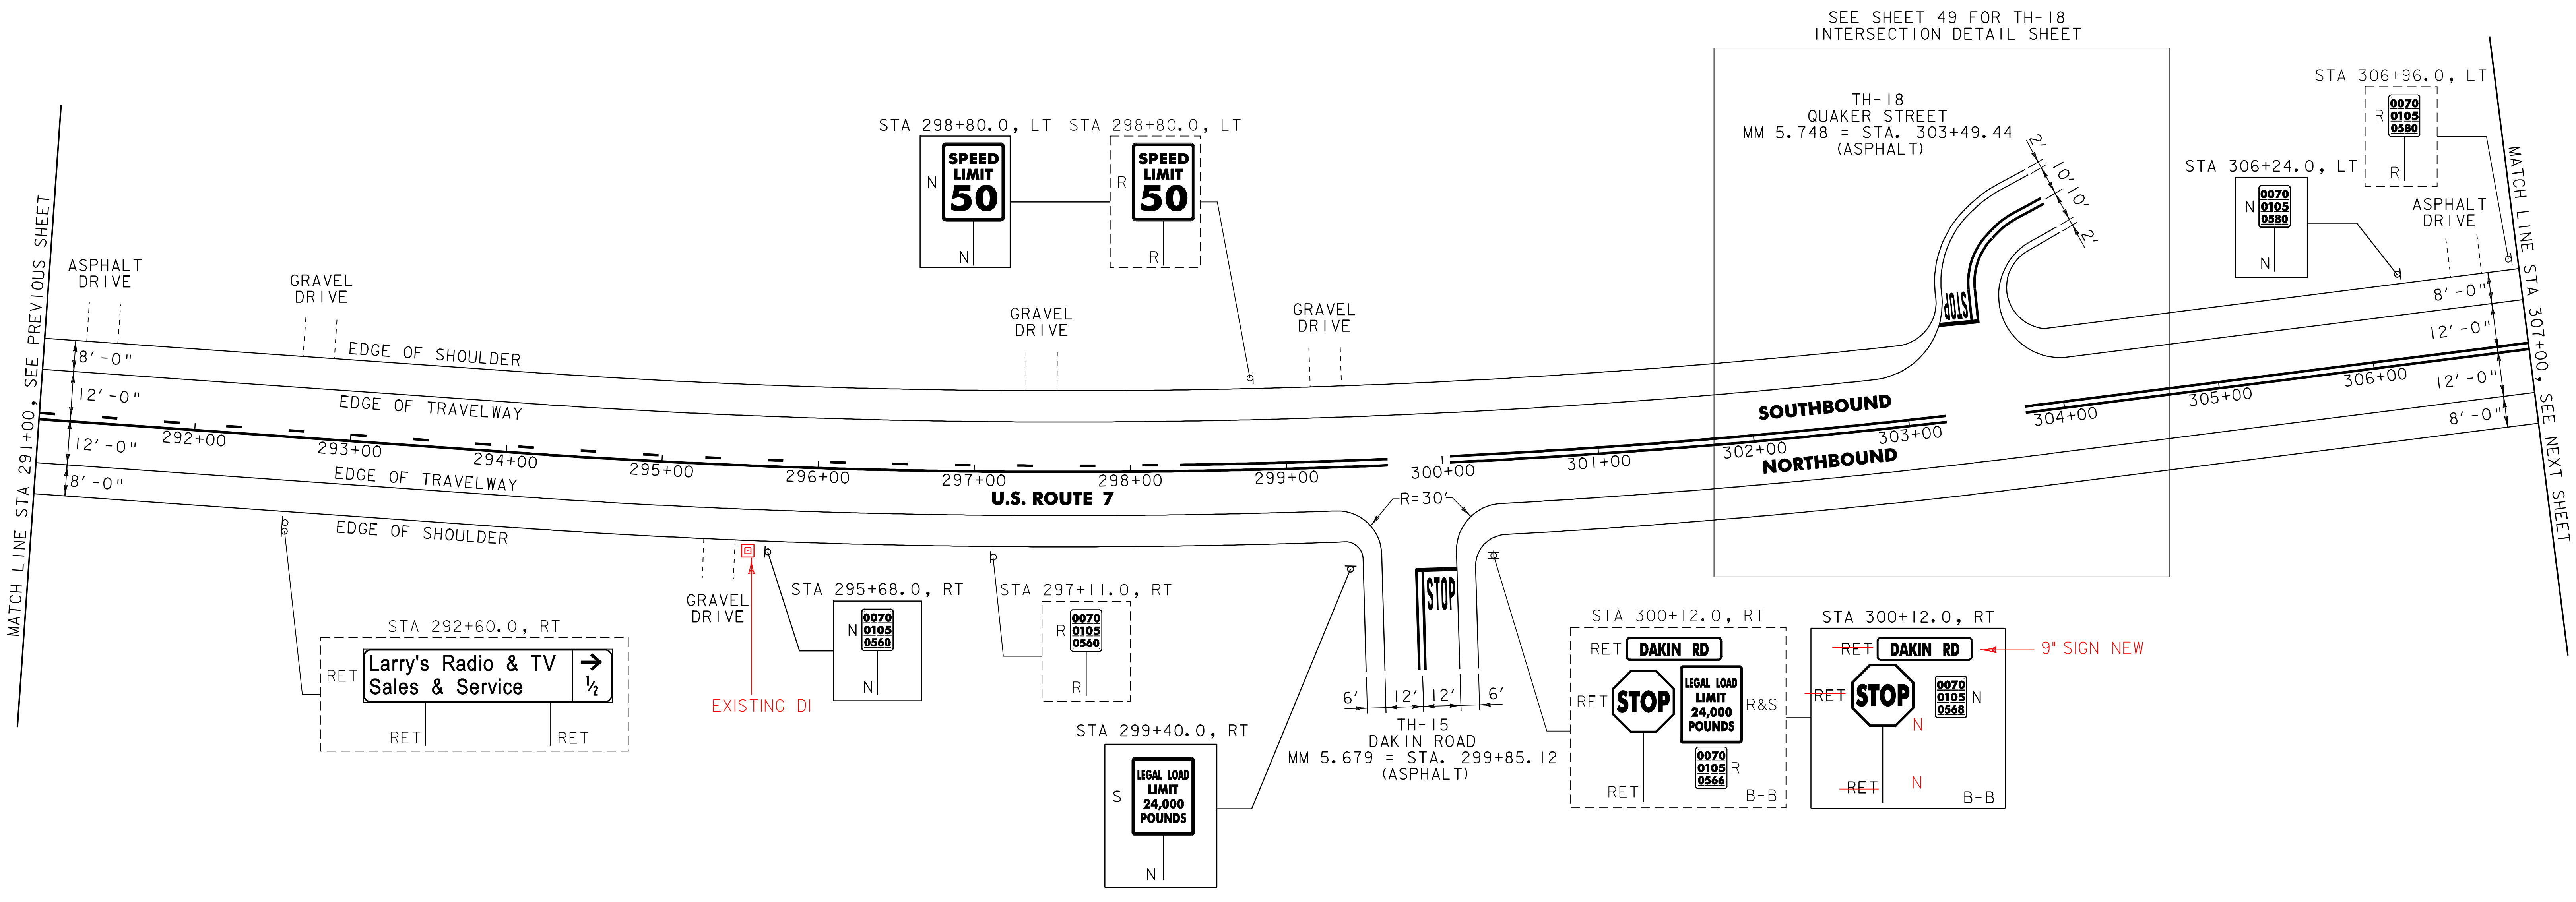

SEE SHEET 49 FOR TH-18 INTERSECTION DETAIL SHEET

MATCH LINE STA 291+00, SEE PREVIOUS SHEET

MATCH LINE STA 307+00, SEE NEXT SHEET

NOTE:  
 1. PAVING LIMIT ON ALL TOWN HIGHWAYS SHALL BE MEASURED 25 FT BACK FROM U.S. ROUTE 7 EDGE OF SHOULDER UNLESS DENOTED OTHERWISE ON THE PLANS OR AS DIRECTED BY THE RESIDENT ENGINEER.

SIGN LEGEND  
 R = REMOVE  
 S = SALVAGE  
 N = NEW  
 RET = RETAIN  
 B-B = BACK TO BACK  
 EXISTING = -----  
 NEW = -----

<b>PROJECT LAYOUT SHEET #30</b>	PROJECT NAME: <u>NEW_HAVEN_-_FERRISBURGH</u>	PLOT DATE: 31-JUL-2009 15
	PROJECT NUMBER: <u>NH_2503(1)S</u>	DRAWN BY: <u>C.A.K.</u>
	FILE NAME: <u>Q5bQ38.dgn</u>	CHECKED BY: <u>D.W.E.</u>
	DESIGNED BY: <u>M.J.M.</u>	SHEET 43 OF 87
	IPARM FILE: <u>p05b038130.i</u>	