


646.402 DURABLE 4 INCH WHITE LINE, THERMOPLASTIC  
 (ALL LINES WILL INCLUDE EDGE LINE BREAKS AND RADIUS FOR TOWN HIGHWAYS)  
 FERRISBURGH:  
 STA 307+00.00 - STA. 323+00.00 EDGE LINE LT & RT  
 646.602 TEMPORARY 4 INCH WHITE LINE, PAINT  
 (ALL LINES WILL INCLUDE EDGE LINE BREAKS AND RADIUS FOR TOWN HIGHWAYS)  
 FERRISBURGH:  
 STA 307+00.00 - STA. 323+00.00 EDGE LINE LT & RT

646.412 DURABLE 4 INCH YELLOW LINE, THERMOPLASTIC  
 (ALL LINES WILL INCLUDE C/L BREAKS FOR TOWN HIGHWAYS) S=SOLID, D=DASHED  
 FERRISBURGH:  
 STA 307+00.00 - STA 312+58.00 LT C RT  
 STA 307+00.00 - STA 312+58.00 S - S  
 STA 312+58.00 - STA 319+97.00 S - D  
 STA 319+97.00 - STA 323+00.00 - D -  
 646.612 TEMPORARY 4 INCH YELLOW LINE, PAINT  
 (ALL LINES WILL INCLUDE C/L BREAKS FOR TOWN HIGHWAYS) S=SOLID, D=DASHED  
 FERRISBURGH:  
 STA 307+00.00 - STA 312+58.00 LT C RT  
 STA 307+00.00 - STA 312+58.00 S - S  
 STA 312+58.00 - STA 319+97.00 S - D  
 STA 319+97.00 - STA 323+00.00 - D -

675.50 REMOVING SIGNS  
 AS SHOWN - I

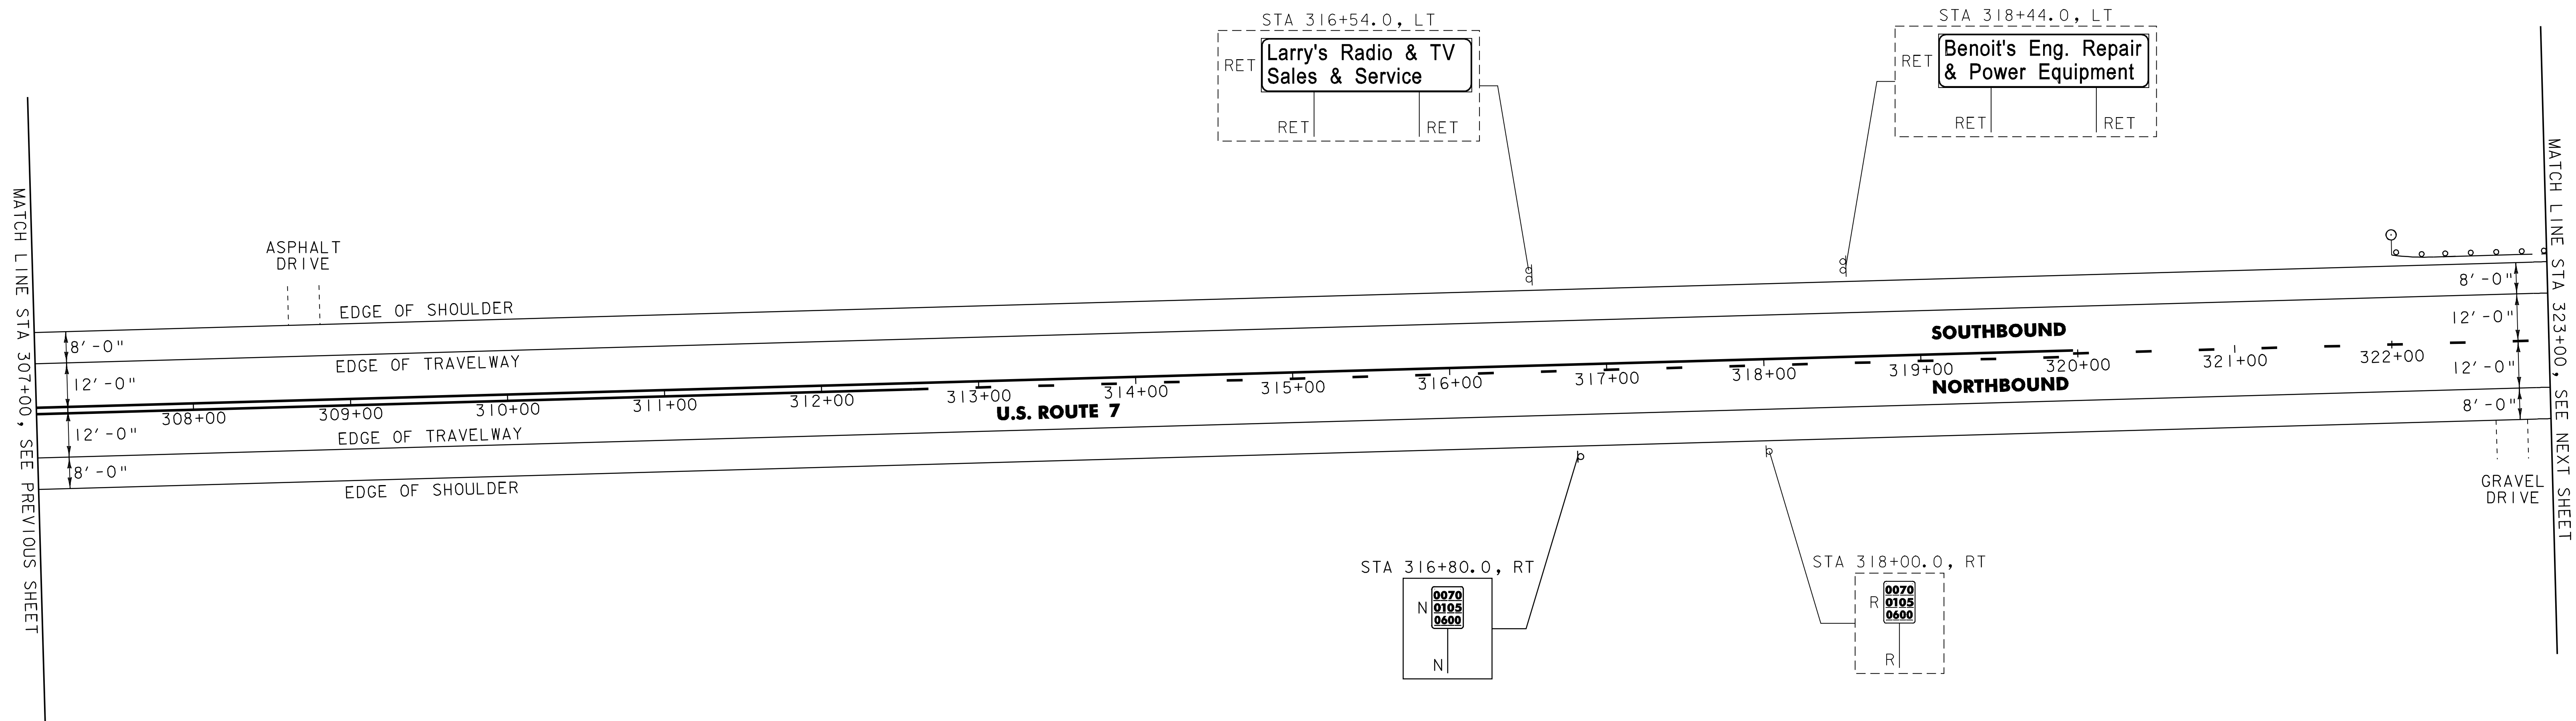

MATCH LINE STA 307+00, SEE PREVIOUS SHEET

MATCH LINE STA 323+00, SEE NEXT SHEET

621.20 STEEL BEAM GUARDRAIL, GALVANIZED

FERRISBURGH:  
 STA 322+39.0 - STA 323+00.0 LT (61.0 LF)

621.50 MANUFACTURED TERMINAL SECTION, FLARED

FERRISBURGH:  
 STA. 322+01.5 - STA 322+39.0 LT

621.80 REMOVAL AND DISPOSAL OF GUARDRAIL

FERRISBURGH:  
 STA 322+02.0 - STA 323+00.0 LT (98.0 LF)

676.10 DELINEATOR WITH STEEL POST

♀ TYPE I WHITE

FERRISBURGH:  
 STA 322+01.5 LT

**SIGN LEGEND**

- R = REMOVE
- S = SALVAGE
- N = NEW
- RET = RETAIN
- B-B = BACK TO BACK
- EXISTING = -----
- NEW = \_\_\_\_\_

**NOT TO SCALE**

<b>PROJECT LAYOUT SHEET #31</b>	PROJECT NAME: <u>NEW HAVEN - FERRISBURGH</u>
	PROJECT NUMBER: <u>NH_2503(I)S</u>
	FILE NAME: <u>Q5b038.dgn</u>
	IPARM FILE: <u>Q05b038I31.i</u>
	PLOT DATE: 31-JUL-2009 15
	DRAWN BY: <u>C.A.K.</u>
	CHECKED BY: <u>D.W.E.</u>
	SHEET 44 OF 87