


646.402 DURABLE 4 INCH WHITE LINE, THERMOPLASTIC
 (ALL LINES WILL INCLUDE EDGE LINE BREAKS AND
 RADIUS FOR TOWN HIGHWAYS)
 FERRISBURGH:
 STA 323+00.00 - STA. 339+00.00 EDGE LINE LT & RT

646.412 DURABLE 4 INCH YELLOW LINE, THERMOPLASTIC
 (ALL LINES WILL INCLUDE C/L BREAKS FOR
 TOWN HIGHWAYS) S=SOLID, D=DASHED
 FERRISBURGH:
 STA 323+00.00 - STA 325+25.00 LT C RT -
 STA 325+25.00 - STA 331+05.00 D - S
 STA 331+05.00 - STA 339+00.00 S - S

646.482 DURABLE 24 INCH STOP BAR, THERMOPLASTIC
 FERRISBURGH:
 STA 332+69.28 LT, TH-I8
 646.492 DURABLE LETTER OR SYMBOL, THERMOPLASTIC
 FERRISBURGH:
 STA 332+69.28 LT, TH-I8 "S,T,O,P" (4 EA)

646.682 TEMPORARY 24 INCH STOP BAR, PAINT
 FERRISBURGH:
 STA 332+69.28 LT, TH-I8
 646.692 TEMPORARY LETTER OR SYMBOL, PAINT
 FERRISBURGH:
 STA 332+69.28 LT, TH-I8 "S,T,O,P" (4 EA)

675.50 REMOVING SIGNS
 AS SHOWN - II
 675.60 ERECTING SALVAGED SIGNS
 AS SHOWN - I

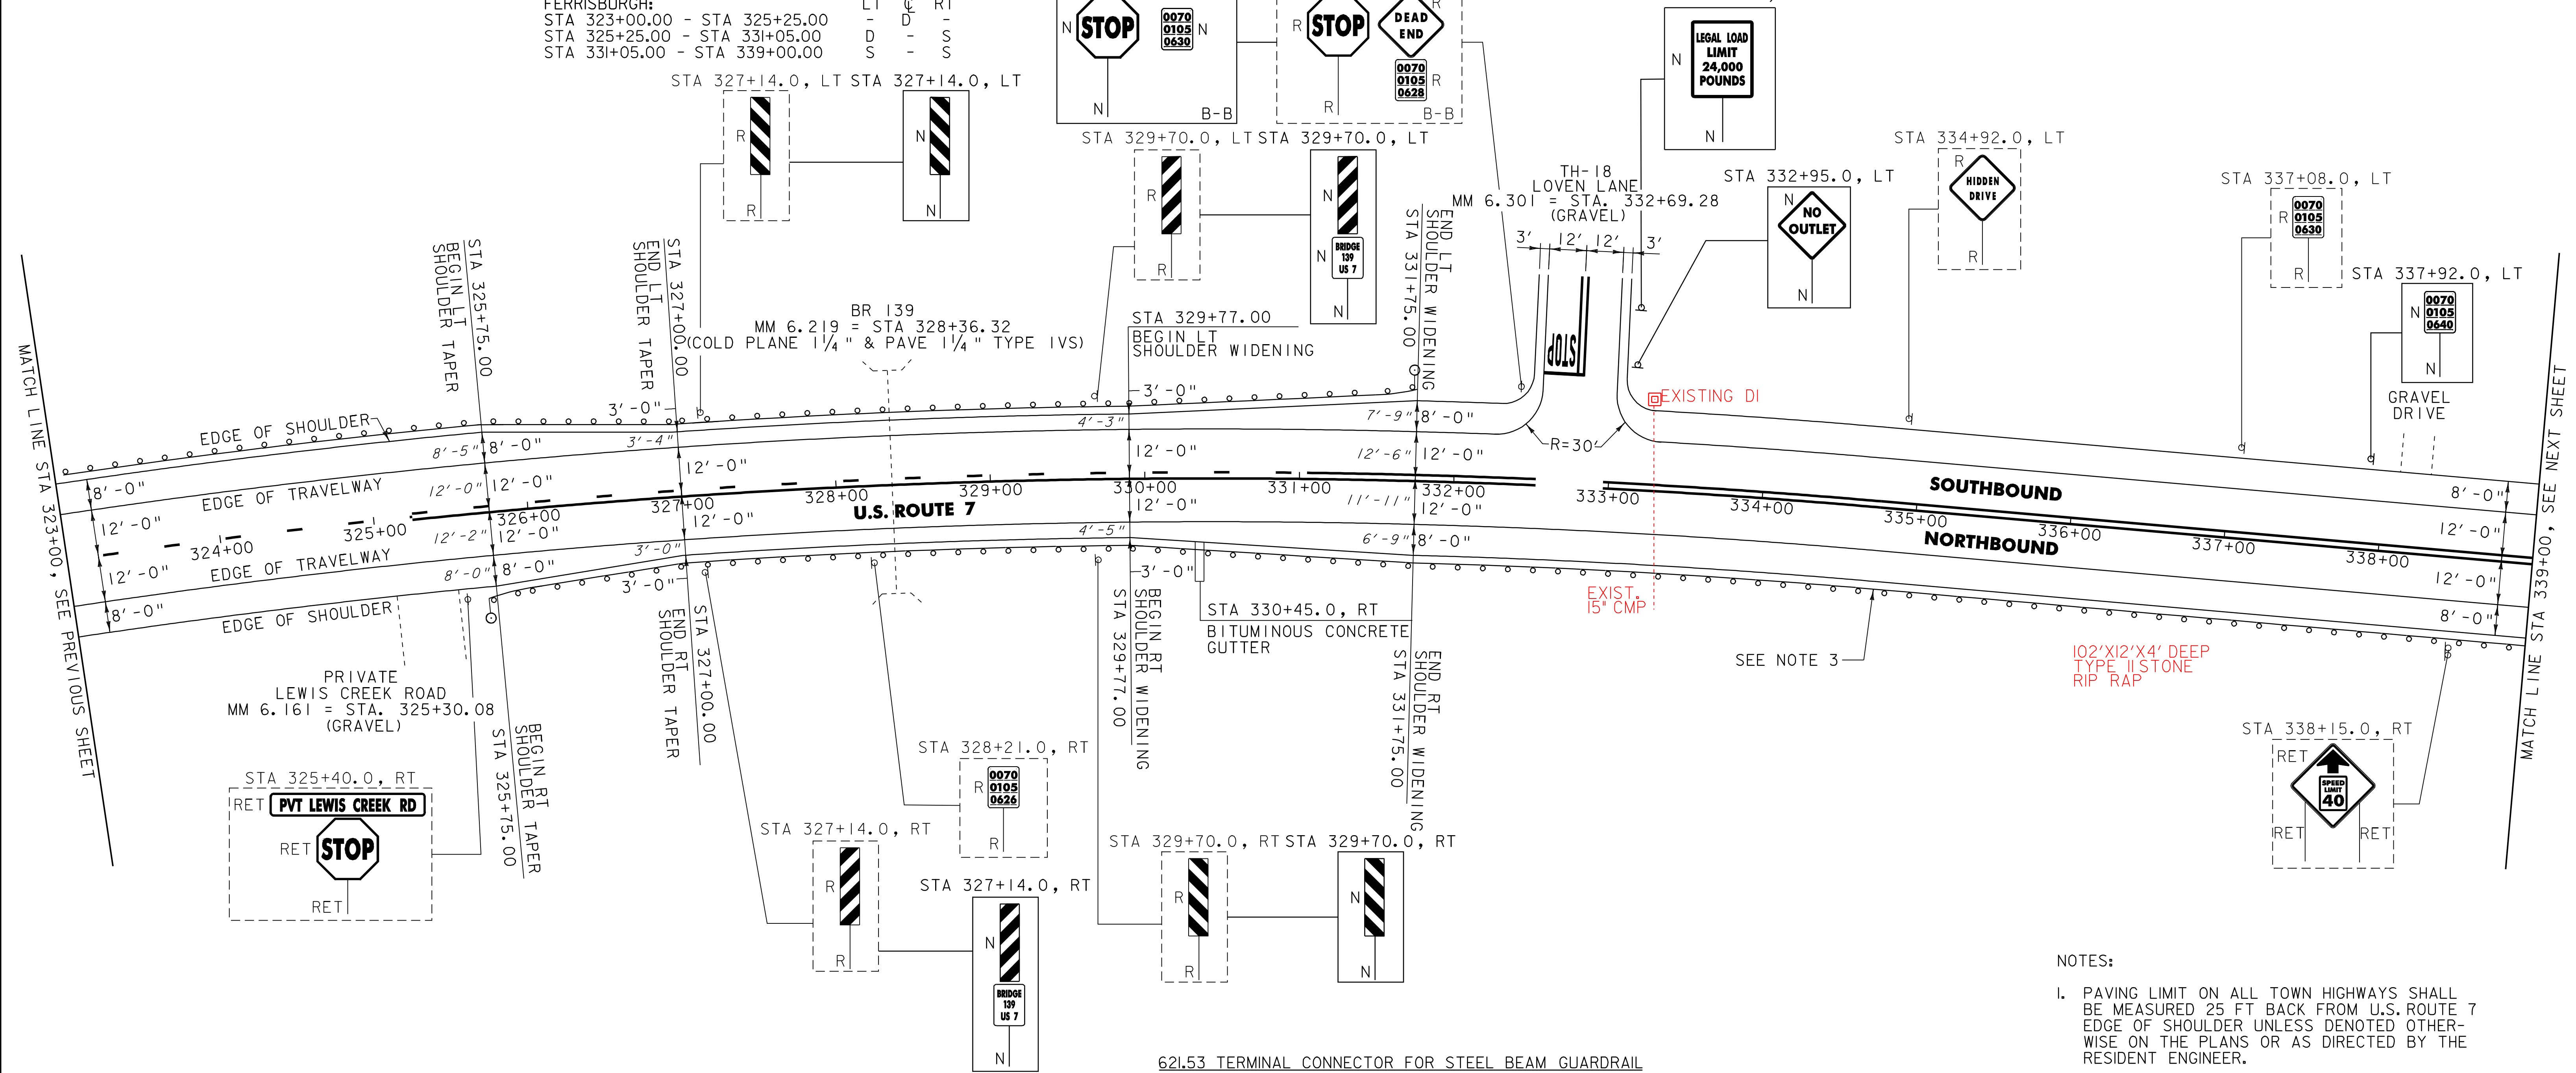

616.35 TREATED TIMBER CURB
 FERRISBURGH:
 STA 330+45.0 - STA 339+00.0 RT (855.0 LF)
 616.47 BITUMINOUS CONCRTE GUTTERS AND TRAFFIC ISLANDS
 FERRISBURGH:
 STA 330+45.0 RT (6.0 TONS)
 621.20 STEEL BEAM GUARDRAIL, GALVANIZED
 FERRISBURGH:
 STA 323+00.0 - STA 326+64.0 LT (364.0 LF)
 STA 326+07.5 - STA 326+95.0 RT (87.5 LF)
 STA 329+88.0 - STA 331+38.0 LT (150.0 LF)

621.205 STEEL BEAM GUARDRAIL, GALVANIZED W/8 FEET POST
 FERRISBURGH:
 STA 330+22.0 - STA 339+00.0 RT (878.0 LF)
 621.21 HD STEEL BEAM GUARDRAIL, GALVANIZED
 FERRISBURGH:
 STA 326+64.0 - STA 326+89.0 LT (25.0 LF)
 STA 326+95.0 - STA 327+20.0 RT (25.0 LF)
 STA 329+63.0 - STA 329+88.0 LT (25.0 LF)
 STA 329+97.0 - STA 330+22.0 RT (25.0 LF)
 621.50 MANUFACTURED TERMINAL SECTION, FLARED
 FERRISBURGH:
 STA 325+70.0 - STA 326+07.5 RT
 STA 331+38.0 - STA 331+75.5 LT

621.53 TERMINAL CONNECTOR FOR STEEL BEAM GUARDRAIL
 FERRISBURGH:
 STA 326+89.0 - STA 326+91.0 LT
 STA 327+20.0 - STA 327+22.0 RT
 STA 329+61.0 - STA 329+63.0 LT
 STA 329+95.0 - STA 329+97.0 RT
 621.80 REMOVAL AND DISPOSAL OF GUARDRAIL
 FERRISBURGH:
 STA 323+00.0 - STA 326+89.0 LT (389.0 LF)
 STA 326+27.0 - STA 327+20.0 RT (93.0 LF)
 STA 329+63.0 - STA 331+73.0 LT (210.0 LF)
 STA 329+97.0 - STA 339+00.0 RT (903.0 LF)
 676.10 DELINEATOR WITH STEEL POST
 ♀ TYPE I WHITE
 FERRISBURGH:
 STA 325+70.0 RT
 STA 331+75.5 LT

- NOTES:
- PAVING LIMIT ON ALL TOWN HIGHWAYS SHALL BE MEASURED 25 FT BACK FROM U.S. ROUTE 7 EDGE OF SHOULDER UNLESS DENOTED OTHERWISE ON THE PLANS OR AS DIRECTED BY THE RESIDENT ENGINEER.
 - SEE SHEET 85 FOR BR 139 DETAILS.
 - THE CONTRACTOR SHALL REPAIR THE EXISTING SIDE SLOPE BETWEEN STA 333+00 RT TO STA 339+00 RT AS DIRECTED BY THE RESIDENT ENGINEER. AN ESTIMATED QUANTITY OF ITEM 613.11 STONE FILL, TYPE II HAS BEEN INCLUDED FOR THESE REPAIRS AND SHALL BE USED AS DIRECTED BY THE RESIDENT ENGINEER.

SIGN LEGEND
 R = REMOVE
 S = SALVAGE
 N = NEW
 RET = RETAIN
 B-B = BACK TO BACK
 EXISTING = -----
 NEW = _____

NOT TO SCALE
PROJECT LAYOUT SHEET #32

PROJECT NAME: NEW HAVEN - FERRISBURGH
 PROJECT NUMBER: NH_2503(1)S
 FILE NAME: Q5b038.dgn PLOT DATE: 31-JUL-2009 15
 PROJECT LEADER: D.E.G. DRAWN BY: C.A.K.
 DESIGNED BY: M.J.M. CHECKED BY: D.W.E.
 IPARM FILE: p05b038j32.i SHEET 45 OF 87