


646.402 DURABLE 4 INCH WHITE LINE, THERMOPLASTIC
 (ALL LINES WILL INCLUDE EDGE LINE BREAKS AND RADIUS FOR TOWN HIGHWAYS)
 FERRISBURGH:
 STA 339+00.00 - STA. 355+00.00 EDGE LINE LT & RT
 646.602 TEMPORARY 4 INCH WHITE LINE, PAINT
 (ALL LINES WILL INCLUDE EDGE LINE BREAKS AND RADIUS FOR TOWN HIGHWAYS)
 FERRISBURGH:
 STA 339+00.00 - STA. 355+00.00 EDGE LINE LT & RT

646.412 DURABLE 4 INCH YELLOW LINE, THERMOPLASTIC
 (ALL LINES WILL INCLUDE C/L BREAKS FOR TOWN HIGHWAYS) S=SOLID, D=DASHED
 FERRISBURGH:
 STA 339+00.00 - STA 355+00.00 LT C RT S - S
 646.612 TEMPORARY 4 INCH YELLOW LINE, PAINT
 (ALL LINES WILL INCLUDE C/L BREAKS FOR TOWN HIGHWAYS) S=SOLID, D=DASHED
 FERRISBURGH:
 STA 339+00.00 - STA 355+00.00 LT C RT S - S

675.50 REMOVING SIGNS
 AS SHOWN - 3
 675.60 ERECTING SALVAGED SIGNS
 AS SHOWN - 1

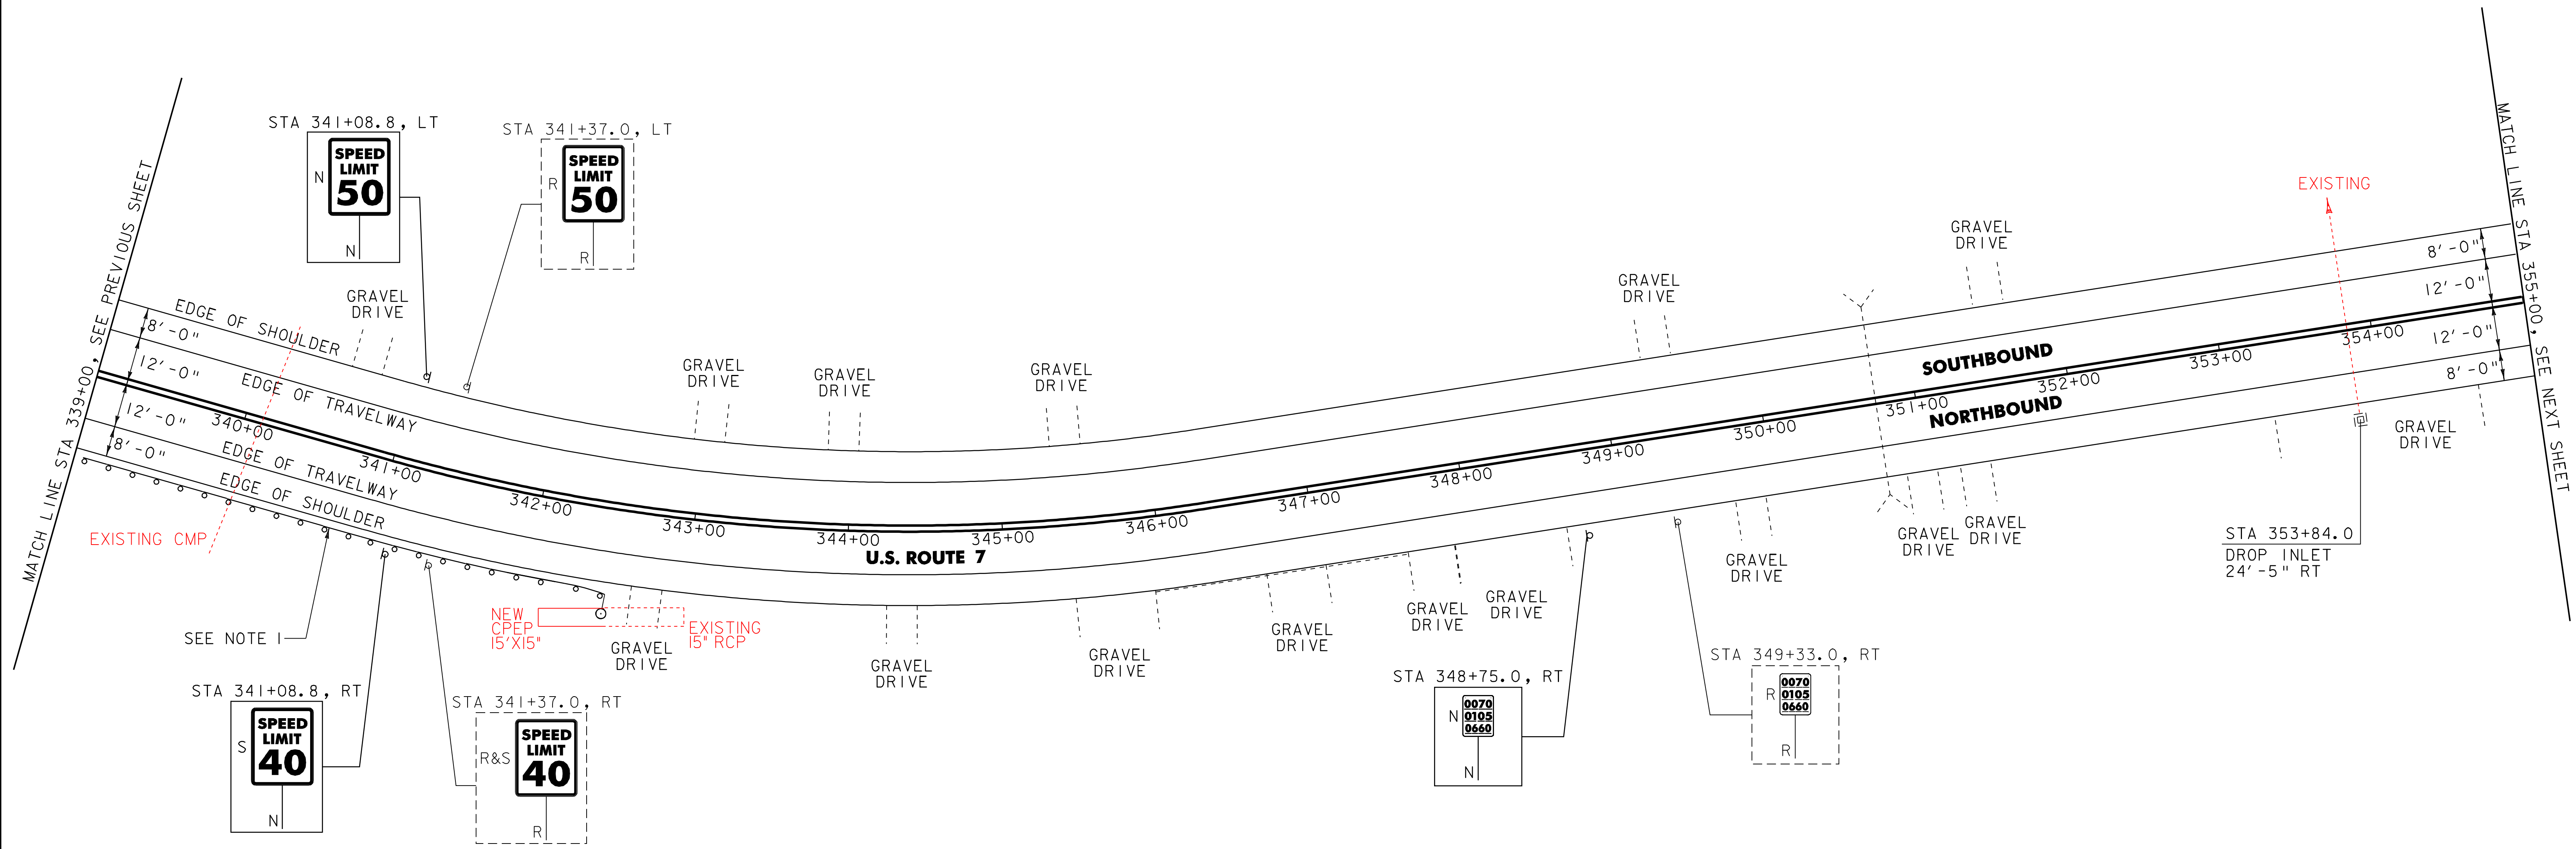

604.412 REHAB. DROP INLETS, CATCH BASINS OR MANHOLES, CLASS I
 FERRISBURGH:
 STA 353+84.0 RT
 616.35 TREATED TIMBER CURB
 FERRISBURGH:
 STA 339+00.0 - STA 342+20.0 RT (320.0 LF)
 621.205 STEEL BEAM GUARDRAIL, GALVANIZED W/8 FEET POSTS
 FERRISBURGH:
 STA 339+00.0 - STA 342+22.0 RT (322.0 LF)

621.50 MANUFACTURED TERMINAL SECTION, FLARED
 FERRISBURGH:
 STA 342+22.0 - STA 342+59.5 RT
 621.80 REMOVAL AND DISPOSAL OF GUARDRAIL
 FERRISBURGH:
 STA 339+00.0 - STA 342+51.0 RT (351.0 LF)
 676.10 DELINEATOR WITH STEEL POST
 ♯ TYPE I WHITE
 FERRISBURGH:
 STA 342+59.5 RT

SIGN LEGEND
 R = REMOVE
 S = SALVAGE
 N = NEW
 RET = RETAIN
 B-B = BACK TO BACK
 EXISTING = - - - - -
 NEW = _____

NOTE:
 I. STONE FILL, TYPE II SHALL BE PLACE ALONG THE EXISTING SIDE SLOPE BETWEEN STA 333+00 RT TO STA 339+00 RT AS DIRECTED BY THE RESIDENT ENGINEER.

PROJECT LAYOUT SHEET #33	PROJECT NAME: <u>NEW_HAVEN_-_FERRISBURGH</u>	PLOT DATE: 31-JUL-2009 15
	PROJECT NUMBER: <u>NH_2503(I)S</u>	DRAWN BY: <u>C.A.K.</u>
	FILE NAME: <u>Q5b038.dgn</u>	CHECKED BY: <u>D.W.E.</u>
	DESIGNED BY: <u>M.J.M.</u>	SHEET 46 OF 87