

646.412 DURABLE 4 INCH YELLOW LINE, THERMOPLASTIC
 (ALL LINES WILL INCLUDE C/L BREAKS FOR TOWN HIGHWAYS) S=SOLID, D=DASHED

FERRISBURGH STATE HIGHWAY:
 STA 0+00.00 - 7+53.00 DOUBLE SOLID LT,

646.612 TEMPORARY 4 INCH YELLOW LINE, PAINT
 (ALL LINES WILL INCLUDE C/L BREAKS FOR TOWN HIGHWAYS) S=SOLID, D=DASHED
 FERRISBURGH STATE HIGHWAY:
 STA 0+00.00 - 7+53.00 DOUBLE SOLID LT,

646.492 DURABLE LETTER OR SYMBOL, THERMOPLASTIC

FERRISBURGH STATE HIGHWAY:
 STA 5+83.00 LT, "A,H,E,A,D" (5 EA)
 STA 6+15.00 LT, "S,T,O,P" (4 EA)

646.692 TEMPORARY LETTER OR SYMBOL, PAINT

FERRISBURGH STATE HIGHWAY:
 STA 5+83.00 LT, "A,H,E,A,D" (5 EA)
 STA 6+15.00 LT, "S,T,O,P" (4 EA)

675.50 REMOVALS 13 EA
 675.301 FLANGE CH SIGN POSTS

646.402 DURABLE 4 INCH WHITE LINE, THERMOPLASTIC

FERRISBURGH STATE HIGHWAY:
 STA 0+00.00 - 7+53.00 SOLID LT. & RT.

646.602 TEMPORARY 4 INCH WHITE LINE, PAINT

FERRISBURGH STATE HIGHWAY:
 STA 0+00.00 - 7+53.00 SOLID LT. & RT.

675.50 REMOVING SIGNS

AS SHOWN - (14)

621.20 STEEL BEAM GUARDRAIL, GALVANIZED


FERRISBURGH STATE HIGHWAY:
 STA 0+62.50 - STA 2+50.0 LT (187.5 LF)
 STA 0+00.00 - STA 3+12.5 RT (312.5 LF)

621.50 MANUFACTURED TERMINAL SECTION, FLARED

FERRISBURGH STATE HIGHWAY:
 STA 0+25.0 - STA 0+62.5 LT
 STA 2+50.0 - STA 2+87.5 LT
 STA 3+12.5.00 - STA 3+50.00 RT

621.80 REMOVAL AND DISPOSAL OF GUARDRAIL

FERRISBURGH STATE HIGHWAY:
 STA 0+00.0 - STA 2+62.5 LT (262.5 LF)
 STA 0+00.0 - STA 3+50.0 RT (350.0 LF)

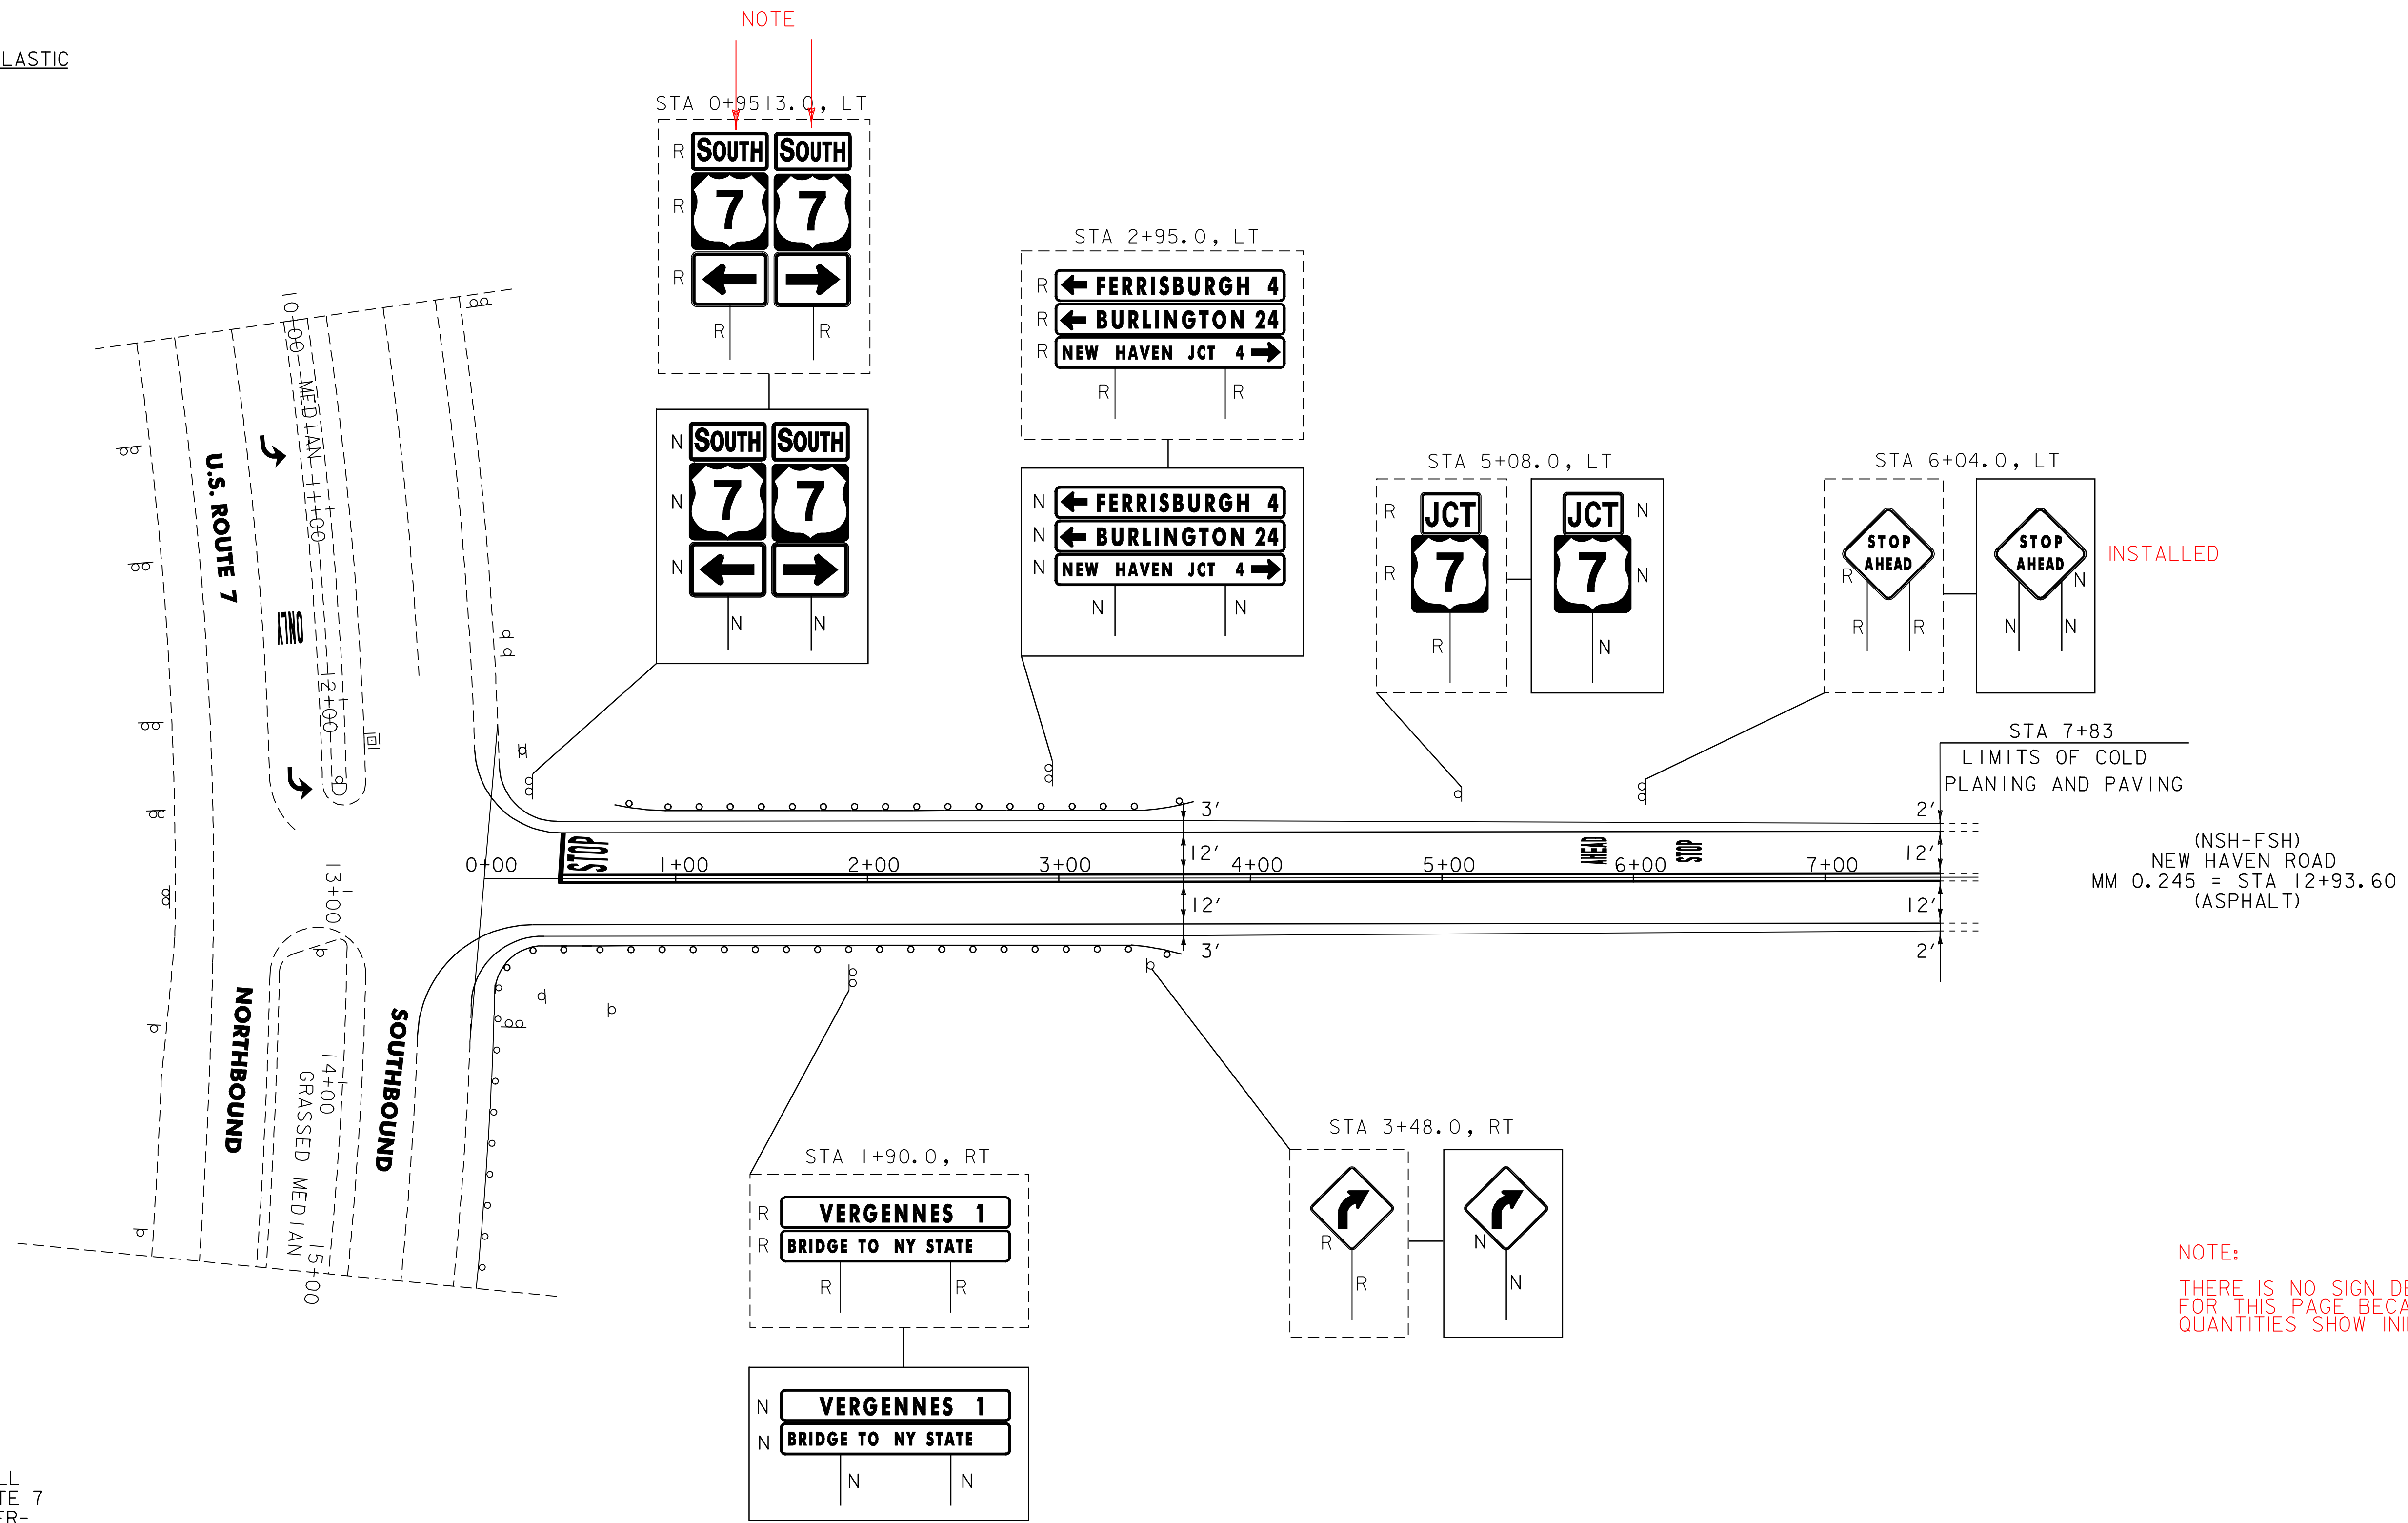

INSTALLED

NOTE:
 THERE IS NO SIGN DETAIL SHEET FOR THIS PAGE BECAUSE NO QUANTITIES SHOW IN IN BID QUANTITIES.

- NOTES:
- PAVING LIMIT ON ALL TOWN HIGHWAYS SHALL BE MEASURED 25 FT BACK FROM U.S. ROUTE 7 EDGE OF SHOULDER UNLESS DENOTED OTHERWISE ON THE PLANS OR AS DIRECTED BY THE RESIDENT ENGINEER.
 - REMOVE EXISTING GUARDRAIL AND GUARDRAIL END SECTION AND INSTALL NEW MANUFACTURED TERMINAL SECTION, FLARED AND GUARDRAIL AS DIRECTED BY THE RESIDENT ENGINEER. THE CONTRACTOR SHALL CONNECT TO EXISTING RAIL ALONG NSH-FSH BY INSTALLING A NEW 16' RADIUS PANEL WITH ANCHORS AT EACH END AS DIRECTED BY THE RESIDENT ENGINEER.

SIGN LEGEND
 R = REMOVE
 S = SALVAGE
 N = NEW
 RET = RETAIN
 B-B = BACK TO BACK
 EXISTING = -----
 NEW = _____

NOT TO SCALE FERRISBURGH STATE HIGHWAY DETAIL SHEET	PROJECT NAME: <u>NEW HAVEN - FERRISBURGH</u>
	PROJECT NUMBER: <u>NH_2503(1)S</u>
	FILE NAME: <u>Q5b038.dgn</u>
	IPARM FILE: <u>Q5b038intg.i</u>
	PLOT DATE: 31-JUL-2009 15
	DRAWN BY: <u>J.L.B.</u>
	CHECKED BY: <u>L.S.W.</u>
	SHEET 49A OF 87