


INDEX OF SHEETS
SEE SHEET 2

STATE OF VERMONT
AGENCY OF TRANSPORTATION





PROPOSED IMPROVEMENT & INTERSECTION RECONSTRUCTION
TOWN OF WILMINGTON
COUNTY OF WINDHAM
VT.ROUTE 9 & VT.ROUTE 100

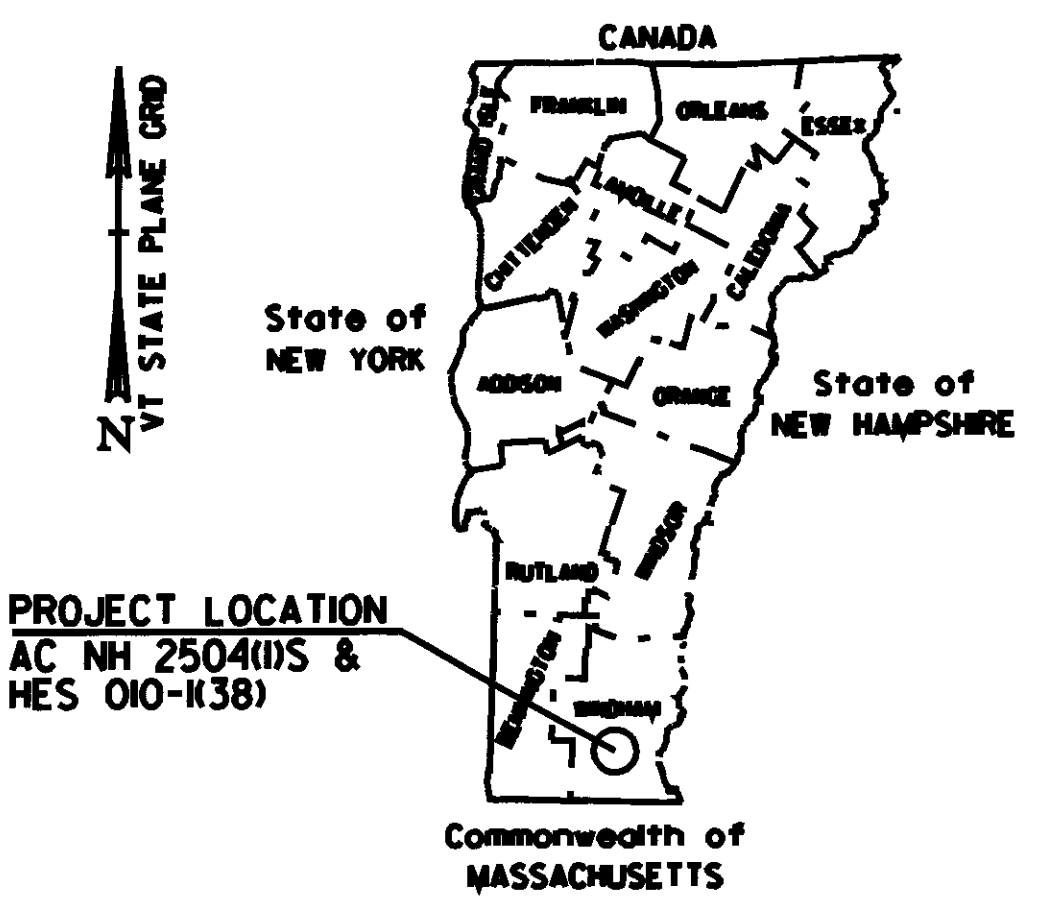

WILMINGTON
AC NH 2504(1)S
SEE SHEET 6
FOR ADDITIONAL PROJECT INFORMATION
AND THE SUPERPAVE DESIGN CRITERIA

WILMINGTON
HES 010-1(38)
SEE SHEET 79
FOR ADDITIONAL PROJECT INFORMATION

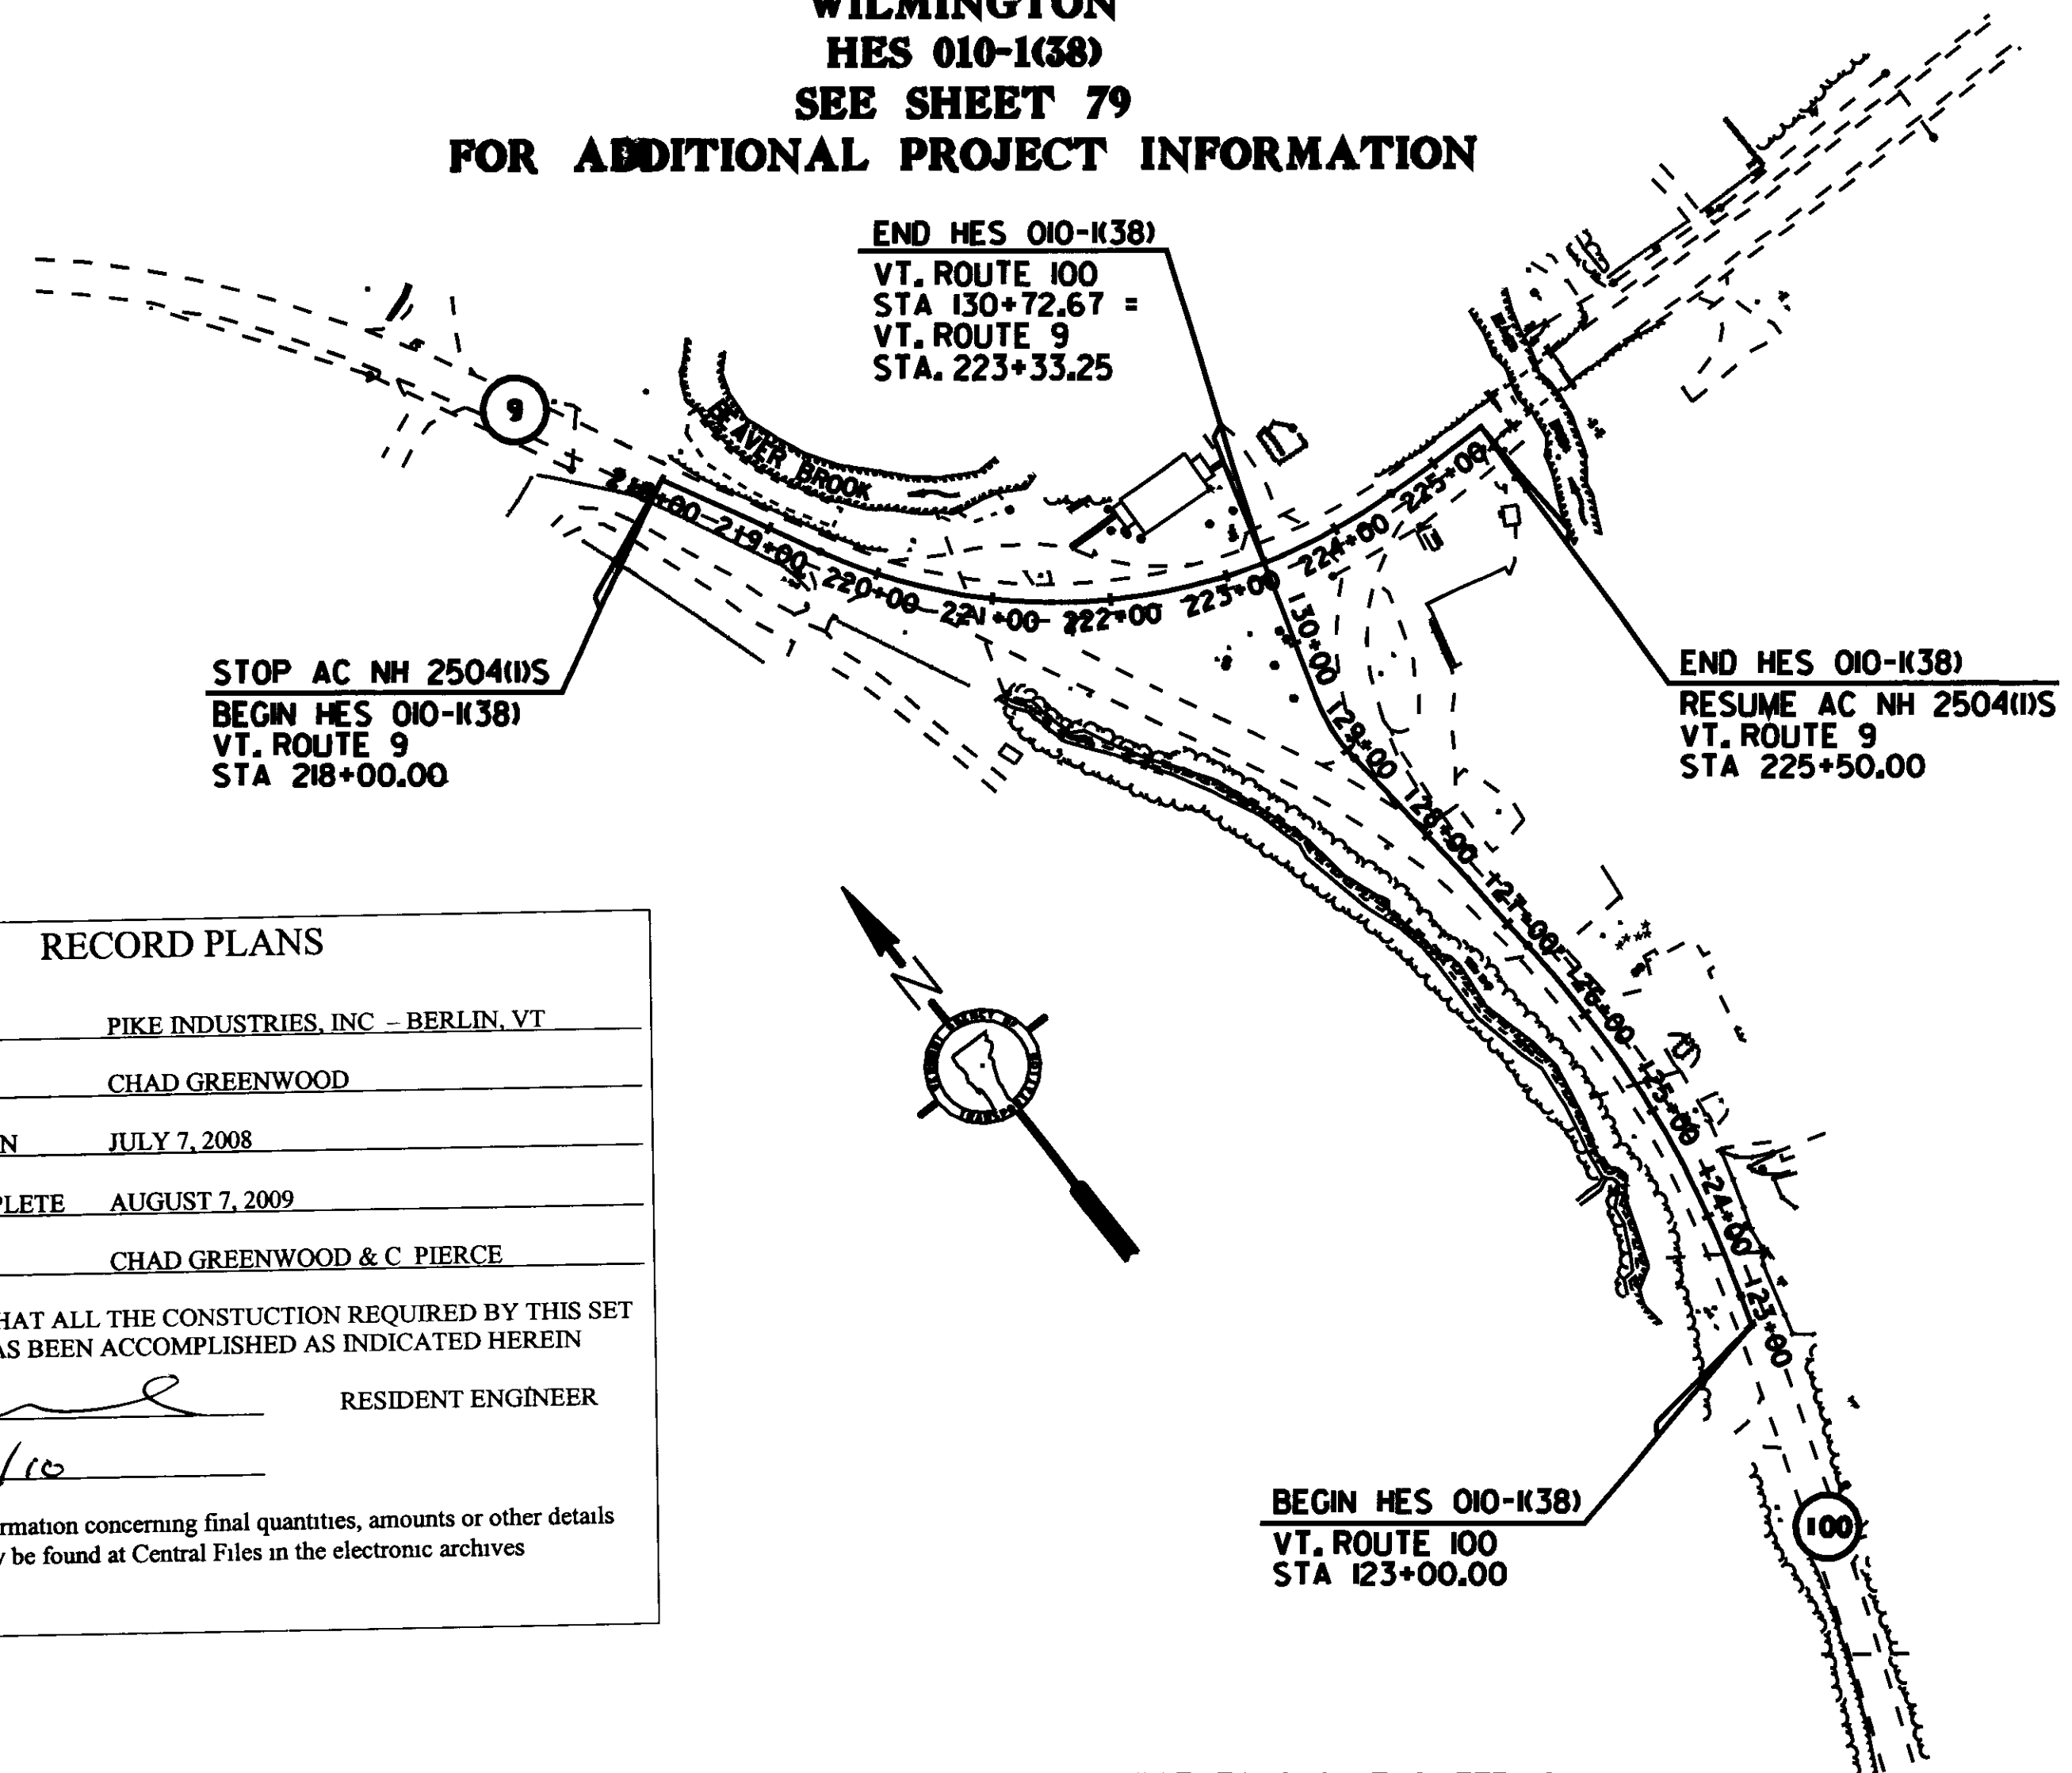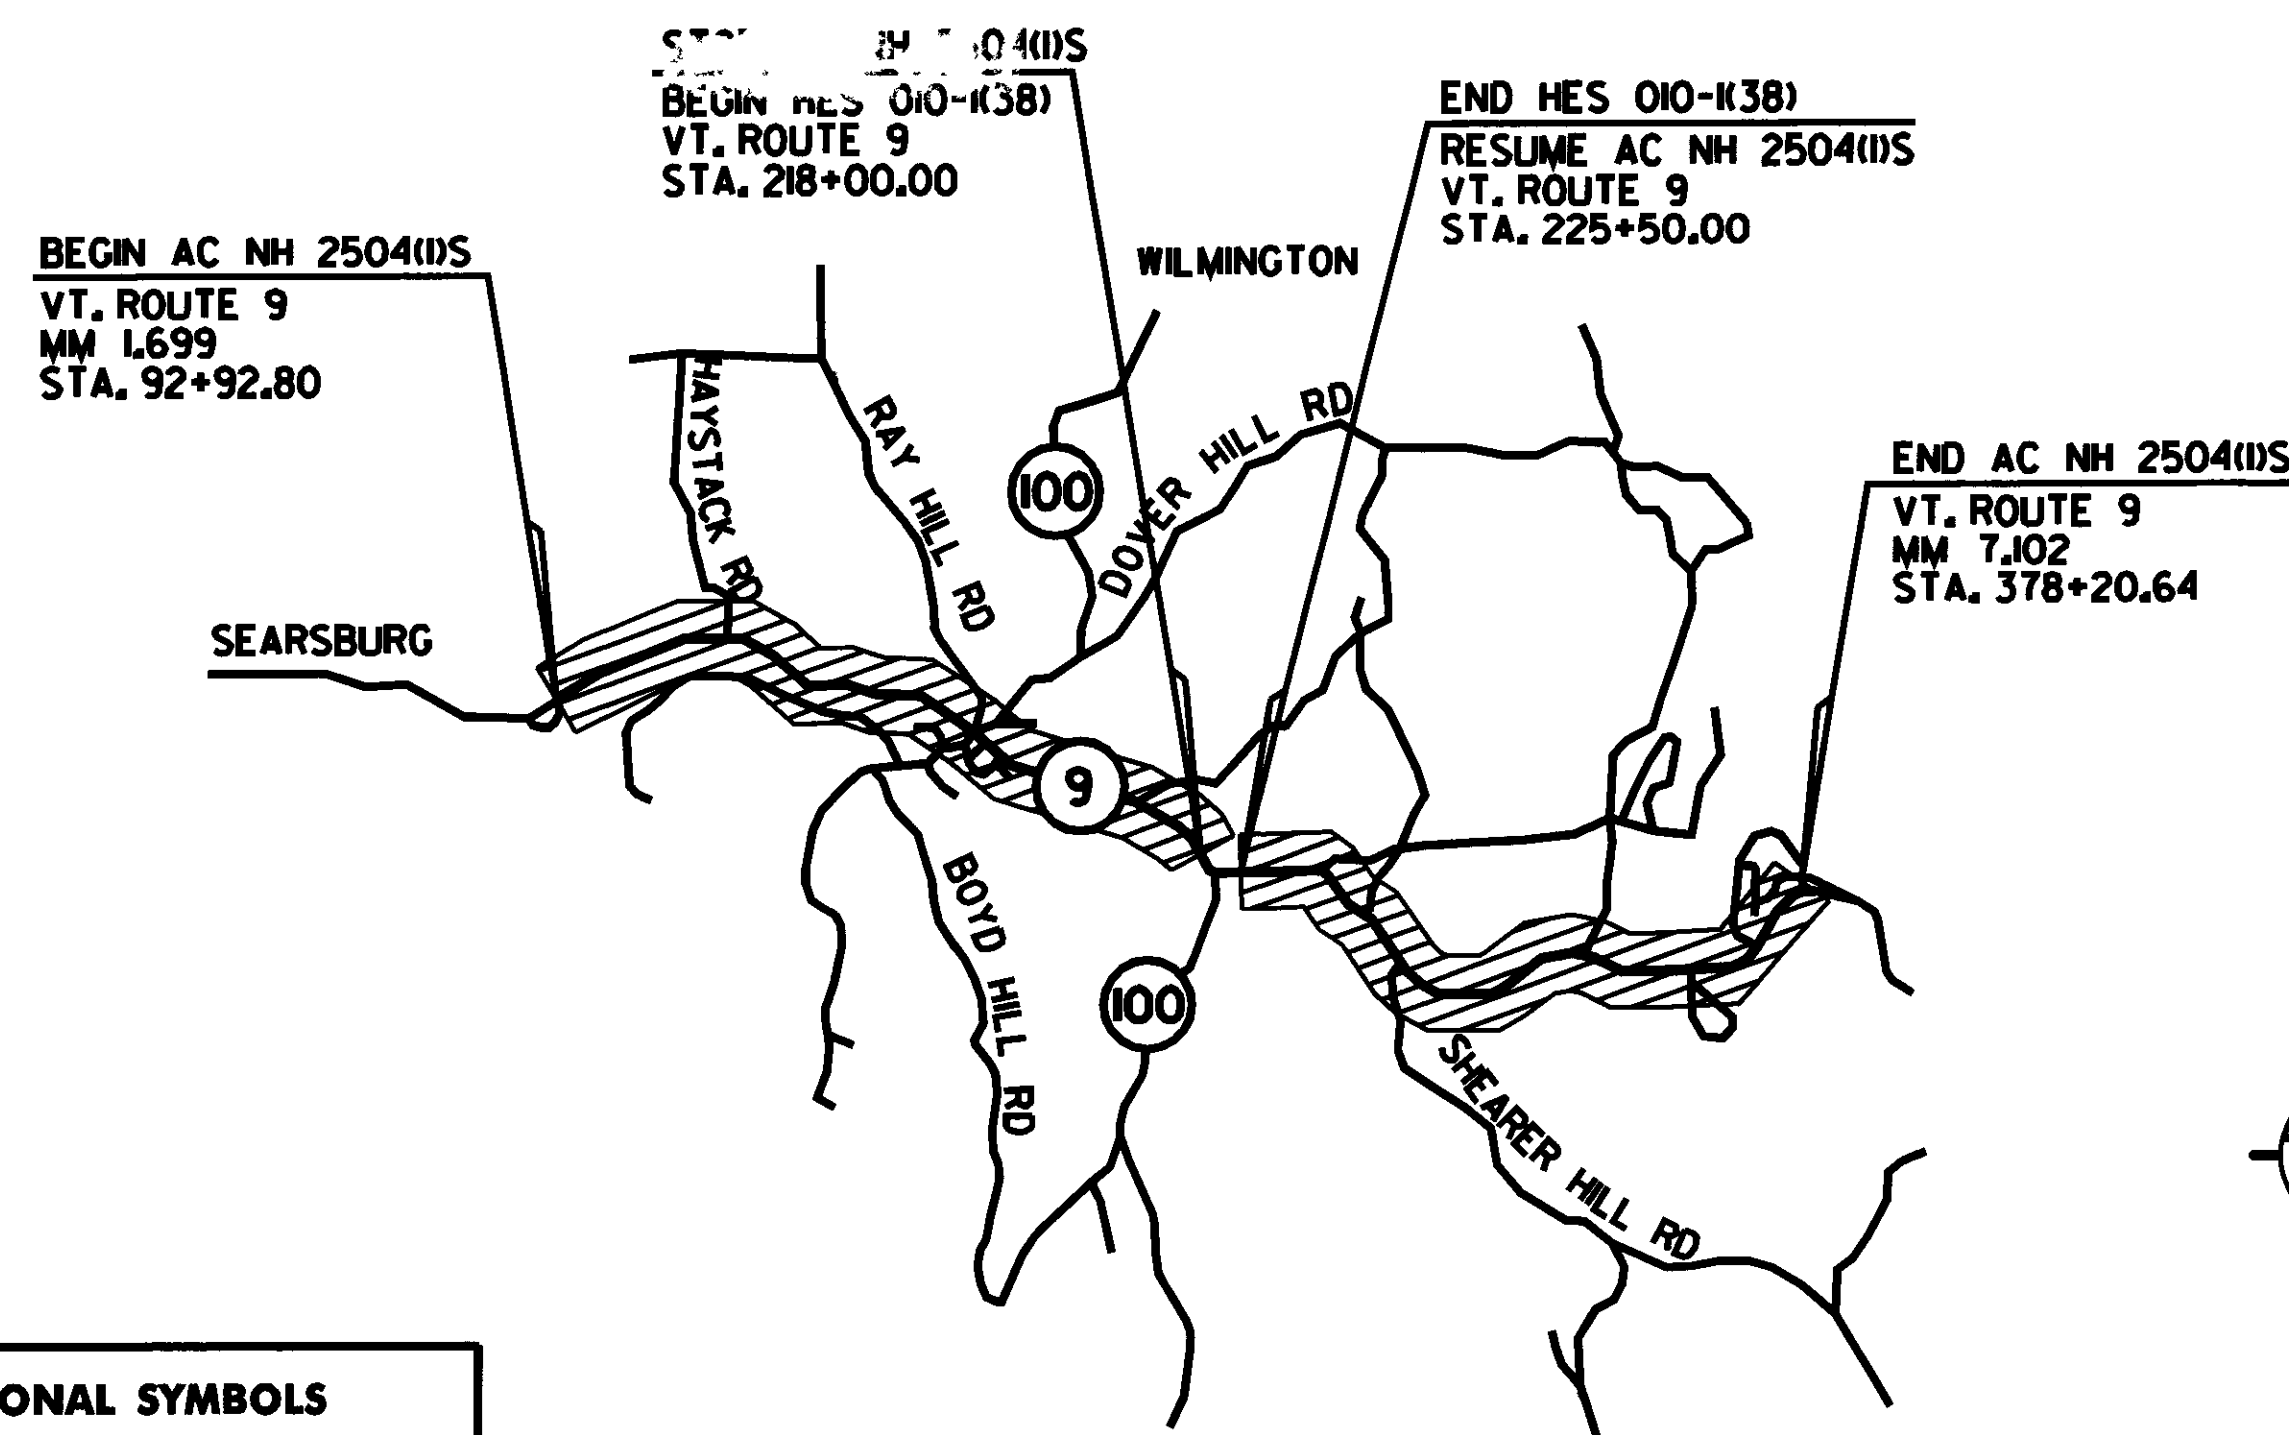

RECORD PLANS

CONTRACTOR	PIKE INDUSTRIES, INC - BERLIN, VT
RESIDENT ENGINEER	CHAD GREENWOOD
CONSTRUCTION BEGAN	JULY 7, 2008
CONSTRUCTION COMPLETE	AUGUST 7, 2009
RECORD PLANS BY	CHAD GREENWOOD & C PIERCE

I HEREBY CERTIFY THAT ALL THE CONSTRUCTION REQUIRED BY THIS SET OF DRAWINGS HAS BEEN ACCOMPLISHED AS INDICATED HEREIN

BY *Chad Greenwood* RESIDENT ENGINEER
DATE *6/8/10*

NOTE Any further information concerning final quantities, amounts or other details relative to this project may be found at Central Files in the electronic archives

CONVENTIONAL SYMBOLS

COUNTY LINE	---
TOWN LINE	---
LIMITS OF ACCESS	---
POINT OF ACCESS	X
FENCE LINE	X-X-X-X-X
STONE WALL	o-o-o-o-o-o-o-o-o-o
TRAVELED WAY	---
GUARD RAIL	o-o-o-o-o-o-o-o-o-o
RAILROAD	---
SURVEY LINE	---
CULVERT	---
POWER POLE	o
TELEPHONE POLE	o
TREES	o
CONTROL OF ACCESS	---
PROPERTY LINE	---
FLOW TAKING LINE	SR
SLOPE RIGHTS	SR
TOP OF CUT	---
TOE OF SLOPE	---

SURVEYED BY : NA
SURVEYED DATE : NA

DATUM
VERTICAL : NA
HORIZONTAL :

PLANS PREPARED BY

CHA
CLOUGH HARBOUR & ASSOCIATES LLP
111 Winners Circle, PO Box 5289 • Albany, NY 12205-0289
Main (518) 433-4500 • www.cloughharbour.com

THESE PLANS ARE SUBJECT TO SUCH ENGINEERING CHANGES AS MAY BE REQUIRED BY THE FEDERAL HIGHWAY ADMINISTRATION OR THE DIRECTOR OF PROGRAM DEVELOPMENT.

CONSTRUCTION IS TO BE CARRIED ON IN ACCORDANCE WITH THESE PLANS AND THE STANDARD SPECIFICATIONS FOR CONSTRUCTION DATED 2006, AS APPROVED BY THE FEDERAL HIGHWAY ADMINISTRATION ON JUNE 15, 2006 FOR USE ON THIS PROJECT, INCLUDING ALL SUBSEQUENT REVISIONS AND SUCH REVISED SPECIFICATIONS AND SPECIAL PROVISIONS AS ARE INCORPORATED IN THESE PLANS.

DIRECTOR OF PROGRAM DEVELOPMENT	
APPROVED <i>Ted Domey</i>	DATE <i>3-28-08</i>
PROJECT MANAGER : TED DOMEY	
PROJECT NAME : WILMINGTON	
PROJECT NUMBER : AC NH 2504(1)S & HES 010-1(38)	
SHEET 1 OF 125 SHEETS	

FILE NAME : I:\PROJECTS\WILMINGTON_2008\comp\comp.dgn DATE TIME : 3/28/08 11:25:25