



OVERLAY TYPICAL SECTION

VT. ROUTE 9 WILMINGTON STA. 282+40.00 TO WILMINGTON STA. 376+00.00

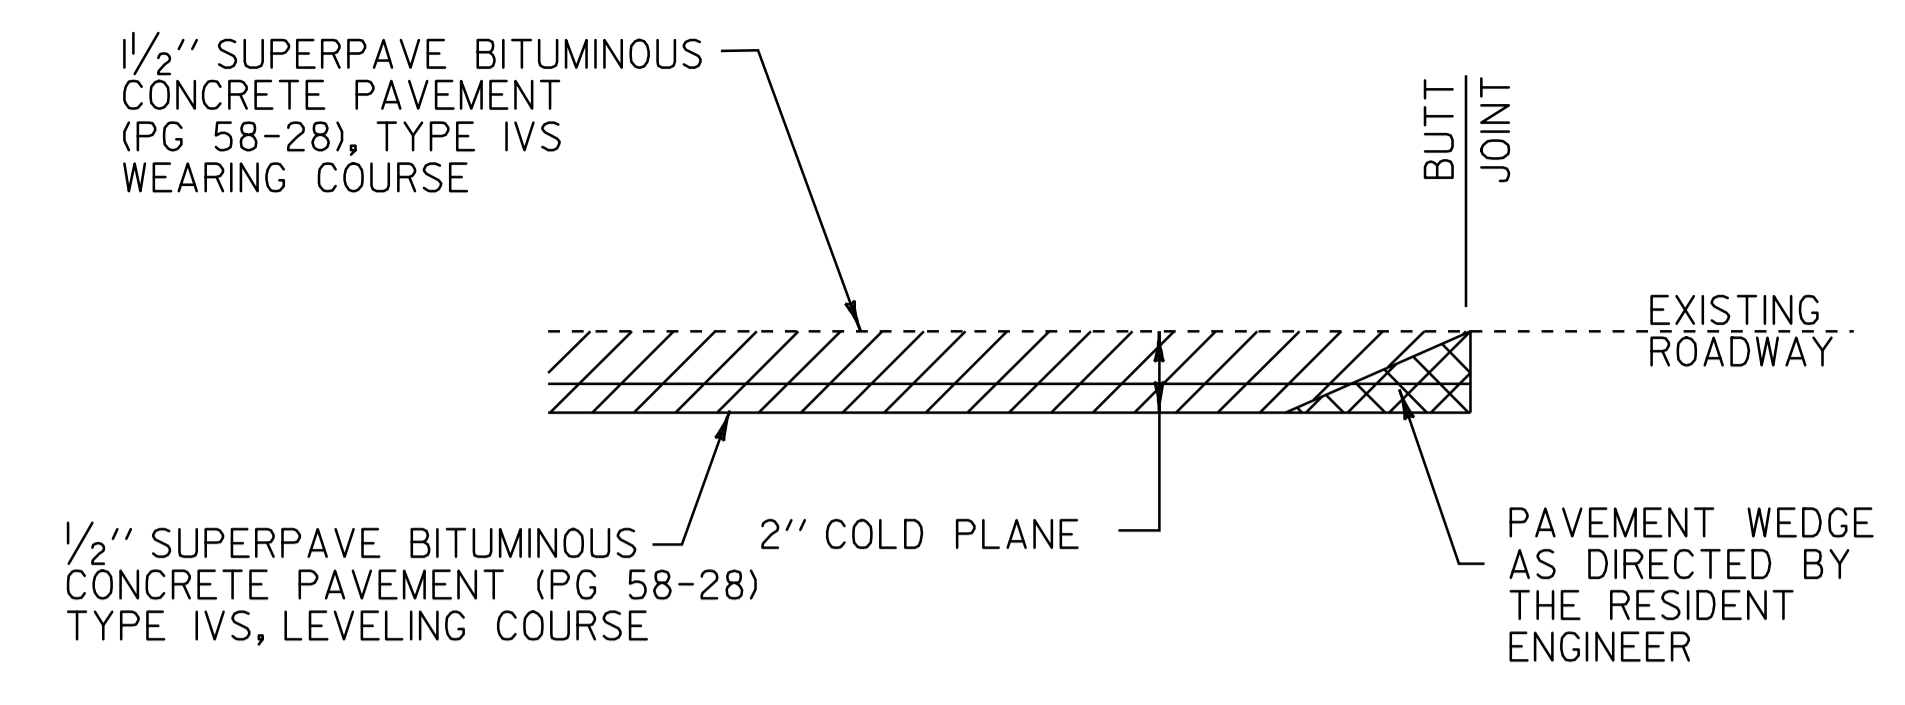


MAINLINE APPROACH AREA DETAIL

VT. ROUTE 9 WILMINGTON STA. 92+92.80 - BEGIN PROJECT

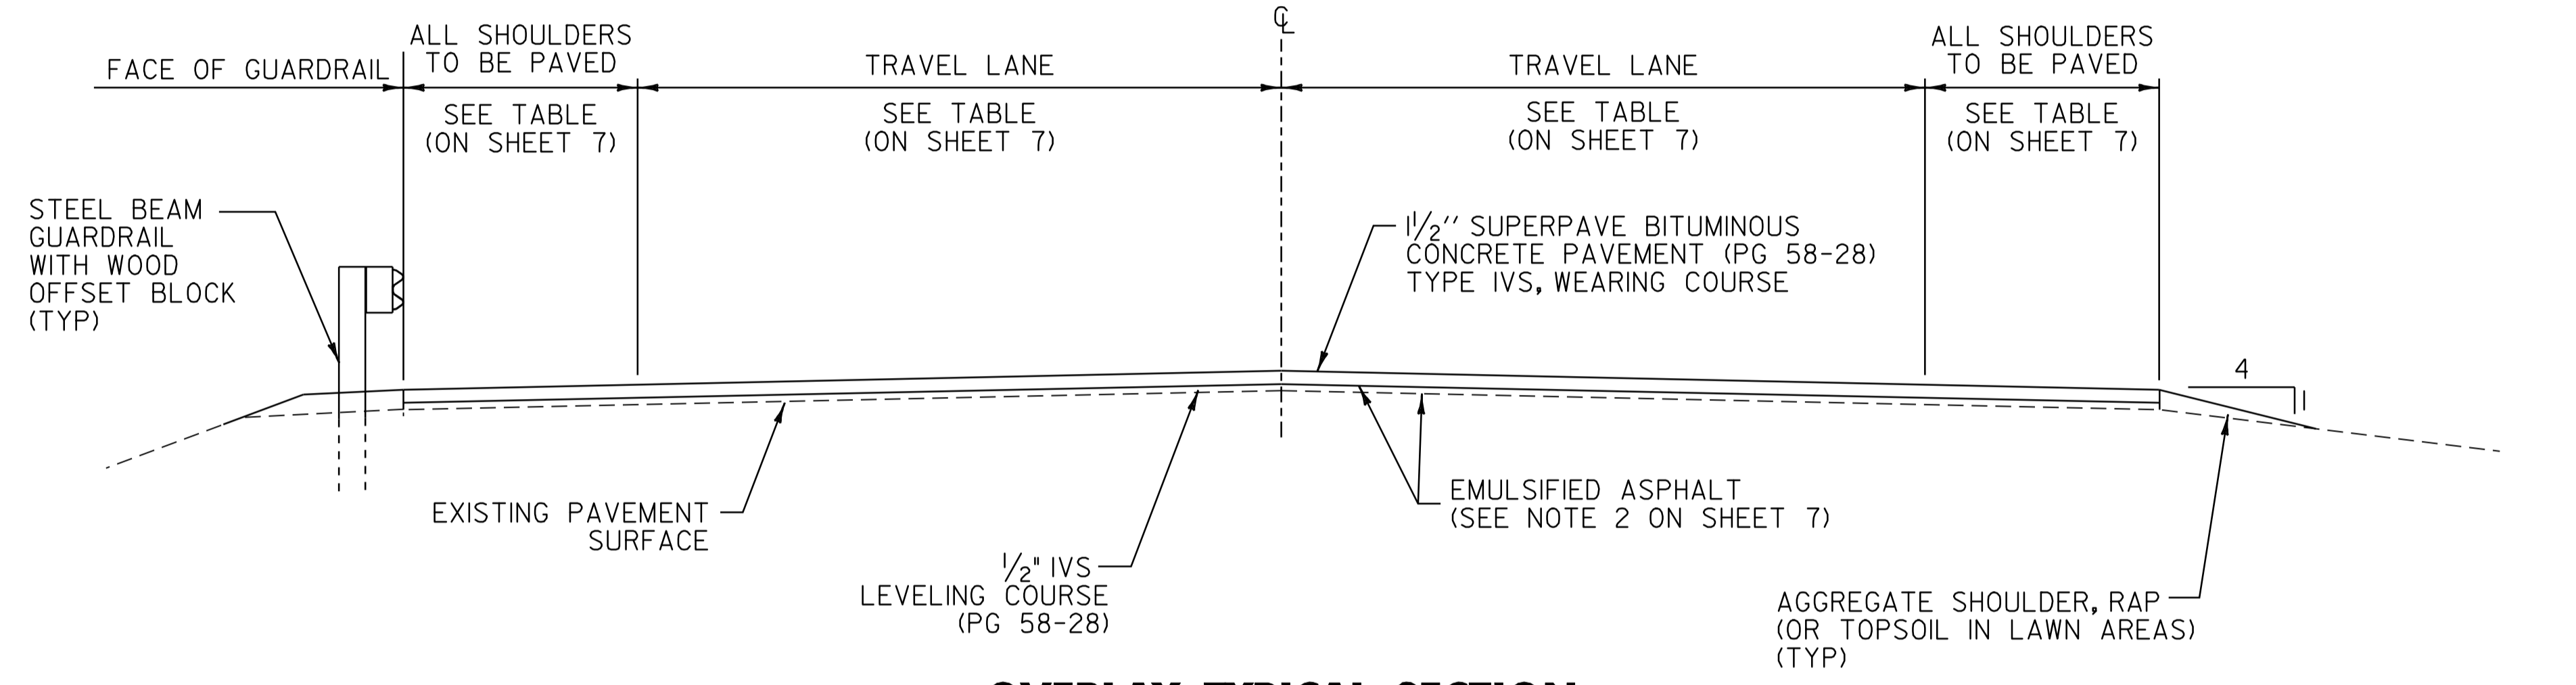


OVERLAY TYPICAL SECTION

VT. ROUTE 9 WILMINGTON STA. 226+32.00 TO WILMINGTON STA. 271+8.00
 VT. ROUTE 9 WILMINGTON STA. 271+37.00 TO WILMINGTON STA. 282+40.00
 VT. ROUTE 9 WILMINGTON STA. 376+00.00 TO WILMINGTON STA. 378+20.64

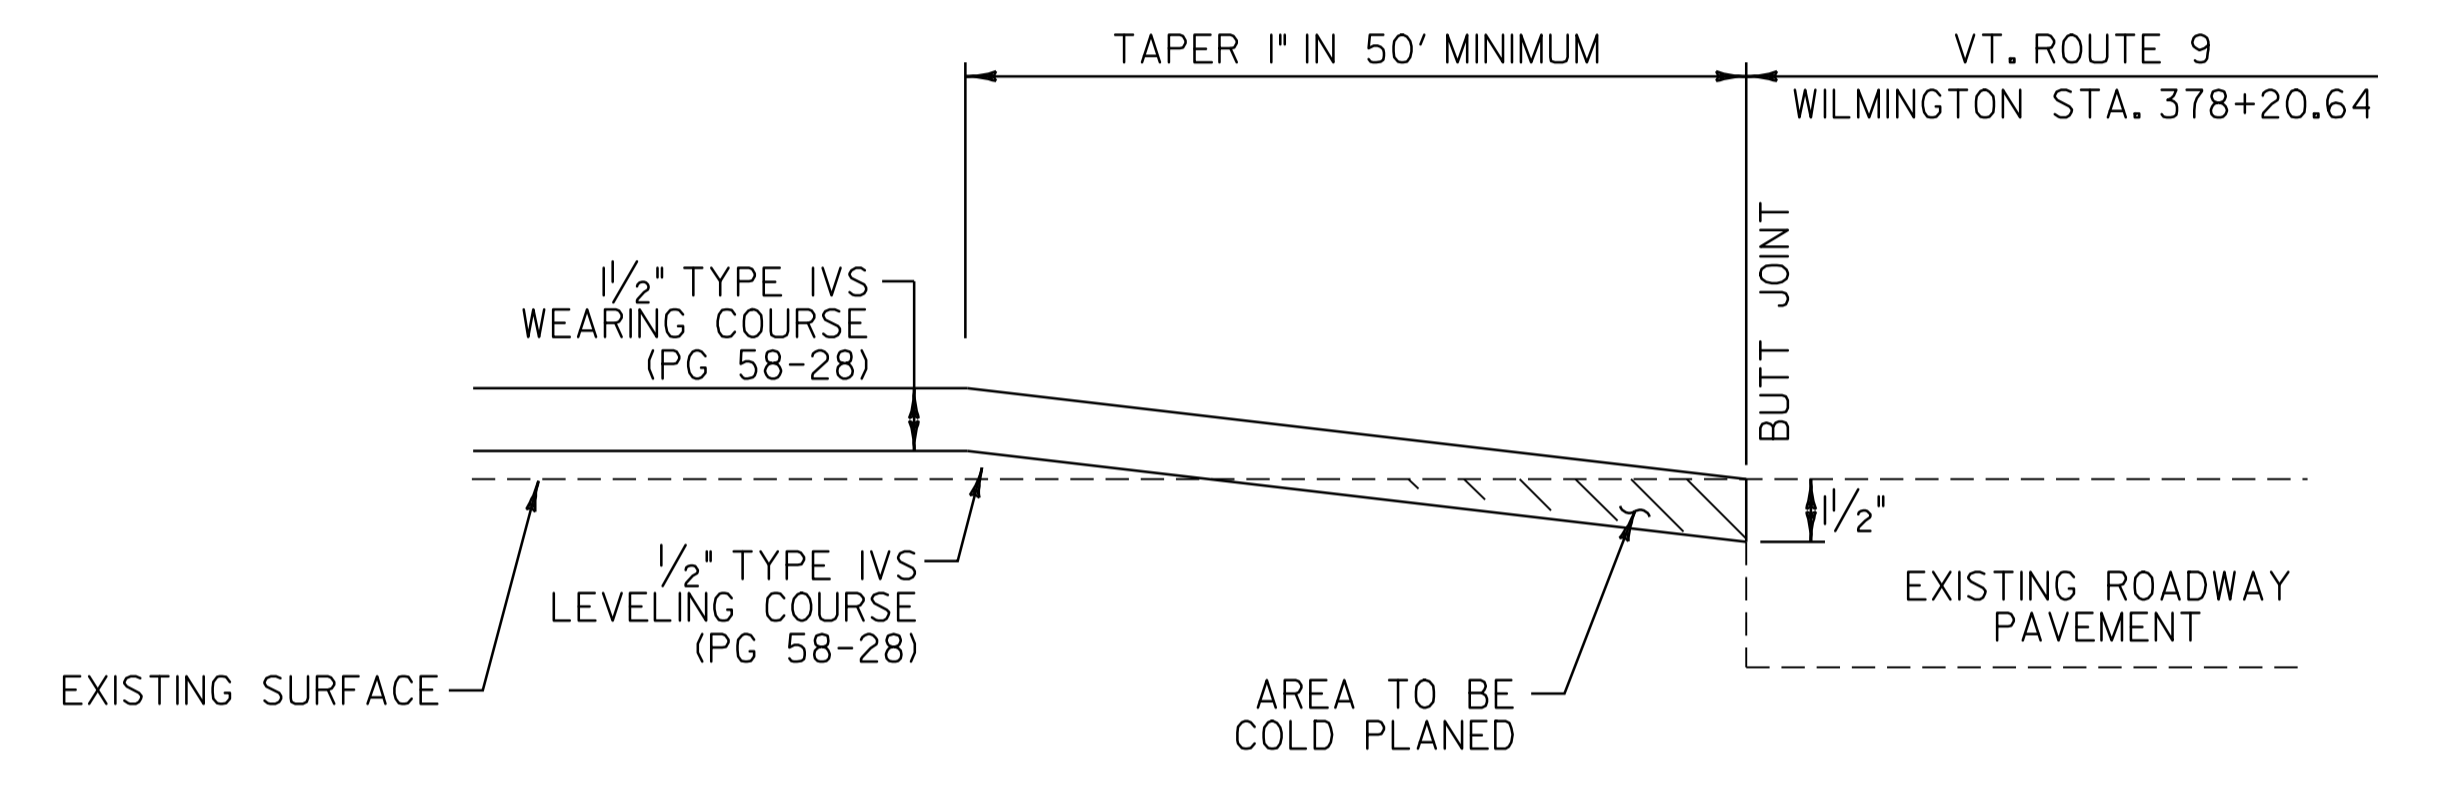

MAINLINE APPROACH AREA DETAIL

VT. ROUTE 9 WILMINGTON STA. 378+20.64 - END PROJECT

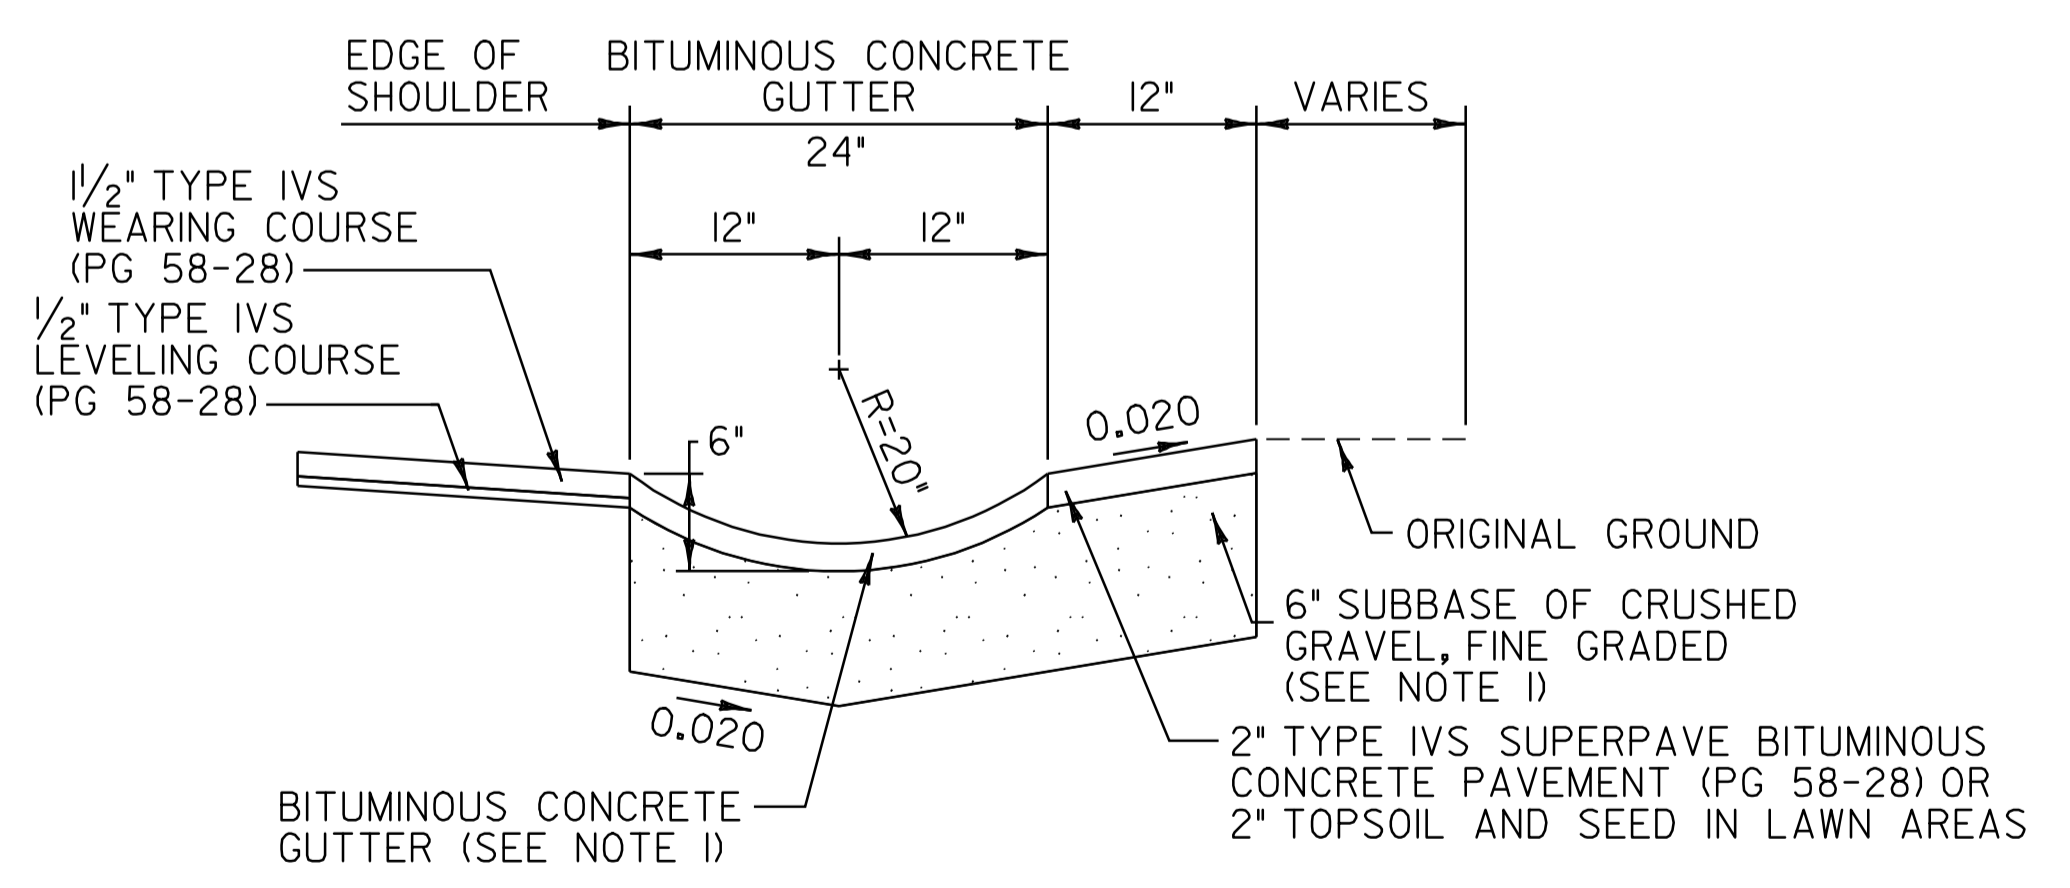


BITUMINOUS CONCRETE GUTTER DETAIL

VT. ROUTE 9 WILMINGTON:

STA. 175+50.00 - STA. 178+75.00 RT (12.1 TON)
 STA. 203+07.00 - STA. 203+21.00 RT (0.5 TON)
 STA. 207+86.00 - STA. 208+10.00 LT (0.9 TON)


NOTE:

- 1. BITUMINOUS CONCRETE GUTTER TO BE CONSTRUCTED BY PLACING 1-2" TYPE IVS SUPERPAVE BITUMINOUS CONCRETE PAVEMENT LIFT AS DIRECTED BY THE RESIDENT ENGINEER. PAYMENT UNDER ITEM 616.47 BITUMINOUS CONCRETE GUTTERS AND TRAFFIC ISLANDS. SUBBASE TO BE PAID UNDER ITEM 301.28 SUBBASE OF CRUSHED GRAVEL, FINE GRADED.

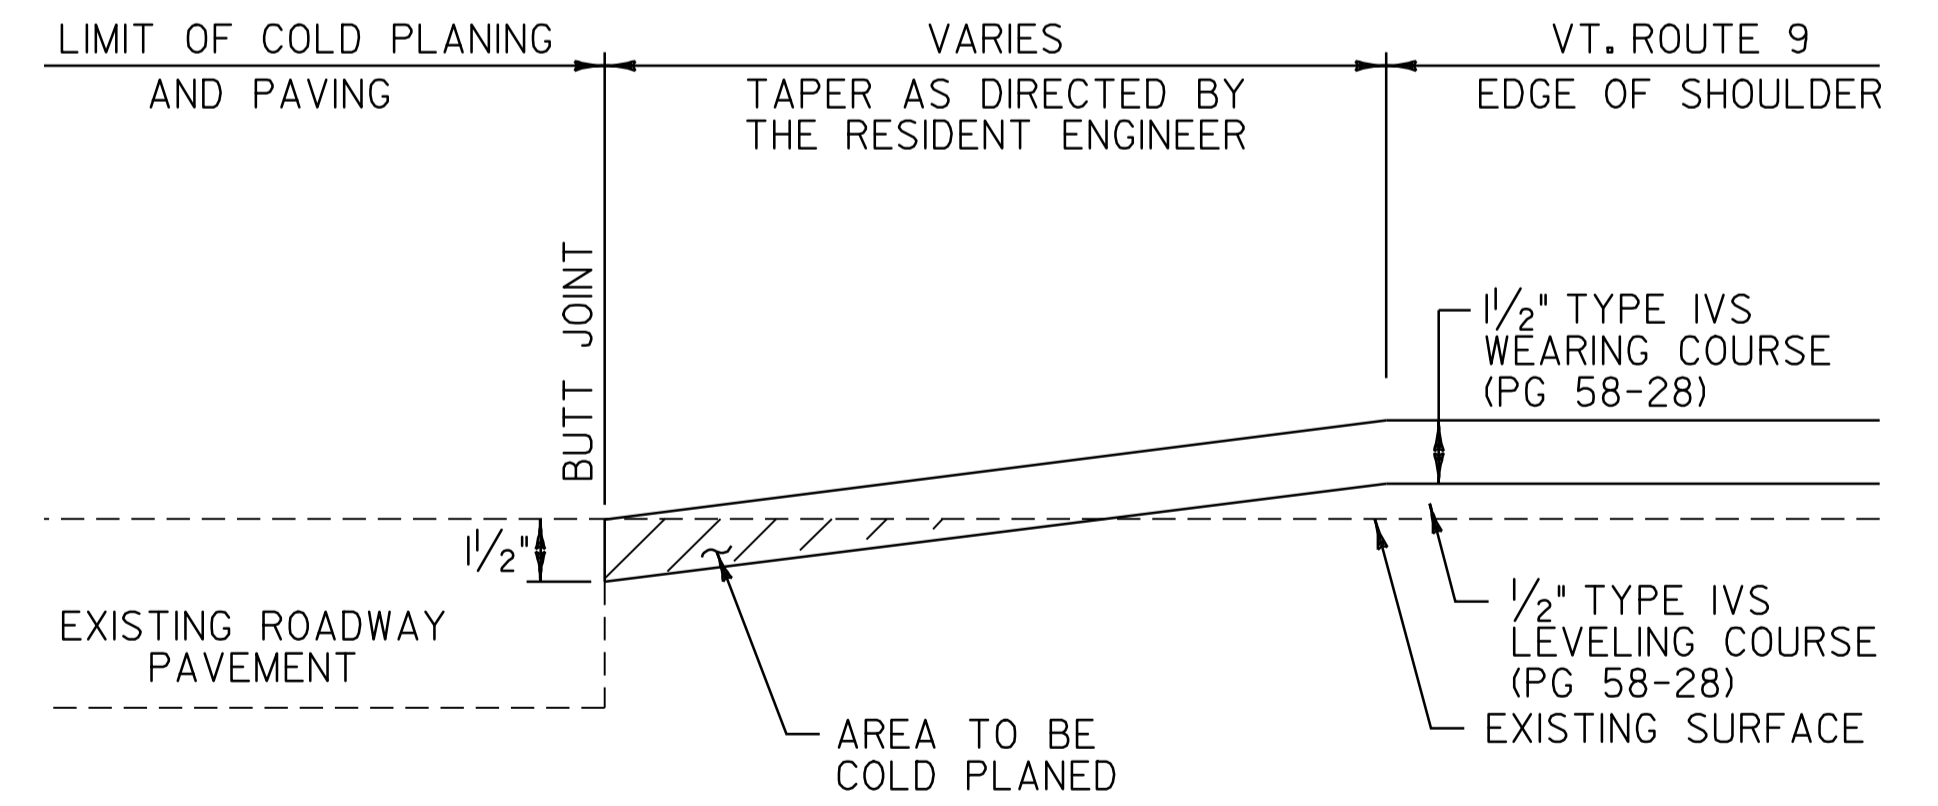


APPROACH AREA DETAIL

WILMINGTON: TH-26 STA. 244+62.24 TH-28 STA. 318+27.84
 TH-40 STA. 272+44.80 TH-95 STA. 330+42.24
 TH-88 STA. 293+04.00 SFH STA. 339+08.00
 TH-4 STA. 315+74.40 TH-27 STA. 352+17.60

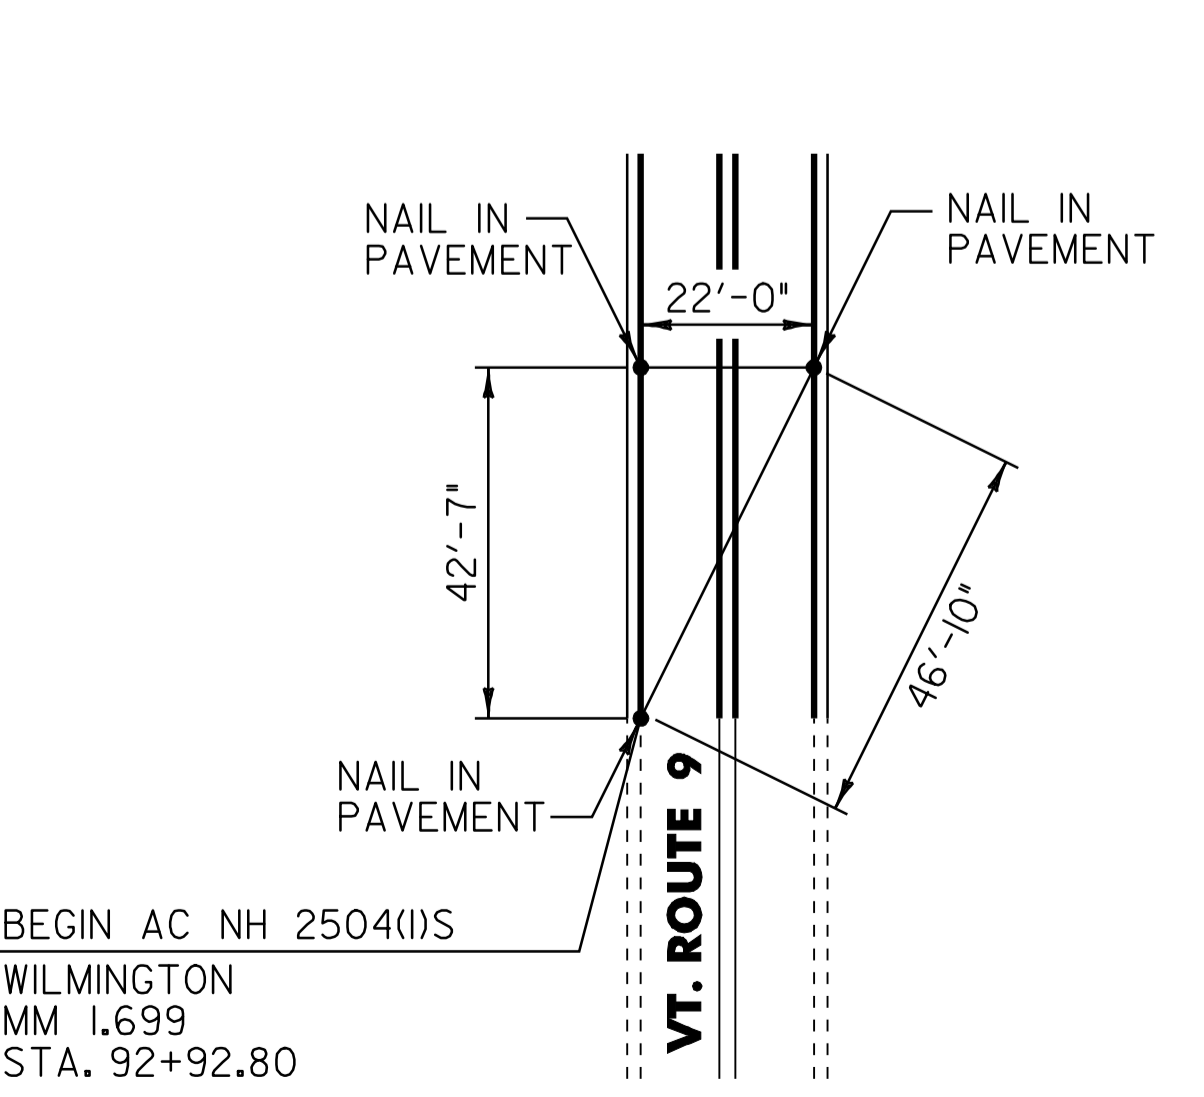

BEGIN PROJECT LOCATION TIES

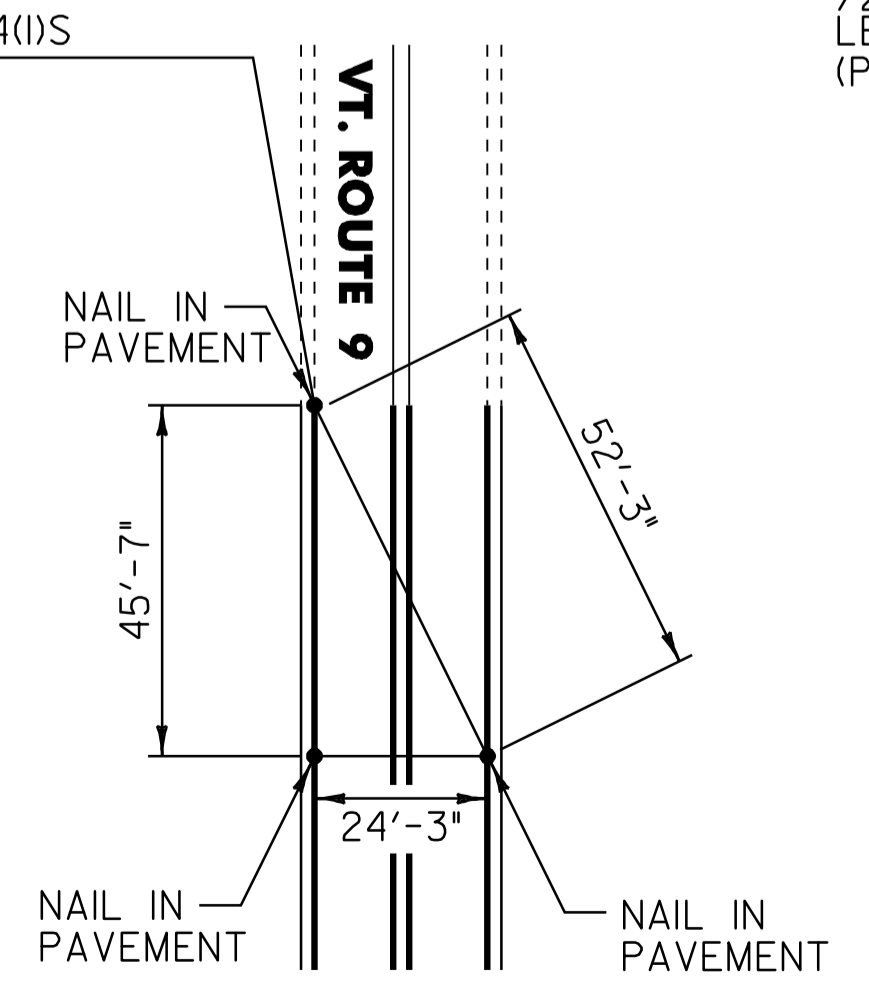

END PROJECT LOCATION TIES

NOT TO SCALE

PROJECT TYPICAL SHEET #2

PROJECT NAME: WILMINGTON	FILE NAME: p05b044.dgn	PLOT DATE: 23-AUG-2010 1
PROJECT NUMBER: AC_NH_2504(I)S	PROJECT LEADER: D.E.G.	DRAWN BY: C.A.K.
	DESIGNED BY: M.J.M.	CHECKED BY: D.W.E.
	IPARM FILE: p05b044typ2.i	SHEET 8 OF 125