

646.402 DURABLE 4 INCH WHITE LINE, THERMOPLASTIC
(ALL LINES WILL INCLUDE EDGE LINE BREAKS AND RADIUS FOR TOWN HIGHWAYS)

WILMINGTON:
STA. 92+92.80 - STA. 108+00.00 EDGE LINE LT & RT

646.412 DURABLE 4 INCH YELLOW LINE, THERMOPLASTIC
(ALL LINES WILL INCLUDE C/L BREAKS FOR TOWN HIGHWAYS) S=SOLID, D=DASHED

WILMINGTON:
STA. 92+92.80 - STA. 108+00.00 S C RT
STA. 103+80.48 DOUBLE SOLID LT, TH-9 S S

646.602 TEMPORARY 4 INCH WHITE LINE, PAINT
(ALL LINES WILL INCLUDE EDGE LINE BREAKS AND RADIUS FOR TOWN HIGHWAYS)

WILMINGTON:
STA. 92+92.80 - STA. 108+00.00 EDGE LINE LT & RT

646.612 TEMPORARY 4 INCH YELLOW LINE, PAINT
(ALL LINES WILL INCLUDE C/L BREAKS FOR TOWN HIGHWAYS) S=SOLID, D=DASHED

WILMINGTON:
STA. 92+92.80 - STA. 108+00.00 S C RT
STA. 103+80.48 DOUBLE SOLID LT, TH-9 S S

646.482 DURABLE 24 INCH STOP BAR, THERMOPLASTIC

WILMINGTON:
STA. 103+80.48 LT, TH-9

646.682 TEMPORARY 24 INCH STOP BAR, PAINT

WILMINGTON:
STA. 103+80.48 LT, TH-9

646.492 DURABLE LETTER OR SYMBOL, THERMOPLASTIC

WILMINGTON:
STA. 103+80.48 LT, TH-9 "S,T,O,P" (4 EA)

646.692 TEMPORARY LETTER OR SYMBOL, PAINT


WILMINGTON:
STA. 103+80.48 LT, TH-9 "S,T,O,P" (8 EA)

675.50 REMOVING SIGNS

AS SHOWN - II

675.60 ERECTING SALVAGED SIGNS

AS SHOWN - I

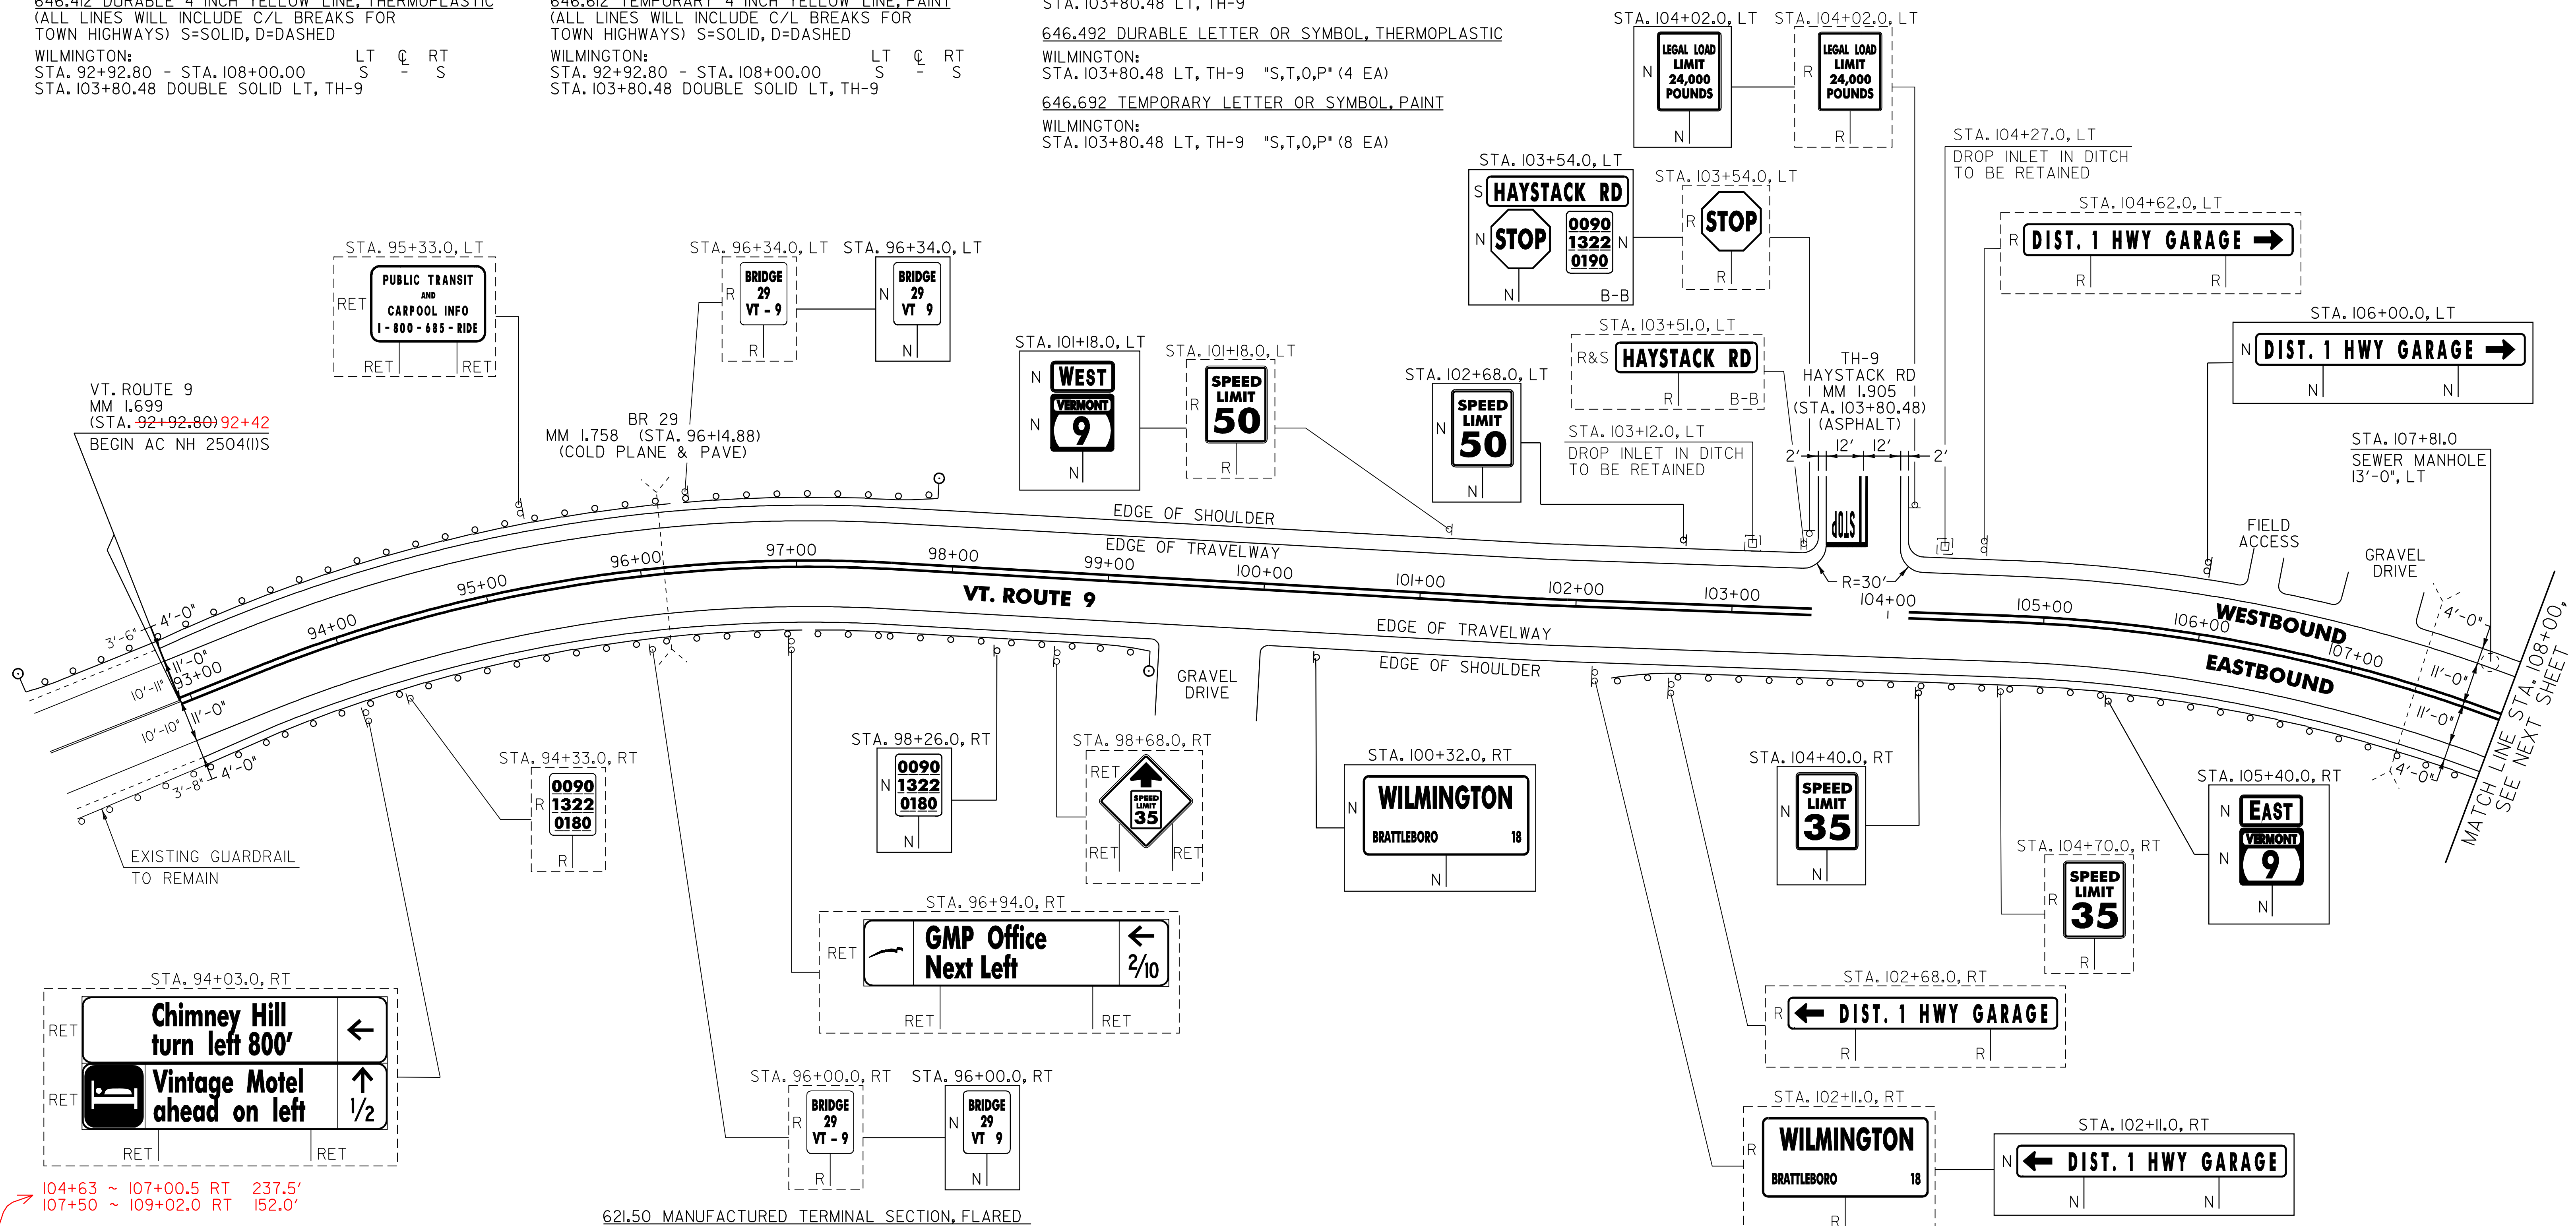

104+63 ~ 107+00.5 RT 237.5'
107+50 ~ 109+02.0 RT 152.0'

604.42 CHANGING ELEVATION OF SEWER MANHOLES
WILMINGTON:
- STA. 107+81.0 LT

621.20 STEEL BEAM GUARDRAIL, GALVANIZED
WILMINGTON:
STA. 92+69.0 - STA. 97+44.0 LT (475.0 LF) 97+02
STA. 102+27.5 - STA. 108+00.0 RT (572.5 LF) +36' 102+76' 39.5'

621.205 STEEL BEAM GUARDRAIL, GALVANIZED W/8 FEET POSTS
WILMINGTON:
700'
91+83 STA. 92+92.8 - STA. 99+05.3 RT (612.5 LF) 98+83 RT
102+76 ~ 104+63 RT (187.5') 107+00.5 ~ 107+50.5 RT (50')

621.50 MANUFACTURED TERMINAL SECTION, FLARED

WILMINGTON:
92+40 STA. 92+31.5 - STA. 92+69.0 LT 92+77.5
97+02 STA. 97+44.0 - STA. 97+81.5 LT 97+40
98+83 STA. 99+05.3 - STA. 99+43.8 RT 99+21

621.60 ANCHOR FOR STEEL BEAM RAIL

WILMINGTON:
STA. 102+34.0 RT 36'

621.80 REMOVAL AND DISPOSAL OF GUARDRAIL

WILMINGTON:
91+83 STA. 92+92.8 - STA. 97+76.0 LT (538.0 LF)
STA. 92+92.8 - STA. 99+30.3 RT (637.5 LF)
STA. 102+41.0 - STA. 108+00.0 RT (559.0 LF)

676.10 DELINEATOR WITH STEEL POST
TYPE I WHITE

WILMINGTON:
STA. 92+31.5 LT
STA. 97+81.5 LT
STA. 99+43.8 RT

NOTE:

1. PAVING LIMIT ON ALL TOWN HIGHWAYS SHALL BE MEASURED 25 FT BACK FROM VT. ROUTE 9 EDGE OF SHOULDER UNLESS DENOTED OTHERWISE ON THE PLANS OR AS DIRECTED BY THE RESIDENT ENGINEER.

SIGN LEGEND
R = REMOVE
S = SALVAGE
N = NEW
RET = RETAIN
B-B = BACK TO BACK
EXISTING = - - - - -
NEW = _____

NOT TO SCALE

PROJECT LAYOUT SHEET #1

PROJECT NAME: WILMINGTON
PROJECT NUMBER: AC_NH_2504(I)S
FILE NAME: p05b044.dgn
PROJECT LEADER: D.E.G.
DESIGNED BY: M.J.M.
IPARM FILE: p05b044LOL.I
PLOT DATE: 23-AUG-2010 14
DRAWN BY: C.A.K.
CHECKED BY: D.W.E.
SHEET 20 OF 125