

646.402 DURABLE 4 INCH WHITE LINE, THERMOPLASTIC
 (ALL LINES WILL INCLUDE EDGE LINE BREAKS AND RADIUS FOR TOWN HIGHWAYS)
 WILMINGTON:
 STA. 156+00.00 - STA. 161+00.00 EDGE LINE LT & RT

646.412 DURABLE 4 INCH YELLOW LINE, THERMOPLASTIC
 (ALL LINES WILL INCLUDE C/L BREAKS FOR TOWN HIGHWAYS) S=SOLID, D=DASHED
 WILMINGTON:
 STA. 156+00.00 - STA. 161+00.00 LT @ RT
 S - S

646.442 DURABLE 8 INCH WHITE LINE THERMOPLASTIC
 WILMINGTON:
 STA. 159+13.0 - STA. 159+25.0 NO PARKING RT
 STA. 159+00.0 - STA. 159+20.0 NO PARKING LT
 STA. 159+28.0 - STA. 159+59.0 NO PARKING RT

646.602 TEMPORARY 4 INCH WHITE LINE, PAINT
 (ALL LINES WILL INCLUDE EDGE LINE BREAKS AND RADIUS FOR TOWN HIGHWAYS)
 WILMINGTON:
 STA. 156+00.00 - STA. 161+00.00 EDGE LINE LT & RT

646.612 TEMPORARY 4 INCH YELLOW LINE, PAINT
 (ALL LINES WILL INCLUDE C/L BREAKS FOR TOWN HIGHWAYS) S=SOLID, D=DASHED
 WILMINGTON:
 STA. 156+00.00 - STA. 161+00.00 LT @ RT
 S - S

646.492 DURABLE LETTER OR SYMBOL, THERMOPLASTIC
 WILMINGTON:
 STA. 160+08.5 RT, HANDICAP SYMBOL

646.692 TEMPORARY LETTER OR SYMBOL, PAINT
 WILMINGTON:
 STA. 160+08.5 RT, HANDICAP SYMBOL

675.50 REMOVING SIGNS
 AS SHOWN - 16


675.60 ERECTING SALVAGED SIGNS
 AS SHOWN - 3

646.81 PAINTED CURB
 WILMINGTON:
 STA. 156+00.0 - STA. 156+49.0 RT (49.0 LF)
 STA. 156+67.0 - STA. 156+94.0 RT (27.0 LF)
 STA. 159+00.0 - STA. 159+20.0 LT (20.0 LF)
 STA. 159+28.0 - STA. 159+59.0 RT (31.0 LF)
 157+20 ~ 157+91 RT (41')

900.640 SPECIAL PROVISION (DURABLE CROSSWALK MARKING, INLAID THERMOPLASTIC)

WILMINGTON:
 STA. 159+24.0 LT/RT

646.702 TEMPORARY CROSSWALK MARKING, PAINT
 WILMINGTON:
 STA. 159+24.0 LT/RT

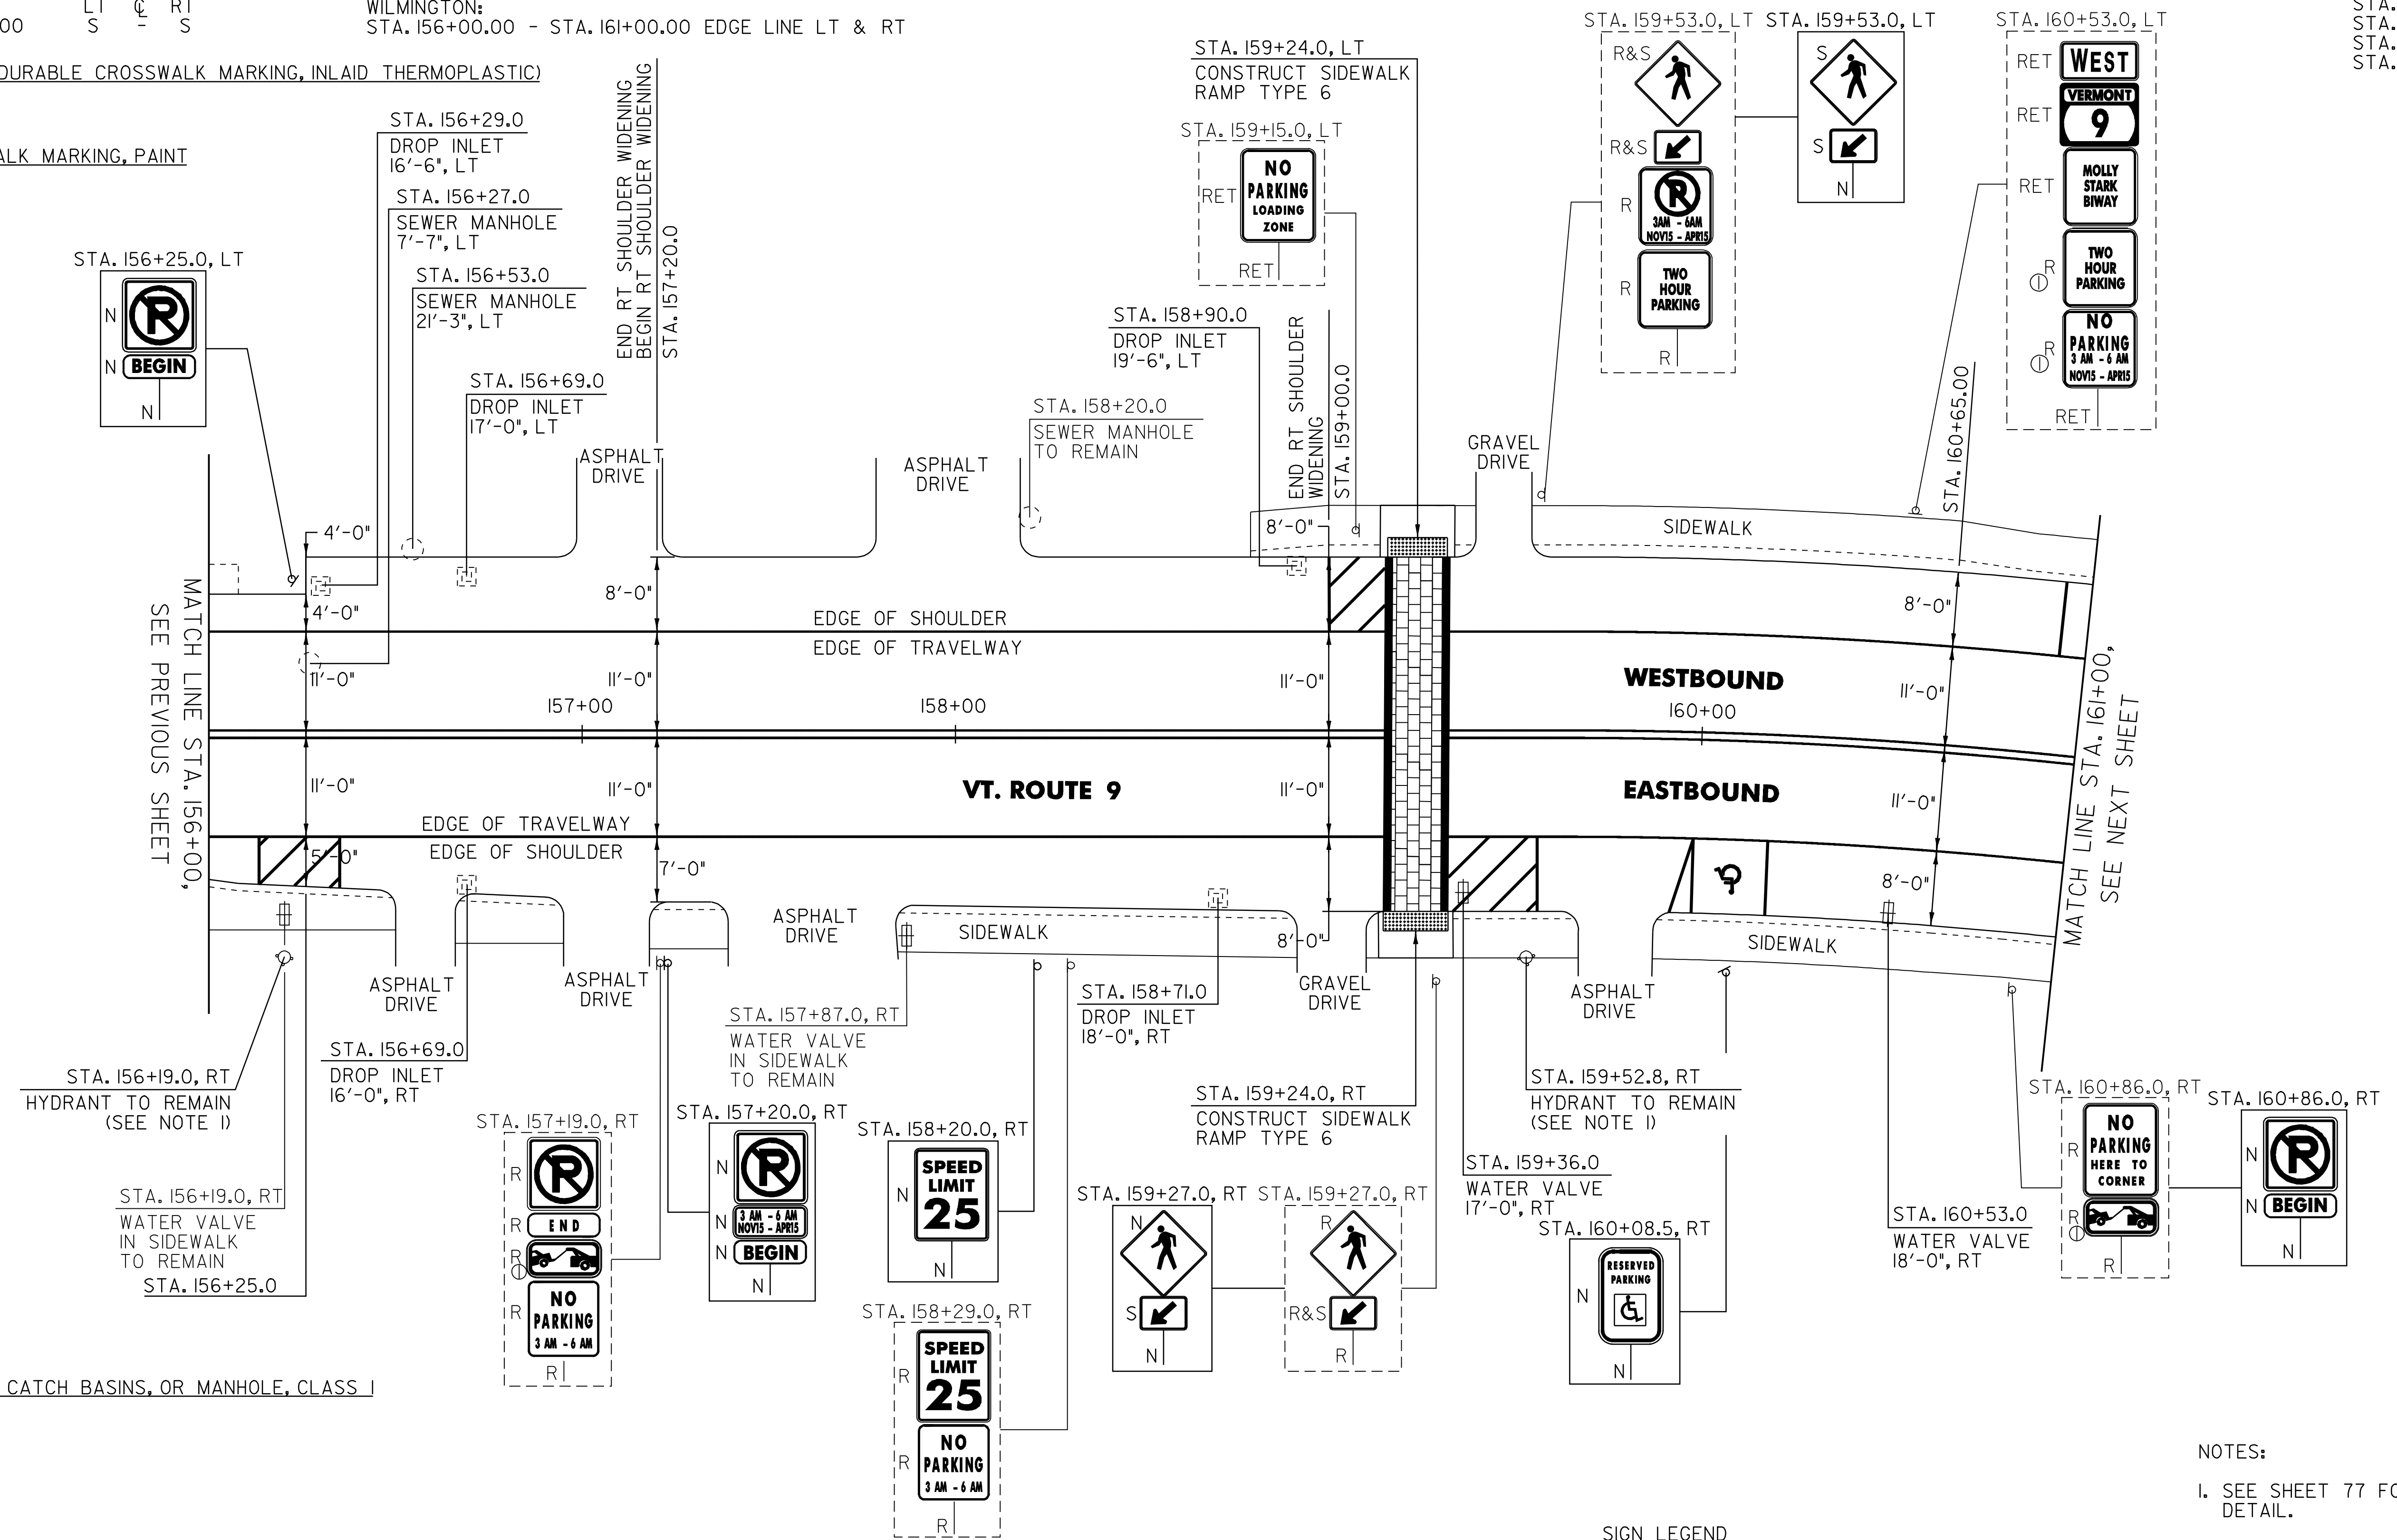

604.412 REHAB. DROP INLETS, CATCH BASINS, OR MANHOLE, CLASS 1
 WILMINGTON:
 STA. 156+29.0 LT
 STA. 156+69.0 RT
 STA. 156+69.0 LT
 STA. 158+71.0 RT
 STA. 158+90.0 LT

604.42 CHANGING ELEVATION OF SEWER MANHOLES
 WILMINGTON:
 STA. 156+27.0 LT
 STA. 156+53.0 LT

629.20 ADJUST ELEVATION OF VALVE BOX
 WILMINGTON:
 STA. 159+36.0 RT
 STA. 160+53.0 RT

SIGN LEGEND
 R = REMOVE
 S = SALVAGE
 N = NEW
 RET = RETAIN
 B-B = BACK TO BACK
 EXISTING = - - - - -
 NEW = _____
 (N) = SIGN TO BE RETURNED TO THE TOWN OF WILMINGTON

NOTES:
 1. SEE SHEET 77 FOR FIRE HYDRANT PAVEMENT MARKING DETAIL.
 2. SEE SHEET 77 FOR DETAIL OF CROSSWALK MARKINGS.

PROJECT LAYOUT SHEET #5	NOT TO SCALE	
	PROJECT NAME: WILMINGTON	PROJECT NUMBER: AC_NH_2504(I)S
	FILE NAME: p05b044.dgn	PLOT DATE: 23-AUG-2010 14:00
	PROJECT LEADER: D.E.G.	DRAWN BY: C.A.K.
	DESIGNED BY: M.J.M.	CHECKED BY: D.W.E.
	IPARM FILE: p05b044L05.I	SHEET 24 OF 125